

APPLICATION FOR PERMIT

1

COUNTY OF LOS ANGELES
DEPARTMENT OF COUNTY ENGINEER

SEWER-SEWAGE DISPOSAL

BUILDING AND SAFETY DIVISION

JOHN A. LAMBIE, County Engineer
WILLIAM A. JENSEN, Sup't of Building

FOR APPLICANT TO FILL IN

LEGAL DESCRIPTION LOT NO. *N. 124 (approx) of 24*

BLOCK *P* TRACT *JANSS*

SIZE OF LOT NO. OF BLDGS. NOW ON LOT *2*

USE OF BUILDINGS *DWELLINGS*

CONTRACTOR *Felix Rizzi Owner*

ADDRESS *3504 Winter St*

CITY *Los Angeles* TEL. NO. *An 53452*

REGISTRATION NO. STATE COUNTY

NO.	DESCRIPTION OF WORK	FEE
	HOUSE SEWER CONNECTING TO PUBLIC SEWER	@ \$5.00
	SEPTIC TANK, SEEPAGE PIT OR PITS AND/OR DRAINFIELD	@ \$10.00
	HOUSE SEWER CONNECTING TO PRIVATE DISPOSAL SYSTEM	@ \$3.00
	CONNECT ADDITIONAL BLDG. OR WORK TO HOUSE SEWER	@ \$3.00
	OVERFLOW SEEPAGE PIT, DRAINFIELD EXTN., CESSPOOL, DRYWELL, MANHOLE	@ \$5.00
	ALTER REPAIR OR ABANDON HOUSE SEWER OR DISPOSAL SYSTEM	@ \$3.00
	<i>Cap portion as connected on Per. #25327</i>	<i>3.00</i>

OWNER'S AUTHORIZATION	PERMIT	\$	2.00
	TOTAL FEE		5.00

I HAVE AT THIS DATE A CONTRACT WITH THE HEREIN NAMED CONTRACTOR TO CONNECT THE ABOVE DESCRIBED EXISTING DWELLING TO THE PUBLIC SEWER.

SIGNED THIS _____ DAY OF _____ 19____

OWNER OR OWNERS AGENT _____

ADDRESS _____

I HEREBY ACKNOWLEDGE THAT I HAVE READ THIS APPLICATION AND STATE THAT THE ABOVE IS CORRECT AND AGREE TO COMPLY WITH ALL COUNTY ORDINANCES AND STATE LAWS REGULATING PLUMBING AND SEWERS.

I HEREBY CERTIFY THAT I AM PROPERLY REGISTERED AND/OR LICENSED AS REQUIRED BY LOS ANGELES COUNTY AND STATE OF CALIFORNIA OR THAT I AM THE LEGAL OWNER OF, AND INTEND TO RESIDE IN, THE ABOVE DESCRIBED RESIDENTIAL PROPERTY.

SIGNATURE OF PERMITTEE *Felix Rizzi*

BUILDING ADDRESS *3502-2 1/2 E. Winter*

LOCALITY *E. L.A.*

NEAREST CROSS ST. *Townsend*

OWNER *Felix Rizzi*

MAIL ADDRESS *3504 E. Winter*

CITY *E. L.A.* TEL. NO. *AN-5-3452*

DISTRICT NO.	GROUP	MAP	PROCESSED BY
<i>6</i>	<i>I</i>	<i>A-74</i>	<i>White</i>

CONNECTION DATA

STATION *12+39.5* DEPTH _____

MANHOLE REFERENCE _____ UPPER LOWER

TYPE OF CONNECTION _____ LENGTH FROM M.L. TO P.L. _____

CO. IMP. NO. _____ P.C. NO. _____ JOB NO. _____

TRUNK PERMIT NO. _____ ROAD PERMIT NO. _____

AFFIDAVIT _____ WAIVER _____ EASEMENT _____ RECORD. INSTR. NO. _____ DATE _____

HWY. OR ST. WIDENING *Res at 3504 E. Winter*

STATE ENCROACHMENT PERMIT NO. *To remain on sewer*

INDUSTRIAL WASTE APPROVAL _____

CHARGES

CONNECTION CHARGE FEE _____

REIMBURSEMENT FEE _____

APPROVALS	DATE	INSPECTOR'S SIGNATURE
NEW HOUSE SEWER		
CONNECT ADDITIONAL BUILDING OR WORK		
SEPTIC TANK, SEEP, PIT (S) AND/OR DRAINFIELD		
CESSPOOL <input type="checkbox"/> DRYWELL <input type="checkbox"/>		
ALTER, REPAIR, SEWER OR SEWAGE DISPOSAL SYSTEM		
DISCONNECT PLUG AND ABANDON HOUSE SEWER	<i>3-289</i>	<i>White</i>
BACKFILL SEPTIC TANKS <input type="checkbox"/> SEEP, PIT (S) <input type="checkbox"/> CESSPOOLS <input type="checkbox"/>		

VALIDATION

CK. _____ M. O. _____ CASH _____

ROBERT A. WOOD

SUPERVISING MECHANICAL ENGINEER

LAC 78226 JUN 9 10 A 5.00


White

INSPECTOR COPY

FOR DEPARTMENT USE

REQUIRED INFORMATION

1. INDICATE ALL BUILDINGS ON PROPERTY.
2. INDICATE AND DIMENSION SEWAGE DISPOSAL SYSTEM WITH TIE DISTANCES TO BUILDINGS AND PROPERTY LINES.
3. INDICATE SIZE OF SEPTIC TANK—DEPTH OF SEEPAGE PIT(S)—SIZE OF CESSPOOL(S).
4. INDICATE NORTH DIRECTION ON PLOT.
5. INDICATE BOTH STREETS IF CORNER.

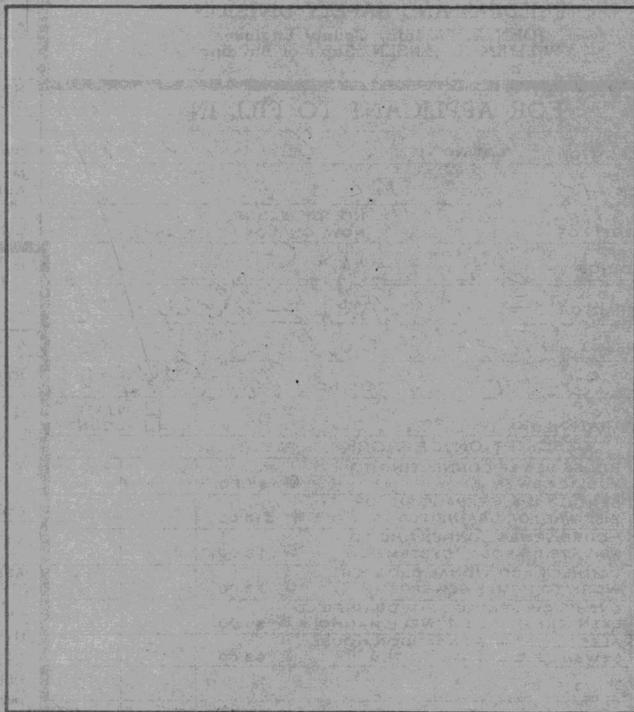

ST. ALLEY R/W

FIELD NOTES

Talked with owner he had called for inspection of cap and covered the following week end. Draw