

CE808 6-60
76A642D

APPLICATION FOR PERMIT

SEWER—SEWAGE DISPOSAL

1

COUNTY OF LOS ANGELES
DEPARTMENT OF COUNTY ENGINEER
BUILDING AND SAFETY DIVISION
JOHN A. LAMBIE, County Engineer
WILLIAM A. JENSEN, Sup't of Building

FOR APPLICANT TO FILL IN

LEGAL DESCRIPTION LOT NO. 12
BLOCK TRACT 16078
NO. OF BLDGS. NOW ON LOT

USE OF BUILDINGS

CONTRACTOR *Owner*

ADDRESS

CITY TEL. NO.

REGISTRATION NO. STATE COUNTY

| NO. | DESCRIPTION OF WORK | FEE |
|-----|---|----------------------|
| | HOUSE SEWER CONNECTING TO PUBLIC SEWER | @ \$3.00 |
| | SEPTIC TANK, SEEPAGE PIT OR PITS AND/OR DRAINFIELD | @ \$3.00 |
| | OVERFLOW SEEPAGE PIT, DRAINFIELD EXTN., CESSPOOL, DRYWELL | @ \$2.00 |
| | HOUSE SEWER CONNECTING TO PRIVATE DISPOSAL SYSTEM | @ \$1.00 |
| 1 | CONNECT ADDITIONAL WORK TO HOUSE SEWER | @ \$1.00 <i>3 00</i> |
| | ALTER, REPAIR OR ABANDON HOUSE SEWER OR DISPOSAL SYSTEM | @ \$1.00 |

OWNER'S AUTHORIZATION

| | |
|-----------|-------------|
| PERMIT | \$ 2 00 |
| TOTAL FEE | <i>5 00</i> |

I HAVE AT THIS DATE A CONTRACT WITH THE HEREIN NAMED CONTRACTOR TO CONNECT THE ABOVE DESCRIBED EXISTING DWELLING TO THE PUBLIC SEWER.

SIGNED THIS _____ DAY OF _____ 19 _____

OWNER OR OWNERS AGENT _____

ADDRESS _____

I HEREBY ACKNOWLEDGE THAT I HAVE READ THIS APPLICATION AND STATE THAT THE ABOVE IS CORRECT AND AGREE TO COMPLY WITH ALL COUNTY ORDINANCES AND STATE LAWS REGULATING PLUMBING AND SEWERS.

I HEREBY CERTIFY THAT I AM PROPERLY REGISTERED AND/OR LICENSED AS REQUIRED BY LOS ANGELES COUNTY AND STATE OF CALIFORNIA OR THAT I AM THE LEGAL OWNER OF THE ABOVE DESCRIBED RESIDENTIAL PROPERTY.

SIGNATURE OF PERMITTEE *William A. Jensen*

BUILDING ADDRESS *1821 Robinlinda Lane*
LOCALITY *So San Gabriel, Calif.*
NEAREST CROSS ST. *Wannsted*

OWNER *VAL G. FRAVON*
MAIL ADDRESS *1821 Robinlinda Lane*
CITY *San Gabriel* TEL. NO. *AT84487*

| DISTRICT NO. | GROUP | MAP | PG | PROCESSED BY |
|--------------|----------|----------|------------|---------------|
| <i>5</i> | <i>I</i> | <i>H</i> | <i>113</i> | <i>LeCote</i> |

CONNECTION DATA

| STATION | DEPTH |
|---------|-------|
| | |

| MANHOLE REFERENCE | UPPER | LOWER |
|-------------------|-------|-------|
| | | |

| Y. | TYPE OF CONNECTION CURB | P.L. | LENGTH FROM M.L. TO P.L. |
|----|-------------------------|------|--------------------------|
| | | | |

Add to permit # 163635

| CO. IMP. NO. | P. C. NO. JOB NO. |
|--------------|-------------------|
| | |

| TRUNK PERMIT NO. | ROAD PERMIT NO. |
|------------------|-----------------|
| | |

STATE ENCROACHMENT PERMIT NO.

INDUSTRIAL WASTE APPROVAL

CHARGES

CONNECTION CHARGE FEE

REIMBURSEMENT FEE

| APPROVALS | DATE | INSPECTOR'S SIGNATURE |
|-----------|------|-----------------------|
|-----------|------|-----------------------|

| | | |
|-------------------------------------|---------------|----------------|
| NEW HOUSE SEWER | | |
| CONNECT ADDITIONAL BUILDING OR WORK | <i>8-8-62</i> | <i>Rensley</i> |

| | | |
|---|--|--|
| SEPTIC TANK, SEEP. PIT(S) AND/OR DRAINFIELD | | |
|---|--|--|

| | | |
|--|--|--|
| CESSPOOL <input type="checkbox"/> DRYWELL <input type="checkbox"/> | | |
|--|--|--|

| | | |
|--|--|--|
| ALTER, REPAIR, SEWER OR SEWAGE DISPOSAL SYSTEM | | |
|--|--|--|

| | | |
|---|--|--|
| DISCONNECT PLUG AND ABANDON HOUSE SEWER | | |
|---|--|--|

| | | |
|--|--|--|
| BACKFILL SEPTIC TANKS <input type="checkbox"/> | | |
| SEEP. PIT(S) <input type="checkbox"/> CESSPOOLS <input type="checkbox"/> | | |

VALIDATION

CK.

M. O.

CASH

ROBERT A. WOOD
SUPERVISING MECHANICAL ENGINEER

LAC 17678 JUL 17 1962

5.00-3


Bonham

INSPECTOR COPY

FOR DEPARTMENT USE

REQUIRED INFORMATION

1. INDICATE ALL BUILDINGS ON PROPERTY.
2. INDICATE AND DIMENSION SEWAGE DISPOSAL SYSTEM WITH TIE DISTANCES TO BUILDINGS AND PROPERTY LINES.
3. INDICATE SIZE OF SEPTIC TANK—DEPTH OF SEEPAGE PIT(S)—SIZE OF CESSPOOL(S).
4. INDICATE NORTH DIRECTION ON PLOT.
5. INDICATE BOTH STREETS IF CORNER.

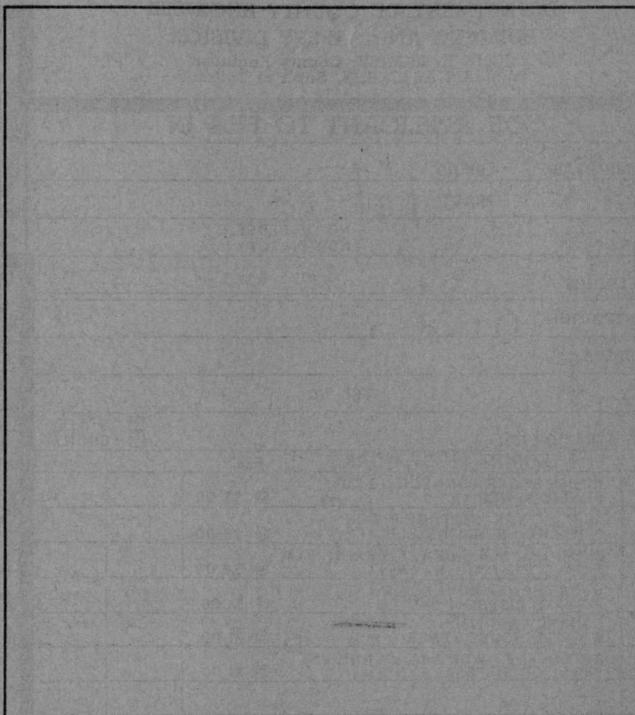

ST. ALLEY R/W

FIELD NOTES

Handwritten notes in the field notes section, including the number 200-7 and other illegible markings.