


**VICINITY MAP**

NOT TO SCALE  
 GPS: N34° 01' 05.00"  
 W118° 10' 30.47"

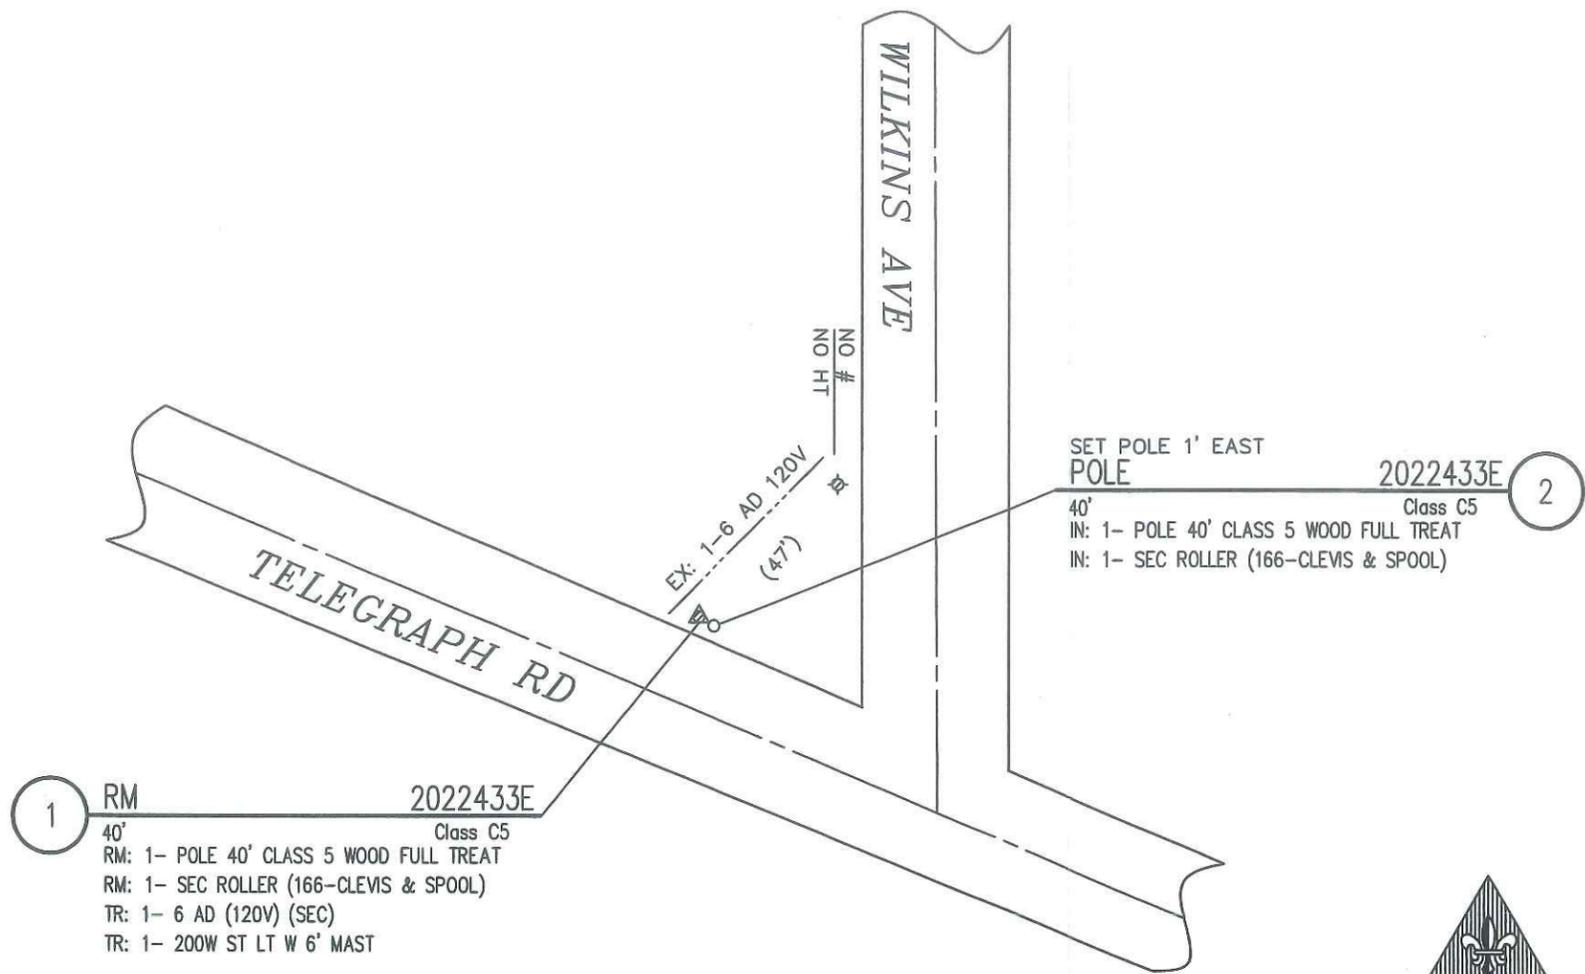

1 RM 2022433E  
 40' Class C5  
 RM: 1- POLE 40' CLASS 5 WOOD FULL TREAT  
 RM: 1- SEC ROLLER (166-CLEVIS & SPOOL)  
 TR: 1- 6 AD (120V) (SEC)  
 TR: 1- 200W ST LT W 6' MAST

2 SET POLE 1' EAST POLE 2022433E  
 40' Class C5  
 IN: 1- POLE 40' CLASS 5 WOOD FULL TREAT  
 IN: 1- SEC ROLLER (166-CLEVIS & SPOOL)

NOTE:  
 -E TO PTD  
 -PTC REQ. (ROUTE 03)  
 -CONCRETE REPAIR REQ 4'x4'

REQUIRED PERMITS:  
 -TRAFFIC CONTROL PERMIT REQ.  
 -ENCROACHMENT PERMIT REQ.  
 -EXCAVATION PERMIT REQ.

NOTES:  
 HAND SET: NO  
 JOINT MEET: NO  
 TRUCK ACCESS: YES  
 CONTACT CATV: NO  
 PAVEMENT REPAIR: YES  
 JOINT ANCHOR: NO  
 ENVIRONMENTAL/  
 REAL PROP. REVIEW: NO

If changes to JPA are req'd i.e., Cut vs. PTD, or location change \*contact Joint Utility prior to construction


UTILITY: \_\_\_\_\_  
 ENGINEER: \_\_\_\_\_  
 PHONE: \_\_\_\_\_  
 DATE: \_\_\_\_\_  
 INSPECTED BY: \_\_\_\_\_  
 DATE INSPECTED: \_\_\_\_\_ STA: 1 & 2



**BURGER 4KV % BICKNELL SUB**

NOT TO SCALE

DISTRICT 22 - MONTEBELLO		PROJ. MGR. JOHN RODRIGUEZ, PHONE 909-469-0219		PLANNER ADAM FUENTES PHONE 909-303-3493		BUDGET ITEM 480	YEAR 2014
FOREMAN		TRUCK NO.	P/E	INVENTORY MAP NO. 118-4233-1	THOMAS GUIDE 675-E1	GRID NO. 000	DESIGN NO. 633501_0.01
CSD 140	Y <input type="checkbox"/> N <input type="checkbox"/>	BY-PASS CODE	EXISTING CHANGE TO	TLM CHECKED	%LOAD	J.P.A. NO.	ASSOCIATED DESIGN NO.
PRODUCT/SAP NO. 910283-DET POLE REPLACEMENT		PRODUCT/SAP NO.			PRODUCT/SAP NO.		
PROPOSED CONSTRUCTION (LOCATION) DETERIORATED POLE REPLACEMENT TELEGRAPH N/S 3' C/O WILKINS MONTEBELLO							SHEET
TYPE APPROVED BY DATE CHECKED BY DRAWN BY PAX #							JOB NO. 633501_0.01
Southern California Edison Company							OF

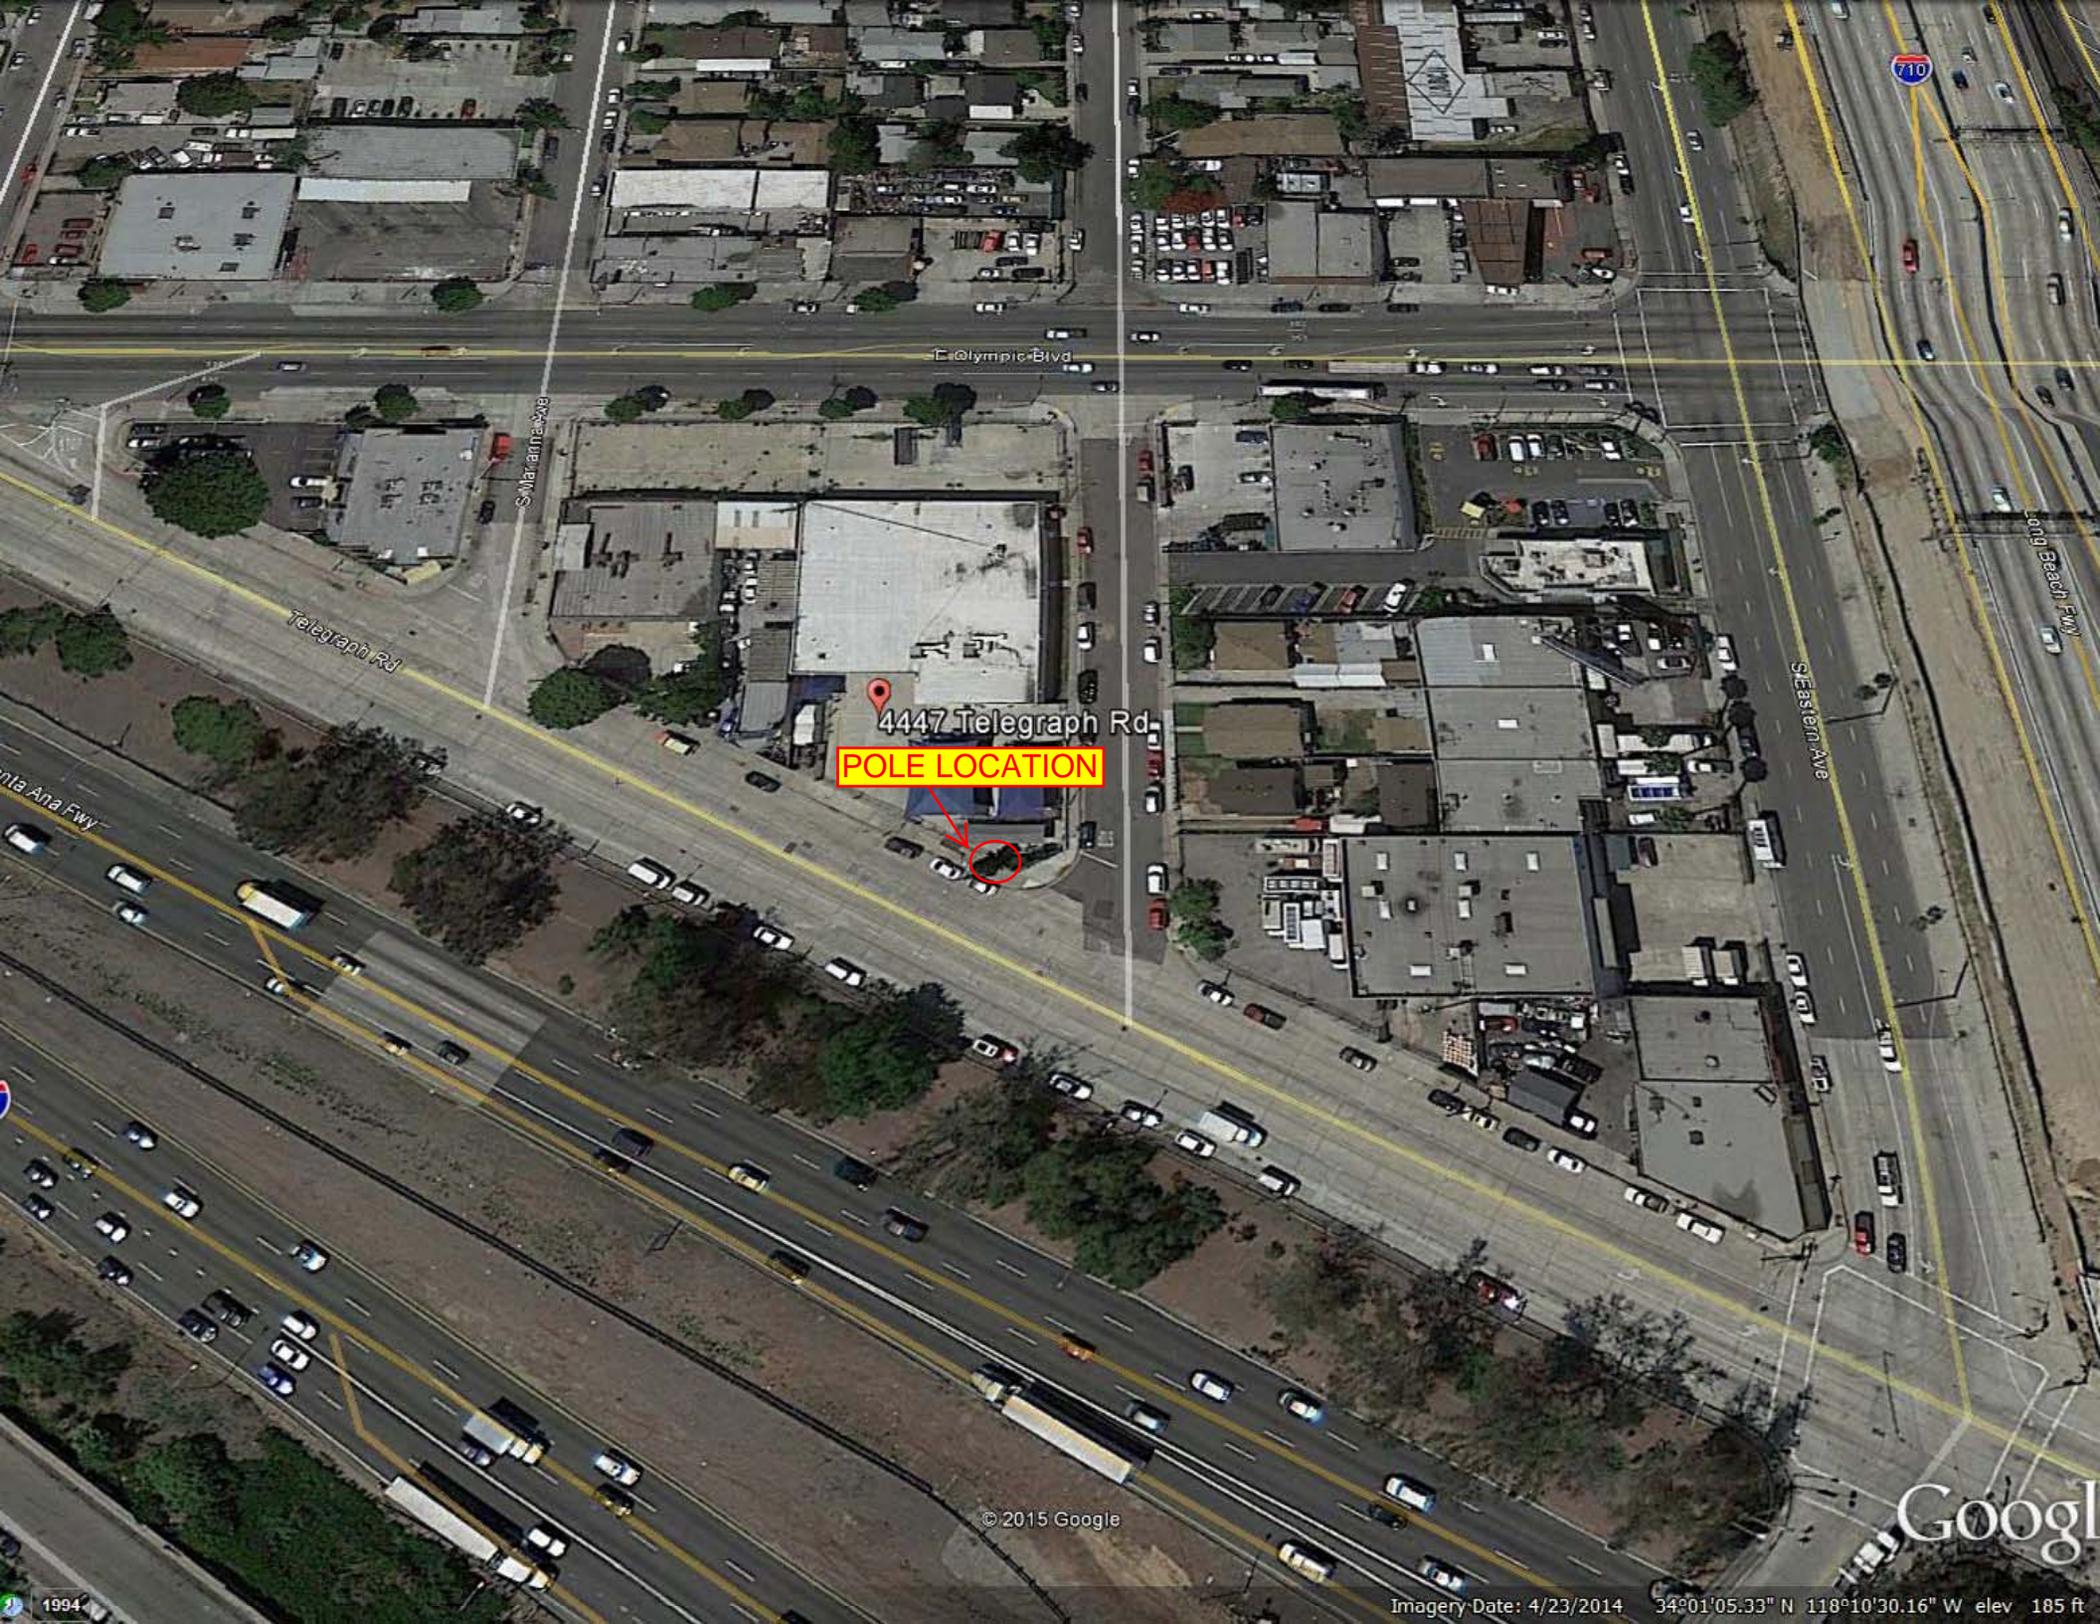

Olympic Blvd

S. Marana Ave

Telegraph Rd

Santa Ana Fwy

Eastern Ave

Long Beach Fwy

4447 Telegraph Rd

**POLE LOCATION**

© 2015 Google


Google

Imagery Date: 4/23/2014 34°01'05.33" N 118°10'30.16" W elev 185 ft

1994




S Eastern Avenue

S Marianna Avenue

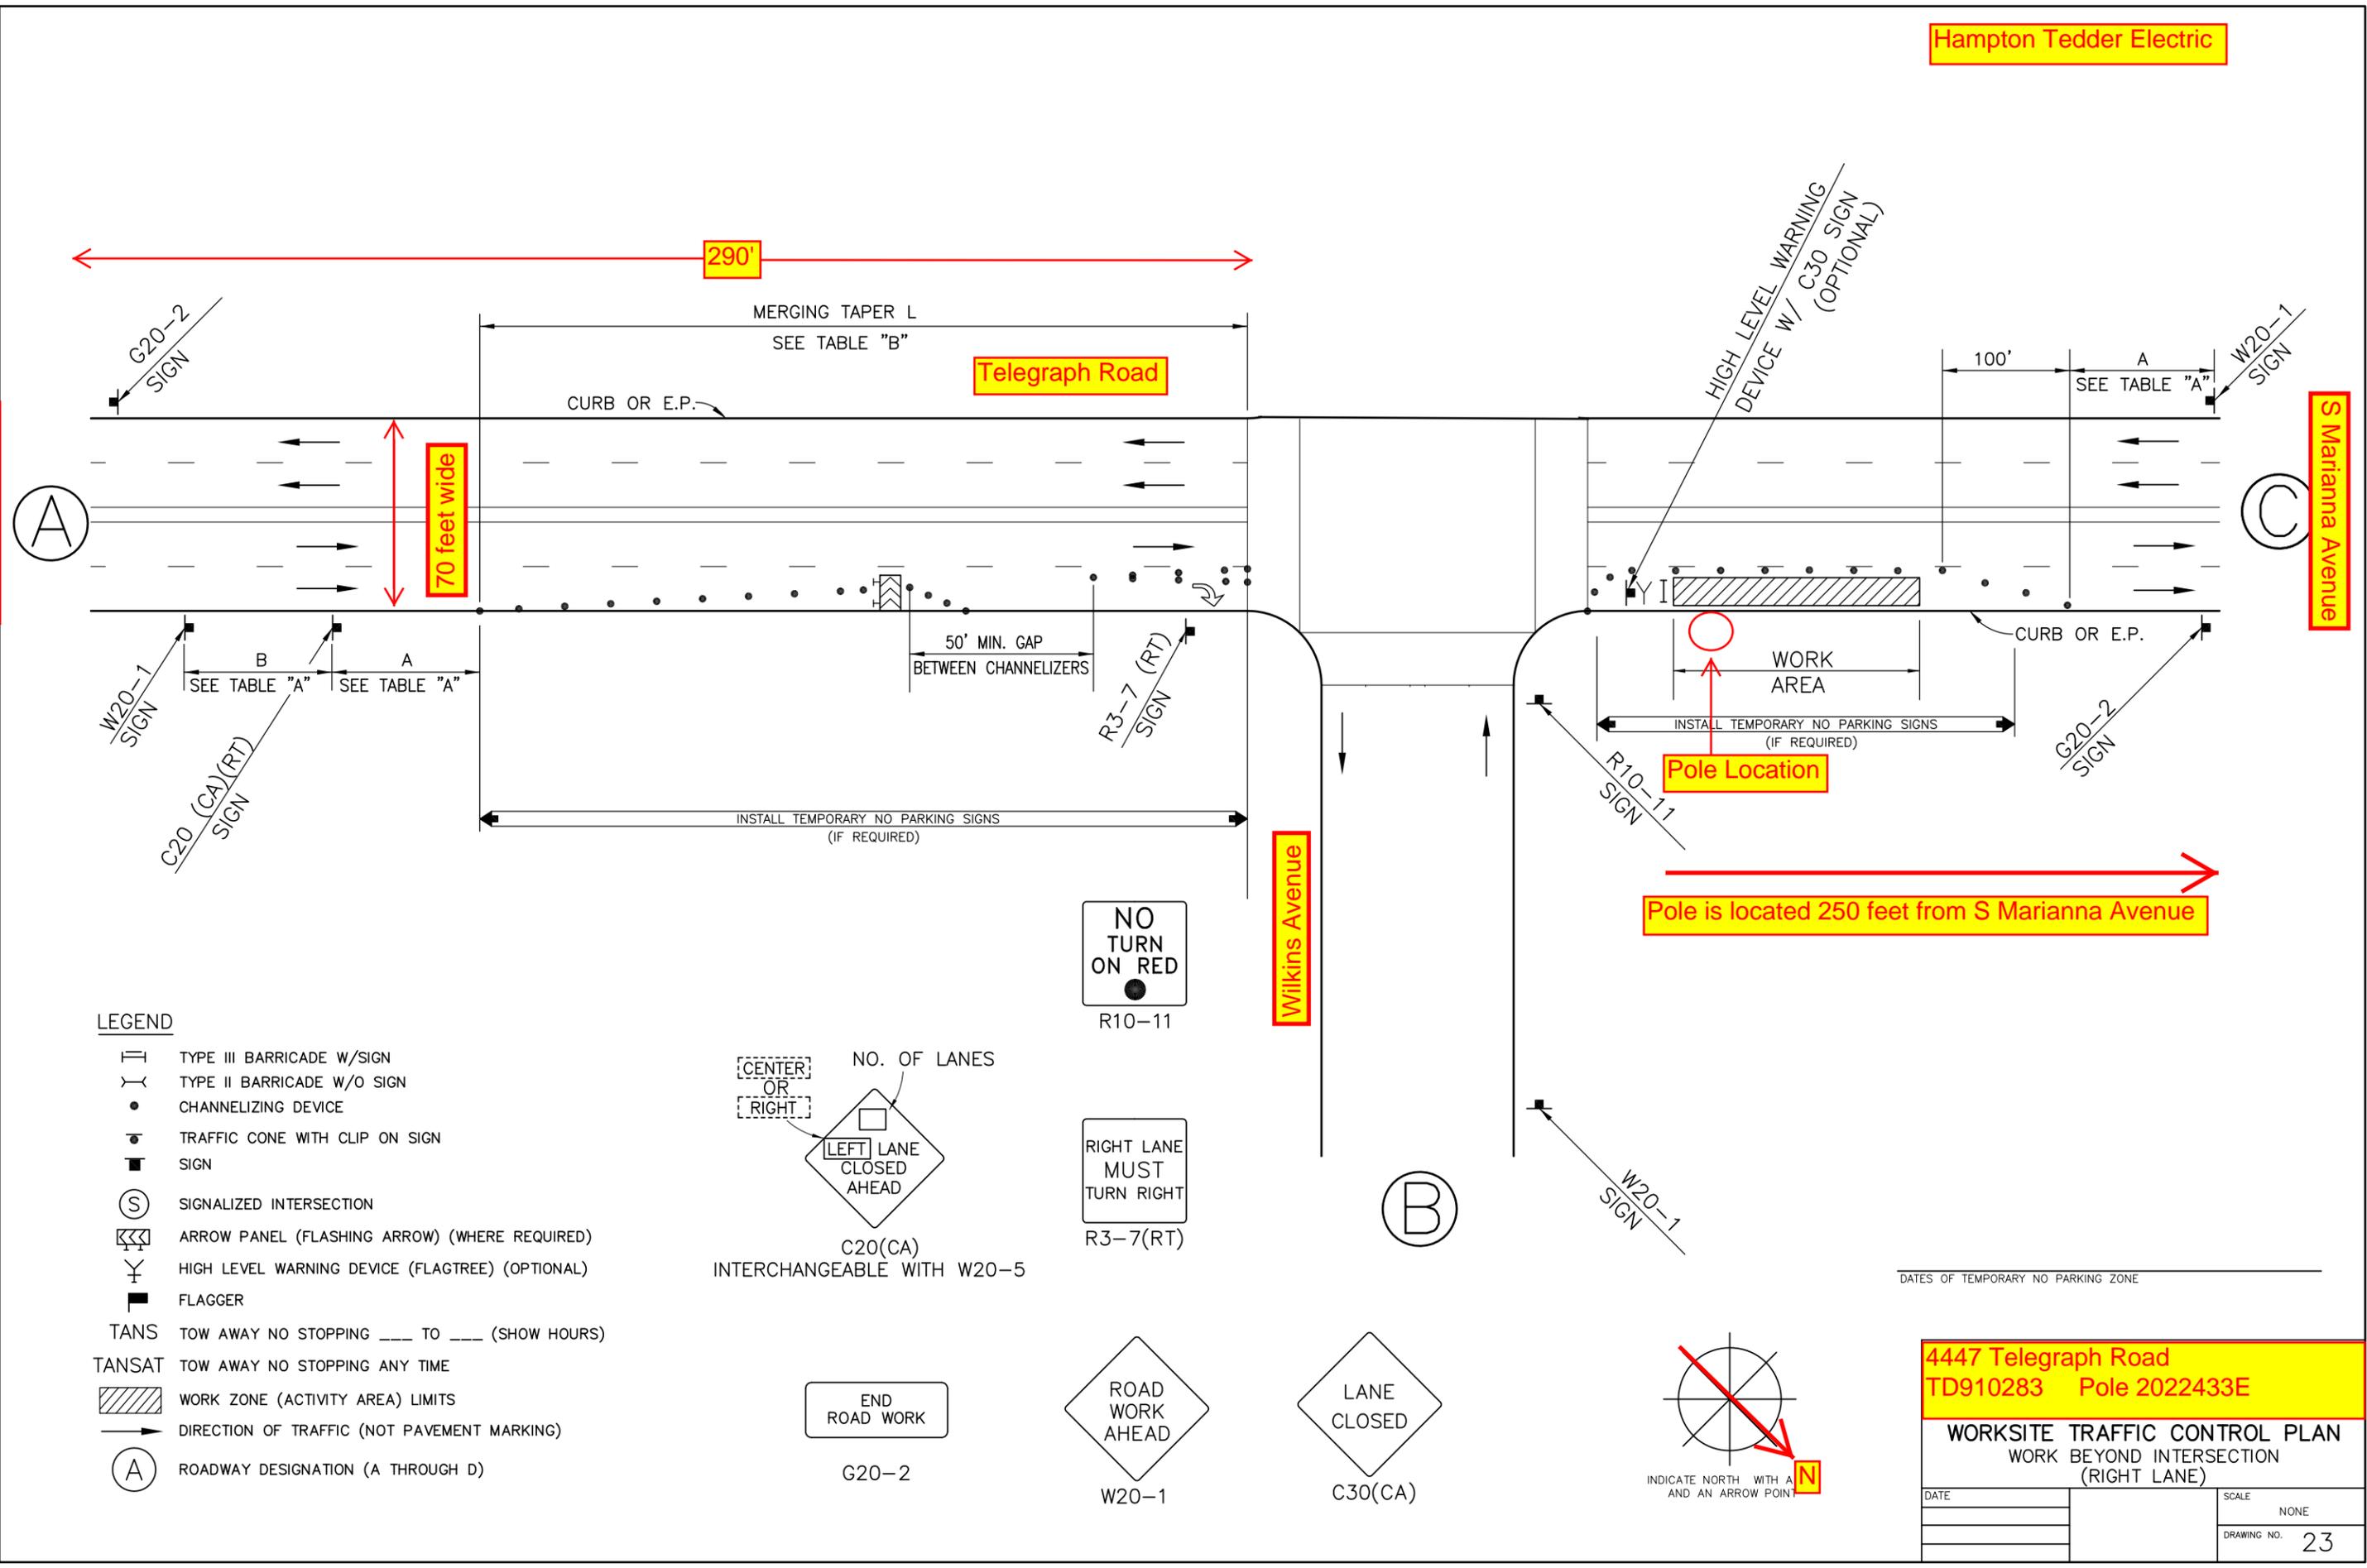

**LEGEND**

- TYPE III BARRICADE W/SIGN
- TYPE II BARRICADE W/O SIGN
- CHANNELIZING DEVICE
- TRAFFIC CONE WITH CLIP ON SIGN
- SIGN
- SIGNALIZED INTERSECTION
- ARROW PANEL (FLASHING ARROW) (WHERE REQUIRED)
- HIGH LEVEL WARNING DEVICE (FLAGTREE) (OPTIONAL)
- FLAGGER
- TANS TOW AWAY NO STOPPING \_\_\_\_ TO \_\_\_\_ (SHOW HOURS)
- TANSAT TOW AWAY NO STOPPING ANY TIME
- WORK ZONE (ACTIVITY AREA) LIMITS
- DIRECTION OF TRAFFIC (NOT PAVEMENT MARKING)
- ROADWAY DESIGNATION (A THROUGH D)

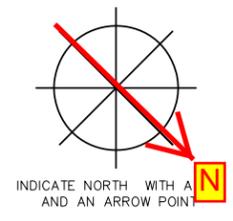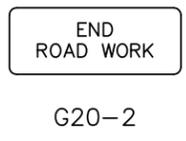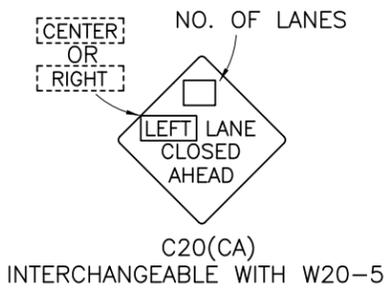

Pole is located 250 feet from S Marianna Avenue

DATES OF TEMPORARY NO PARKING ZONE \_\_\_\_\_

**4447 Telegraph Road**  
**TD910283 Pole 2022433E**

**WORKSITE TRAFFIC CONTROL PLAN**  
 WORK BEYOND INTERSECTION  
 (RIGHT LANE)

DATE		SCALE	NONE
		DRAWING NO.	23



COUNTY OF LOS ANGELES DEPARTMENT OF PUBLIC WORKS ROAD PERMIT APPLICATION

Pre-inspection Request. R.F.S. #: \_\_\_\_\_

DATE: 3/11/15 SUBDIVISION ID NO. ( DS - PC - PM - TR )

PLEASE PROVIDE ALL INFORMATION REQUESTED ON THIS FORM. COMPLETE PERMIT APPLICATION PACKAGES WILL BE PROCESSED IN THE ORDER RECEIVED. THE OMISSION OF ANY REQUESTED INFORMATION MAY RESULT IN PERMIT PROCESSING DELAY.

OWNER/APPLICANT: James Schrickel PRINT NAME Signature (REQUIRED) PHONE: (909) 592-3757

COMPANY NAME Southern California Edison ADDRESS: 800 West Ciencga San Dimas 91773

FAX: ( ) CELL: (909) 239-3086 EMAIL ADDRESS: JAMES.SCHRICKEL@HAMPTONTEDDER.COM

hereby makes application to perform work within the Public Highway at the following described locations, subject to the provisions required by the Highway Permit Ordinance (Division 1 of Title 16 Los Angeles County Code) as amended or the Municipal Code and city ordinance of the city for which this permit is issued, the attachments hereon specified, AND THE SPECIFIED REQUIREMENTS INDICATED ON THE REVERSE SIDE.

AGENT [ ] CONTRACTOR [X] CONSULTANT [ ] CONTACT [ ] OTHER [ ] James Schrickel (909) 628-1253, Ext. 301

COMPANY NAME Hampton Tedder Electric ADDRESS: 4571 State St. Montclair 91763

FAX: (909) 628-6375 CELL: (909) 239-3086 EMAIL ADDRESS: JAMES.SCHRICKEL@HAMPTONTEDDER.COM

SITE ADDRESS: 4447 Telegraph Road ASSESSOR'S PARCEL NO.: CITY: Commerce THOMAS GUIDE PAGE & GRID 675-E1

LOCATION DESCRIPTION: On sidewalk at corner of Telegraph Rd. and Wilkins Avenue

SCOPE OF WORK: Replacing power pole 2022433E for SCE- Will repair concrete (4' x 4') when new pole is set.

PLEASE COMPLETE THE FOLLOWING WHERE APPLICABLE

PERMITTEE WORK ORDER NO.: TD910283 USA "DIG ALERT" NO.: Customer/Vendor ID Number ELCSSP 10970 Address ID Number PIPE OR CONDUIT MATERIAL TYPE: SIZE: LENGTH: EXCAVATION LENGTH: 4' WIDTH: 4' TYPE OF SURFACE: Concrete

PERMIT TYPE: FOR LOS ANGELES COUNTY PERMIT OFFICE USE ONLY CONSTRUCTION [ ] ENCROACHMENT [ ] ENCROACHMENT ANNUAL [ ] EXCAVATION [ ] EXCAVATION ANNUAL [ ] ISSUANCE FEE: \$ (Non-Refundable) DATE RECEIVED: PROCESSING FEE: \$ (Non-Refundable) RECEIVED BY: PLAN CHECK: \$ (Calculated Fee or Actual Cost Deposit) PERMIT TRACKING NO: INSPECTION: \$ (Calculated Fee or Actual Cost Deposit) PERMIT WRITER: SECURITY DEPOSIT: \$ (Refundable upon completion of work) DATE APPROVED FOR ISSUANCE: TOTAL: \$ Payment Type: CASH CHECK (#)



LOS ANGELES COUNTY DEPARTMENT OF PUBLIC WORKS

Acknowledgement Best Management Practices (BMP) Attachment

DATE: 3/12/15 PERMIT NO. \_\_\_\_\_

OWNER/APPLICANT: James Schrickel (PRINT NAME) [Signature] (WET SIGNATURE (REQUIRED)) PHONE: (909) 592-3757

ADDRESS: 800 West Cienega Ave. (STREET) San Dimas (CITY) 91773 (ZIP CODE)

FAX: ( ) CELL: (909) 239-3086 EMAIL ADDRESS: JAMES.SCHRICHEL@HAMPTONTEDDER.COM

AGENT/CONTACT: James Schrickel (PRINT NAME) [Signature] (WET SIGNATURE (REQUIRED)) PHONE: (909) 628-1253, Ext. 301

ADDRESS: 4571 State St. (STREET) Montclair (CITY) 91763 (ZIP CODE)

FAX: (909) 628-6375 CELL: (909) 239-3086 EMAIL ADDRESS: JAMES.SCHRICHEL@HAMPTONTEDDER.COM


hereby acknowledges reading, understanding, and agreeing to comply with the Best Management Practices (BMP) Attachment in accordance with Los Angeles County Code Chapter 12.80 Stormwater and Runoff Pollution Control.

SITE ADDRESS: 4447 Telegraph Rd. (Street) Commerce (City) 90023 (Zip Code)

NEAREST INTERSECTION: Telegraph Rd. & Wilkins Ave. THOMAS GUIDE: 675-E1

PLEASE SUBMIT THIS DOCUMENT WITH THE APPLICATION

APPROVAL TO ISSUE ENCROACHMENT PERMIT PER CITY / COUNTY STANDARDS APPROVED: RAO DATE: 3/23/15 COMMENTS: TCP STRICTLY ENFORCED Provide sidewalk closure & Flagging

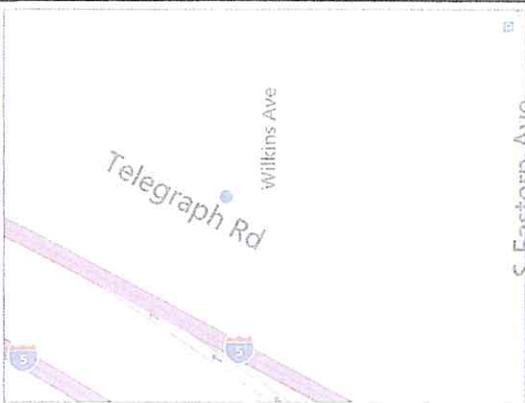


**VICINITY MAP**

NOT TO SCALE  
 GPS: N34° 01' 05.00"  
 W118° 10' 30.47"

APPROVAL TO ISSUE  
 ENCROACHMENT PERMIT PER  
 CITY/ COUNTY STANDARDS

APPROVED: RAO DATE: 3/23/15

CONDITIONS: TCP STRICTLY ENFORCED  
Provide SW closure  
& a flagger to direct  
Peds

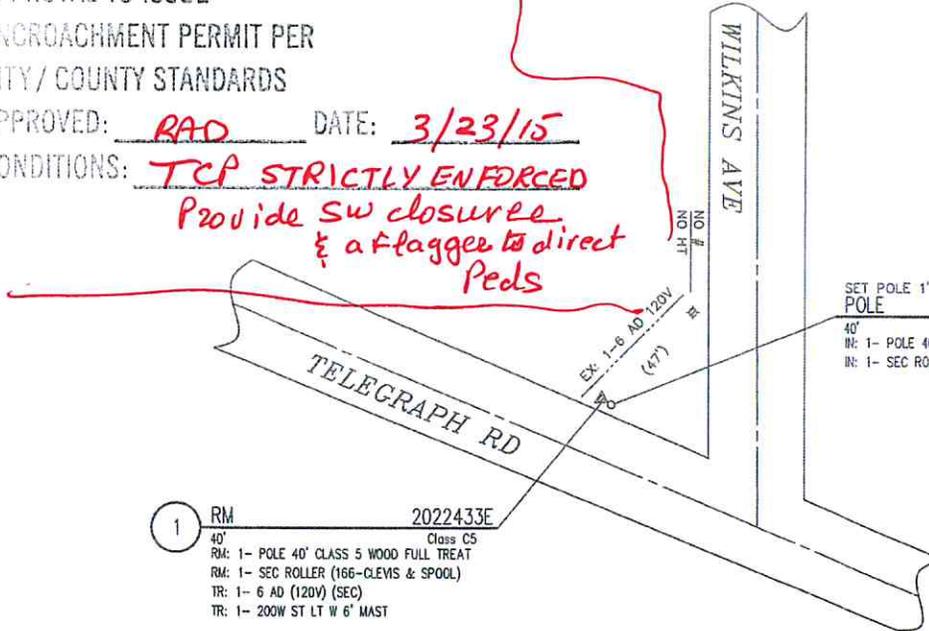

SET POLE 1' EAST  
 POLE 2022433E  
 40' Class C5  
 IN: 1- POLE 40' CLASS 5 WOOD FULL TREAT  
 IN: 1- SEC ROLLER (166-CLEVIS & SPOOL)

1 RM 2022433E  
 40' Class C5  
 RM: 1- POLE 40' CLASS 5 WOOD FULL TREAT  
 RM: 1- SEC ROLLER (166-CLEVIS & SPOOL)  
 TR: 1- 6 AD (120V) (SEC)  
 TR: 1- 200W ST LT W 6' MAST



NOTE:  
 -E TO PTD  
 -PTC REQ. (ROUTE 03)  
 -CONCRETE REPAIR REQ 4'x4'

REQUIRED PERMITS:  
 -TRAFFIC CONTROL PERMIT REQ.  
 -ENCROACHMENT PERMIT REQ.  
 -EXCAVATION PERMIT REQ.

NOTES:  
 HAND SET: NO  
 JOINT MEET: NO  
 TRUCK ACCESS: YES  
 CONTACT CATV: NO  
 PAVEMENT REPAIR: YES  
 JOINT ANCHOR: NO  
 ENVIRONMENTAL/  
 REAL PROP. REVIEW: NO

If changes to JPA are req'd i.e. Cut vs. PTD, or location change \*contact Joint Utility prior to construction

UTILITY: \_\_\_\_\_  
 ENGINEER: \_\_\_\_\_  
 PHONE: \_\_\_\_\_  
 DATE: \_\_\_\_\_  
 INSPECTED BY: \_\_\_\_\_  
 DATE INSPECTED: \_\_\_\_\_ STA: 1 & 2

**BURGER 4KV % BICKNELL SUB** NOT TO SCALE


DISTRICT 22 - MONTEBELLO	PROJ MGR. JOHN RODRIGUEZ, PHONE 909-469-0219	PLANNER ADAM FUENTES PHONE 909-303-3493	BUDGET ITEM 480	YEAR 2014
FOREMAN	TRUCK NO. P/E	INVENTORY MAP NO. THOMAS GUIDE 118-4233-1 675-E1	GRID NO. 000	DESIGN NO. 633501_0.01
CSD 140 Y _____ N _____	BY-PASS CODE	EXISTING CHANGE TO	TLM CHECKED	J.P.A. NO. ASSOCIATED DESIGN NO.
PRODUCT/SAP NO. 910283-DET POLE REPLACEMENT		PRODUCT/SAP NO.		PRODUCT/SAP NO.
PROPOSED CONSTRUCTION (LOCATION) DETERIORATED POLE REPLACEMENT TELEGRAPH N/S 3' C/O WILKINS MONTEBELLO			SHEET JOB NO. 633501_0.01	
TYPE	APPROVED BY	DATE	CHECKED BY	DRAWN BY PAX #

Southern California Edison Company

S Eastern Avenue




S Marianna Avenue

Wilkins Avenue

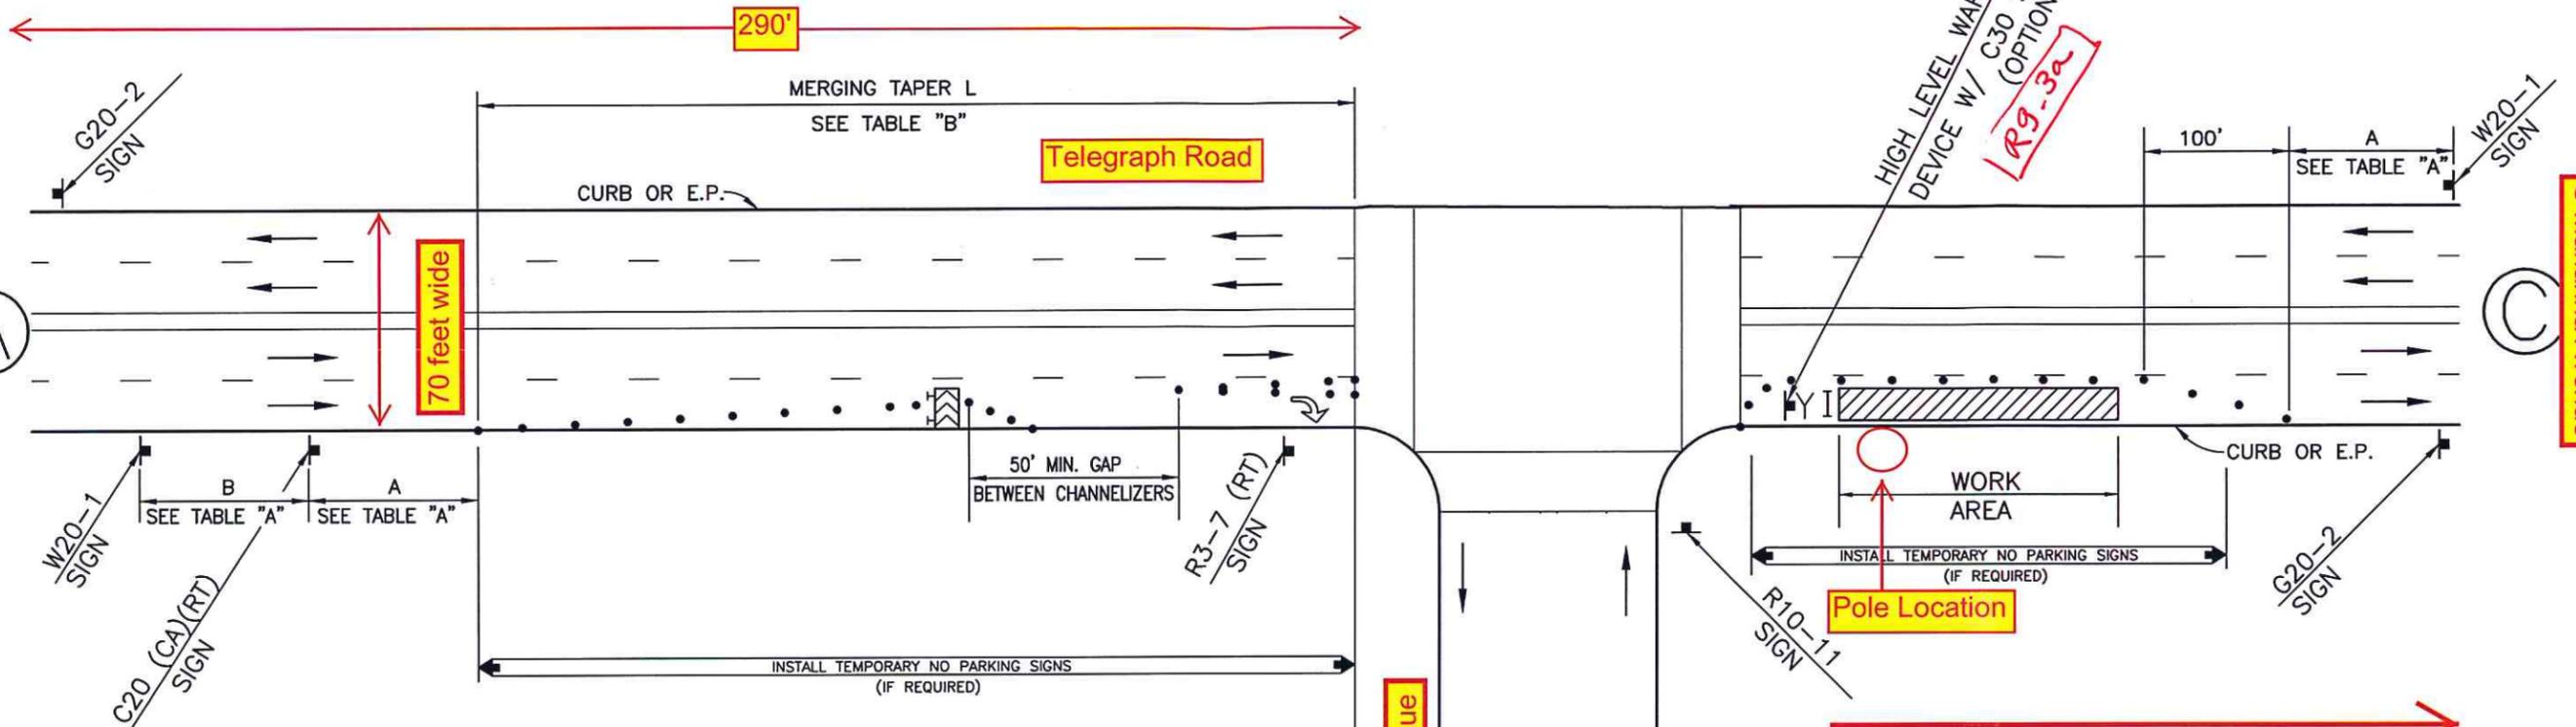

LEGEND

- TYPE III BARRICADE W/SIGN
- TYPE II BARRICADE W/O SIGN
- CHANNELIZING DEVICE
- TRAFFIC CONE WITH CLIP ON SIGN
- SIGN
- SIGNALIZED INTERSECTION
- ARROW PANEL (FLASHING ARROW) (WHERE REQUIRED)
- HIGH LEVEL WARNING DEVICE (FLAGTREE) (OPTIONAL)
- FLAGGER
- TANS TOW AWAY NO STOPPING \_\_\_\_ TO \_\_\_\_ (SHOW HOURS)
- TANSAT TOW AWAY NO STOPPING ANY TIME
- WORK ZONE (ACTIVITY AREA) LIMITS
- DIRECTION OF TRAFFIC (NOT PAVEMENT MARKING)
- ROADWAY DESIGNATION (A THROUGH D)

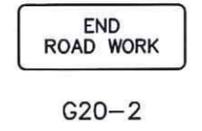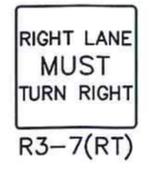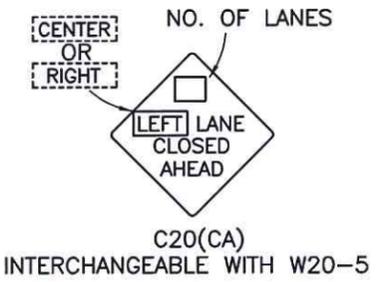

HIGH LEVEL WARNING DEVICE W/ C30 SIGN (OPTIONAL) **R9-3a**

APPROVAL TO ISSUE ENCROACHMENT PERMIT PER CITY / COUNTY STANDARDS  
 APPROVED: RAD DATE: 3/23/15  
 CONDITIONS: TCP STRICTLY ENFORCED  
Provide sidewalk closure & flaggers to direct pedestrians

4447 Telegraph Road  
 TD910283 Pole 2022433E

**WORKSITE TRAFFIC CONTROL PLAN**  
 WORK BEYOND INTERSECTION (RIGHT LANE)

DATE		SCALE	NONE
		DRAWING NO.	23

REV. APR-2010 CAUTION-DWG523.DWG



