



MARK PESTRELLA, Director

COUNTY OF LOS ANGELES

DEPARTMENT OF PUBLIC WORKS

"To Enrich Lives Through Effective and Caring Service"

900 SOUTH FREMONT AVENUE
ALHAMBRA, CALIFORNIA 91803-1331
Telephone: (626) 458-5100
<http://dpw.lacounty.gov>

ADDRESS ALL CORRESPONDENCE TO:
P.O. BOX 1460
ALHAMBRA, CALIFORNIA 91802-1460

April 16, 2025

IN REPLY PLEASE

REFER TO FILE: **BRC-2**

**NOTICE TO BIDDERS D
HARBOR-UCLA MEDICAL CENTER REPLACEMENT PROGRAM
GENERATOR BUILDING RETROFIT PROJECT COMPONENT
BID NUMBER: BRC0000569
SPECS 7962; C.P. 67961**

This Notice to Bidders D revises certain portions of the Invitation for Bids (IFB), dated February 13, 2025, for the above-named bid and is hereby made a part thereof.

a. QUESTIONS AND ANSWERS

Refer to the attached file dated April 16, 2025, "Request for Information/Clarifications", containing questions and answers, in response to the questions received from bidders.

b. BID FORMS

- 1) Replace Section 00 03 00 "Form of Bid" with the revised Section 00 03 00 (Attached).

c. PLANS

1. Replace and add Increment 1 Sheets as noted in Exhibit 14, Addendum D narrative.
2. Replace and add Increment 2 Sheets as noted in Exhibit 14, Addendum D narrative.

d. SPECIFICATIONS

1. Replace and add Increment 1 Specification Sections as noted in Exhibit 14, Addendum D narrative.
2. Replace and add Increment 2 Specification Sections as noted in Exhibit 14, Addendum D narrative.

Notice to Bidders D

April 16, 2025

Page 2

Kindly notify your subconsultants of this Notice.

If you have any questions regarding this Notice to Bidders D, you may contact Mr. Matt Jerge at (626) 476-0378 or by email at mjerge@pw.lacounty.gov.

Very truly yours,

MARK PESTRELLA, PE
Director of Public Works

Brian Soria

for Soo Kim
Division Chief
Business Relations and Contracts Division

MJ

April 16, 2025
REQUEST FOR INFORMATION/CLARIFICATIONS
HARBOR-UCLA MEDICAL CENTER REPLACEMENT PROGRAM
GENERATOR BUILDING RETROFIT PROJECT COMPONENT
BID NUMBER: BRC0000569

Question Number	Question	Answer	Answer Provided in Notice to Bidders:
1	What is the typical timeline for a shutdown notice, and would temporary generators be needed?	<p>The typical required shutdown notice period is four (4) weeks. Please refer to Exhibit 9 and notes in the plans, which outline the various shutdowns and cutovers that may be required throughout the course of the project.</p> <p>Bidders/Contractors shall provide Temporary Generators required for any major shutdowns exceeding 15 minutes in 24/7 occupied buildings, including but not limited to:</p> <ul style="list-style-type: none">•Main hospital buildings•Central Plant•Main Data Centers <p>For buildings that operate only during regular hours, work may be scheduled off-hours to avoid the need for temporary generators. However, if a data center is present in those buildings, it must be supported with Temporary Generators during shutdowns.</p> <p>Bidders/Contractor are responsible for coordinating shutdowns, obtaining approvals, and ensuring compliance with all hospital, regulatory, and project-specific requirements.</p>	A
2	Please further clarify the details of the expected responsibilities from the bidders for the scope of Owner-Furnished, Contractor-Installed (OF/CI) work, and are power studies required?	<p>The Owner-Furnished, Contractor-Installed (OF/CI) scope is outlined in Exhibit 10, which clearly defines the roles and responsibilities for OF/CI work. Bidders/Contractors must review Exhibit 10 in detail to fully understand their obligations under this project.</p> <p>Power studies are required. Bidders/Contractors shall assume that all necessary power system studies (e.g., short-circuit analysis, coordination study, arc flash study, and harmonic analysis) are required and are the responsibility of the Bidders/Contractors unless explicitly stated otherwise in the Contract Documents or Exhibit 10.</p> <p>Bidders/Contractors shall install, integrate, test, and commission all Owner-Furnished equipment per project specifications and applicable codes.</p>	A
3	Can we schedule an additional job-walk for this project?	<p>Bidders may request one additional job walk to view the project site by emailing Matt Jerge at mjerge@dpw.lacounty.gov. Additional job walks will only be conducted from April 7, 2025 through April 11, 2025.</p>	C

Question Number	Question	Answer	Answer Provided in Notice to Bidders:
4	<p>Specification 23 09 00 – 2</p> <p>Please confirm that Siemens, Johnson Controls, & Honeywell are approved DDC manufacturers? These manufacturers provide open BACnet controls systems and are equivalent to the listed acceptable manufacturer in specification 23 09 00 – 2 Section 1.3.</p> <p>By allowing these manufacturers, this will allow for competitive bidding as required per California public contracting code section 3400.</p>	<p>Per Mechanical Controls scope identified on specification 230900 section 1.3, and detail 3/sheet M301.2 keynote #4, "Contractor is to integrate new mechanical and fuel oil monitoring systems into the existing hospital BAS (Schneider Electric EcoStruxure) and coordinate with owner preferred vendor (KDC Systems)". Siemens, Johnson Controls, & Honeywell are not approved vendors, as they not authorized and licensed to work within the existing Schneider Ecostruxure platform that serves the existing Hospital.</p>	D
5	<p>Who is responsible for veeder root control panel installation, conduit, and wiring, including all sensors?</p>	<p>All described scope, including but not limited to, the veeder root control panel installation, conduit, wiring, and all sensors, shall be part of the Contractor's base bid.</p>	D
6	<p>Who is responsible for fuel oil control panel installation, conduit, and wiring, including all sensors?</p>	<p>All described scope, including but not limited to, the fuel oil control panel installation, conduit, wiring, and all sensors, should be part of the Contractor's base bid.</p>	D
	<p>1. (1) Front End Panel with the following:</p> <ul style="list-style-type: none">• (1) Network Control Panel (120-volt power not included)• (1) Ethernet Connection (assumed within room)• Any Underground conduit & wire excluded from scope <p>2. (1) Vender Root Panel with the following:</p> <ul style="list-style-type: none">• (1) MSTP BACnet to Panel Installed by Others• Controller and all sensors installed by others <p>3. (1) Fuel Oil Control Panel with the following:</p> <ul style="list-style-type: none">• (1) MSTP BACnet to Panel Installed by Others• Fuel Oil System & all sensors installed by others <p>4. VRF System:</p> <ul style="list-style-type: none">• (1) Centralized Controller (Power not included)• (2) Outdoor Condensing Unit• (4) Fan Coil Units w/ Mfg. T-STAT <p>• Any additional points e.g. 24-volt converter kits, filter, leak sensor, etc., are not included</p>	<p>All the described scope shall be part of the Contractor's base bid.</p>	D

Question Number	Question	Answer	Answer Provided in Notice to Bidders:
7	Please advise on the logistics and requirements necessary for shutting down adjacent streets to perform work.	The requirements are a two step process, allow for two week minimum to receive approval: Step 1: Submit an Facilities Management Request for Information (FMRFI) with the request. Step 2: Once FMRFI response received, submit a Construction Activity Notice (CAN) and Logistics Plan.	D
8	Please provide a logistics plan for parking, construction trailers, material and equipment Laydown.	Please use Exhibit 13 for prillimanry logitics plan assumptions which will need to be submitted by the contractor to the DHS facilities for review and	D
9	Please provide preferred Vendors for Fuel Controls/monitoring, Fire Alarm, Fire Sprinkler and HVAC Controls.	Manufacturers are listed in Specific Spec Sections. See answer to RFI #10. There are no Fire Sprinklers on the project	D
10	Are there any preferred vendors required to use on this project?	First listed manufacturer in the specs if multiple manufacturers are listed should always be the basis of design. Any substitutions need to be formally submitted per the specification. Technology Low Voltage requires a Genetec Certified Contractor.	D
11	Will the Owner provide parking for GC and Subcontractor use? If not, please provide typical parking cost.	Yes, parking shall be provided for up to 50 vevhiecles. please refer to Exhibit 13 in RFI #8.	D
12	Sheet DU2-221, Key note 1 calls to remove the existing equipment and pad for the existing gear inside the switchgear room. Please advise if existing pad can remain?	The housekeeping pad in the new battery needs to be removed. The housekeeping pad in the main switchgear room is to remain and be reused.	D
13	Is Duct Leakage testing required?	Yes, See Spec section 230593 for requirements as part of TAB requirements.	D

Question Number	Question	Answer	Answer Provided in Notice to Bidders:
14	Reference Inc. #1 Electrical Sheet DU1-214.2 (Bottom Right Corner) Feeder Designations: G002, S001B, C003 & F001. These listed feeder designations are listed on electrical sheet DU1-214.2 and there is a note next to the feeder runs that states: see continued on sheet DU1-214.3. Once on sheet DU1-214.3 there is nothing listed and we need to know where these feeder (conduit's) connect to or what equipment they connect to. Please advise.	G002, S001B, C003, and F001 do not continue on DU1-214.3. See Special Notes 1 and 2 on DU1-214.2 Just to the east of Manhole MVMH-N-19/20 there is a cap shown where these conduits connect to the conduits that are installed by the Inc 2 contractor. See Addendum D.	D
15	Reference Inc. #1 Electrical sheets (conduit and cable schedules). There are feeder designations (P627, P628, P629, P630, P631A, L001B and L002B shown on the conduit and cable schedule but these are not shown on the Inc. #1 drawings. Please provide an electrical site drawing showing these conduit feeder locations, otherwise we will assume that they are N.I.C.	P627, P628, P629 and P630 are NIC and will be removed from the conduit and cable schedule on DU1-403.1, see Addendum D. P631A is shown at the bottom of DU1-212 to the west of manhole MVMH-N-19/20. L001B and L002B can be found on DU1-221 and DU1-224 in Addendum D. DU1-214.3 has been renumbered to DU1-224 in Addendum D.	D
16	Reference Inc. #1 Electrical sheet DU1-214.3 and Conduit and Cable Schedule sheet DU1-402.1 (Feeder tags L001 & L002). Looking at sheet DU1-214.3 there you will see feeder conduit tags (L001 & L002) with a Note #2 next to them. Note #2 states: Install cable into existing conduits. Sheet DU1-402.1 feeder tags (L001 & L002) tell us to install new (2) 2" PVC/IMC conduits and NO wire. Please advise as to what the scope of work is for feeder designations. (L001 & L002).	Feeder tags on DU1-214.3 were renumbered from L001 and L002 to L001B and L002B. DU1-214.3 was renumbered to DU1-224 in Addendum D. L001 L002 is Inc 1 contractor scope to install conduit only in Milestone 1. L001A and L002A is Inc 2 contractor scope to install conduit only in Milestone 1. L001B and L002B is Inc 1 contractor scope to install cable in Milestone 2.	D
17	INC 2 Milestone 3 - says to turn o@ LSC4 and pull new cables from new 011-01-EMV-SGR-02-GB-23 to MVMH-E-01E and splice. LSC4 feeder needs to be moved somewhere prior to the new EMV-SGR-02 to be installed. It does not show when and where LSC4 feeder is to be refed to allow for the existing switchgear to be removed so that new switchgear can be installed? Please Advise.	In Milestone 3, the existing generator building switchgear from which LSC4 is connected to is still installed. After new switchgear 011-01-EMV-SGR-02 (PART A) is installed, a new feeder is to be installed from breaker GB-23 through a different conduit system than LSC4 is installed in to manhole MVMH-E-01E and spliced to the portion of LSC4 that is connected to breaker GP-31. See drawing DU1-223 for new conduit path and DU1-234 for new cable from 011-01-EMV-SGR-02 (PART A).	D
18	Are there any Badge requirements for this facility? If so, please provide cost to obtain a badge.	Yes,badging is required. Vendormate, the HUCLA approved badging service.	D
19	Per the job walk it was discussed that GC is to remove all trees and shrubbery and the leftover foam insulation debris on site. Please confirm or advise.	Confirmed. This should be part of your base bid.	D
20	Per the job walk, it was discussed that the GC is to include allowances for unforeseen utilities. Please provide amount to be included in bid.	Bidder to include a contingency to be used for corrections associated with unforeseen utilities conditions discovered during construction. Please breakout the contingency under Division 01 - 01 73 00. Please see updated Form of Bid attached to this Notice.	D
21	For the owner furnished equipment to be installed by the contractor, is there a specific person who should be contacted from CAT/QUINN Power Systems for details on scope, cost, and warranty for work to be included in contractor's bid?	Yes, please contact Andrew Salem, the Product Support Sales Manager at 562-463-4782 Phone 626-862-7870 Cell andrew.salem@quinnpower.com www.quinnpower.com	D

EXHIBIT 13

Conceptual Logistics Plan

- 1. Conceptual Logistics Plan: Prepared by DPW dated 04/15/2025**

Exhibit #13

Construction Trailers - Option #2

Construction Trailers/Laydown - Option #1

Material and Equipment Laydown - Option #2

Material and Equipment Laydown - Option #1

Parking - PS-A - Option 2

Project Site Area

Parking - Lot V - Option 1

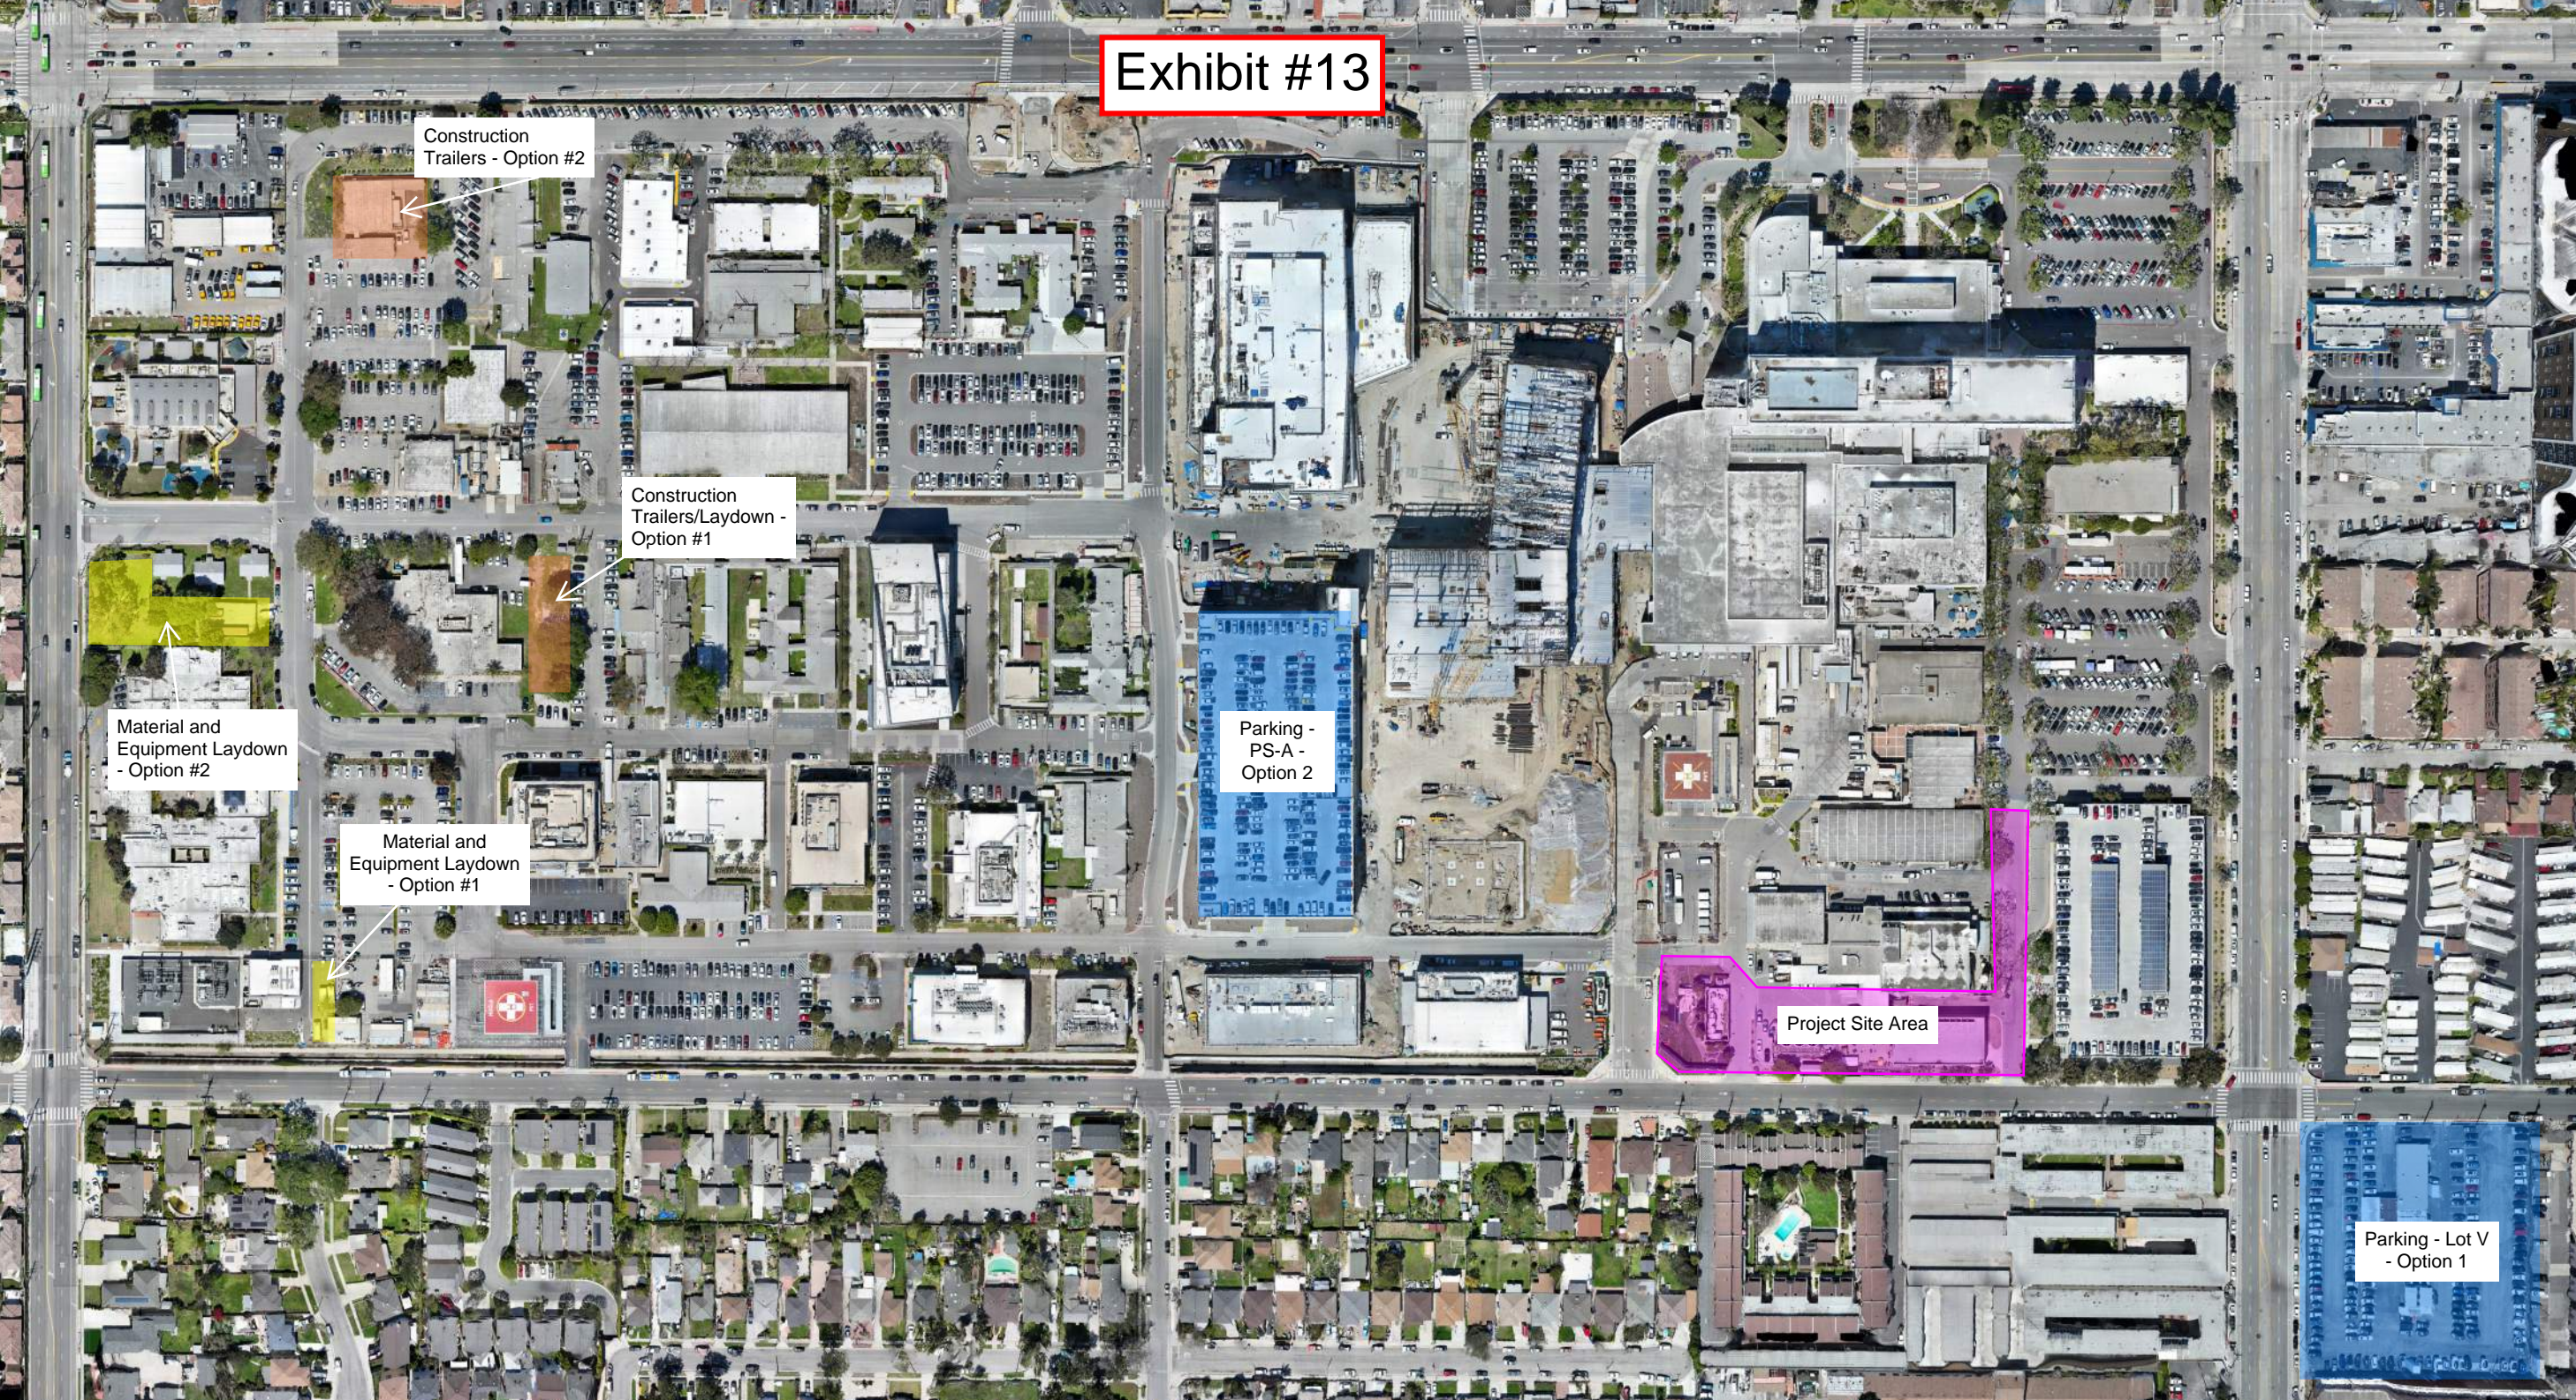


EXHIBIT 14 - Addendum D

1. Addendum D Narrative: Prepared by RBB Architects dated April 11, 2025



LAC/Harbor-UCLA Medical Center
ADDENDUM NO. D
Phase 2E Redesign Emergency Generator Service
Inc. 1 – 12kV General Access Power (GAP) Switchgear Building
Inc. 2 - Generator Building Retrofit
RBB PROJECT NO. 1712076

4/11/25
Page 1

ADDENDUM NO. D

To RBB Architects Drawings, Specifications, and Project Documents for:

LAC/Harbor-UCLA Medical Center
Phase 2E Inc. 1 – 12kV General Access Power (GAP) Switchgear Building
Inc. 2 – Generator Building Retrofit

RBB ARCHITECTS INC

Joseph A. Balbona, AIA
Sylvia Botero, AIA
Kevin S. Boots, AIA
Melissa L. Keiser, AIA
Craig S. Laurie

10980 Wilshire Boulevard
Los Angeles, California
90024-3905

Telephone 310 473 3555
www.rbbinc.com

RBB ARCHITECTS INC
10980 Wilshire Blvd.
Los Angeles, CA 90024-3905

RBB # 1712076
OSHPD # I240005-19-01 / # I240005-19-02
Client # BRC #0000569 / Spec # 7962

NOTICE

The following clarification's, additions, and/or deletions shall, by this reference, be incorporated into the Contract Specifications and/or Drawings authored by RBB Architect Inc. or its Consultants as though fully set forth therein.

DOCUMENTS ISSUED WITH THIS ADDENDUM

None

DOCUMENTS REVISED WITH THIS ADDENDUM

None

DOCUMENTS REISSUED WITH THIS ADDENDUM

None

DRAWINGS REISSUED WITH THIS ADDENDUM

None

Inc. 1 DRAWINGS ISSUED WITH THIS ADDENDUM

None



Inc. 2 DRAWINGS ISSUED WITH THIS ADDENDUM

None

Inc. 1 DRAWINGS REVISED WITH THIS ADDENDUM

- DU1-004** – Added general notes to provide additional requirements for contractor.
- DU1-005** – Added steps to Sequence of Installation for installation of HVAC and Plumbing equipment.
- DU1-212** – Clarified “Electrical Lines” to “Electrical Underground Ductbank Conduit Lines” on Note 5.
- DU1-221** – Added power cables between switchgear sections and added notes 14 and 15.
- DU1-543** – Removed note 3.

Inc. 2 DRAWINGS REVISED WITH THIS ADDENDUM

- A300.2** – Added panic hardware to (3) existing doors in the portion of the existing Emergency Generator Building where new Switchgear will be installed.
- A511.2** – On the enlarged plan of the existing Emergency Generator Building are now showing the existing doors that are to receive panic hardware.
- P011.2** – Plumbing Schedules - Added the voltage requirements for the Fuel Oil Filter cabinet.
- P101.2** – Plumbing Partial Site Plan - Added the existing utilities, i.e. sewer, storm drain, and electrical lines to the Site Plan. Rerouted the Fuel Oil supply and return piping to avoid the existing underground utilities. Revised plumbing notes to reference the correct details. Added the Fuel Tank Overfill Alarm location at each tank. Indicated the location of the Building Engineers office in the Central Plant.
- P211.2** – Plumbing Level 1 Plan - Added the existing underground utilities on this sheet for reference. Relocated Fuel Oil Filter inside the building to avoid the existing electrical panel. Revised plumbing notes for the new fuel pump control panel. Revised the plumbing notes at the existing and new leak and inventory control and monitoring panels. Relocated the transition sump, supply and return lines into the building to avoid the existing underground utilities.
- P220.2** - Revised the detail callout information on the tank vents.
- P301.2** - Added note G to the FUEL CONTROL AND MONITORING SEQUENCE OF OPERATION notes.
- P302.2** - Revised the Fuel Oil piping to and from the Fuel Oil Filter Cabinet. Revised the fuel oil supply and return lines with the transition sump location.
- P303.2** - Revised notes on the control panels to tie to the BMS System in the Central Plants Building Engineers office. Revised callout to Veeder Root. Revised note on the existing daytank solenoid wiring.
- P304.2** - Revised notes on the control panels to tie to the BMS System in the Central Plants Building Engineers office.
- P800.2** – Plumbing Details - Revised product name on Detail #1
- P801.2** – Plumbing Details - Revised underground piping in trench detail to include additional widths. Revised the Fuel Oil Cabinet detail.

- DU2-004** – Added general notes to provide additional requirements for contractor.
- DU2-004** – Updated feeders to fuel pumps on Note 1.



DU2-006 – Added steps to Sequence of Installation for installation of HVAC and Plumbing equipment.

DU2-213 – Updated conduit identification number

DU2-215.1 – Added existing starters and pump controllers. Added Note 4 for demo instructions.

DU2-215.2 – Removed Notes 6 and 10.

DU2-216.2 – Moved detail 2 and added tap detail added notes for tap. Changed circuits on some light circuits.

DU2-225 – Added wiring for battery chargers, added power cables between switchgear, added notes for both.

DU2-245 – Added plumbing power to various equipment, to control panel, and to site. Added notes 3-12.

DU2-401.1 – Fixed pole number of panel pc circuit 29/31.

DU2-401.2 – Adjusted loads being moved around on panels.

DU2-401.3 – Adjusted loads being moved around on panels.

DU2-401.4 – Moved panels around, matched loads with previous steps.

DU2-401.5 – Updated loads. Updated where battery chargers are fed from.

DU2-511 – Added additional requirements to general note 8.

DU2-512 – Update general note 2 to clarify what the load is for.

DU2-513 - Added additional requirements to general note 6.

DU2-604 – Corrected vertical placement of equipment.

FA010.2 – Fire Alarm Symbols and Abbreviations - Revised C.S.F.M. listings for the Conventional Heat Sensor and Fire Alarm Control Panel.

Inc. 1 SPECIFICATIONS REVISIONS ISSUED WITH THIS ADDENDUM

None

Inc. 2 SPECIFICATIONS REVISIONS ISSUED WITH THIS ADDENDUM

221324 Facility Fuel-Oil Piping - Revised Leak Detection and Monitoring system manufacturer and model number in spec section 2.9. A.1.

SPECIFICATIONS SECTIONS ISSUED WITH THIS ADDENDUM

None

SPECIFICATIONS SECTIONS REISSUED WITH THIS ADDENDUM

None

END OF ADDENDUM D

SECTION 221324 - FACILITY FUEL-OIL PIPING

PART 1 - GENERAL

1.1 RELATED DOCUMENTS

- A. Drawings and general provisions of the Contract, including General and Supplementary Conditions and Division 01 Specification Sections, apply to this Section.

1.2 SUMMARY

- A. Section Includes:
 - 1. Fuel-oil pipes, tubes, and fittings.
 - 2. Double-containment piping and fittings.
 - 3. Piping specialties.
 - 4. Joining materials.
 - 5. Specialty valves.
 - 6. Mechanical leak-detection valves.
 - 7. Leak detection and monitoring system.
 - 8. Labels and identification.

1.3 DEFINITIONS

- A. Exposed, Interior Installations: Exposed to view indoors. Examples include finished occupied spaces and mechanical equipment rooms.
- B. Exposed, Exterior Installations: Exposed to view outdoors or subject to outdoor ambient temperatures and weather conditions. Examples include rooftop locations.
- C. Finished Spaces: Spaces other than mechanical and electrical equipment rooms, furred spaces, pipe and duct shafts, unheated spaces immediately below roof, spaces above ceilings, unexcavated spaces, crawlspaces, and tunnels.

1.4 ACTION SUBMITTALS

- A. Product Data: For each type of product.
 - 1. Include construction details, material descriptions, and dimensions of individual components and profiles.
 - 2. Include, where applicable, rated capacities, operating characteristics, electrical characteristics, and furnished specialties and accessories.
 - 3. For valves, include pressure rating, capacity, settings, and electrical connection data of selected models.
- B. Shop Drawings: For fuel-oil piping.
 - 1. Include plans, elevations sections, hangers, and supports for multiple pipes.
 - 2. Include details of location of anchors, alignment guides, and expansion joints and loops.

- C. Delegated-Design Submittal: For fuel-oil piping indicated to comply with performance requirements and design criteria.

1. Include analysis data signed and sealed by the qualified professional engineer responsible for their preparation.
2. Detail fabrication and assembly of anchors and seismic restraints.
3. Design Calculations: Calculate requirements for selecting seismic restraints.
4. Detail fabrication and assembly of pipe anchors, hangers, supports for multiple pipes, and attachments of the same to building structure.

1.5 INFORMATIONAL SUBMITTALS

- A. Coordination Drawings:

1. Plans and details, drawn to scale, on which fuel-oil piping is shown and coordinated with other installations, using input from installers of the items involved.
2. Site Survey: Plans, drawn to scale, on which fuel-oil piping and tanks are shown and coordinated with other services and utilities.

- B. Brazing certificates.

- C. Welding certificates.

- D. Field quality-control reports.

- E. Sample Warranty: For special warranty.

1.6 CLOSEOUT SUBMITTALS

- A. Operation and Maintenance Data: For fuel-oil equipment and accessories to include in emergency, operation, and maintenance manuals.

1.7 MAINTENANCE MATERIAL SUBMITTALS

- A. Furnish extra materials that match products installed and that are packaged with protective covering for storage and identified with labels describing contents.

1.8 QUALITY ASSURANCE

- A. Brazing: Qualify processes and operators according to ASME Boiler and Pressure Vessel Code: Section IX.
- B. Steel Support Welding Qualifications: Qualify procedures and personnel according to AWS D1.1/D1.1M, "Structural Welding Code - Steel."
- C. Pipe Welding Qualifications: Qualify procedures and personnel according to ASME Boiler and Pressure Vessel Code.

1.9 DELIVERY, STORAGE, AND HANDLING

- A. Lift and support fuel-oil storage tanks only at designated lifting or supporting points, as shown on Shop Drawings. Do not move or lift tanks unless empty.
- B. Deliver pipes and tubes with factory-applied end caps. Maintain end caps through shipping, storage, and handling to prevent pipe end damage and to prevent entrance of dirt, debris, and moisture.
- C. Store pipes and tubes with protective PE coating to avoid damaging the coating and to protect from direct sunlight.
- D. Store PE pipes and valves protected from direct sunlight.

1.10 FIELD CONDITIONS

- A. Interruption of Existing Fuel-Oil Service: Do not interrupt fuel-oil service to facilities occupied by Owner or others unless permitted under the following conditions and then only after arranging to provide temporary fuel-oil supply according to requirements indicated:
 - 1. Notify Owner no fewer than two days in advance of proposed interruption of fuel-oil service.
 - 2. Do not proceed with interruption of fuel-oil service without Owner's written permission.

1.11 WARRANTY

- A. Special Warranty: Manufacturer agrees to repair or replace components of flexible, double-containment piping and related equipment that fail in materials or workmanship within specified warranty period.
 - 1. Failures due to defective materials or workmanship for materials including piping, dispenser sumps, water-tight sump entry boots, terminations, and other end fittings.

PART 2 - PRODUCTS

2.1 SYSTEM DESCRIPTION

- A. Electrical Components, Devices, and Accessories: Listed and labeled as defined in NFPA 70, by a qualified testing agency, and marked for intended location and application.
- B. Comply with ASME B31.9, "Building Services Piping," for fuel-oil piping materials, installation, testing, and inspecting.
- C. Fuel-Oil Valves: Comply with UL 842 and have service mark initials "WOG" permanently marked on valve body.
- D. Comply with requirements of the EPA and of state and local authorities having jurisdiction. Include recording of fuel-oil piping.

2.2 PERFORMANCE REQUIREMENTS

- A. Maximum Operating-Pressure Ratings: 3-psig fuel-oil supply pressure at oil-fired appliances.

- B. Delegated Design: Engage a qualified professional engineer, as defined in Section 014000 "Quality Requirements," to design restraints and anchors and multiple pipe supports and hangers for fuel-oil piping.

2.3 FUEL-OIL PIPES, TUBES, AND FITTINGS

- A. See "Outdoor Piping Installation" and "Indoor Piping Installation" articles for where pipes, tubes, fittings, and joining materials are applied in various services.
- B. Steel Pipe: ASTM A 53/A 53M, black steel, Schedule 40, Type E or S, Grade B.
 - 1. Malleable-Iron Threaded Fittings: ASME B16.3, Class 150, standard pattern.
 - 2. Wrought-Steel Welding Fittings: ASTM A 234/A 234M, for butt and socket welding.
 - 3. Unions: ASME B16.39, Class 150, malleable iron with brass-to-iron seat, ground joint, and threaded ends.
 - 4. Forged-Steel Flanges and Flanged Fittings: ASME B16.5, minimum Class 150, including bolts, nuts, and gaskets of the following material group, end connections, and facings:
 - a. Material Group: 1.1.
 - b. End Connections: Threaded or butt welding to match pipe.
 - c. Lapped Face: Not permitted underground.
 - d. Gasket Materials: Asbestos free, ASME B16.20 metallic, or ASME B16.21 nonmetallic, gaskets compatible with fuel oil.
 - e. Bolts and Nuts: ASME B18.2.1, cadmium-plated steel.
 - 5. Protective Coating for Underground Piping: Factory-applied, three-layer coating of epoxy, adhesive, and PE.
 - a. Joint Cover Kits: Epoxy paint, adhesive, and heat-shrink PE sleeves.

2.4 DOUBLE-CONTAINMENT PIPE AND FITTINGS

- A. Flexible, Metallic, Double-Containment Piping: Comply with UL 971A.
 - 1. Franklin Fueling Systems
 - 2. Pipe Materials:
 - a. Metallic Lining: ASTM A 240/ASTM A 240M Type 304 corrugated stainless-steel tubing.
 - b. Carrier Pipe: Fluoropolymer tube.
 - c. Jacket: UV stabilized.
 - 3. Fiberglass transition sumps with wWatertight sump entry boots, pipe adapters with test ports and tubes, coaxial fittings, and couplings.
 - 4. Minimum Operating Pressure Rating: 10 psig.
 - 5. Plastic to Steel Pipe Transition Fittings: Factory-fabricated fittings with plastic end matching or compatible with carrier piping, and steel pipe end complying with ASTM A 53/A 53M, black steel, Schedule 40, Type E or S, Grade B.
 - 6. Include design and fabrication of double-containment pipe and fitting assemblies with provision for field installation of cable leak-detection system in annular space between carrier and containment piping.
- B. Rigid, Double-Containment Piping: Comply with UL 971.

1. 3000 American Series
2. AO Smith Inland
3. RTRP: ASTM D 2996 or ASTM D 2997 carrier and containment piping and mechanical couplings to seal carrier and containment piping or individually bonded joints.
 - a. Minimum Operating-Pressure Rating for RTRP NPS 2 and NPS 3: 150 psig.
 - b. Minimum Operating-Pressure Rating for RTRP NPS 4 and NPS 6: 125 psig. Compliance with UL 971 is not required for NPS 6 and larger piping.
 - c. Fittings: RTRF complying with ASTM D 2996 or ASTM D 2997 and made by RTRP manufacturer; watertight sump entry boots, termination, or other end fittings.
4. Leak-Detection System: Include design and fabrication of double-containment pipe and fitting assemblies with provision for field installation of cable leak-detection system in annular space between carrier and containment piping.

2.5 PIPING SPECIALTIES

A. Metallic Flexible Connectors:

1. Franklin Fueling Systems
2. Listed and labeled for aboveground and underground applications by an NRTL acceptable to authorities having jurisdiction.
3. Stainless-steel bellows with woven, flexible, bronze or stainless-steel, wire-reinforcing protective jacket.
4. Minimum Operating Pressure: 150 psig.
5. End Connections: Socket, flanged, or threaded end to match connected piping.
6. Maximum Length: 30 inches
7. Swivel end, 50-psig maximum operating pressure.
8. Factory-furnished anode for connection to cathodic protection.

B. Y-Pattern Strainers:

1. Body: ASTM A 126, Class B, cast iron with bolted cover and bottom drain connection.
2. End Connections: Threaded ends for NPS 2 and smaller.
3. Strainer Screen: 80-mesh startup strainer and perforated stainless-steel basket with 50 percent free area.
4. CWP Rating: 125 psig.

C. Basket Strainers:

1. Body: ASTM A 126, Class B, high-tensile cast iron with bolted cover and bottom drain connection.
2. End Connections: Threaded ends for NPS 2 and smaller.
3. Strainer Screen: 80-mesh startup strainer and perforated stainless-steel basket with 50 percent free area.
4. CWP Rating: 125 psig.

D. T-Pattern Strainers:

1. Body: Ductile or malleable iron with removable access coupling and end cap for strainer maintenance.
2. End Connections: Grooved ends.
3. Strainer Screen: 80-mesh startup strainer and perforated stainless-steel basket with 57 percent free area.

4. CWP Rating: 750 psig.

E. Manual Air Vents:

1. Body: Bronze.
2. Internal Parts: Nonferrous.
3. Operator: Screwdriver or thumbscrew.
4. Inlet Connection: NPS 1/2.
5. Discharge Connection: NPS 1/8.
6. CWP Rating: 150 psig.
7. Maximum Operating Temperature: 225 deg F.

2.6 JOINING MATERIALS

- A. Joint Compound and Tape for Threaded Joints: Suitable for fuel oil.
- B. Welding Filler Metals: Comply with AWS D10.12/D10.12M for welding materials appropriate for wall thickness and chemical analysis of steel pipe being welded.
- C. Brazing Filler Metals: Alloy with melting point greater than 1000 deg F complying with AWS A5.8/A5.8M. Brazing alloys containing more than 0.05 percent phosphorus are prohibited.
- D. Bonding Adhesive for RTRP and RTRF: As recommended by piping and fitting manufacturer.

2.7 SPECIALTY VALVES

A. Pressure Relief Valves:

1. Universal
2. Listed and labeled for fuel-oil service by an NRTL acceptable to authorities having jurisdiction.
3. Body: Brass, bronze, or cast steel.
4. Springs: Stainless steel, interchangeable.
5. Seat and Seal: Nitrile rubber.
6. Orifice: Stainless steel, interchangeable.
7. Factory-Applied Finish: Baked enamel.
8. Maximum Inlet Pressure: 150 psig.
9. Relief Pressure Setting: 60 psig.

B. Oil Safety Valves:

1. Universal
2. Listed and labeled for fuel-oil service by an NRTL acceptable to authorities having jurisdiction.
3. Body: Brass, bronze, or cast steel.
4. Springs: Stainless steel.
5. Seat and Diaphragm: Nitrile rubber.
6. Orifice: Stainless steel, interchangeable.
7. Factory-Applied Finish: Baked enamel.
8. Manual override port.
9. Maximum Inlet Pressure: 60 psig.
10. Maximum Outlet Pressure: 3 psig.

C. Emergency Shutoff Valves:

1. Universal
2. Listed and labeled for fuel-oil service by an NRTL acceptable to authorities having jurisdiction.
3. Double poppet valve.
4. Body: ASTM A 126, cast iron.
5. Disk: FPM.
6. Poppet Spring: Stainless steel.
7. Stem: Plated brass.
8. O-Ring: FPM.
9. Packing Nut: PTFE-coated brass.
10. Fusible link to close valve at 165 deg F.
11. Thermal relief to vent line pressure buildup due to fire.
12. Air test port.
13. Maximum Operating Pressure: 0.5 psig.

2.8 MECHANICAL LEAK-DETECTION VALVES

- A. Universal
- B. Listed and labeled for fuel-oil service by an NRTL acceptable to authorities having jurisdiction.
- C. Body: ASTM A 126, cast iron.
- D. O-Rings: Elastomeric compatible with fuel oil.
- E. Piston and Stem Seals: PTFE.
- F. Stem and Spring: Stainless steel.
- G. Piston Cylinder: Burnished brass.
- H. Indicated Leak Rate: Maximum 3 gph at 10 psig.
- I. Leak Indication: Reduced flow.

2.9 LEAK-DETECTION AND MONITORING SYSTEM

- A. Cable and Sensor System: Comply with UL 1238.

1. Veeder-Root TLS-450PLUS Automatic Tank Gauge Fuel Management System.
2. Calibrated leak-detection, inventory and monitoring system with probes and other sensors and remote alarm panel for fuel-oil piping with printer.
3. Monitor siter performance, receive real-time alerts, with a wide range of options, store up to 3 years data and protect it from power outages, battery replacement, or software upgrades.
4. Include fittings and devices required for testing.
5. Provide interface for connection to Level and Leak Detection and Monitoring System and Building Automation System (BAS). Interface shall provide information on actual fuel level for each tank, level alarms for each tank, inventory management and product order notification. Coordinate monitoring and controls with Main Fuel Receiving Port controls and Level and Leak Detection and Monitoring System.



2.10 LABELS AND IDENTIFICATION

- A. Detectable Warning Tape: Acid- and alkali-resistant PE film warning tape manufactured for marking and identifying underground utilities, a minimum of 6 inches wide and 4 mils thick, continuously inscribed with a description of utility, with metallic core encased in a protective jacket for corrosion protection, detectable by metal detector when tape is buried up to 30 inches deep; colored yellow.

PART 3 - EXECUTION

3.1 EXAMINATION

- A. Examine areas for compliance with requirements for installation tolerances and other conditions affecting performance of fuel-oil piping.
- B. Examine installation of fuel-burning equipment and fuel-handling and storage equipment to verify actual locations of piping connections before installing fuel-oil piping.
- C. Proceed with installation only after unsatisfactory conditions have been corrected.

3.2 EARTHWORK

- A. Comply with requirements in Section 312~~333000~~ "Excavating, Backfilling and Compaction For Utilities~~earth-Moving~~" for excavating, trenching, and backfilling.

3.3 PREPARATION

- A. Close equipment shutoff valves before turning off fuel oil to premises or piping section.
- B. Comply with NFPA 30 and NFPA 31 requirements for prevention of accidental ignition.

3.4 OUTDOOR PIPING INSTALLATION

- A. Install Underground Fuel-Oil Piping Buried:
 - 1. Under Compacted Backfill: 18 inches below finished grade.
 - 2. Under Asphalt 2 Inches Thick: 8 inches below bottom of asphalt.
 - 3. Under 4 Inches of Reinforced Concrete in Areas Subject to Vehicle Traffic: 4 inches below bottom of concrete.
 - 4. Comply with requirements in Section 312000 "Earth Moving" for excavating, trenching, and backfilling.
- B. Steel Piping with Protective Coating:
 - 1. Apply joint cover kits to pipe after joining, to cover, seal, and protect joints.
 - 2. Repair damage to PE coating on pipe as recommended in writing by protective coating manufacturer. Review protective coating damage with Architect prior to repair.
 - 3. Replace pipe having damaged PE coating with new pipe.

- C. Install double-containment, fuel-oil pipe at a minimum slope of 1 percent downward toward fuel-oil storage tank sump.
- D. Install vent pipe at a minimum slope of 2 percent downward toward fuel-oil storage tank sump.
- E. Assemble and install entry boots for pipe penetrations through sump sidewalls for liquid-tight joints.
- F. Install metal pipes and tubes, fittings, valves, and flexible connectors at piping connections to AST and UST.
- G. Install fittings for changes in direction in rigid pipe.
- H. Install system components with pressure rating equal to or greater than system operating pressure.

3.5 INDOOR PIPING INSTALLATION

- A. Drawing plans, schematics, and diagrams indicate general location and arrangement of piping systems. Indicated locations and arrangements are used to size pipe and calculate friction loss, expansion, and other design considerations. Install piping as indicated unless deviations to layout are approved on Coordination Drawings.
- B. Arrange for pipe spaces, chases, slots, sleeves, and openings in building structure during progress of construction to allow for mechanical installations.
- C. Install piping in concealed locations unless otherwise indicated and except in equipment rooms and service areas.
- D. Install piping indicated to be exposed and piping in equipment rooms and service areas at right angles or parallel to building walls. Diagonal runs are prohibited unless specifically indicated otherwise.
- E. Install piping above accessible ceilings at a height that allows sufficient space for ceiling panel removal.
- F. Install piping free of sags and bends.
- G. Install fittings for changes in direction and branch connections.
- H. Comply with requirements for equipment specifications for roughing-in requirements.
- I. Conceal pipe installations in walls, pipe spaces, or utility spaces; above ceilings; below grade or floors; and in floor channels unless indicated to be exposed to view.
- J. Prohibited Locations:
 - 1. Do not install fuel-oil piping in or through HVAC ducts and plenums, clothes or trash chutes, chimneys or gas vents (flues), ventilating ducts, or dumbwaiter or elevator shafts.
 - 2. Do not install fuel-oil piping in solid walls or partitions.
- K. Use eccentric reducer fittings to make reductions in pipe sizes. Install fittings with level side down.
- L. Connect branch piping from top or side of horizontal piping.
- M. Install unions in pipes NPS 2 and smaller at final connection to each piece of equipment and elsewhere as indicated. Unions are not required on flanged devices.
- N. Do not use fuel-oil piping as grounding electrode.

3.6 VALVE INSTALLATION

- A. Install manual fuel-oil shutoff valves on branch connections to fuel-oil appliance.
- B. Install valves in accessible locations.
- C. Install oil safety valves at inlet of each oil-fired appliance.

- D. Install pressure relief valves in distribution piping between the supply and return lines.
- E. Install one-piece, bronze ball valve with hose end connection at low points in fuel-oil piping. Comply with requirements in Section 2201116-2.4 "Ball Valves for Plumbing Piping."
- F. Install manual air vents at high points in fuel-oil piping.
- G. Install emergency shutoff valves at dispensers.

3.7 PIPING JOINT CONSTRUCTION

- A. Ream ends of pipes and tubes and remove burrs.
- B. Remove scale, slag, dirt, and debris from inside and outside of pipe and fittings before assembly.
- C. Threaded Joints: Thread pipe with tapered pipe threads according to ASME B1.20.1. Cut threads full and clean using sharp dies. Ream threaded pipe ends to remove burrs and restore full ID. Join pipe fittings and valves as follows:
 - 1. Apply appropriate tape or thread compound to external pipe threads unless dry seal threading is specified.
 - 2. Damaged Threads: Do not use pipe or pipe fittings with threads that are corroded or damaged. Do not use pipe sections that have cracked or open welds.
- D. Welded Joints: Construct joints according to AWS D10.12/D10.12M, using qualified processes and welding operators according to "Quality Assurance" Article.
 - 1. Bevel plain ends of steel pipe.
 - 2. Patch factory-applied protective coating as recommended by manufacturer at field welds and where damage to coating occurs during construction.
- E. Brazed Joints: Construct joints according to AWS's "Brazing Handbook," "Pipe and Tubing" Chapter.
- F. Flanged Joints: Install gasket material, size, type, and thickness for service application. Install gasket concentrically positioned.
- G. Flared Joints: Comply with SAE J513. Tighten finger tight then use wrench according to fitting manufacturer's written instructions. Do not overtighten.
- H. Fiberglass-Bonded Joints: Prepare pipe ends and fittings, apply adhesive, and join according to pipe manufacturer's written instructions.

3.8 HANGER AND SUPPORT INSTALLATION

- A. Pipe hanger and support and equipment support materials and installation requirements are specified in Section 230529 "Hangers and Supports for HVAC Piping and Equipment."
- B. Install hangers for horizontal steel piping with the following maximum spacing and minimum rod sizes:
 - 1. NPS 1-1/4 and Smaller: Maximum span, 84 inches; minimum rod size, 3/8 inch.
 - 2. NPS 1-1/2: Maximum span, 108 inches; minimum rod size, 3/8 inch.

3. NPS 2: Maximum span, 10 feet; minimum rod size, 3/8 inch.
4. NPS 2-1/2: Maximum span, 11 feet; minimum rod size, 1/2 inch.
5. NPS 3: Maximum span, 12 feet; minimum rod size, 1/2 inch.
6. NPS 4: Maximum span, 13 feet; minimum rod size, 5/8 inch.

- C. Support vertical steel pipe at each floor and at spacing not greater than 15 feet.
- D. Install hangers for horizontal, drawn-temper copper tubing with the following maximum spacing and minimum rod sizes:
1. NPS 3/4 and Smaller: Maximum span, 60 inches; minimum rod size, 3/8 inch.
 2. NPS 1: Maximum span, 72 inches; minimum rod size, 3/8 inch.
 3. NPS 1-1/4: Maximum span, 84 inches; minimum rod size, 3/8 inch.
 4. NPS 1-1/2 and NPS 2: Maximum span, 96 inches; minimum rod size, 3/8 inch.
 5. NPS 2-1/2: Maximum span, 108 inches; minimum rod size, 1/2 inch.
 6. NPS 3: Maximum span, 10 feet; minimum rod size, 1/2 inch.
 7. NPS 4: Maximum span, 11 feet; minimum rod size, 5/8 inch.
- E. Support vertical copper tube at each floor and at spacing not greater than 10 feet.

3.9 LEAK-DETECTION AND MONITORING SYSTEM INSTALLATION

- A. Install leak-detection and monitoring system. Install alarm panel inside building where indicated.
- B. Double-Containment, Fuel-Oil Piping: Install leak-detection sensor probes at low points in piping.

3.10 CONNECTIONS

- A. Where installing piping adjacent to equipment, allow space for service and maintenance.
- B. Install unions, in piping NPS 2 and smaller, adjacent to each valve and at final connection to each piece of equipment having threaded pipe connection.
- C. Install flanges, in piping NPS 2-1/2 and larger, adjacent to flanged valves and at final connection to each piece of equipment having flanged pipe connection.
- D. Connect piping to equipment with shutoff valve and union. Install union between valve and equipment.
- E. Install flexible piping connectors at final connection to burners or oil-fired appliances.

3.11 LABELING AND IDENTIFYING

- A. Nameplates, pipe identification, valve tags, and signs are specified in Section 230553 "Identification for HVAC Piping and Equipment."
- B. Equipment Nameplates and Signs: Install engraved plastic-laminate equipment nameplates and signs on or near each service regulator, service meter, and earthquake valve.
1. Text: In addition to identifying unit, distinguish between multiple units; inform operator of operational requirements; indicate safety and emergency precautions; and warn of hazards and improper operations.

- C. Install detectable warning tape directly above fuel-oil piping, 12 inches below finished grade, except 6 inches below subgrade under pavements and slabs. Terminate tracer wire in an accessible area and identify as "tracer wire" for future use with plastic-laminate sign.

1. Piping: Over underground fuel-oil distribution piping.

3.12 FIELD QUALITY CONTROL

- A. Pressure Test Piping: Minimum hydrostatic or pneumatic test-pressures measured at highest point in system:

1. Fuel-Oil Distribution Piping: Minimum 100 psig for minimum 6 hours

2. Fuel-Oil, Double-Containment Piping:

- a. Carrier Pipe: Minimum 100 psig for minimum 6 hours.
- b. Containment Conduit: Minimum 100 psig for minimum 6 hours.

3. Suction Piping: Minimum 20-in. Hg for minimum 30 minutes.

4. Isolate storage tanks if test pressure in piping will cause pressure in storage tanks to exceed 10 psig.

- B. Inspect and test fuel-oil piping according to NFPA 31, "Tests of Piping" Paragraph; and according to requirements of authorities having jurisdiction.
- C. Test leak-detection and monitoring system for accuracy by manually operating sensors and checking against alarm panel indication.
- D. Test and adjust controls and safeties. Replace damaged and malfunctioning controls and equipment.
- E. Bleed air from fuel-oil piping using manual air vents.
- F. Fuel-oil piping and equipment will be considered defective if it does not pass tests and inspections.
- G. Prepare test and inspection reports.

3.13 OUTDOOR PIPING SCHEDULE

- A. Underground Fuel-Oil Piping: Rigid, double-containment piping. Size indicated is carrier-pipe size.

- B. Underground fuel-oil-tank fill and vent piping shall be the following:
 - 1. NPS 2 and Smaller: Steel pipe, steel or malleable-iron threaded fittings, and threaded joints. Coat pipe and fittings with protective coating for steel piping.
 - 2. NPS 2-1/2 and Larger: Steel pipe, steel welding fittings, and welded joints. Coat pipe and fittings with protective coating for steel piping.
- C. Containment Conduit: Steel pipe with wrought-steel fittings and welded joints. Coat pipe and fittings with protective coating for steel piping.
- D. Aboveground fuel-oil piping shall be the following:
 - 1. NPS 2 and Smaller: Steel pipe, steel or malleable-iron threaded fittings, and threaded joints.
 - 2. NPS 2-1/2 and Larger: Steel pipe, steel welding fittings, and welded joints.
- E. INDOOR PIPING SCHEDULE
- F. Aboveground fuel-oil piping shall be the following:
 - 1. NPS 1/2 to NPS 2: Steel pipe, steel or malleable-iron threaded fittings, and threaded joints.
 - 2. NPS 2-1/2 and Larger: Steel pipe, steel fittings, and welded or flanged joints.

3.14 SHUTOFF VALVE SCHEDULE

- A. Valves for aboveground distribution piping NPS 2 and smaller shall be the following:
 - 1. Two-piece, full regular-port, bronze ball valves with bronze trim.
- B. Distribution piping valves for pipe NPS 2-1/2 and larger shall be the following:
 - 1. Two-piece, full-port, bronze ball valves with bronze trim.
- C. Valves in branch piping for single appliance shall be the following:
 - 1. Two-piece, full-port, bronze ball valves with bronze trim.

END OF SECTION 221113

LEGEND

SYMBOL	DESCRIPTION
	NOTE CALLOUT
	DETAIL CALLOUT - NUMBER ON TOP DENOTES DETAIL NUMBER - NUMBER ON BOTTOM DENOTES SHEET DETAIL IS SHOWN
	MECHANICAL EQUIPMENT CALLOUT. SEE MECHANICAL PLANS FOR EXACT LOCATION AND REQUIREMENTS
	SECTION CALLOUT
	FEEDER CALLOUT
	EXISTING FEEDER CALLOUT
	NEW LINEWORK
	EXISTING LINEWORK
	DEMOLISHED LINEWORK
	CONDUIT EXPOSED
	CONDUIT CONCEALED IN WALL OR ABOVE CEILING
	CONDUIT CONCEALED UNDERGROUND OR BELOW FLOOR
	CONDUIT EMERGENCY
	MULTI-CHANNEL RACEWAY
	CONDUIT TURNED UP
	CONDUIT CAPPED
	BRANCH CIRCUIT HOMERUN TO PANELBOARD AND CIRCUITS AS INDICATED
	3/4" CONDUIT. TICK MARKS INDICATE QUANTITY OF #12 AWG WIRES (UNLESS NOTED OTHERWISE. NO MARKS INDICATES 2#12 & 1#12 GND WIRES) - SMALL MARK DENOTES HOT WIRE - LARGE MARK DENOTES NEUTRAL WIRE - DIAGONAL DENOTES GROUND WIRE
	GENERATOR
	SWITCH
	CIRCUIT BREAKER
	2-WAY SWITCH, TRANSFER SWITCH
	FUSE
	TRANSFORMER
	GROUND CONNECTION
	MOTOR - SINGLE PHASE FRACTIONAL OR INTEGRAL HORSEPOWER
	METER
	ELECTRONIC CIRCUIT MONITOR
	480V DRAWOUT BREAKER
	VARIABLE FREQUENCY DRIVE
	PANEL
	FUSED DISCONNECT SWITCH
	NON-FUSED DISCONNECT SWITCH
	COMBINATION STARTER/DISCONNECT SWITCH
	SWITCH MOTOR RATED
	SPLICE
	TERMINATION
	EXISTING TERMINATION
	MEDIUM VOLTAGE - AIR CIRCUIT BREAKER DRAWOUT BREAKER
	MEDIUM VOLTAGE FUSED DISCONNECT SWITCH
	MEDIUM VOLTAGE MODULAR SPLICE
	MEDIUM VOLTAGE EXISTING MODULAR SPLICE
	2x4 LIGHT FIXTURE - UPPER CASE LETTER INDICATES LIGHT FIXTURE CALLOUT. LOWER CASE LETTER INDICATES LIGHTING CONTROL ZONE.
	2x4 EMERGENCY LIGHT FIXTURE FED FROM GENERATOR/ INVERTER/ BATTERY BACKUP
	2x2 LIGHT FIXTURE - UPPER CASE LETTER INDICATES LIGHT FIXTURE CALLOUT. LOWER CASE LETTER INDICATES LIGHTING CONTROL ZONE.
	2x2 EMERGENCY LIGHT FIXTURE FED FROM GENERATOR/ INVERTER/ BATTERY BACKUP
	LINEAR LIGHT FIXTURE. DIMENSIONS PER PLANS - UPPER CASE LETTER INDICATES LIGHT FIXTURE CALLOUT. LOWER CASE LETTER INDICATES LIGHTING CONTROL ZONE.
	EMERGENCY LINEAR LIGHT FIXTURE. DIMENSIONS PER PLANS - LIGHT FIXTURE FED FROM GENERATOR/ INVERTER/ BATTERY BACKUP
	LINEAR PENDANT LIGHT FIXTURE. DIMENSIONS PER PLANS - UPPER CASE LETTER INDICATES LIGHT FIXTURE CALLOUT. LOWER CASE LETTER INDICATES LIGHTING CONTROL ZONE.
	TRACK LIGHTING - UPPER CASE LETTER INDICATES LIGHT FIXTURE CALLOUT. LOWER CASE LETTER INDICATES LIGHTING CONTROL ZONE.
	UNDERCABINET / COVE FIXTURE - UPPER CASE LETTER INDICATES LIGHT FIXTURE CALLOUT. LOWER CASE LETTER INDICATES LIGHTING CONTROL ZONE.
	LED STRIP LIGHT FIXTURE - UPPER CASE LETTER INDICATES LIGHT FIXTURE CALLOUT. LOWER CASE LETTER INDICATES LIGHTING CONTROL ZONE.
	LED STRIP EMERGENCY LIGHT FIXTURE - UPPER CASE LETTER INDICATES LIGHT FIXTURE CALLOUT. LOWER CASE LETTER INDICATES LIGHTING CONTROL ZONE. LIGHT FIXTURE FED FROM INVERTER BACKUP.

SYMBOL	DESCRIPTION
	DOWNLIGHT FIXTURE - UPPER CASE LETTER INDICATES LIGHT FIXTURE CALLOUT. LOWER CASE LETTER INDICATES LIGHTING CONTROL ZONE.
	EMERGENCY DOWNLIGHT FIXTURE FED FROM GENERATOR BACKUP
	PENDANT LUMINAIRE - UPPER CASE LETTER INDICATES LIGHT FIXTURE CALLOUT. LOWER CASE LETTER INDICATES LIGHTING CONTROL ZONE.
	WALLWASH LIGHT FIXTURE - UPPER CASE LETTER INDICATES LIGHT FIXTURE CALLOUT. LOWER CASE LETTER INDICATES LIGHTING CONTROL ZONE.
	WALL MOUNTED LIGHT FIXTURE - UPPER CASE LETTER INDICATES LIGHT FIXTURE CALLOUT. LOWER CASE LETTER INDICATES LIGHTING CONTROL ZONE.
	EMERGENCY WALL MOUNTED LIGHT FIXTURE FED FROM GENERATOR BACKUP
	BOLLARD LUMINAIRE
	POST TOP LUMINAIRE
	POLE MOUNTED LUMINAIRE, SINGLE HEAD
	POLE MOUNTED LUMINAIRE, DOUBLE HEAD
	POLE MOUNTED LUMINAIRE, TRIPLE HEAD
	POLE MOUNTED LUMINAIRE, QUAD HEAD
	IN GRADE LUMINAIRE
	PATHWAY LUMINAIRE
	LANDSCAPE FIXTURE
	EXIT LIGHT FIXTURE WITH DIRECTIONAL ARROWS AS INDICATED. SHADED SIDE DENOTES NUMBER OF FACES
	JUNCTION BOX
	PHOTOCELL FOR EXTERIOR APPLICATIONS
	DAYLIGHT SENSOR - CEILING MOUNTED
	RELAY
	EMERGENCY RELAY UL 924 COMPLIANT
	MOTION SENSOR - CEILING MOUNTED
	MOTION SENSOR - CORNER OR WALL MOUNTED
	MOTION SENSOR WITH AISLE/CORRIDOR LENS - CEILING MOUNTED
	COMBINATION MOTION AND DAYLIGHT SENSOR
	LIGHTING CONTROL NETWORK DEVICE
	DIGITAL TIMER SWITCH
	MOTION SENSOR SWITCH
	LOW VOLTAGE SWITCH
	DIMMER MASTER SWITCH
	DIGITAL DIMMING SWITCH
	GRAPHICAL TOUCH SCREEN - LIGHTING CONTROL STATION
	THERMOSTAT WITH A 3/4" CONDUIT TO ACCESSIBLE CEILING SPACE
	MODULAR FURNITURE - BASE POWER WHIP FEED CONNECTION
	MODULAR FURNITURE - FLOOR BOX FEED CONNECTION
	MODULAR FURNITURE - POWER POLE FEED CONNECTION
	LIGHTING CONTROL PANEL - SURFACE MOUNTED
	PANELBOARD - RECESSED MOUNTED
	PANELBOARD - SURFACE MOUNTED
	DISTRIBUTION PANEL/ BOARD
	SINGLE POLE SWITCH, DEVICE SHALL BE MOUNTED +48" MAX AND +36" MIN FROM THE CENTER OF DEVICE.
	SWITCH 3-WAY (48" AFF MAXIMUM)
	TIMER SWITCH (48" AFF MAXIMUM)
	DUAL SWITCH (48" AFF MAXIMUM)
	PUSHBUTTON SWITCH


	RECESSED ON WALL SURFACE
	RECESSED FLOOR BOX
	RECESSED POKE-THROUGH
	RECESSED POKE-THROUGH - POWER/TEL/DATA
	RECESSED FLOOR BOX - POWER/TEL/DATA
	20A, 125V DUPLEX RECEPTACLE MOUNTED +15" AFF, UNLESS OTHERWISE NOTED
	20A, 125V QUAD RECEPTACLE MOUNTED +15" AFF, UNLESS OTHERWISE NOTED
	20A, 125V DUPLEX RECEPTACLE ON DEDICATED CIRCUIT MOUNTED +15" AFF, UNLESS OTHERWISE NOTED
	20A, 125V CONTROLLED DUPLEX RECEPTACLE MOUNTED +15" AFF, UNLESS OTHERWISE NOTED
	20A, 125V QUAD RECEPTACLE (HALF) CONTROLLED RECEPTACLE MOUNTED +15" AFF, UNLESS OTHERWISE NOTED
	20A, 125V HOSPITAL GRADE EMERGENCY DUPLEX RECEPTACLE MOUNTED +15" AFF, UNLESS OTHERWISE NOTED
	20A, 125V HOSPITAL GRADE EMERGENCY QUAD RECEPTACLE MOUNTED +15" AFF, UNLESS OTHERWISE NOTED
	SPECIAL RECEPTACLE REFER TO DRAWINGS FOR NEMA CONFIGURATION MOUNTED +15" AFF, UNLESS OTHERWISE NOTED
	JUNCTION BOX
	20A, 125V DUPLEX RECEPTACLE FIRE RATED TYPE
	20A, 125V QUAD RECEPTACLE FIRE RATED TYPE

ABBREVIATIONS

ABBREVIATION	DESCRIPTION	ABBREVIATION	DESCRIPTION
&	AND	LF	LINEAR FEET
1/C	SINGLE CONDUCTOR	LPMC	LIQUIDTIGHT FLEXIBLE METAL CONDUIT
@	AT	LGST	LARGEST
A OR AMP	AMPERES	LIS	LOAD INTERRUPTER SWITCH
A.C.	ASPHALT CONCRETE	LOC	LOCATION
ABV	ABOVE	LOTO	LOCK-OUT & TAG-OUT
AF	AMPERE FUSE RATING	LSI	LONG TERM, SHORT TERM, INSTANTANEOUS
AFC	AVAILABLE FAULT CURRENT	LSIG	LONG TERM, SHORT TERM, INSTANTANEOUS GROUNDING
AFB	ABOVE FINISHED FLOOR	LTG	LIGHTING
AFG	ABOVE FINISHED GRADE	LV	LOW VOLTAGE
AIC	AMPERE INTERRUPTING CAPACITY	M	METER
AL	ALUMINUM	MAX	MAXIMUM
APPROX.	APPROXIMATE	MCA	MINIMUM CIRCUIT AMPS
ARCH.	ARCHITECT, ARCHITECTURAL	MCC	MOTOR CONTROL CENTER
AS	AMPERE SWITCH RATING	MCP	MOTOR CIRCUIT PROTECTOR
ASCC	AVAILABLE SHORT CIRCUIT CURRENT	MEGR, MFR	MANUFACTURER
ATC	AIR TERMINAL CHAMBER	MH	MECHANICAL INTERLOCK
ATO	AUTOMATIC THROW-OVER (SWITCH)	MIN	MINIMUM
ATS	AUTOMATIC TRANSFER SWITCH	MCCP	MAXIMUM OVERCURRENT PROTECTION
AUTO	AUTOMATIC	MCRCT	MULTI-RATIO CURRENT TRANSFORMER
AUX	AUXILIARY	MTD	MOUNTED
AWG	AMERICAN WIRE GAUGE	MTG	MOUNTING
B.S.	BARE STRANDED	MTR	MOTOR
BAT	BATTERY	MTTB	MAIN TELEPHONE TERMINAL BOARD
BEL	BELOW	MV	MEDIUM VOLTAGE
BKBD	BACKBOARD	N	NORTH
BKR	BREAKER	NAC	NOTIFICATION APPLIANCE CIRCUIT
BLDG	BUILDING	NC	NORMALLY CLOSED
C	CONDUIT	NEC	NATIONAL ELECTRICAL CODE
C.O.	CONDUIT ONLY WITH PULL WIRE	NF	NON-FUSED
CB	CIRCUIT BREAKER	NIC	NOT IN CONTRACT
CC	CONSTANT CURRENT	NL	NIGHT LIGHT- 24HRS ON
CKT	CIRCUIT	NO	NUMBER
CL	CENTER LINE	OC	ON CENTER
CLG	CEILING	OCPO	OVERCURRENT PROTECTIVE DEVICE
COL	COLUMN	OD	OUTSIDE DIAMETER
CP	COMMUNICATION PROCESSOR	OE	OVERHEAD ELECTRICAL
CPT	CONTROL POWER TRANSFORMER	OFC	OIL FUSED CUTOUT
CR	CONTROL RELAY	OH	OVER HEAD
CSFD	COMBINATION SMOKE FIRE DAMPER	OL	OIL LEVER SWITCH
CT	CURRENT TRANSFORMER	P	POLE
CJ	COPPER	PAC	PROGRAMMABLE AUTOMATION CONTROLLER
CW	COLD WATER	PB	PULL BOX
DIAG	DIAGRAM	PC	PHOTOCELL
DIS	DISCONNECT	PCB	POLYCHLORINATED BIPHENYL
DIST.	DISTANCE	PDS	PRESSURE DIFFERENTIAL SWITCH
DL	DAMP LOCATION LISTING	PF	POWER FACTOR
DM	DIGITAL METER	PH OR Ø	PHASE
DMM	DIGITAL METER MODULE	PLC	PAPER INSULATED, LEAD COVER
DP	DISTRIBUTION PANEL	PIV	POST INDICATING VALVE
DWG	DRAWING	PL	PLATE
DWP	DEPARTMENT OF WATER & POWER	PLC	PROGRAMMABLE LOGIC CONTROLLER
EA	EACH	PNL	PANEL
ECM	ELECTRIC CIRCUIT MONITOR	POC	POINT OF CONNECTION
ELEC.	ELECTRICAL	PREF.	PREFERRED
EM	EMERGENCY	PRI	PRIMARY
EMH	ELECTRICAL MANHOLE	PVC	POLY-VINYL CHLORIDE
EMT	ELECTRICAL METALLIC TUBING	PWR	POWER
EPO	EMERGENCY POWER OFF	RECCEPT	RECEPTACLE
EPR	ETHYLENE PROPYLENE RUBBER	REQD	REQUIRED
EQUIP	EQUIPMENT	RGS	RIGID GALVANIZED STEEL
ERR	EXISTING TO BE RELOCATED AND RECONNECTED	RM	ROOM
EXIST(E)	EXISTING	RMC	RIGID METAL CONDUIT
EXP	EXPLOSION PROOF	RMCJV	ROSENDIN MEADOWS JOINT VENTURE (DESIGN-BUILD CONTRACTOR)
FA	FIRE ALARM	RPBP	REDUCED PRESSURE BACK FLOW PREVENTER
FACP	FIRE ALARM CONTROL PANEL	RTAC	REAL TIME AUTOMATION CONTROLLER
FATC	FIRE ALARM TERMINAL CABINET	SCCR	SHORT CIRCUIT CURRENT RATING
FFE	FINISHED FLOOR ELEVATION	SCE	SOUTHERN CALIFORNIA EDISON
FIN.	FINISH	SF	SQUARE FEET
FIP.	FIELD INTERFACE PANEL	SHT	SHEET
FIXT	FIXTURE	SIG	SIGNAL
FLA	FULL LOAD AMPS	SP	SPARE
FLR	FLOOR	SPECS	SPECIFICATIONS
FLUOR	FLUORESCENT	ST	STREET
FMC	FLEXIBLE METAL CONDUIT	STD	STANDARD
FO	FIBER OPTIC	STP	SHIELDED TWISTED PAIR
FT	FOOTING	SW	SWITCH
FTG	FOOTING	SWBD	SWITCHBOARD
GAP	GENERAL ACCESS POWER	SWGR	SWITCHGEAR
GEN	GENERATOR	SWST	SWITCHING STATION
GFI	GROUND FAULT INTERRUPTER	T.O.D.	TOP OF DUCTBANK
GFR	GROUND FAULT RELAY	T.O.M.	TOP OF MANHOLE
GG	GREEN GROUND	TB	TERMINAL BLOCK
GND	GROUND	TEL/TELE	TELEPHONE
HOA	HAND-OFF-AUTOMATIC	TMH	TELEPHONE MANHOLE
HP	HORSEPOWER	TPS	TWISTED SHIELDED PAIR
HT	HEIGHT	TRANSF, XFMR	TRANSFORMER
HTR	HEATER	TS	TAMPER SWITCH
HV	HIGH VOLTAGE	TYP	TYPICAL
HZ	HERTZ	UG	UNDERGROUND
ICON	INTEGRATED COMMUNICATIONS OPTICAL NETWORK	UON	UNLESS OTHERWISE NOTED
IE	INVERT ELEVATION	V	VOLTS
IED	INTELLIGENT ELECTRONIC DEVICE	VA	VOLT-AMPERES
IMC	INTERMEDIATE METAL CONDUIT	VB	VIBRATION SWITCH
INCAND	INCANDESCENT	VFD	VARIABLE FREQUENCY DRIVE
ISC	SHORT CIRCUIT CURRENT	W	WATTS
J, JB, J-BOX	JUNCTION BOX	W/	WITH
KCMIL	THOUSAND CIRCULAR MILS	W/O	WITHOUT
KV	KILOVOLT	WP	WEATHERPROOF
KVA	KILOVOLT-AMPERES		
KW	KILOWATT		

IN THE EVENT ABBREVIATIONS NOT MENTIONED HEREIN ARE USED, REFERENCE WILL BE MADE TO ANSI Y1.1, MILITARY STANDARD ABBREVIATIONS AND OTHER STANDARD INDUSTRY CONVENTIONS. (1)

SHEET INDEX LEGEND

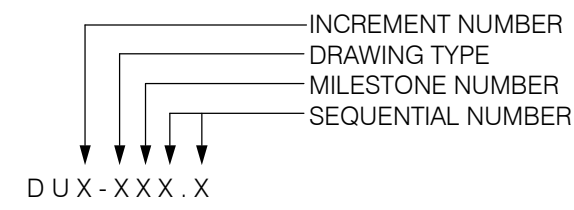

SHEET INDEX

SHEET	DESCRIPTION
DU1-001	LEGEND, ABBREVIATIONS AND SHEET INDEX
DU1-002	GENERAL NOTES
DU1-003	DEMOLITION AND SITE UTILITY NOTES
DU1-004	EQUIPMENT PLAN - GAP SWGR BLDG
DU1-005	SEQUENCE OF INSTALLATION
DU1-200	OVERALL SITE PLAN
DU1-210	REFEED 4160V CHILLER XMFR PLAN
DU1-211	SITE PLAN
DU1-212	ENLARGED 12KV SITE UG POWER PLAN - GAP BLDG
DU1-213	ENLARGED 12KV UG POWER PLAN - GAP SWGR BLDG
DU1-214	ENLARGED 12KV SCADA FIRE COM. GEN START SITE UG POWER PLAN - GAP SWGR BLDG
DU1-214.2	ENLARGED 208/120V, SCADA FIRE COM. GEN START SITE UG POWER PLAN - GEN BLDG
DU1-215	ENLARGED GROUNDING PLAN - GAP SWGR BLDG
DU1-220	ENLARGED 12KV SITE UG POWER PLAN - GEN BLDG
DU1-221	ENLARGED 208/120V POWER PLAN - GAP SWGR BLDG
DU1-222.1	ENLARGED LIGHTING PLAN - GAP SWGR BLDG
DU1-222.2	EGRESS PHOTOMETRICS - GAP SWGR BLDG
DU1-223	ENLARGED 12KV SCADA FIRE COM. GEN START SITE UG POWER PLAN - GAP SWGR BLDG
DU1-224	ENLARGED 208/120V, SCADA FIRE COM. GEN START SITE UG POWER PLAN - GEN BLDG
DU1-231	ENLARGED 12KV SITE UG POWER PLAN - GAP SWGR BLDG
DU1-232	ENLARGED 12KV SITE UG POWER PLAN - GEN BLDG
DU1-241	ENLARGED 12KV SITE UG POWER PLAN - GAP SWGR BLDG
DU1-242	ENLARGED 12KV SITE UG POWER PLAN - GAP SWGR BLDG
DU1-301	SCADA SCHEMATIC - GAP SWGR BLDG
DU1-302	12KV GAP SWGR SCADA CONTROLS
DU1-303	ENLARGED SCADA PLAN - GAP SWGR BLDG
DU1-401	PANEL SCHEDULES
DU1-402.1	CONDUIT AND CABLE SCHEDULE
DU1-402.2	CONDUIT AND CABLE SCHEDULE
DU1-402.3	CONDUIT AND CABLE SCHEDULE
DU1-500	12KV GAP SWGR NOTES
DU1-511	EXISTING GEN BLDG SINGLE LINE DIAGRAM FOR TEMP FEEDER
DU1-521	12KV GAP SWGR SINGLE LINE DIAGRAM
DU1-522	EXISTING GEN BLDG SINGLE LINE DIAGRAM FOR LSC4 FEEDER
DU1-531	DEMO 1ST CUTOVER GEN BLDG SINGLE LINE DIAGRAM
DU1-532	1ST CUTOVER GAP SINGLE LINE DIAGRAM
DU1-533	1ST CUTOVER GEN BLDG SINGLE LINE DIAGRAM
DU1-541	DEMO 2ND CUTOVER GEN BLDG SINGLE LINE DIAGRAM
DU1-542	2ND CUTOVER GAP SINGLE LINE DIAGRAM
DU1-543	2ND CUTOVER GEN BLDG SINGLE LINE DIAGRAM
DU1-601.1	DETAILS - MANHOLES
DU1-601.2	DETAILS - CABLES
DU1-603	DETAILS - MANHOLE, PULLBOX
DU1-604.1	DETAILS - DUCT BANK SECTION CUTS
DU1-604.2	DETAILS - DUCT BANK SECTION CUTS
DU1-605	DETAILS - GROUNDING
DU1-606	SCADA EQUIPMENT DETAILS
DU1-610	DETAILS - MANHOLE BUTTERFLIES
DU1-611	DETAILS - MANHOLE BUTTERFLIES
DU1-612	DETAILS - MANHOLE BUTTERFLIES
DU1-613	DETAILS - MANHOLE BUTTERFLIES
DU1-620	DETAILS - MANHOLE BUTTERFLIES
DU1-630	DETAILS - MANHOLE BUTTERFLIES
DU1-640	DETAILS - MANHOLE BUTTERFLIES
DU1-700	UNDERGROUND SURVEY - FOR REFERENCE ONLY
DU1-701	UNDERGROUND SURVEY - FOR REFERENCE ONLY
DU1-702	UNDERGROUND SURVEY - FOR REFERENCE ONLY
DU1-703	UNDERGROUND SURVEY - FOR REFERENCE ONLY
DU1-704	UNDERGROUND SURVEY - FOR REFERENCE ONLY
DU1-705	UNDERGROUND SURVEY - FOR REFERENCE ONLY
DU1-706	UNDERGROUND SURVEY - FOR REFERENCE ONLY
DU1-707	UNDERGROUND SURVEY - FOR REFERENCE ONLY

Joseph A. Balbons, AIA
Sylvia Botero, AIA
Kevin S. Boots, AIA

10980 Wilshire Boulevard
Los Angeles, California
90024-3905

Telephone 310 473 3555
Facsimile 310 473 3555
www.rbbinc.com

AGENCY APPROVALS

OSHPD # 1240005-19-01

CONSULTANT

Long Beach // Irvine // Los Angeles
San Diego // San Jose // Seattle

p2sinc.com

ISSUE RECORD

04/09/2025	D	ADDENDUM D
03/14/2025	A	ADDENDUM A
02/10/2025		BID SET
01/31/2025	3	HCAI BACKCHECK 2
04/04/2024		HCAI SUBMITTAL
DATE	△	DESCRIPTION

HARBOR-UCLA MEDICAL CENTER
PHASE 2E INC 1 - RETROFIT OF
GENERATOR BLDG. SWITCHGEAR

1000 West Carson Street, Torrance, CA 90509


MILESTONE: HCAI SUBMITTAL

MILESTONE DATE: 12/17/2024

RBB PROJECT: 1712105 SCALE:

DESCRIPTION
LEGEND, ABBREVIATIONS AND
SHEET INDEX

DU1-001

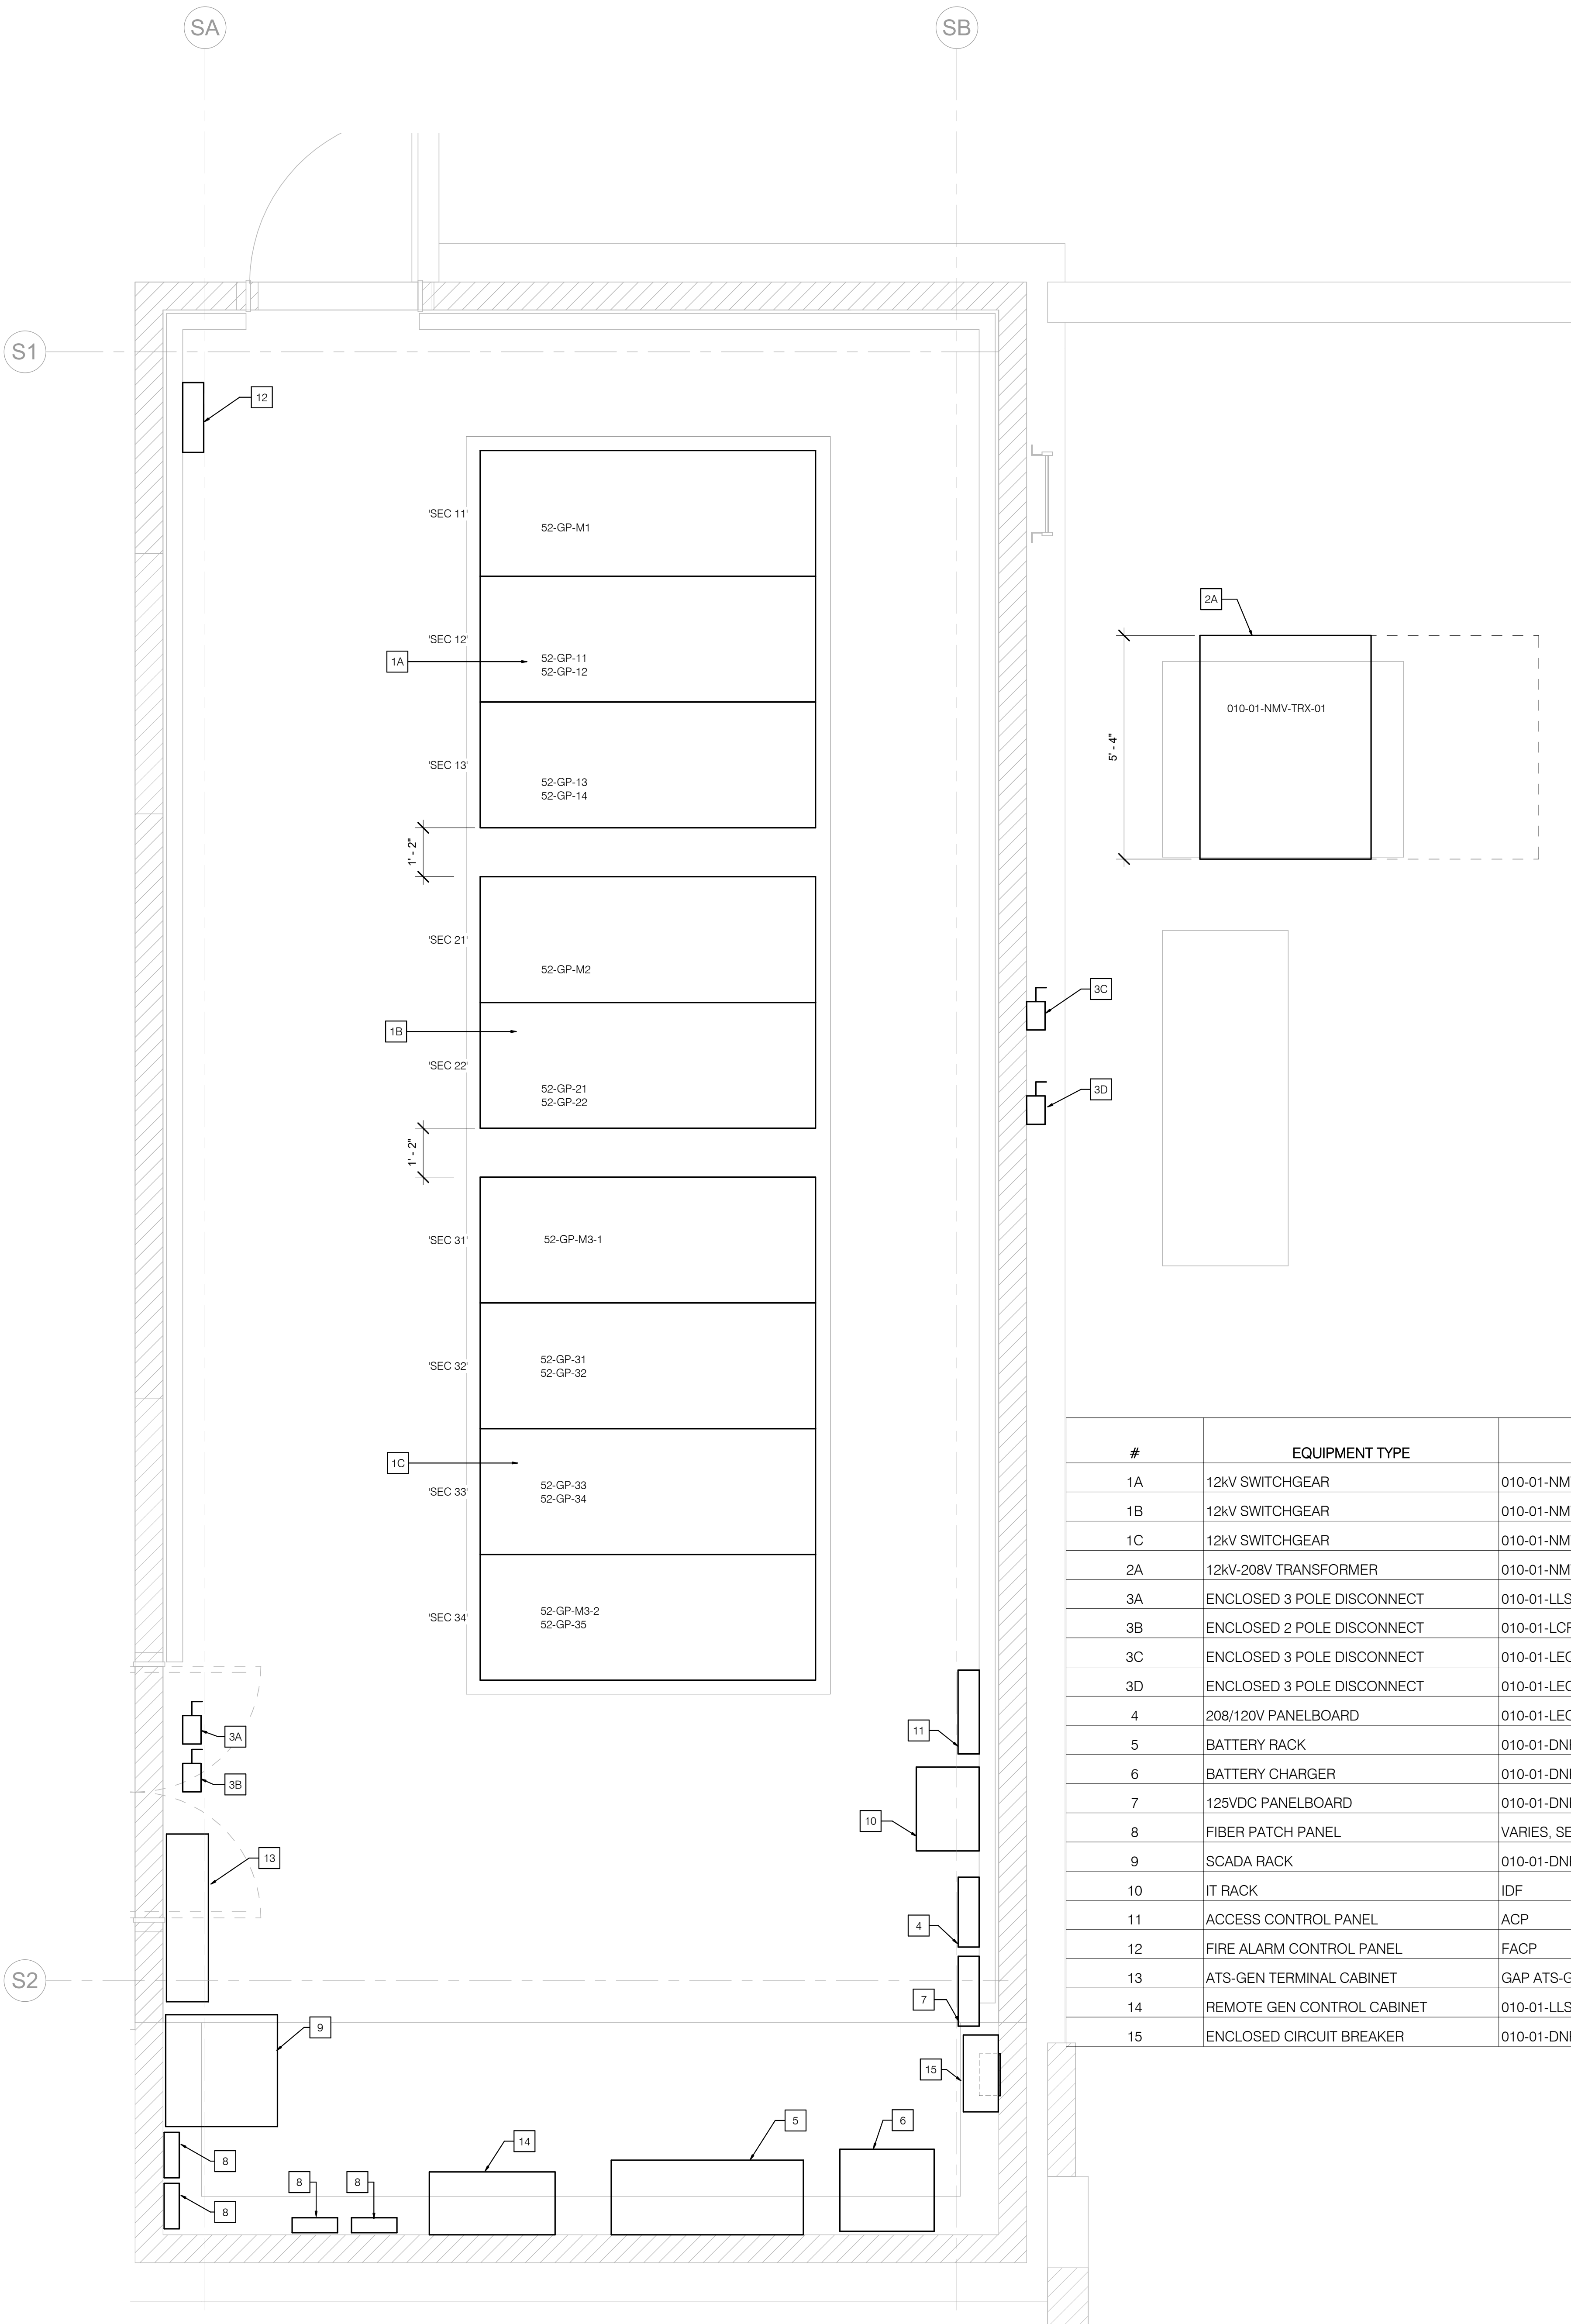

- GENERAL NOTES**
1. CONTRACTOR TO PROVIDE POWER AND ARC FLASH STUDY FOR LOW VOLTAGE 600 VOLTS AND LESS EQUIPMENT.
 2. CONTRACTOR TO PROVIDE STRUCTURAL DESIGN CALCULATIONS STUDY WITH SEISMIC FOR ANCHORING THE SWITCHGEAR TO THE HOUSE KEEPING PAD PER SPEC 26 1913 MEDIUM-VOLTAGE METAL CLAD SWITCHGEAR.
 3. CONTRACTOR TO PROVIDE STRUCTURAL DESIGN CALCULATIONS STUDY WITH SEISMIC FOR ANCHORING THE SCADA AND GENERATOR CONTROL PANELS IN GAP BUILDING TO THE HOUSE KEEPING PAD.
 4. CONTRACTOR TO ADD WARNING LABELS FOR EXPOSED 12KV CONDUITS AND PULL BOXES TO WITH 'YELLOW BACK GROUND 'DANGER HIGH VOLTAGE'.
 5. CONTRACTOR TO COORDINATE WORK AND WITH QUINN AND CAT COMPANIES.

#	FURNISHMENT	INSTALLATION	TESTING BY QUINN CONTRACTOR PROVIDED	TESTING BY 3RD PARTY CONTRACTOR PROVIDED
1A	OWNER	CONTRACTOR	YES	
1B	OWNER	CONTRACTOR	YES	
1C	OWNER	CONTRACTOR	YES	YES
2A	CONTRACTOR	CONTRACTOR		YES
3A	CONTRACTOR	CONTRACTOR		YES
3B	CONTRACTOR	CONTRACTOR		YES
3C	CONTRACTOR	CONTRACTOR		YES
3D	CONTRACTOR	CONTRACTOR		YES
4	CONTRACTOR	CONTRACTOR		YES
5	CONTRACTOR	CONTRACTOR		YES
6	CONTRACTOR	CONTRACTOR		YES
7	CONTRACTOR	CONTRACTOR		YES
8	CONTRACTOR	CONTRACTOR		YES
9	OWNER	CONTRACTOR	YES	
10	CONTRACTOR	CONTRACTOR		YES
11	CONTRACTOR	CONTRACTOR		YES
12	CONTRACTOR	CONTRACTOR		YES
13	CONTRACTOR	CONTRACTOR		YES
14	OWNER	CONTRACTOR	YES	
15	CONTRACTOR	CONTRACTOR		YES

#	EQUIPMENT TYPE	EQUIPMENT ID	MANUFACTURER	DESCRIPTION/CATALOG #	ANCHORAGE DETAIL (#/SHEET #)	OSP CERTIFICATION #
1A	12KV SWITCHGEAR	010-01-NMV-SGR-01	EATON	VACCLAD-W, 15k, 1200A, 25KAIC	6/S602.1	OSP-0019
1B	12KV SWITCHGEAR	010-01-NMV-SGR-02	EATON	VACCLAD-W, 15k, 1200A, 25KAIC	6/S602.1	OSP-0019
1C	12KV SWITCHGEAR	010-01-NMV-SGR-03	EATON	VACCLAD-W, 15k, 1200A, 25KAIC	6/S602.1	OSP-0019
2A	12KV-208V TRANSFORMER	010-01-NMV-TRX-01	EATON	CA202003EN, 75kVA, 12KV-208Y/120V, RADIAL FEED	6/S602.1	OSP-0008
3A	ENCLOSED 3 POLE DISCONNECT	010-01-LLS-BDS-01	EATON	DH362UGK	1/S603.1	OSP-0338
3B	ENCLOSED 2 POLE DISCONNECT	010-01-LCR-BDS-01	EATON	DH261UGK	1/S603.1	OSP-0338
3C	ENCLOSED 3 POLE DISCONNECT	010-01-LEQ-FDS-01	EATON	DH362UGK, NEMA 3R	1/S603.1	OSP-0338
3D	ENCLOSED 3 POLE DISCONNECT	010-01-LEQ-FDS-02	EATON	DH362UGK, NEMA 3R	1/S603.1	OSP-0338
4	208/120V PANELBOARD	010-01-LEQ-PNL-01	EATON	208Y/120V, 3PH 4W, 225A/3P MCB, 30CKT	3/S603.1	OSP-0009
5	BATTERY RACK	010-01-DNP-BAT-01	C&D TECHNOLOGIES	RD01266	11/S602.1	OSP-0569
6	BATTERY CHARGER	010-01-DNP-BCH-01	LA MARCHE	TPSD-75-130V-550-017-537	5/S602.1	OSP-0340
7	125VDC PANELBOARD	010-01-DNP-PPL-01	EATON	125VDC, 2W,250A, 100A/2P MCB, 28CKT	3/S603.1	OSP-0009
8	FIBER PATCH PANEL	VARIES, SEE DRAWINGS	COMMSCOPE	WBE-EMT-BK-4P-MOD	EXEMPT PER CBC 1616A.1.18	
9	SCADA RACK	010-01-DNP-FPP-02	CAT/QUINN COMPANY			OPM-0247-13
10	IT RACK	IDF	SEE TELECOM DRAWINGS	SEE TELECOM DRAWINGS		OPM-0247-13
11	ACCESS CONTROL PANEL	ACP	SEE TELECOM DRAWINGS	SEE TELECOM DRAWINGS		
12	FIRE ALARM CONTROL PANEL	FACP	SEE FIRE PROTECTION DRAWINGS	4007-9201	8/S603.1	OSP-0004-10
13	ATS-GEN TERMINAL CABINET	GAP ATS-GEN TERMINAL CABINET	HOFFMAN	A424812WFSSLP	6/S603.1	
14	REMOTE GEN CONTROL CABINET	010-01-LLS-GCP-01	CAT/QUINN COMPANY			OSP-0697
15	ENCLOSED CIRCUIT BREAKER	010-01-DNP-BDS-01	EATON	HD100S WITH HDL 100A CIRCUIT BREAKER		OSP-0064



RBB ARCHITECTS INC

Joseph A. Balbons, AIA
Sylvia Botero, AIA
Kevin S. Boots, AIA

10980 Wilshire Boulevard
Los Angeles, California
90024-3905

Telephone 310 473 3555
Facsimile 310 473 3555
www.rbbinc.com



AGENCY APPROVALS

OSHPD # 1240005-19-01

CONSULTANT



Long Beach // Irvine // Los Angeles
San Diego // San Jose // Seattle

p2sinc.com

ISSUE RECORD

04/09/2025	D	ADDENDUM D
03/14/2025	A	ADDENDUM A
02/10/2025		BID SET
01/31/2025	3	HCAI BACKCHECK 2
08/08/2024		HCAI BACKCHECK 1
04/04/2024		HCAI SUBMITTAL
DATE	△	DESCRIPTION



HARBOR-UCLA MEDICAL CENTER
PHASE 2E INC 1 - RETROFIT OF
GENERATOR BLDG. SWITCHGEAR

1000 West Carson Street, Torrance, CA 90509

MILESTONE: HCAI SUBMITTAL

MILESTONE DATE: 01/03/24

RBB PROJECT: 1712105 SCALE: 1/2" = 1'-0"

DESCRIPTION
EQUIPMENT PLAN - GAP SWGR
BLDG

DU1-004

SEQUENCE OF INSTALLATION

INC 1 MILESTONE 1 (INSTALL GAP AREA 12KV UNDERGROUND CONDUITS):

- INSTALL 12KV CONDUIT AND CABLE FROM SF6-S7 TO CHILLER PLANT 2000KVA, 12KV TO 4160V TRANSFORMER AND TO CHILLER PLANT 1500KVA, 12KV TO 480V TRANSFORMER. REMOVE SOME OF THE EXISTING CONDUIT AND ALL OF THE CABLE FROM THE ORIGINAL 12KV CABLE FROM SF6-S7 TO THE CHILLER PLANT 12KV TO 4160V TRANSFORMER. THE EXISTING POWER PATH TO 12KV TO 4160V TRANSFORMER IS IN THE WAY OF INSTALLING THE NEW GAP BUILDING.
- INSTALL ALL 12KV UNDERGROUND MANHOLES, CONDUITS AND DUCT BANKS.
- INCREMENT 1, MILESTONE 1: UNDERGROUND CONDUIT INSTALLATION SIGN OFF.**

INC 2 MILESTONE 1 (INSTALL NEW LOW VOLTAGE CONFIGURATION FOR POWER SUPPLY TO NEW AND EXISTING PANELS):

- INSTALL 3 NEW 208/120 VOLT PANELS (011-01-LEP-PNL-01, 011-01-LEQ-PNL-01, AND 011-01-LCR-PNL-01) AND 2 ATS UNITS 011-01-LEP-ATS-01 AND 011-01-LEP-ATS-02 IN THE GENERATOR BUILDING.
- INSTALL NEW GENERATOR HOUSE TRANSFORMER 011-01-NMV-TRX-01 AND 12KV CABLE FROM SF6-S7 TO TRANSFORMER 011-01-NMV-TRX-01 INPUT SWITCH B. TRANSFORMER FEEDS NORMAL POWER TO NEW ATS UNITS 011-01-LEP-ATS-01.
- TEMPORARILY MOVE ALL INDIVIDUAL LOADS FROM EXISTING PANEL LSA TO EXISTING PANEL PC. NOTE ALL EXISTING PANELS HAVE MOSTLY LIFE SAFETY LOADS ON THEM WITH OTHER TYPES MIXED IN THEM.
- REPLACE THE EXISTING 208/120 VOLT, 50A PANEL LSA WITH NEW LARGER 225A BUS RATING.
- CONNECT A TEMPORARY 208/120V 4W 3 PHASE 150KVA GENERATOR TO ATS 011-01-LEP-ATS-02. ATS 011-01-LEP-ATS-02 WILL SEND A SIGNAL TO THE TEMPORARY GENERATOR ON WHEN TO TURN ON.
- MOVE SOME INDIVIDUAL LOADS TO THE NEW PANELS. THE 3 NEW PANELS ARE RATED FOR EQUIPMENT, CRITICAL, AND LIFE SAFETY CIRCUITS. THE 2 OLD REMAINING PANELS PB AND PC WILL NOW ONLY HAVE LIFE SAFETY LOADS ON THEM.
- MOVE EXISTING 208/120 VOLT PANEL PC INTO NEW SYSTEM. NOTE ONLY GEN 5 AND 6 ARE WITHOUT CONTROL POWER DURING THIS MOVE. GEN 1 TO 4 ARE WITH 208/120 VOLT CONTROL POWER.
- MOVE INDIVIDUAL GENERATOR #4 208/120 VOLT LOADS FROM PANEL PB TO PANEL PC.
- TEMP MOVE GENERATOR #3 208/120 VOLT LOADS FROM PANEL PB TO PANEL PC.
- TURN OFF THE GENERATOR SWITCHGEAR BREAKER UE-2 WHICH DE-ENERGIZES THE EXISTING HOUSE POWER TRANSFORMER AND ONLY PANEL PB. MOVE EXISTING 208/120 VOLT PANEL PB INTO NEW SYSTEM. NOTE ONLY GEN 1 AND 2 ARE WITHOUT CONTROL POWER DURING THIS MOVE. GEN 3 TO 6 ARE WITH 208/120 VOLT CONTROL POWER.
- MOVE INDIVIDUAL GENERATOR #3 208/120 VOLT LOADS FROM PANEL PC BACK TO PANEL PB.
- WITH GENERATOR SWITCHGEAR BREAKER UE-2 STILL OFF THAT DE-ENERGIZED THE EXISTING HOUSE POWER TRANSFORMER. CONNECT THE EXISTING HOUSE TRANSFORMER TO ATS 011-01-LEP-ATS-01.
- TURN ON THE GENERATOR SWITCHGEAR BREAKER UE-2 WHICH ENERGIZES THE EXISTING HOUSE POWER TRANSFORMER. THE NEW AND EXISTING 208/120V PANELS ARE NOW WITH GENERATOR BACKUP POWER VIA ATS 011-01-LEP-ATS-01.
- REMOVE TEMP GENERATOR.
- RENAME PANELS PB AND PC TO LATEST NAMING CONVENTIONS THAT NOTE THEY ARE NOW

- DEMO EXISTING HVAC.
- INSTALL NEW HVAC.
- REFEED FUEL SYSTEM WITH NEW.

INCREMENT 2, MILESTONE 1: RECONFIGURE GENERATOR BUILDING HOUSE LOADS SIGN OFF.

INC 1 MILESTONE 2 (INSTALL GAP BUILDING WITH SWITCHGEAR):

- INSTALL GAP BUILDING, HOUSE TRANSFORMER WITH EQUIPMENT PANELS, HVAC, FACP AND ASSOCIATED DEVICES.
- INSTALL GAP SWITCHGEAR IN GAP BUILDING WITH CONTROLS.
- CONNECT 12KV CABLE FROM GENERATOR ESSENTIAL SWITCHGEAR BREAKER LSC4 TO GAP SWITCHGEAR 010-001-NMV-SGR-03.
- INSTALL (3) 120V CIRCUITS FROM LIFE SAFETY PANEL IN THE GENERATOR BUILDING TO GAP BUILDING.
- INSTALL (2) 120V CIRCUITS FROM CRITICAL PANEL IN THE GENERATOR BUILDING TO GAP BUILDING.
- START UP GAP BUILDING AND SWITCHGEAR AND TEST.
- PROGRAM TEST CONTROLS FOR GAP SWITCHGEAR 010-001-NMV-SGR-03. SWITCHGEAR 010-001-NMV-SGR-03 WILL BE BACKED UP BY EXISTING GENERATORS AND A LOSS OF POWER TO THIS SWITCHGEAR WILL START THE EXISTING GENERATORS.
- INCREMENT 1, MILESTONE 2: GAP BUILDING CONSTRUCTION AND COMMISSIONING SIGN OFF.**

INC 1 MILESTONE 3 (MOVE SOME NORMAL LOADS FROM GENERATOR BUILDING SWITCHGEAR TO GAP SWITCHGEAR):

- CLOSE GENERATOR SWITCHGEAR BREAKER LSC4 TO GAP SWITCHGEAR. GENERATOR BACKUP POWER IS NOW AVAILABLE TO GAP SWITCHGEAR 010-001-NMV-SGR-03.
- MOVE 2 NORMAL 12KV LOADS, SUB-6N1 AND SF6-S7 WAY 2, FROM THE GENERATOR NORMAL SWITCHGEAR AND ONE, CHILLER PLANT TRANSFORMER LOAD, FROM SF6-S7 TO THE GAP SWITCHGEAR 010-001-NMV-SGR-01, 010-001-NMV-SGR-02 AND 010-001-NMV-SGR-03. NOTE THAT SOME OF THE NORMAL 12KV LOADS ARE FROM THE EXISTING CHILLER/BOILER PLANT AND WILL BE CONNECTED TO GAP SWITCHGEAR 010-001-NMV-SGR-03. THE TEMP PROGRAMMING FOR GAP SWITCHGEAR 010-001-NMV-SGR-03 WILL PROVIDE GENERATOR EQUIPMENT LEVEL POWER TO THE CHILLER/BOILER PLANT TO BE ABLE TO RUN THE BOILER PLANT UNDER GENERATOR POWER. THE GENERATOR POWER WILL BE PROVIDED VIA THE EXISTING GENERATOR SWITCHGEAR ESSENTIAL BUS BREAKER LSC4 TO SWITCHGEAR 010-001-NMV-SGR-03.
- INCREMENT 1, MILESTONE 3: REFEED NORMAL LOADS PART 1 SIGN OFF**

INC 1 MILESTONE 4 (MOVE REMAINING NORMAL LOADS FROM GENERATOR SWITCHGEAR TO GAP SWITCHGEAR):

- MOVE 2 NORMAL 12KV LOADS, SF6-S4 WAY 2 AND ONE CHILLER PLANT TRANSFORMER LOAD, FROM THE GENERATOR SWITCHGEAR TO THE GAP SWITCHGEAR 010-001-NMV-SGR-01 AND 010-001-NMV-SGR-03.
- INCREMENT 1, MILESTONE 4: REFEED NORMAL LOADS PART 2 SIGN OFF.**

INC 2 MILESTONE 2 (DEMO NORMAL GENERATOR BUILDING SWITCHGEAR AND INSTALL NEW ESSENTIAL SWITCHGEAR):

- INSTALL 12KV CABLE FROM NEW GENERATOR HOUSE TRANSFORMER 011-01-NMV-TRX-01 SWITCH INPUT A TO GAP SWITCHGEAR 010-001-NMV-SGR-03 BREAKER GP-35.
- CHANGE A / B SWITCH IN NEW GENERATOR HOUSE TRANSFORMER 011-01-NMV-TRX-01 TO A. THE NEW GENERATOR HOUSE TRANSFORMER 011-01-NMV-TRX-01 IS NOW FED FROM SWITCHGEAR 011-001-NMV-SGR-03. THIS IS A TEMP CONNECTION AND WILL PROVIDE BACK POWER TO THE GENERATOR BUILDING 208/120V PANELS FROM THE GAP SWITCHGEAR 010-010-NMV-SGR-03.
- TURN OFF THE GENERATOR SWITCHGEAR BREAKER UE-2 AND DE-ENERGIZE THE EXISTING GENERATOR BUILDING HOUSE TRANSFORMER AND REMOVE OLD TRANSFORMER.
- COORDINATE WITH SCE TO DISCONNECT OLD SERVICE TO THE GENERATOR BUILDING METER SWITCHGEAR AND REMOVE THEIR METER.
- DEMO THE GENERATOR BUILDING NORMAL SWITCHGEAR AND UTILITY METER SWITCHGEAR.
- TURN OFF H-O-A SWITCH FOR GENERATORS 1 AND 2 AND RACK OUT 12KV MAIN BREAKERS FOR GENERATORS 1 AND 2.
- INSTALL NEW SWITCHGEAR 011-01-EMV-SGR-02 PART 1 AND 011-01-EMV-SGR-03 IN GENERATOR BUILDING WITH CONTROLS WHERE THE NORMAL SWITCHGEAR WAS INSTALLED.
- INSTALL NEW GENERATOR HOUSE TRANSFORMER 011-01-EMV-TRX-01 FED FROM NEW SWITCHGEAR 011-01-EMV-SGR-02 PART 1. CONNECT TRANSFORMER SECONDARY POWER CABLE TO NEW BREAKER 011-01-ENP-BDS-01. CONNECT NEW BREAKER 01-ENP-BDS-01 TO ATS 011-01-LEP-ATS-01 VIA A TERMINAL PANEL ABOVE NEW BREAKER 011-01-ENP-BDS-01.

- INSTALL NEW 12KV CABLES FROM GENERATORS 1 AND 2 TO NEW SWITCHGEAR 011-01-EMV-SGR-03.
- CONNECT ATS CONTROLS OF ATS 011-01-LEP-ATS-01 TO CONTROL SYSTEM FOR OPERATING GENERATORS 1 AND 2.
- PROGRAM AND TEST NEW SWITCHGEAR.
- TEST TO ENSURE THE NEW SWITCHGEAR IS NOW ABLE TO TAKE ON EMERGENCY LOAD AND POWER FROM GENERATORS 1 AND 2.
- INCREMENT 2, MILESTONE 2: DEMOLISH EXISTING NORMAL SWITCHGEAR, INSTALL NEW ESSENTIAL SWITCHGEAR SIGN OFF.**

INC 2 MILESTONE 3 (MOVE EXISTING GENERATOR LOADS FROM EXISTING GENERATOR SWITCHGEAR TO NEW ESSENTIAL SWITCHGEAR 011-01-EMV-SGR-02 AND 011-01-EMV-SGR-03):

- MOVE 2 ESSENTIAL LOADS, SUB-6E1 AND SUB-6E2, OFF THE OLD GENERATOR SWITCHGEAR TO NEW GENERATOR SWITCHGEAR 011-001-NMV-SGR-02 AND 011-001-NMV-SGR-03.
- CHANGE THE A / B 12KV SWITCH IN NEW GENERATOR HOUSE TRANSFORMER 011-01-NMV-TRX-01 TO B. THE NEW GENERATOR HOUSE TRANSFORMER 011-01-NMV-TRX-01 IS NOW BEING FED FROM NORMAL POWER SF6-S7 WAY 5. ATS 011-01-LEP-ATS-01 WILL AUTOMATICALLY SWITCH BETWEEN BEING FED FROM 011-01-NMV-TRX-01 OR 011-01-EMV-TRX-01 FOR GENERATOR POWER.
- IN SWITCHGEAR 010-001-NMV-SGR-03 OPEN 12KV BREAKER GP-35 AND RACK IT OUT FOR 12KV CABLE GOING TO TRANSFORMER 011-01-NMV-TRX-01 INPUT SWITCH A.
- RECONFIGURE GAP SWITCHGEAR 010-001-NMV-SGR-02 TO BE FED BY 010-001-NMV-SGR-03 BY CLOSING BREAKERS FROM SWITCHGEAR 010-001-NMV-SGR-03 AND OPEN MAIN BREAKER GP-M2 ON SWITCHGEAR 010-001-NMV-SGR-02. CHANGE EAST LOOP 12KV OPEN SWITCH FROM SF6-S7 POSITION 1 TO SF6-S1 POSITION 1. NOTE THE HOSPITAL TOWER NORMAL POWER IS FED FROM GAP SWITCHGEAR 010-001-NMV-SGR-02 AND SWITCHGEAR 010-001-NMV-SGR-02 IS FED FROM SWITCHGEAR 010-001-NMV-SGR-03.
- CHANGE CONTROL PROGRAM FOR SWITCHGEAR 010-001-NMV-SGR-03 TO HAVE A TEMP PROGRAM SO THAT IF GENERATOR POWER IS NEEDED IT WILL REPOWER 010-001-NMV-SGR-02 AFTER MORE THAN 2 EXITING GENERATORS ARE PARALLELED.
- TURN OFF THE EXISTING 4160V CHILLERS AND KEEP THEM OFF. STARTUP 3 OF THE 6 GENERATORS IN THE GENERATOR BUILDING AND HAVE THEM PARALLELED AND STAY RUNNING AND PARALLELED. DISCONNECT THE ESSENTIAL 12KV CABLE FROM HOSPITAL TOWER ATS UNITS OFF OF BREAKER LSC1. SPLICE THE OLD HOSPITAL TOWER ATS ESSENTIAL 12KV CABLE IN MANHOLE MVMH-E-01E TO NEW CABLE FROM NEW GENERATOR SWITCHGEAR 011-01-EMV-SGR-02. NOTE THAT IF A UTILITY POWER IS LOST THE HOSPITAL ATS UNITS WILL NOT RECEIVE ESSENTIAL POWER FROM THE ESSENTIAL FEEDER. HOWEVER, THE NORMAL POWER WILL BE BACK UP IN LESS THAN 10 SECTIONS VIA OLD GENERATOR SWITCHGEAR BREAKER LSC4 FEEDING GAP SWITCHGEAR 010-001-NMV-SGR-03 AND GAP SWITCHGEAR 010-001-NMV-SGR-03 FEEDING SWITCHGEAR 010-001-NMV-SGR-02.
- AFTER SPLICE IS COMPLETED TURN THE 3 GENERATORS FROM FORCE TO RUN BACK TO AUTO AND ALLOW THEM TO AUTO TURN OFF. ENABLE THE EXISTING 4160V CHILLERS TO RUN.
- REMOVE TEMP CONTROL PROGRAM FOR SWITCHGEAR 010-001-NMV-SGR-03 AND INSTALL THE ORIGINAL ONE BACK.
- RECONFIGURE GAP SWITCHGEAR 010-001-NMV-SGR-02 TO BE FED BY MAIN BREAKER GP-M2 BY CLOSING GP-M2 ON SWITCHGEAR 010-001-NMV-SGR-02 AND OPEN BREAKERS FROM SWITCHGEAR 010-001-NMV-SGR-03. CHANGE EAST LOOP 12KV OPEN SWITCH BACK TO THE ORIGINAL LOCATION FROM SF6-S1 POSITION 1 TO SF6-S7 POSITION 1.
- INSTALL NEW 12KV CABLE FROM NEW SWITCHGEAR 011-01-EMV-SGR-02 BREAKER GB-23 TO MANHOLE MVMH-E-01E. TURN OFF EXISTING GENERATOR SWITCHGEAR BREAKER LSC4 THAT FEEDS GENERATOR POWER TO GAP SWITCHGEAR 010-001-NMV-SGR-03 VIA A SPLICE IN MANHOLE MVMH-E-01E. DISCONNECT SPLICE IN MANHOLE MVMH-E-01E AND SPLICE TO NEW CABLE FROM NEW GENERATOR SWITCHGEAR 011-01-EMV-SGR-02 IN MANHOLE MVMH-E-01E. NEW SWITCHGEAR 011-01-EMV-SGR-02 NOW FEEDS GENERATOR POWER TO GAP SWITCHGEAR 010-001-NMV-SGR-03 WHEN NEEDED.
- INCREMENT 2, MILESTONE 3: REFEED ESSENTIAL LOADS SIGN OFF.**

INC 2 MILESTONE 4 (DEMO OLD EXISTING GENERATOR BUILDING SWITCHGEAR AND INSTALL NEW ESSENTIAL SWITCHGEAR):

- TURN OFF THE H-O-A SWITCH FOR GENERATORS 3 THROUGH 6 AND RACK 12KV MAIN BREAKERS FOR GENERATORS 3 THRU 6.
- DEMO OLD EXISTING GENERATOR ESSENTIAL BUS SWITCHGEAR.
- INSTALL NEW SWITCHGEAR 011-01-EMV-SGR-01 AND 011-01-EMV-SGR-02 PART 2 IN GENERATOR BUILDING WITH CONTROLS.
- INSTALL NEW 12KV CABLES FROM GENERATORS 5 AND 6 TO NEW SWITCHGEAR 011-01-EMV-SGR-01 AND NEW 12KV CABLE FROM GENERATORS 3 AND 4 TO NEW SWITCHGEAR 011-01-EMV-SGR-02 PART 2.
- PROGRAM AND TEST NEW SWITCHGEAR.
- TEST TO ENSURE THE NEW SWITCHGEAR 011-01-EMV-SGR-01 IS NOW ABLE TO TAKE ON EMERGENCY LOADS AND POWER FROM GENERATORS 5 AND 6.
- INSTALL NEW FUEL CONTROL SYSTEM AND FILTER.
- CONVERT EXISTING FUEL SYSTEM TO NEW ONE.
- DEMO OLD FUEL CONTROL SYSTEM.
- INCREMENT 2, MILESTONE 4: DEMOLISH EXISTING SWITCHGEAR, INSTALL NEW SWITCHGEAR SIGN OFF.**

INC 2 MILESTONE 5 (COMPLETE THE INSTALL OF NEW SWITCHGEAR 011-01-EMV-SGR-02):

- CONNECT 011-01-EMV-SGR-02 PART 1 AND 011-01-EMV-SGR-02 PART 2 WITH 12KV CABLE AND PROGRAM AND TEST SWITCHGEAR.
- THIS TEST IS TO ENSURE THE NEW SWITCHGEAR IS NOW ABLE TO TAKE ON EMERGENCY LOAD AND POWER FROM GENERATORS 3 AND 4.
- PROGRAM AND TEST THAT ALL 6 GENERATORS CAN NOW PARALLEL AS ONE.
- INCREMENT 2, MILESTONE 5: COMPLETE AND COMMISSIONING ESSENTIAL SWITCHGEAR SIGN-OFF.**

INC 2 MILESTONE 6 (FINAL RECONFIGURATIONS OF THE 12KV SYSTEM):


- THE SURGERY EMERGENCY BUILDING NORMAL 12KV POWER SUPPLY SUB-6N2 IS CONNECTED FROM GAP SWITCHGEAR TO NEW CUP SWITCHGEAR 007-02-NMV-SGR-02.
- THE SURGERY EMERGENCY BUILDING NORMAL 12KV POWER SUPPLY SUB-6N21 IS MOVED FROM GAP SWITCHGEAR 010-001-NMV-SGR-01 TO NEW CUP SWITCHGEAR 007-02-NMV-SGR-01 AND NO LONGER FED FROM GAP SWITCHGEAR 010-001-NMV-SGR-01.
- INSTALL NEW 12KV CABLE FROM THE NEW CUP SWITCHGEAR 007-02-NMV-SGR-02 TO GAP SWITCHGEAR 010-001-NMV-SGR-02 MAIN BREAKER GP-M2. REMOVE NO LONGER USED 12KV POWER SUPPLY CABLE FROM GAP SWITCHGEAR 010-001-NMV-SGR-02 MAIN BREAKER GP-M2 TO GAP SWITCHGEAR 010-001-NMV-SGR-01. GAP SWITCHGEAR 010-001-NMV-SGR-02 IS NOW FED FROM THE NEW CUP SWITCHGEAR 007-02-NMV-SGR-02.
- INSTALL NEW 12KV CABLE FROM GAP SWITCHGEAR 010-001-NMV-SGR-01 BREAKER GP-11 TO MANHOLE MVMH-N-15. CONNECT NEW CABLE FROM GAP SWITCHGEAR 010-001-NMV-SGR-01 BREAKER GP-11 IN MVMH-N-15 TO 12KV CABLE GOING TO TRANSFORMER 011-01-NMV-TRX-01 INPUT SWITCH A. REMOVE NO LONGER USED 12KV CABLE FROM MANHOLE MVMH-N-15 TO GAP SWITCHGEAR 010-001-NMV-SGR-03 BREAKER GP-35.
- UPDATE THE CONTROL PROGRAM FOR SWITCHGEAR 010-001-NMV-SGR-03 TO THE FINAL PROGRAM SO THAT WHEN GENERATOR POWER IS NEEDED TO THE CHILLER/BOILER PLANT IT WILL PRIORITIZE THE BOILER PLANT AS FIRST AND EXTRA POWER FOR THE CHILLER PLANT IF AVAILABLE.
- INSTALL NEW 12KV CABLE TO EXISTING CHILLER PLANT 2000KVA, 12KV TO 4160V TRANSFORMER FROM GAP SWITCHGEAR 010-001-NMV-SGR-03. REMOVE NO LONGER USED 12KV CABLE FROM SF6-S7 TO CHILLER PLANT 2000KVA, 12KV TO 4160V TRANSFORMER.
- INSTALL NEW 12KV CABLE FROM THE NEW CUP SWITCHGEAR 007-02-NMV-SGR-01 TO GAP SWITCHGEAR 010-001-NMV-SGR-01 MAIN BREAKER GP-M1. REMOVE NO LONGER USED 12KV POWER SUPPLY CABLE FROM GAP SWITCHGEAR 010-001-NMV-SGR-01 MAIN BREAKER GP-M1 TO MANHOLE MVMH-N-15. GAP SWITCHGEAR 010-001-NMV-SGR-01 IS NOW FED FROM THE NEW CUP SWITCHGEAR 007-02-NMV-SGR-01.
- INCREMENT 2, MILESTONE 6: FINAL 12KV CONNECTIONS SIGN OFF.**

CONSTRUCTION SEQUENCING

- INCREMENT 1, MILESTONE 1 AND INCREMENT 2, MILESTONE 1 MAY BE CONSTRUCTED CONCURRENTLY.
- DO NOT PROCEED WITH CONSTRUCTION OF INCREMENT 1, MILESTONE 2 UNTIL INCREMENT 1, MILESTONE 1 ARE COMPLETED WITH HCAI SIGN OFF.
- DO NOT PROCEED WITH CONSTRUCTION OF INCREMENT 1, MILESTONE 3 UNTIL INCREMENT 1, MILESTONE 2 IS COMPLETE WITH HCAI SIGN OFF.
- DO NOT PROCEED WITH CONSTRUCTION OF INCREMENT 1, MILESTONE 4 UNTIL INCREMENT 1, MILESTONE 3 IS COMPLETE WITH HCAI SIGN OFF.

CONSTRUCTION SEQUENCE LEGEND

INC 1 MILESTONE 1
INC 2 MILESTONE 1
INC 1 MILESTONE 2
INC 1 MILESTONE 3
INC 1 MILESTONE 4
INC 2 MILESTONE 2
INC 2 MILESTONE 3
INC 2 MILESTONE 4
INC 2 MILESTONE 5
INC 2 MILESTONE 6

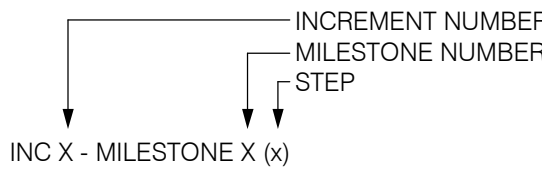

GENERAL NOTES

- ALL OUTAGES REQUIRE A MINIMUM 4 WEEKS NOTICE AND AGREEMENT WITH THE OWNER ON TIMING OF THE OUTAGE. MOPS WILL NEED TO BE SUBMITTED AND APPROVED. OUTAGE DURATION TO BE MINIMIZED SUCH AS ADDING 600A T-BODY WITH CAPACITIVE TEST POINT TO NEW CABLES BEFORE CUTTING INTO EXISTING 12KV CABLES.
- PHASE VOLTAGE ROTATION SHALL BE RECORDED BEFORE THE POWER IS SHUT OFF. CONFIRM THE ROTATION ON THE SUPPLY END AND THE LOAD END OF THE CABLE THAT IS TO BE CUT AND/OR REPLACED. AFTER THE CUT OVER AND BEFORE DOWN STREAM LOADS ARE ALLOWED TO COME ON PERFORM PHASE ROTATION AND PHASE TO PHASE TESTING AT THE NEW SUPPLY AND LOAD END OF THE NEW CABLE. RECORD THE RESULTS AND PROVIDE IN OUTAGE REPORT.
- IF THE OUTAGE FOR THE LOADS IS REQUIRED TO BE LONGER THAN 2.5 HOURS PROVIDE TEMPORARY GENERATORS FOR THE LOADS.
- OUTAGES ARE TO BE BETWEEN 11PM AND 6AM. GENERATORS ARE ALWAYS REQUIRED FOR ANY OUTAGE TO THE IT/SHOPS AND THE CHILLER PLANT 1500KVA TRANSFORMER.




RBB ARCHITECTS INC

Joseph A. Balbons, AIA
Sylvia Botero, AIA
Kevin S. Boots, AIA

10980 Wilshire Boulevard
Los Angeles, California
90024-3905

Telephone 310 473 3555
Facsimile 310 473 3555
www.rbbinc.com

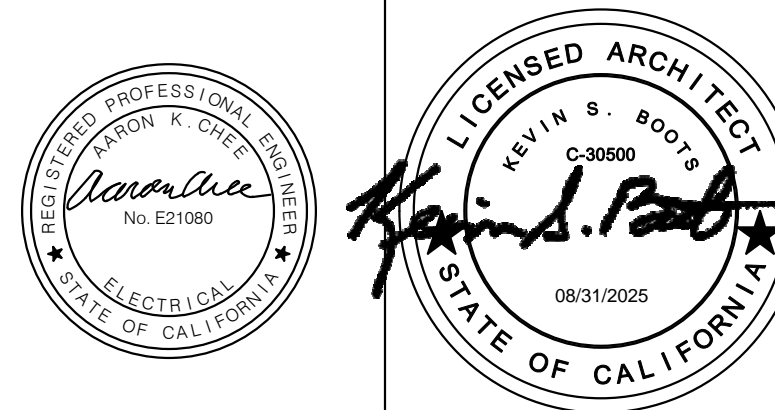

AGENCY APPROVALS

OSHPD # 1240005-19-01

CONSULTANT




Long Beach // Irvine // Los Angeles
San Diego // San Jose // Seattle

p2sinc.com

ISSUE RECORD

DATE	DESCRIPTION
04/09/2025	D ADDENDUM D
03/14/2025	A ADDENDUM A
02/10/2025	BID SET
08/08/2024	HCAI BACKCHECK 1
04/04/2024	HCAI SUBMITTAL

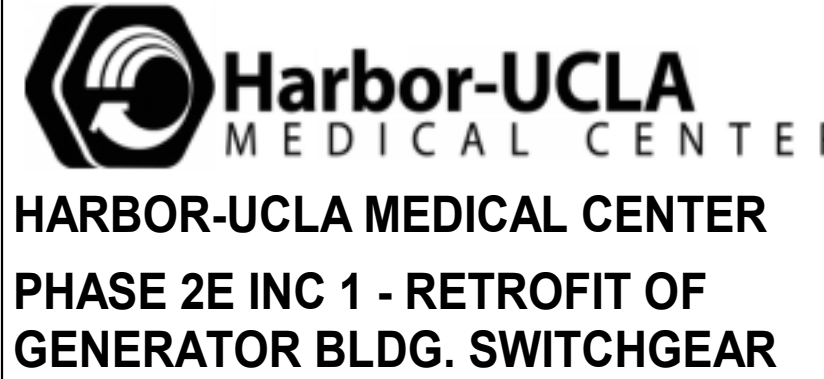


1000 West Carson Street, Torrance, CA 90509

MILESTONE: HCAI SUBMITTAL
MILESTONE DATE: 01/16/24
RBB PROJECT: 1712105 SCALE:

DESCRIPTION
SEQUENCE OF INSTALLATION

DU1-005

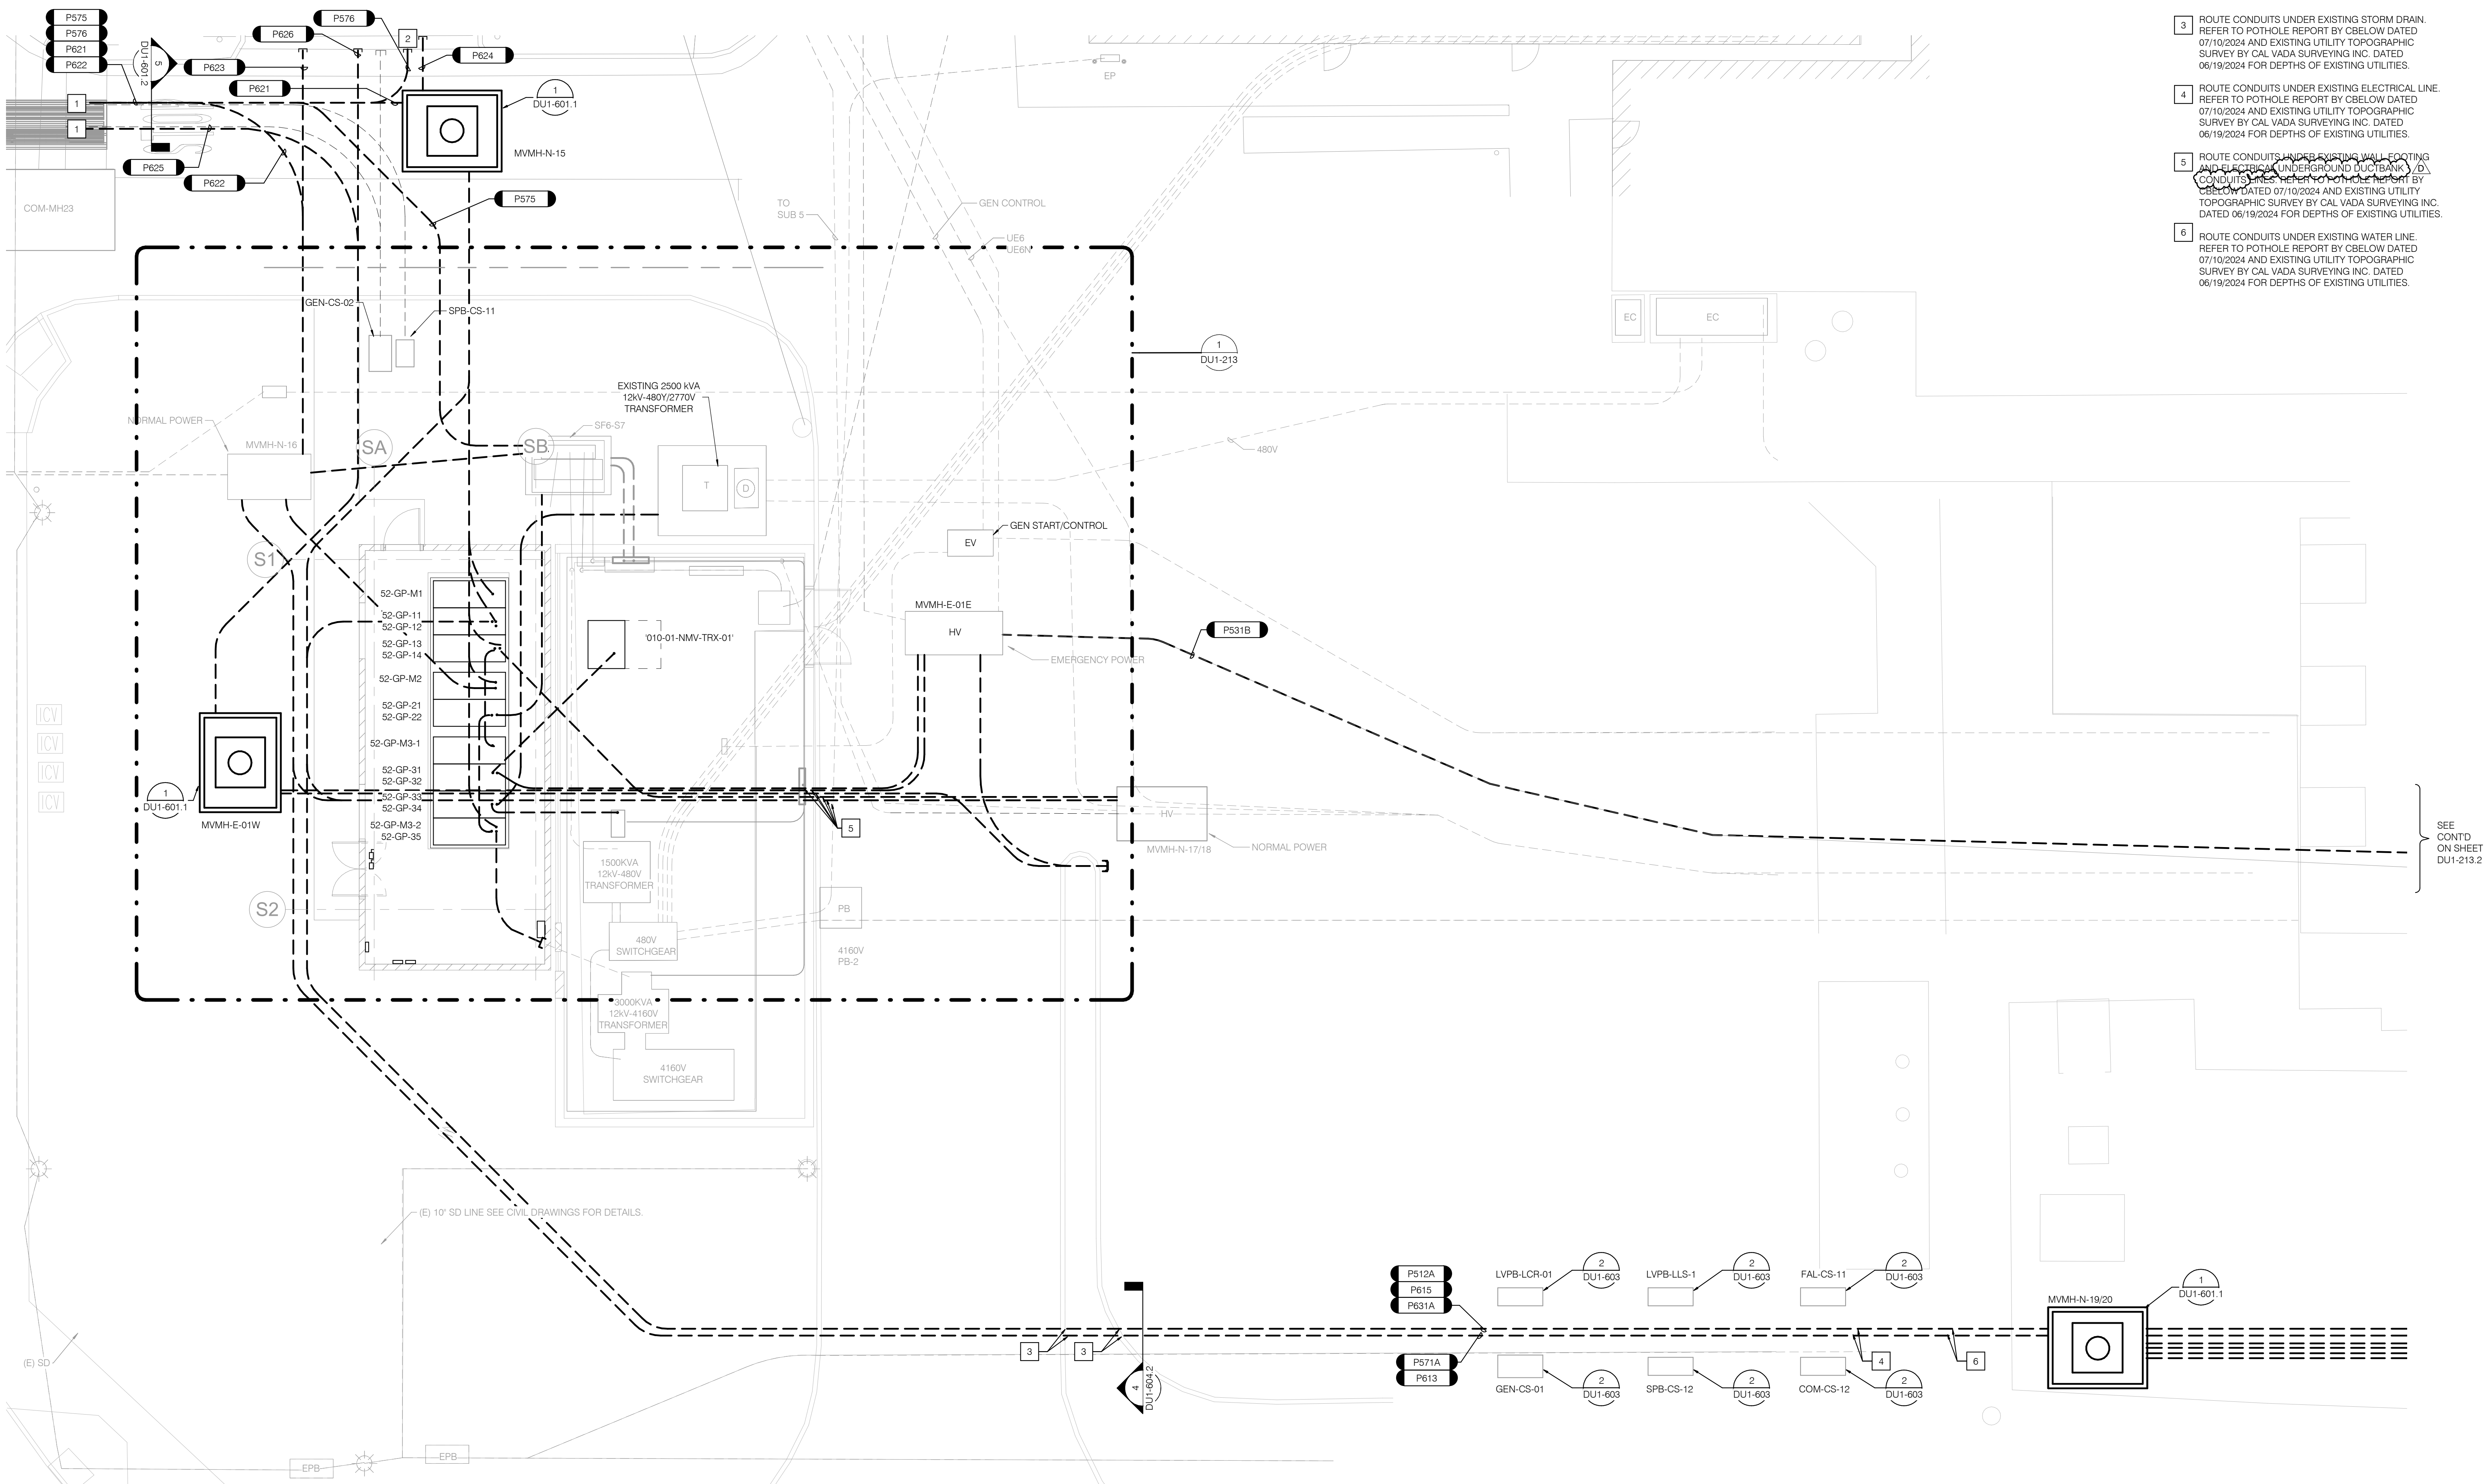

GENERAL NOTES

1. ALL 6" CONDUIT MINIMUM BEND RADIUS IS 60'.
2. THIS SHEET REPRESENTS INSTALLATION OF CONDUITS ONLY. REFER TO SHEET DU1-402.1, DU1-402.2, AND DU1-402.3 FOR CONDUIT INFORMATION.
3. REFER TO SINGLE LINE SHEET DU1-S21 AND DU1-S22 FOR MORE INFORMATION.
4. TYPE MV CABLE SHALL BE INSTALLED, TERMINATED AND TESTED BY QUALIFIED PERSONS AND SHALL BE MARKED AS REQUIRED BY GEO 310.120.
5. PROVIDE INSPECTIONS AND TEST REPORT TO HCA/OSHPD PRIOR TO ENERGIZATION.
6. ALL 4" CONDUIT MINIMUM BEND RADIUS IS 48'.

NOTES

1. CONNECT TO EXISTING DUCKBANK. CONFIRM AND COORDINATE EXISTING CONDUIT DUCTBANKS FOR EACH CONDUIT TO AND FROM LOCATIONS.
2. STUB OUT (1)-5" C WHOSE "OTHER END" IS AT MV/MH-N-13 AND (1)-5" C WHOSE "OTHER END" IS AT MV/MH-N-14.
3. ROUTE CONDUITS UNDER EXISTING STORM DRAIN. REFER TO POT HOLE REPORT BY CBELOW DATED 07/10/2024 AND EXISTING UTILITY TOPOGRAPHIC SURVEY BY CAL VADA SURVEYING INC. DATED 06/19/2024 FOR DEPTHS OF EXISTING UTILITIES.
4. ROUTE CONDUITS UNDER EXISTING ELECTRICAL LINE. REFER TO POT HOLE REPORT BY CBELOW DATED 07/10/2024 AND EXISTING UTILITY TOPOGRAPHIC SURVEY BY CAL VADA SURVEYING INC. DATED 06/19/2024 FOR DEPTHS OF EXISTING UTILITIES.
5. ROUTE CONDUITS UNDER EXISTING WALL FOOTING AND EXISTING UNDERGROUND DUCTBANK. DO NOT CROSS UNDERGROUND DUCTBANKS BY CBELOW DATED 07/10/2024 AND EXISTING UTILITY TOPOGRAPHIC SURVEY BY CAL VADA SURVEYING INC. DATED 06/19/2024 FOR DEPTHS OF EXISTING UTILITIES.
6. ROUTE CONDUITS UNDER EXISTING WATER LINE. REFER TO POT HOLE REPORT BY CBELOW DATED 07/10/2024 AND EXISTING UTILITY TOPOGRAPHIC SURVEY BY CAL VADA SURVEYING INC. DATED 06/19/2024 FOR DEPTHS OF EXISTING UTILITIES.



RBB ARCHITECTS INC

Joseph A. Balbons, AIA
Sylvia Botero, AIA
Kevin S. Boots, AIA

10980 Wilshire Boulevard
Los Angeles, California
90024-3905

Telephone 310 473 3555
Facsimile 310 473 3555
www.rbbinc.com



AGENCY APPROVALS

OSHPD # 1240005-19-01

CONSULTANT

P2S ENG

Long Beach // Irvine // Los Angeles
San Diego // San Jose // Seattle

p2sinc.com

ISSUE RECORD

DATE	DESCRIPTION
04/09/2025	D ADDENDUM D
03/14/2025	A ADDENDUM A
02/10/2025	BID SET
01/31/2025	3 HCAI BACKCHECK 2
08/08/2024	HCAI BACKCHECK 1
04/04/2024	HCAI SUBMITTAL




HARBOR-UCLA MEDICAL CENTER
PHASE 2E INC 1 - RETROFIT OF
GENERATOR BLDG. SWITCHGEAR

1000 West Carson Street, Torrance, CA 90509


MILESTONE: HCAI SUBMITTAL
MILESTONE DATE: 12/21/23
RBB PROJECT: 1712105 SCALE: 1/8" = 1'-0"

DESCRIPTION
ENLARGED 12KV SITE UG
POWER PLAN - GAP BLDG

(MILESTONE 1)

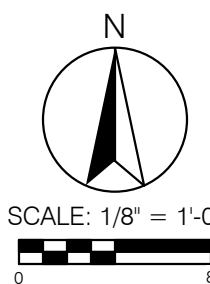

DU1-212

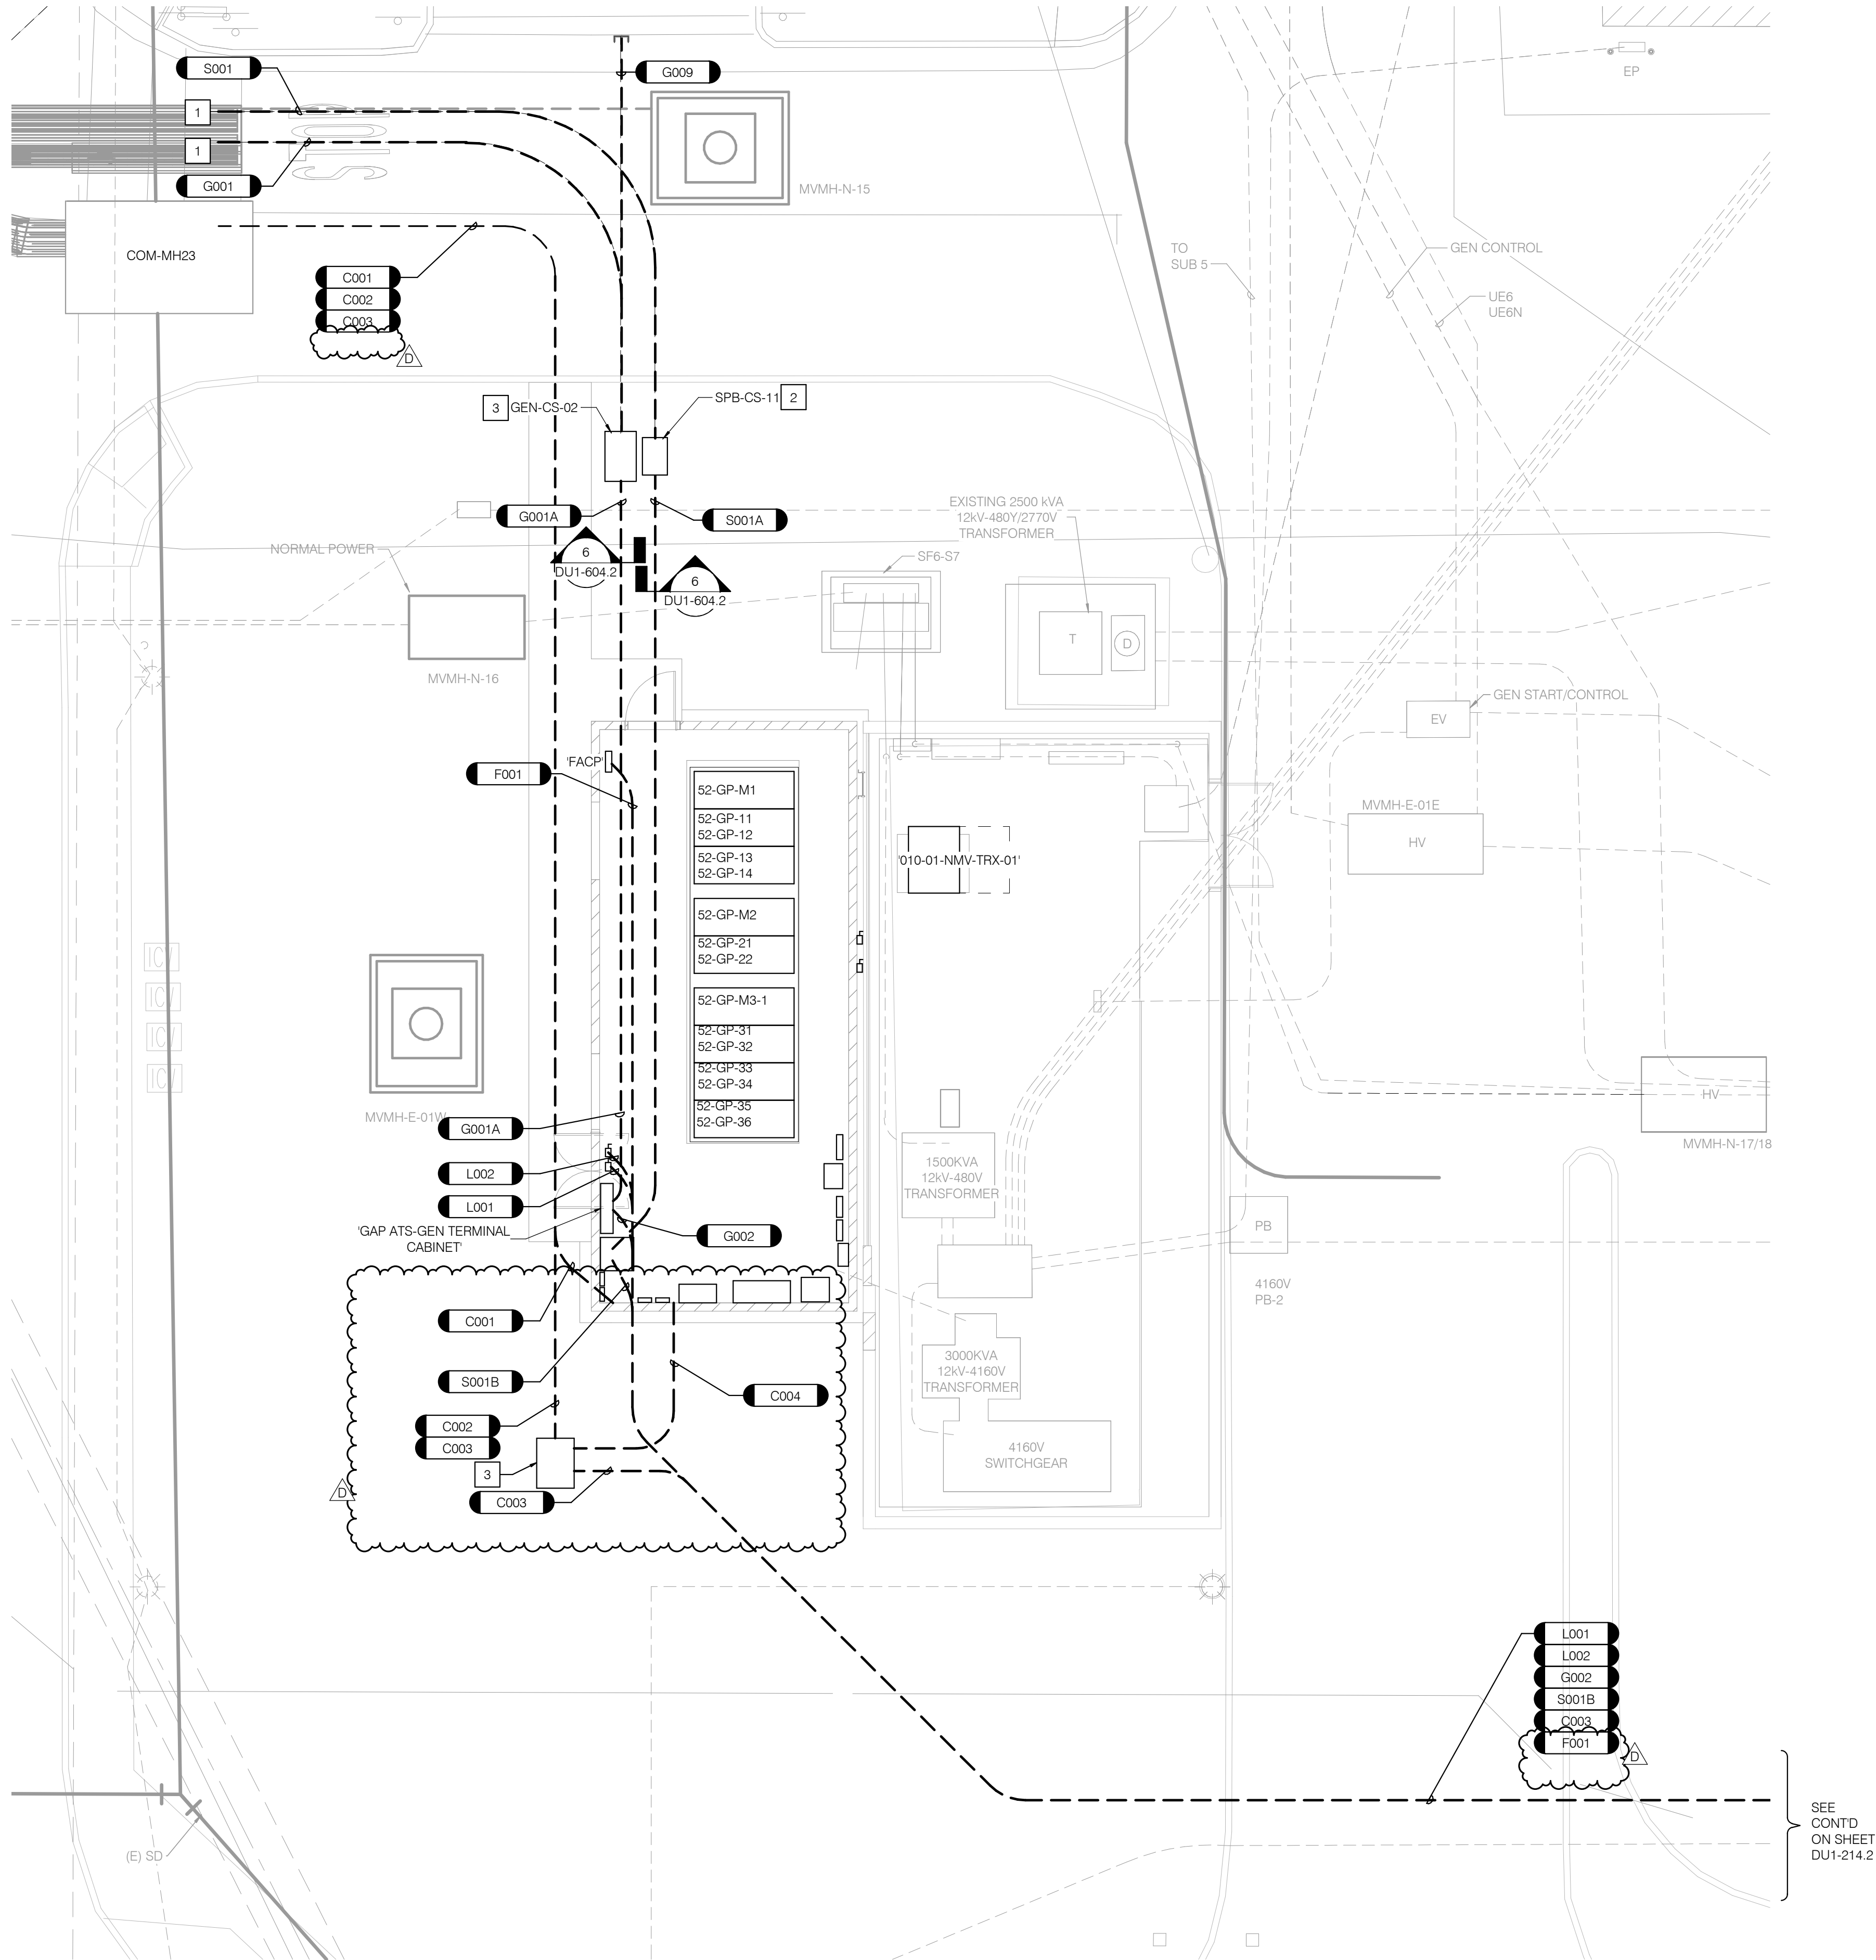

GENERAL NOTES

1. SEE DRAWING DU1-004 FOR EQUIPMENT CATALOG NUMBERS FOR WHICH THIS DESIGN IS BASED ON.
2. SEE DRAWING DU1-402.1, DU1-402.2, AND DU1-402.3 FOR CONDUIT AND CABLE SCHEDULE.
3. REFER TO DRAWINGS DU1-211, DU1-212, DU1-213.1, DU1-213.2 FOR ADDITIONAL CONDUITS TO BE INSTALLED DURING MILESTONE 1.
4. ALL 6" CONDUIT MINIMUM BEND RADIUS IS 60'.
5. ALL 4" CONDUIT MINIMUM BEND RADIUS IS 48'.

NOTES

1. CONNECT TO EXISTING DUCKBANK.
2. IN GROUND PULL BOX 2'WX3'LX3'H FEET. SEE DRAWING DU1-603 DETAIL 2.
3. IN GROUND PULL BOX 2.5'WX4'LX3'H. SEE DRAWING DU1-601.2 DETAIL 5.




RBB ARCHITECTS INC

Joseph A. Balbons, AIA
Sylvia Botero, AIA
Kevin S. Boots, AIA

10980 Wilshire Boulevard
Los Angeles, California
90024-3905

Telephone 310 473 3555
Facsimile 310 473 3555
www.rbbinc.com

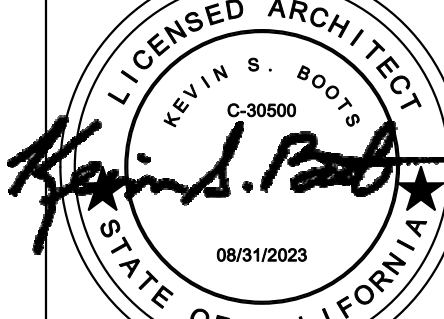

AGENCY APPROVALS

OSHPD # 1240005-19-01

CONSULTANT



Long Beach // Irvine // Los Angeles
San Diego // San Jose // Seattle

p2sinc.com

ISSUE RECORD

DATE	DESCRIPTION
04/09/2025	D - ADDENDUM D
03/14/2025	A - ADDENDUM A
02/10/2025	BID SET
01/31/2025	3 - HCAI BACKCHECK 2
04/04/2024	HCAI SUBMITTAL




HARBOR-UCLA MEDICAL CENTER
PHASE 2E INC 1 - RETROFIT OF
GENERATOR BLDG. SWITCHGEAR

1000 West Carson Street, Torrance, CA 90509


MILESTONE: HCAI SUBMITTAL
MILESTONE DATE: 12/21/23
RBB PROJECT: 1712105 SCALE: 1/8" = 1'-0"

DESCRIPTION
ENLARGED 208/120V, SCADA,
FIRE, COM, GEN START SITE UG
PLAN - GAP SWGR BLDG

DU1-214.1

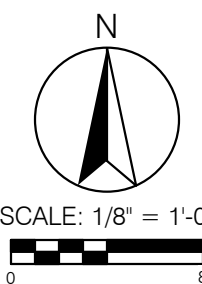

(MILESTONE 1)

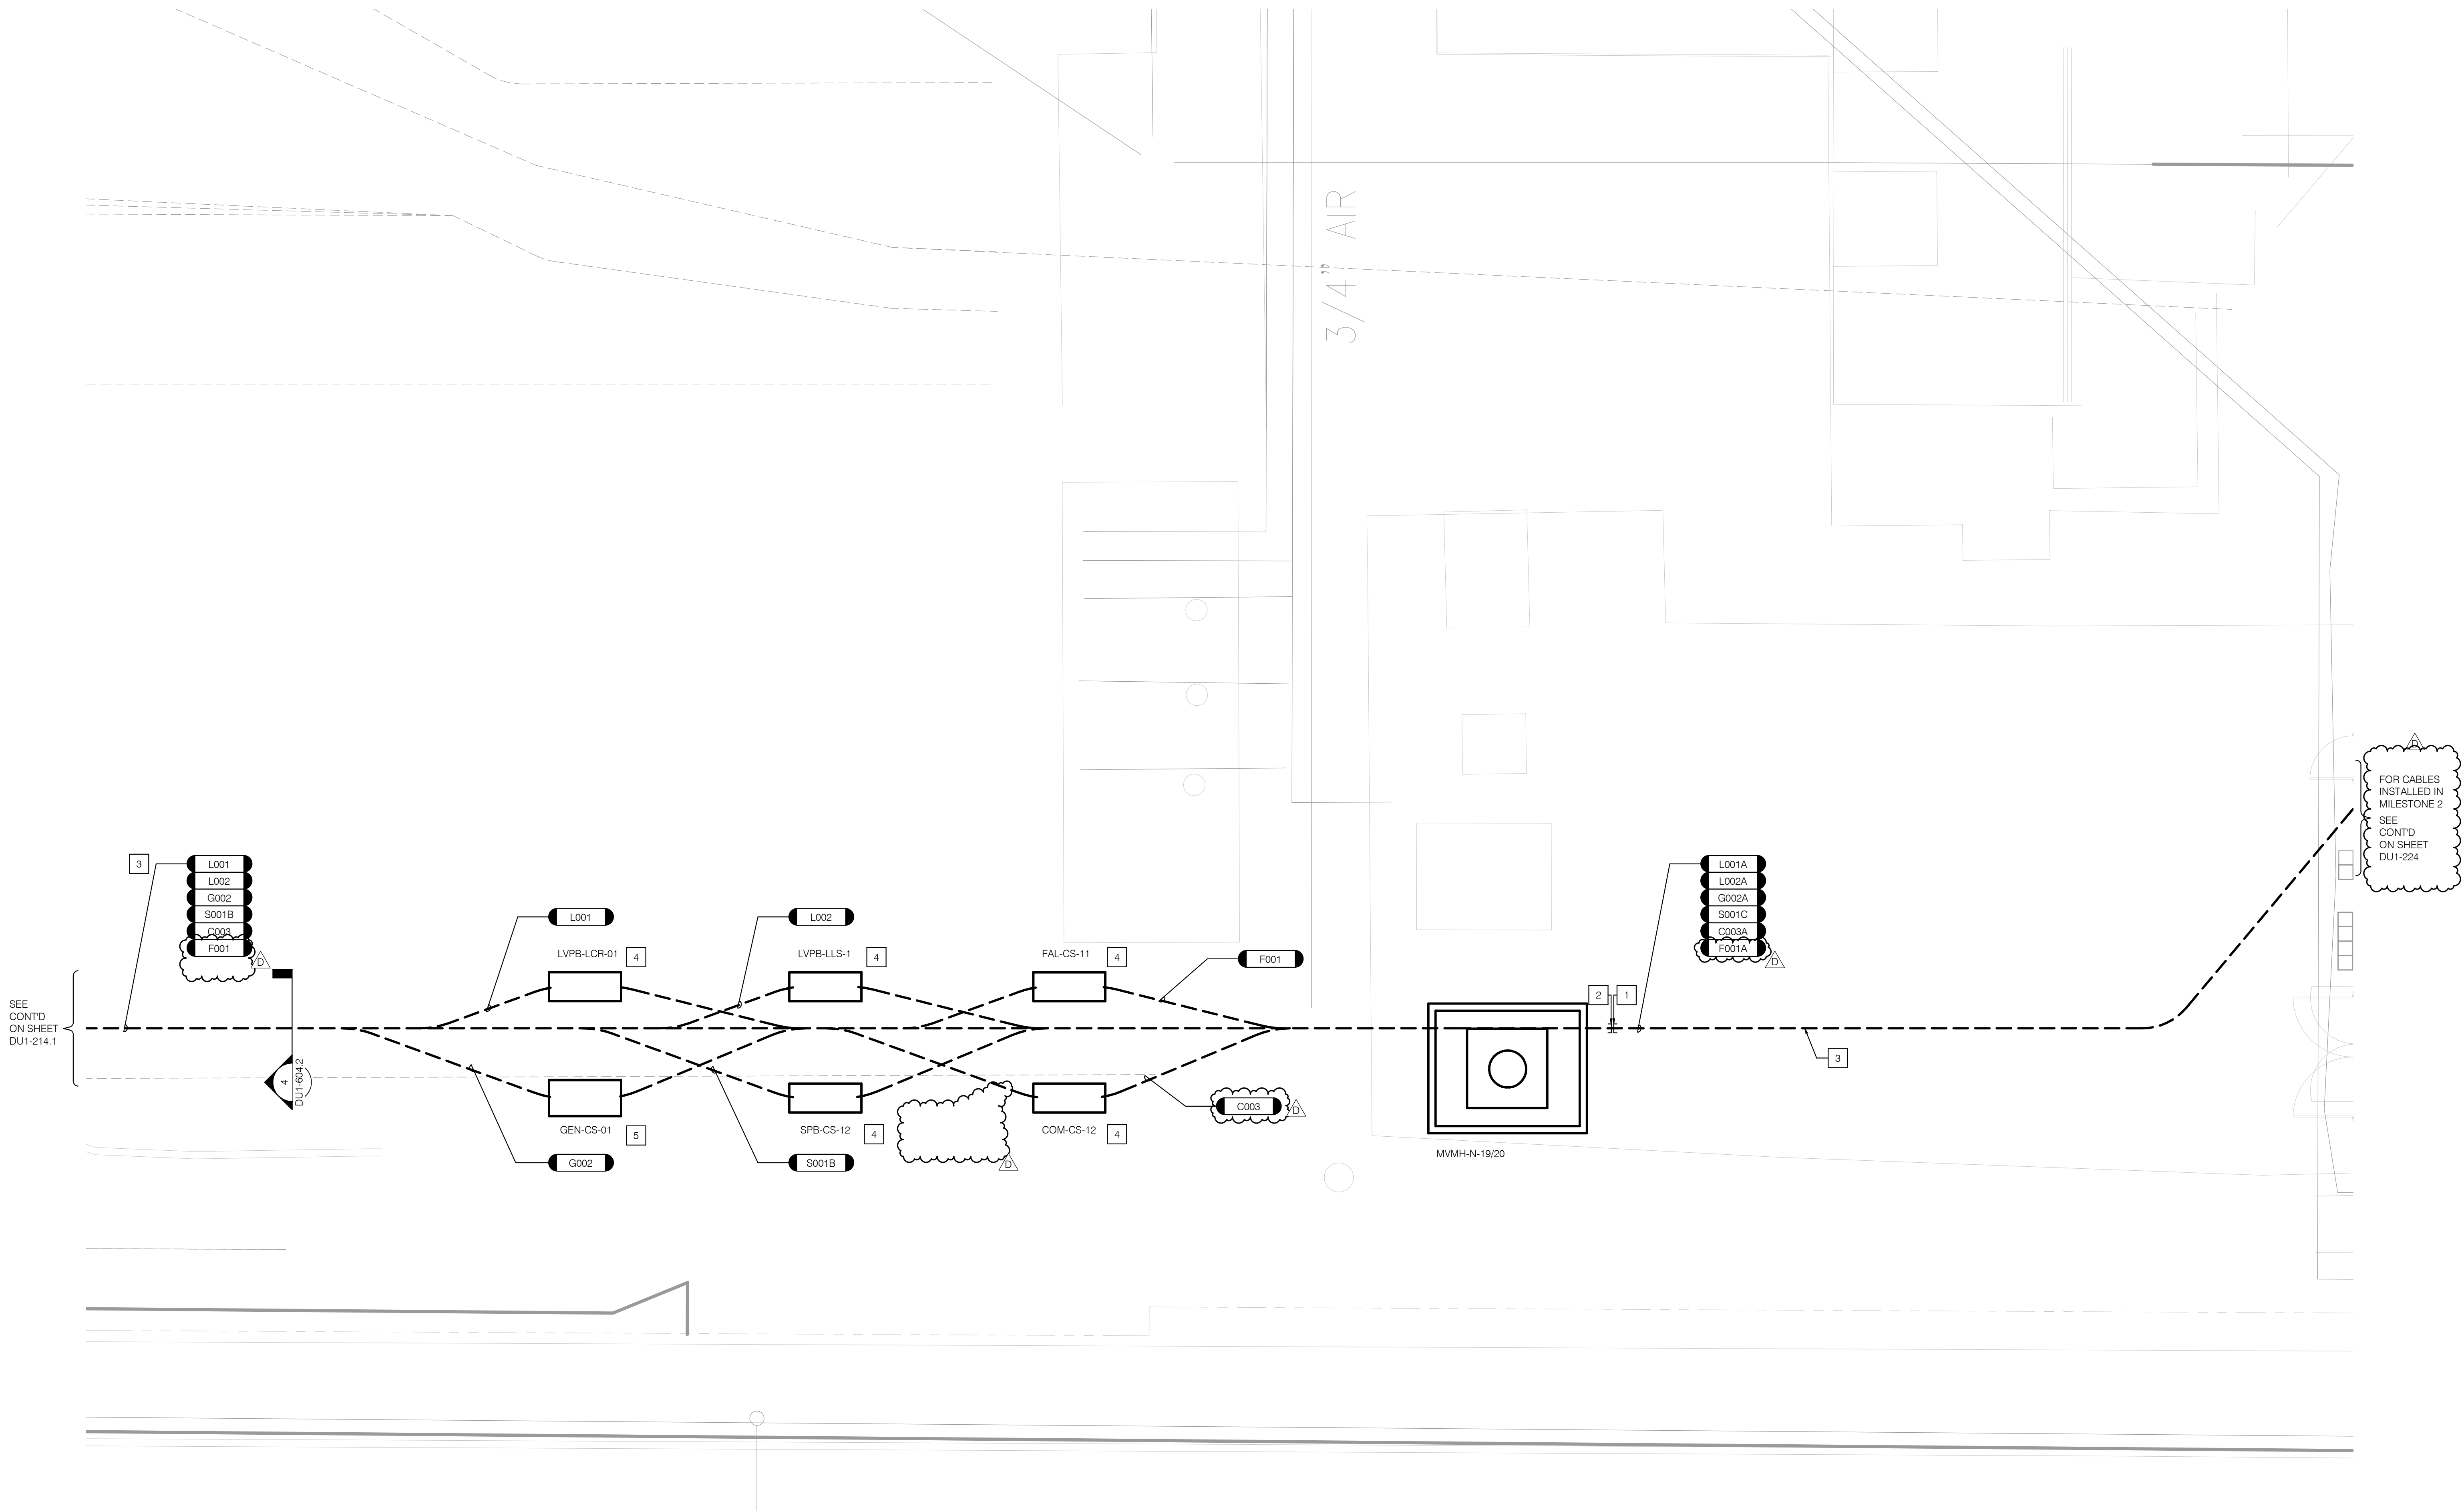

GENERAL NOTES

1. REFER TO DRAWINGS DU1-211, DU1-212, DU1-213.1, DU1-213.2, DU1-214.1 FOR ADDITIONAL CONDUITS TO BE INSTALLED DURING MILESTONE 1.

NOTES

- 1 UNDERGROUND EAST CONDUITS BY INC 2 CONTRACTOR. REMOVE CAP AND CONNECT CONDUIT TO INC 1 STUB OUT.
- 2 UNDERGROUND WEST CONDUITS BY INC 1 CONTRACTOR. REMOVE CAP AND CONNECT CONDUIT TO INC 2 STUB OUT.
- 3 ROUTE CONDUITS UNDER EXISTING UTILITIES.
- 4 IN GROUND PULLBOX 2'WX3' LX3'H. SEET DRAWING DU1-603 DETAIL 2.
- 5 IN GROUND PULLBOX 2.5'WX4' LX3'H. SEE DRAWING DU1-601.2 DETAIL 5.




RBB ARCHITECTS INC

Joseph A. Balbons, AIA
Sylvia Botero, AIA
Kevin S. Boots, AIA

10980 Wilshire Boulevard
Los Angeles, California
90024-3905

Telephone 310 473 3555
Facsimile 310 473 3555
www.rbbinc.com

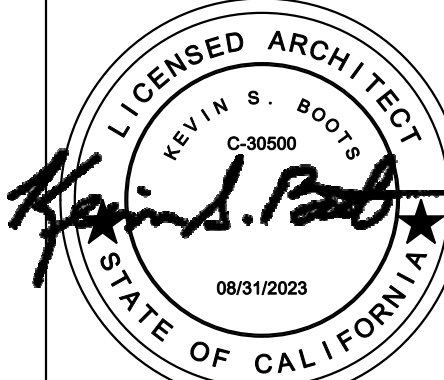

AGENCY APPROVALS

OSHPD # 1240005-19-01

CONSULTANT



Long Beach // Irvine // Los Angeles
San Diego // San Jose // Seattle

p2sinc.com

ISSUE RECORD

04/09/2025	D	ADDENDUM D
03/14/2025	A	ADDENDUM A
02/10/2025		BID SET
01/31/2025	3	HCAI BACKCHECK 2
08/08/2024		HCAI BACKCHECK 1
04/04/2024		HCAI SUBMITTAL
DATE	△	DESCRIPTION



HARBOR-UCLA MEDICAL CENTER
PHASE 2E INC 2 - GENERATOR BLDG.
RETROFIT

1000 West Carson Street, Torrance, CA 90509

MILESTONE: HCAI SUBMITTAL

MILESTONE DATE: 10/25/2024


RBB PROJECT: 1712105 SCALE: 3/16" = 1'-0"

DESCRIPTION
ENLARGED 208/120V, SCADA,
FIRE, COM, GEN START SITE UG
POWER PLAN

DU1-214.2

(MILESTONE 1)

Print Date: 3/13/2025 6:00:22 PM

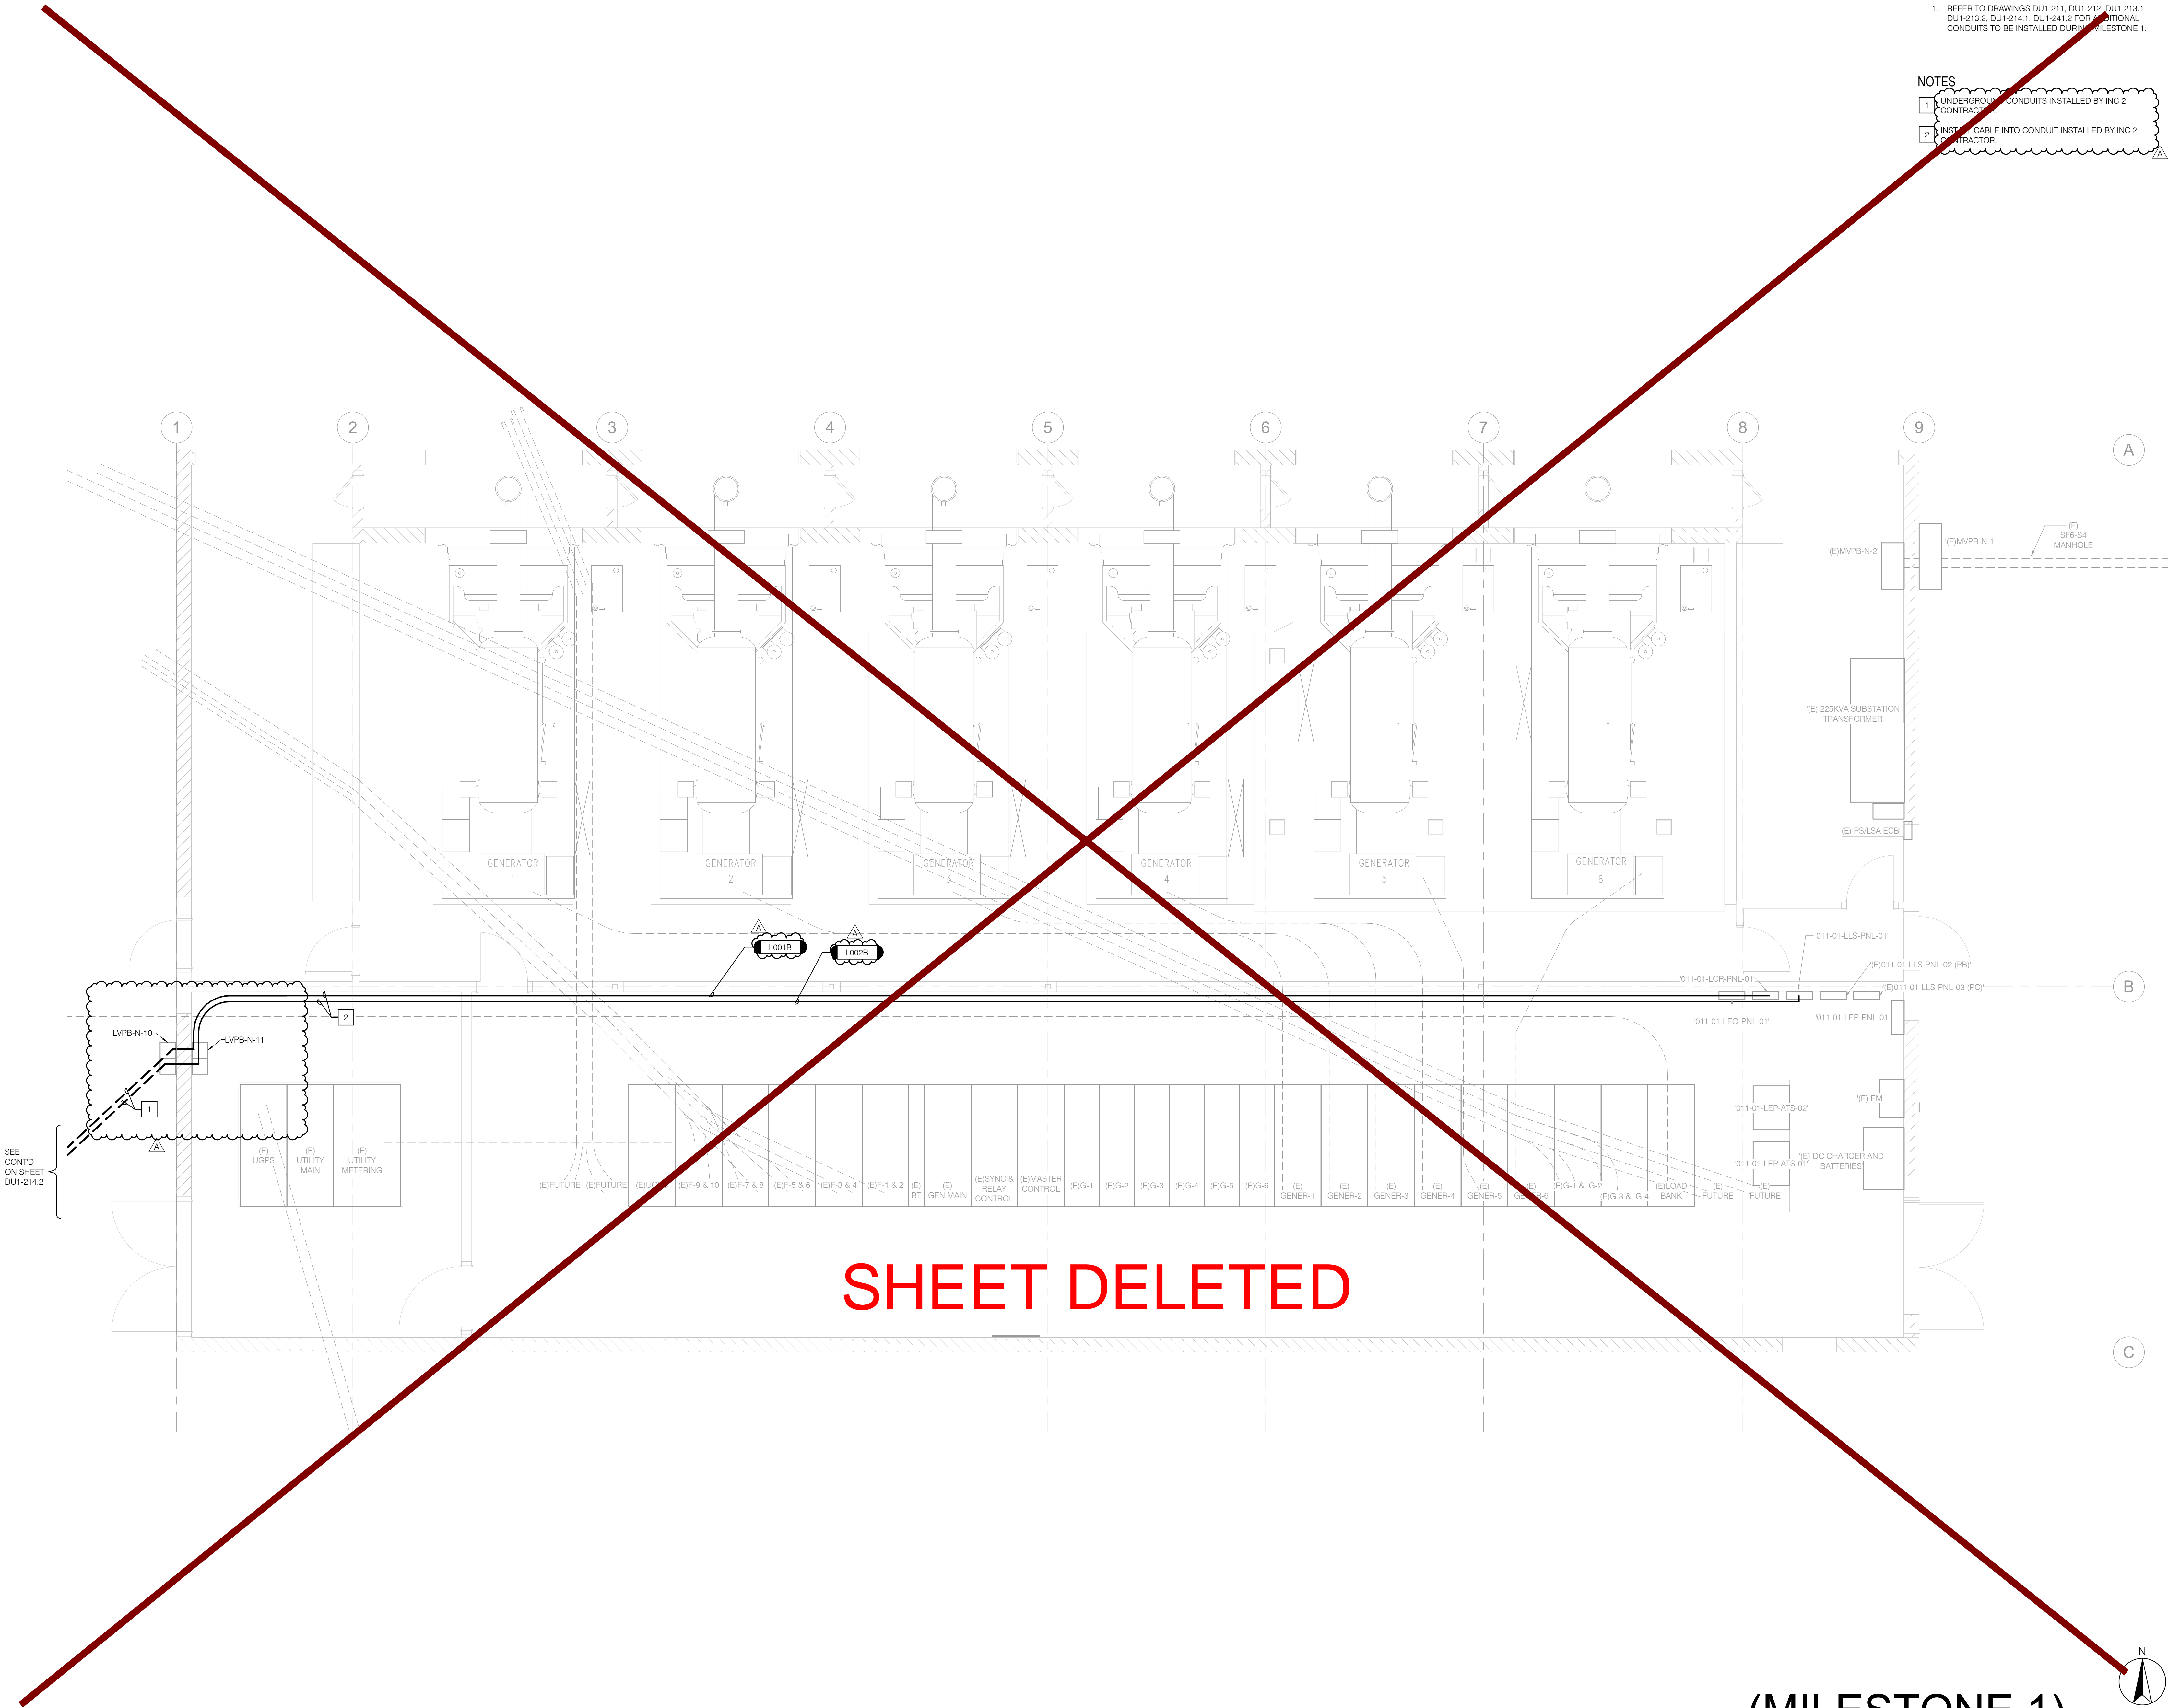


GENERAL NOTES

1. REFER TO DRAWINGS DU1-211, DU1-212, DU1-213.1, DU1-213.2, DU1-214.1, DU1-241.2 FOR ADDITIONAL CONDUITS TO BE INSTALLED DURING MILESTONE 1.

NOTES

1. UNDERGROUND CONDUITS INSTALLED BY INC 2 CONTRACTOR.
2. INSTALL CABLE INTO CONDUIT INSTALLED BY INC 2 CONTRACTOR.

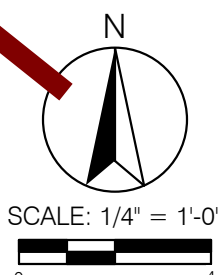


RBB ARCHITECTS INC

Joseph A. Balbons, AIA
Sylvia Botero, AIA
Kevin S. Boots, AIA

10980 Wilshire Boulevard
Los Angeles, California
90024-3905

Telephone 310 473 3555
Facsimile 310 473 3555
www.rbbinc.com

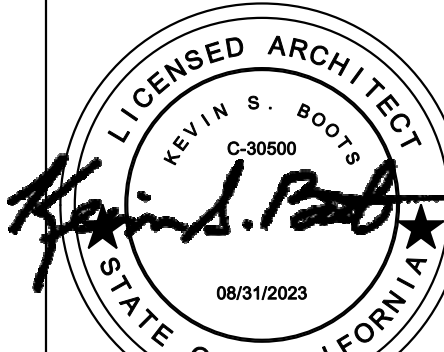

AGENCY APPROVALS

OSHPD # 1240005-19-01

CONSULTANT

P2S ENG

Long Beach // Irvine // Los Angeles
San Diego // San Jose // Seattle

p2sinc.com

ISSUE RECORD

DATE	DESCRIPTION
03/14/2025	A - ADDENDUM A
02/10/2025	BID SET
01/31/2025	HCAI BACKCHECK 2
04/04/2024	HCAI SUBMITTAL



HARBOR-UCLA MEDICAL CENTER
PHASE 2E INC 1 - RETROFIT OF
GENERATOR BLDG. SWITCHGEAR

1000 West Carson Street, Torrance, CA 90509

MILESTONE: HCAI SUBMITTAL

MILESTONE DATE: 12/21/23

RBB PROJECT: 1712105 SCALE: 1/4" = 1'-0"

DESCRIPTION
ENLARGED 208/120V, SCADA,
FIRE, COM, GEN START SITE UG
POWER PLAN - GEN BLDG

DU1-214.3



DESCRIPTION
ENLARGED 208/120V, SCADA,
FIRE, COM, GEN START SITE UG
POWER PLAN - GEN BLDG

Print Date: 4/15/2025 2:45:24 PM

GENERAL NOTES											
1. TYPE MV CABLE SHALL BE INSTALLED, TERMINATED AND TESTED BY QUALIFIED PERSONS AND SHALL BE MARKED AS REQUIRED BY CEC 310.120.											
2. SEE THE CONDUIT AND CABLE SCHEDULE FOR CONDUIT TYPES. CONDUIT INDOORS SHALL BE RGS FOR CONDUITS CONTAINING HIGH VOLTAGE CABLE OF 1000V OR GREATER. CONDUIT OUTSIDE SHALL BE RGS. CONDUIT CONTAINING VOLTAGES 600V OR LESS INSTALLED INDOORS AND ABOVE 9' CAN BE EMT.											
3. SPLICING OF MV CABLES ARE TO BE MADE WITH 600A T-BODY WITH CAPACITIVE TEST POINT.											
ID	FROM	TO	PHASE CABLE SIZE	PHASE CABLE TYPE	GROUND CONDUCTOR SIZE	GROUND CONDUCTOR TYPE	NEW CONDUIT SIZE	NEW CONDUIT TYPE	VIA	CONTRACTOR SCOPE	REMARKS
C001	PULLBOX 'COM-MH23'	STUB UP IN GAP BUILDING BUILDING	-	-	-	-	4"	PVC	-	INC 1	
C002	PULLBOX 'COM-MH23'	PULLBOX 'COM-CS-13'	-	-	-	-	2" 4"	PVC	COM-CS-12, COM-CS-12	INC 1	
C003	PULLBOX 'COM-MH23'	STUB OUT NEAR MVMH-N-19/20	-	-	-	-	(3) 2"	PVC	-	INC 1	
C003A	STUB OUT NEAR MVMH-N-19/20	GEN BUILDING	-	-	-	-	(3) 2"	PVC	-	INC 2	
C004	PULLBOX 'COM-CS-13'	STUB UP IN GAP BUILDING BUILDING	-	-	-	-	(1) 2"	PVC	-	INC 1	
C005	GEN BUILDING IDF ENCLOSURE	GEN BUILDING BACKBOARD	-	-	-	-	(1) 2"	PVC	-	INC 2	
D100	BATTERY RACK '011-01-DNB-BAT-01'	DISCONNECT '011-01-DNP-BDS-01'	2-2 AWG	0.6 KV, CU, THHN/THWN	1-8 AWG	THHN/THWN	1"	IMC	-	INC 2	
D101	DISCONNECT '011-01-DNP-BDS-01'	SPLICE BOX	2-2 AWG	0.6 KV, CU, THHN/THWN	1-8 AWG	THHN/THWN	1"	IMC	-	INC 2	
D102	BATTERY CHARGER '011-01-DNP-BCH-01'	SPLICE BOX	2-2 AWG	0.6 KV, CU, THHN/THWN	1-8 AWG	THHN/THWN	1"	IMC	-	INC 2	
D103	SPLICE BOX	PANEL '011-01-DNP-PNL-01'	2-2 AWG	0.6 KV, CU, THHN/THWN	1-8 AWG	THHN/THWN	1"	IMC	-	INC 2	
D104	PANEL '011-01-DNP-PNL-01'	PANEL '011-01-DNP-PNL-02'	2-2 AWG	0.6 KV, CU, THHN/THWN	1-8 AWG	THHN/THWN	1"	IMC	-	INC 2	
D105	PANEL '011-01-DNP-PNL-01'	PANEL '011-01-DNP-PNL-03'	2-2 AWG	0.6 KV, CU, THHN/THWN	1-8 AWG	THHN/THWN	1"	IMC	-	INC 2	
D106	PANEL '011-01-DNP-PNL-01'	011-01-EMV-SGR-01 RELAYS, POWER METERS AND SWGR CIRCUIT BREAKERS 'OPEN'	4#12AWG,...	0.6 KV, CU, THHN/THWN	1#10AWG	THHN/THWN	1"	IMC	-	INC 2	
D107	PANEL '011-01-DNP-PNL-01'	011-01-EMV-SGR-01 CIRCUIT BREAKERS 'CLOSE'	2#6AWG	0.6 KV, CU, THHN/THWN	1#10AWG	THHN/THWN	1.25"	IMC	-	INC 2	
D108	PANEL '011-01-DNP-PNL-01'	SCADA CONTROL AND GEN CONTROL	6#12AWG,...	0.6 KV, CU, THHN/THWN	1#10AWG	THHN/THWN	1"	IMC	-	INC 2	
D200	BATTERY RACK '011-01-DNB-BAT-02'	DISCONNECT '011-01-DNP-BDS-02'	2-2 AWG	0.6 KV, CU, THHN/THWN	1-8 AWG	THHN/THWN	1"	IMC	-	INC 2	
D201	DISCONNECT '011-01-DNP-BDS-0'	SPLICE BOX	2-2 AWG	0.6 KV, CU, THHN/THWN	1-8 AWG	THHN/THWN	1"	IMC	-	INC 2	
D202	BATTERY CHARGER '011-01-DNP-BCH-02'	SPLICE BOX	2-2 AWG	0.6 KV, CU, THHN/THWN	1-8 AWG	THHN/THWN	1"	IMC	-	INC 2	
D203	SPLICE BOX	PANEL '011-01-DNP-PNL-02'	2-2 AWG	0.6 KV, CU, THHN/THWN	1-8 AWG	THHN/THWN	1"	IMC	-	INC 2	
D204	PANEL '011-01-DNP-PNL-02'	PANEL '011-01-DNP-PNL-03'	2-2 AWG	0.6 KV, CU, THHN/THWN	1-8 AWG	THHN/THWN	1"	IMC	-	INC 2	
D205	PANEL '011-01-DNP-PNL-02'	011-01-EMV-SGR-02 (PART A) RELAYS, POWER METERS AND SWGR CIRCUIT BREAKERS 'OPEN'	4#12AWG,...	0.6 KV, CU, THHN/THWN	1#10AWG	THHN/THWN	1"	IMC	-	INC 2	
D206	PANEL '011-01-DNP-PNL-02'	011-01-EMV-SGR-02 (PART A) CIRCUIT BREAKERS 'CLOSE'	2#6AWG	0.6 KV, CU, THHN/THWN	1#10AWG	THHN/THWN	1"	IMC	-	INC 2	
D207	PANEL '011-01-DNP-PNL-02'	011-01-EMV-SGR-02 (PART B) RELAYS, POWER METERS AND SWGR CIRCUIT BREAKERS 'OPEN'	4#12AWG,...	0.6 KV, CU, THHN/THWN	1#10AWG	THHN/THWN	1"	IMC	-	INC 2	
D208	PANEL '011-01-DNP-PNL-02'	011-01-EMV-SGR-02 (PART B) SWGR CIRCUIT BREAKERS 'CLOSE'	2#6AWG	0.6 KV, CU, THHN/THWN	1#10AWG	THHN/THWN	1"	IMC	-	INC 2	
D301	PANEL '011-01-DNP-PNL-03'	011-01-EMV-SGR-03 RELAYS, POWER METERS AND SWGR CIRCUIT BREAKERS 'OPEN'	4#12AWG,...	0.6 KV, CU, THHN/THWN	1#10AWG	THHN/THWN	1"	IMC	-	INC 2	
D302	PANEL '011-01-DNP-PNL-03'	011-01-EMV-SGR-03 SWGR CIRCUIT BREAKERS 'CLOSE'	2#6AWG	0.6 KV, CU, THHN/THWN	1#10AWG	THHN/THWN	1"	IMC	-	INC 2	
D303	PANEL '011-01-DNP-PNL-03'	SCADA CONTROL AND GEN CONTROL	6#12AWG,...	0.6 KV, CU, THHN/THWN	1#10AWG	THHN/THWN	1.25"	IMC	-	INC 2	
F001	FACP IN GAP BUILDING	STUB OUT NEAR MVMH-N-19/20	-	-	-	-	(2) 2"	PVC	FAL-CS-11	INC 1	
F001A	STUB OUT NEAR MVMH-N-19/20	(E) FIRE ALARM TERMINAL CABINET IN GENERATOR BUILDING	-	-	-	-	(2) 2"	PVC	-	INC 2	
S001	EXISTING CONDUITS INSTALLED BY PHASE 1A, INC 3 DUCTBANK PROJECT	PULLBOX 'SPB-CS-11'	-	-	-	-	(4) 2"	PVC	-	INC 1	CONNECT (2) CONDUITS FORM SPB-CS-09 AND (2) FROM SPB-CS-10
S001A	PULLBOX 'SPB-CS-11'	SCADA FIBER PATCH PANEL IN GAP SWITCHGEAR BUILDING	-	-	-	-	(4) 2"	PVC	-	INC 1	SEE DU2-403.2 FOR CABLE REQUIREMENTS
S001B	(4) FIBER PATCH PANELS: (2) SCADA, GEN CONTROL, AND ATS METER FIBER PATCH PANELS IN GAP...	STUB OUT NEAR MVMH-N-19/20	-	-	-	-	(4) 2"	PVC/IMC	SPB-CS-12	INC 1	
S001C	STUB OUT NEAR MVMH-N-19/20	(4) FIBER PATCH PANELS: (2) SCADA, GEN CONTROL, AND ATS METER FIBER PATCH PANELS IN ...	-	-	-	-	(4) 2"	PVC/IMC	-	INC 2	
S001D	(4) FIBER PATCH PANELS: (2) SCADA, GEN CONTROL, AND ATS METER FIBER PATCH PANELS IN GAP...	(4) FIBER PATCH PANELS: (4) FIBER PATCH PANELS: (2) SCADA, GEN CONTROL, AND ATS METER...	-	-	-	-	-	-	-	INC 2	SEE DU2-403.2 FOR CABLE REQUIREMENTS
S001E	(4) FIBER PATCH PANELS: (2) SCADA, GEN CONTROL, AND ATS METER FIBER PATCH PANELS IN GEN...	GENERATOR BLDG SWGR SCADA AND GEN CONTROL SECTION	-	-	-	-	-	-	-	INC 2	SEE DU2-403.2 FOR CABLE REQUIREMENT INSTALL IN WIREWAY
G001	EXISTING CONDUITS FROM PULLBOX 'GEN-CS-03' INSTALLED BY PHASE 1A, INC 3 DUCTBANK...	PULLBOX 'GEN-CS-02'	-	-	-	-	(7) 2"	PVC	-	INC 1	SEE DU2-403.2 FOR CABLE REQUIREMENTS
G001A	PULLBOX 'GEN-CS-02'	ATS-GEN TERMINAL CABINET IN GAP BUILDING	-	-	-	-	(9) 2"	PVC	-	INC 1	SEE DU2-403.2 FOR CABLE REQUIREMENTS
G002	ATS-GEN TERMINAL CABINET IN GAP BUILDING	STUB OUT NEAR MVMH-N-19/20	-	-	-	-	(7) 2"	PVC/IMC	GEN-CS-01W	INC 1	
G002A	STUB OUT NEAR MVMH-N-19/20	ATS-GEN TERMINAL CABINET IN GENERATOR BUILDING	-	-	-	-	(7) 2"	PVC/IMC/RMC	-	INC 2	USE RMC OUTSIDE
G002B	ATS-GEN TERMINAL CABINET IN GENERATOR BUILDING	GENERATOR BLDG SWGR GEN CONTROL SECTION	156#12AWG	-	-	-	-	-	-	INC 2	INSTALL IN WIREWAY
G002C	ATS-GEN TERMINAL CABINET IN GAP BUILDING	ATS-GEN TERMINAL CABINET IN GENERATOR BUILDING	264#12 AWG	-	-	-	-	-	-	INC 2	(1) 2"C-36#12, (1) 2"C-48#12, (3) 2"C-60#12
G003	GENERATOR CONTROL CABINET IN EXISTING GENERATOR BUILDING	TRANSFER SWITCH #1 IN SUB 1	-	-	-	-	-	-	GEN-CS-01E, GEN-CS-02E	INC 2	SEE DU2-403.2 FOR CABLE REQUIREMENTS
G004	GENERATOR CONTROL CABINET IN EXISTING GENERATOR BUILDING	TRANSFER SWITCH #2 IN SUB 1	-	-	-	-	-	-	GEN-CS-01E, GEN-CS-02E	INC 2	SEE DU2-403.2 FOR CABLE REQUIREMENTS
G005	GENERATOR CONTROL CABINET IN EXISTING GENERATOR BUILDING	TRANSFER SWITCH #3 IN SUB 1	-	-	-	-	-	-	GEN-CS-01E, GEN-CS-02E	INC 2	SEE DU2-403.2 FOR CABLE REQUIREMENTS
G006	GENERATOR CONTROL CABINET IN EXISTING GENERATOR BUILDING	TRANSFER SWITCH #4 IN PCDC	-	-	-	-	-	-	GEN-CS-01E, GEN-CS-02E	INC 2	SEE DU2-403.2 FOR CABLE REQUIREMENTS
G007	GENERATOR CONTROL CABINET IN EXISTING GENERATOR BUILDING	TRANSFER SWITCH #5 IN PCDC	-	-	-	-	-	-	GEN-CS-01E, GEN-CS-02E	INC 2	SEE DU2-403.2 FOR CABLE REQUIREMENTS
G008	GENERATOR CONTROL CABINET IN EXISTING GENERATOR BUILDING	TRANSFER SWITCH #6 IN PCDC	-	-	-	-	-	-	GEN-CS-01E, GEN-CS-02E	INC 2	SEE DU2-403.2 FOR CABLE REQUIREMENTS
G009	PULLBOX 'GEN-CS-02'	STUB OUT INTO EMERGENCY RESPONSE HAZ MAT AREA	-	-	-	-	(2) 2"C	PVC	-	INC 1	
G010	ATS '011-01-LEP-ATS-01'	ATS-GEN TERMINAL CABINET IN GENERATOR BUILDING	12#12 AWG	-	-	-	2"	IMC	-	INC 2	
G011	GENERATOR BLDG SWGR GEN CONTROL SECTION	(E) CHILLER PLANT BMS/EMS CONTROL SYSTEM	20#14 AWG	-	-	-	2"	RMC	-	INC 2	INSTALL FLEX CONDUIT SEISMIC CONNECTION BETWEEN GENERATOR BUILDING AND OVER SHADE STRUCTURE
G012	GENERATOR BLDG SWGR GEN CONTROL SECTION	(E) CHILLER PLANT BMS/EMS CONTROL SYSTEM	-	6-PAIR MULTI-MODE FIBER OPTIC CABLE	-	-	1.5"	RMC	-	INC 2	INSTALL FLEX CONDUIT SEISMIC CONNECTION BETWEEN GENERATOR BUILDING AND OVER SHADE STRUCTURE
L001	DISCONNECT '010-01-LCR-BDS-01'	STUB OUT NEAR MVMH-N-19/20	-	-	-	-	(2) 2"	PVC/IMC	LVPB-LCR-01	INC 1	
L001A	STUB OUT NEAR MVMH-N-19/20	PANEL '011-01-LCR-PNL-01	-	-	-	-	(2) 2"	PVC/IMC	-	INC 2	
L001B	PANEL '011-01-LCR-PNL-01'	DISCONNECT '010-01-LCR-BDS-01'	4-6 AWG	0.6 KV, CU, THHN/THWN	6 AWG	THHN/THWN	-	-	LVPB-LCR-01	INC 1	
L002	DISCONNECT '010-01-LLS-BDS-01'	STUB OUT NEAR MVMH-N-19/20	-	-	-	-	(2) 2"	PVC/IMC	LVPB-LLS-01	INC 1	
L002A	STUB OUT NEAR MVMH-N-19/20	PANEL '011-01-LLS-PNL-01'	-	-	-	-	(2) 2"	PVC/IMC	-	INC 2	
L002B	PANEL '011-01-LLS-PNL-01'	DISCONNECT '010-01-LLS-BDS-01'	6-6 AWG	0.6 KV, CU, THHN/THWN	6 AWG	THHN/THWN	-	-	LVPB-LLS-01	INC 1	
L003	TRANSFORMER '010-01-NMV-TRX-01'	PANEL '010-01-LEQ-PNL-01'	4-4/0 AWG	0.6 KV, CU, THHN/THWN	4 AWG	THHN/THWN	2.5"	PVC	-	INC 1	
L100	TRANSFORMER '011-01-NMV-TRX-01'	DISCONNECT SWITCH ABOVE LVPB-E-04	(2) 4-250KCMIL	0.6 KV, CU, THHN/THWN	(2) #1/0AWG	THHN/THWN	(2) 3"	PVC/RMC	VIA LVPB-E-11 AND LVPB-E-04	INC 2	
L100A	TRANSFORMER '011-01-NMV-TRX-01'	DISCONNECT '011-01-LNP-BDS-01'	4- 12 AWG	0.6 KV, CU, THHN/THWN	12 AWG	THHN/THWN	1"	PVC/RMC	LVPB-E-04		
L101	DISCONNECT '011-01-LNP-BDS-01'	TRANSFER SWITCH '011-01-LEP-ATS-01'	(2) 4-250KCMIL	0.6 KV, CU, THHN/THWN	(2) 2#AWG	THHN/THWN	(2) 3"	IMC	-	INC 2	
L102	JUNCTION BOX 'LVPB-E-02'	TRANSFER SWITCH '011-01-LEP-ATS-01'	(2) 4-250KCMIL	0.6 KV, CU, THHN/THWN	(2) 2#AWG	THHN/THWN	(2) 3"	IMC	-	INC 2	
L103	TRANSFER SWITCH '011-01-LEP-ATS-01'	TRANSFER SWITCH '011-01-LEP-ATS-02'	(2) 4-250KCMIL	0.6 KV, CU, THHN/THWN	(2) 2#AWG	THHN/THWN	(2) 3"	IMC	-	INC 2	
L104	GENERATOR QUICK CONNECT BOX '011-01-LEP-GQC-01'	TRANSFER SWITCH '011-01-LEP-ATS-02'	(2) 4-250KCMIL	0.6 KV, CU, THHN/THWN	(2) 2#AWG	THHN/THWN	(2) 3"	IMC	-	INC 2	
L105	TRANSFER SWITCH '011-01-LEP-ATS-02'	PANEL '011-01-LEP-PNL-01'	(2) 4-250KCMIL	0.6 KV, CU, THHN/THWN	(2) 2#AWG	THHN/THWN	(2) 3"	IMC	-	INC 2	
L106	EXISTING PS/LSA ENCLOSED CIRCUIT BREAKER	JUNCTION BOX 'LVPB-E-02'	4-500KCMIL	0.6 KV, CU, THHN/THWN	2#AWG	THHN/THWN	4"	IMC	-	INC 2	
L111	PANEL '011-01-LEP-PNL-01'	PANEL '011-01-LEQ-PNL-01'	4- 3/0 AWG	0.6 KV, CU, THHN/THWN	4 AWG	THHN/THWN	2"	IMC	-	INC 2	
L110	PANEL '011-01-LEP-PNL-01'	PANEL '011-01-LCR-PNL-01'	4-4/0 AWG	0.6 KV, CU, THHN/THWN	4 AWG	THHN/THWN	2.5"	IMC	-	INC 2	
L112	PANEL '011-01-LEP-PNL-01'	PANEL '011-01-LLS-PNL-01'	4-4/0 AWG	0.6 KV, CU, THHN/THWN	4 AWG	THHN/THWN	2.5"	IMC	-	INC 2	
L113	PANEL '011-01-LEP-PNL-01'	PANEL '011-01-LLS-PNL-02'	4-4/0 AWG	0.6 KV, CU, THHN/THWN	4 AWG	THHN/THWN	2.5"	IMC	-	INC 2	
L114	PANEL '011-01-LEP-PNL-01'	PANEL '011-01-LLS-PNL-03'	4-4/0 AWG	0.6 KV, CU, THHN/THWN	4 AWG	THHN/THWN	2.5"	IMC	-	INC 2	
L200	TRANSFORMER '011-01-EMV-TRX-01'	DISCONNECT '011-01-ENP-BDS-01'	(2) 4-250KCMIL	0.6 KV, CU, THHN/THWN	(2) #1/0AWG	THHN/THWN	(2) 3"	PVC/RMC	VIA LVPB-E-10 AND LVPB-E-01	INC 2	
L201	DISCONNECT '011-01-ENP-BDS-01'	J-BOX LVPB-E-02	(2) 4-250KCMIL	0.6 KV, CU, THHN/THWN	(2) 2#AWG	THHN/THWN	(2) 3"	IMC	-	INC 2	



RBB ARCHITECTS INC

Joseph A. Balbons, AIA
Sylvia Botero, AIA
Kevin S. Boots, AIA

10980 Wilshire Boulevard
Los Angeles, California
90024-3905

Telephone 310 473 3555
Facsimile 310 473 3555
www.rbinc.com



AGENCY APPROVALS

OSHPD # 1240005-19-01

CONSULTANT



Long Beach // Irvine // Los Angeles
San Diego // San Jose // Seattle

p2sinc.com

ISSUE RECORD

04/09/2025 D ADDENDUM D
03/14/2025 A ADDENDUM A
02/10/2025 BID SET
04/04/2024 HCAI SUBMITTAL
DATE DESCRIPTION



HARBOR-UCLA MEDICAL CENTER
PHASE 2E INC 1 - RETROFIT OF
GENERATOR BLDG. SWITCHGEAR

1000 West Carson Street, Torrance, CA 90509

MILESTONE: HCAI SUBMITTAL

MILESTONE DATE: 11/17/2023

RBB PROJECT: 1712105

SCALE:

DESCRIPTION
CONDUIT AND CABLE
SCHEDULE

DU1-402.1

GENERAL NOTES

1. TYPE MV CABLE SHALL BE INSTALLED, TERMINATED AND TESTED BY QUALIFIED PERSONS AND SHALL BE MARKED AS REQUIRED BY CEC 310.120.
2. SEE THE CONDUIT AND CABLE SCHEDULE FOR CONDUIT TYPES. CONDUIT INDOORS SHALL BE RGS FOR CONDUITS CONTAINING HIGH VOLTAGE CABLE OF 1000V OR GREATER. CONDUIT OUTSIDE SHALL BE RGS. CONDUIT CONTAINING VOLTAGES 600V OR LESS SHALL BE INSTALLED INDOORS AND ABOVE 9' CAN BE EMT.
3. SPLICING OF MV CABLES ARE TO BE MADE WITH 600A T-BODY WITH CAPACITIVE TEST POINT.

ID	FROM	TO	PHASE CABLE SIZE	PHASE CABLE TYPE	GROUND CONDUCTOR SIZE	GROUND CONDUCTOR TYPE	NEW CONDUIT SIZE	NEW CONDUIT TYPE	VIA	CONTRACTOR SCOPE	REMARKS
P581	EXISTING 12KV MAIN SWITCHGEAR IN GENERATOR BUILDING, 52-LB	EXISTING 2000KW LOAD BANK	-	-	-	-	-	-	-	INC 2	DISCONNECT AND REMOVE CABLE
P582	EXISTING 12KV MAIN SWITCHGEAR IN GENERATOR BUILDING, LSC4	MANHOLE 'MMH-E-01E'	-	-	-	-	-	-	MMH-E-01E	INC 2	DISCONNECT AND REMOVE CABLE
P583	EXISTING 12KV MAIN SWITCHGEAR IN GENERATOR BUILDING, LSC3	MANHOLE 'MMH-E-01E'	-	-	-	-	-	-	-	INC 2	DISCONNECT AND REMOVE CABLE
P584	EXISTING 12KV MAIN SWITCHGEAR IN GENERATOR BUILDING, LSC2	MANHOLE 'MMH-E-01E'	-	-	-	-	-	-	-	INC 2	DISCONNECT AND REMOVE CABLE
P585	EXISTING 12KV MAIN SWITCHGEAR IN GENERATOR BUILDING, LSC1	MANHOLE 'MMH-E-01E'	-	-	-	-	-	-	-	INC 2	DISCONNECT AND REMOVE CABLE
P586	EXISTING 12KV MAIN SWITCHGEAR IN GENERATOR BUILDING, G1	DIESEL GENERATOR 1	-	-	-	-	-	-	-	INC 2	DISCONNECT AND REMOVE CABLE
P587	EXISTING 12KV MAIN SWITCHGEAR IN GENERATOR BUILDING, G2	DIESEL GENERATOR 2	-	-	-	-	-	-	-	INC 2	DISCONNECT AND REMOVE CABLE
P588	EXISTING 12KV MAIN SWITCHGEAR IN GENERATOR BUILDING, G3	DIESEL GENERATOR 3	-	-	-	-	-	-	-	INC 2	DISCONNECT AND REMOVE CABLE
P589	EXISTING 12KV MAIN SWITCHGEAR IN GENERATOR BUILDING, G4	DIESEL GENERATOR 4	-	-	-	-	-	-	-	INC 2	DISCONNECT AND REMOVE CABLE
P590	EXISTING 12KV MAIN SWITCHGEAR IN GENERATOR BUILDING, G5	DIESEL GENERATOR 5	-	-	-	-	-	-	-	INC 2	DISCONNECT AND REMOVE CABLE
P591	EXISTING 12KV MAIN SWITCHGEAR IN GENERATOR BUILDING, G6	DIESEL GENERATOR 6	-	-	-	-	-	-	-	INC 2	DISCONNECT AND REMOVE CABLE
P600	EXISTING 12KV MAIN SWITCHGEAR IN GENERATOR BUILDING, UE-1	SWITCH 'SF6-S7'	-	-	-	-	-	-	MMH-N-17/18, UE-1 FEED P.B.	INC 1	DISCONNECT AND REMOVE CABLE
P601	EXISTING 12KV MAIN SWITCHGEAR IN GENERATOR BUILDING, UE-2	EXISTING GENERATOR BUILDING HOUSE TRANSFORMER	-	-	-	-	-	-	-	INC 2	DISCONNECT AND REMOVE CABLE
P602	EXISTING 12KV MAIN SWITCHGEAR IN GENERATOR BUILDING, UE-4	EXISTING 2500KVA OUTDOOR SUB AT CENTRAL PLANT	-	-	-	-	-	-	-	INC 1	DISCONNECT AND REMOVE CABLE
P603	EXISTING 12KV MAIN SWITCHGEAR IN GENERATOR BUILDING, UE-5	MANHOLE 'MMH-N-17/18'	-	-	-	-	-	-	-	INC 1	DISCONNECT AND REMOVE CABLE
P604	EXISTING 12KV MAIN SWITCHGEAR IN GENERATOR BUILDING, UE-6	MANHOLE 'MMH-N-17/18'	-	-	-	-	-	-	-	INC 1	DISCONNECT AND REMOVE CABLE
P605	EXISTING 12KV MAIN SWITCHGEAR IN GENERATOR BUILDING, UE-7	PULLBOX 'MVPB-N-01' IN GENERATOR BUILDING	-	-	-	-	-	-	-	INC 1	DISCONNECT AND REMOVE CABLE TO MVPB-N-1 AND DEMOLISH CONDUIT TO MVPB-N-2
P610	MANHOLE 'MMH-N-01E'	MANHOLE 'MMH-E-01W'	-	-	-	-	(4) 4"	PVC	-	INC 1	
P611	STUB OUT SOUTH OF MANHOLE 'MMH-N-17/18'	STUB OUT SOUTH OF MMH-N-17/18	-	-	-	-	(8) 4"	PVC	-	INC 2	
P612	MANHOLE 'MMH-N-16'	MANHOLE 'MMH-N-17/18'	-	-	-	-	(2) 4"	PVC	-	INC 1	
P613	MANHOLE 'MMH-N-16'	MANHOLE 'MMH-N-19/20'	-	-	-	-	(2) 4"	PVC	-	INC 1	
P614	MANHOLE 'MMH-N-15'	MANHOLE 'MMH-N-17/18'	-	-	-	-	(2) 4"	PVC	-	INC 1	
P615	MANHOLE 'MMH-N-15'	MANHOLE 'MMH-N-19/20'	-	-	-	-	4"	PVC	-	INC 1	
P617	MANHOLE 'MMH-E-01E'	STUB OUT SOUTH OF MANHOLE 'MMH-N-17/18'	-	-	-	-	(4) 4"	PVC	-	INC 1	SPARE
P618	MANHOLE 'MMH-E-01W'	STUB OUT SOUTH OF MANHOLE 'MMH-N-17/18'	-	-	-	-	(5) 4"	PVC	-	INC 1	
P619	MANHOLE 'MMH-N-19/20'	PULLBOX 'MVPB-N-4'	-	-	-	-	4"	PVC/RMC	-	INC 2	
P619A	MANHOLE 'MMH-N-19/20'	STUB UP AND CAP AT WEST WALL OF GENERATOR BUILDING	-	-	-	-	(2) 4"	PVC	-	INC 2	
P620	NEAR MANHOLE 'MMH-N-17/18'		-	-	-	-	(9) 4"	PVC	-	INC 2	EXTEND P617, P618 TO INTERCEPT EXISTING CONDUITS
P621	EXISTING CONDUITS INSTALLED BY PHASE 1A, INC 3 DUCTBANK PROJECT	MANHOLE 'MMH-N-15'	-	-	-	-	(6) 5"	PVC	-	INC 1	CONNECT (2) CONDUITS FORM MMH-N-11 AND (4) FROM...
P622	EXISTING CONDUITS INSTALLED BY PHASE 1A, INC 3 DUCTBANK PROJECT	MANHOLE 'MMH-N-16'	-	-	-	-	(6) 5"	PVC	-	INC 1	CONNECT (2) CONDUITS FORM MMH-N-12 AND (4) FROM...
P623	EXISTING CONDUITS INSTALLED BY PHASE 1A, INC 3 DUCTBANK PROJECT	STUB OUT INTO EMERGENCY RESPONSE HAZ MAT AREA	-	-	-	-	(2) 5"	PVC	-	INC 1	
P624	MANHOLE 'MMH-N-15'	STUB OUT INTO EMERGENCY RESPONSE HAZ MAT AREA	-	-	-	-	(2) 5"	PVC	-	INC 1	
P625	EXISTING CONDUITS INSTALLED BY PHASE 1A, INC 3 DUCTBANK PROJECT	MANHOLE 'MMH-E-01W'	-	-	-	-	(6) 5"	PVC	-	INC 1	
P626	MANHOLE 'MMH-E-01W'	STUB OUT INTO EMERGENCY RESPONSE HAZ MAT AREA	-	-	-	-	(2) 4"	PVC	-	INC 1	
P631A	MANHOLE 'MMH-N-15'	MANHOLE 'MMH-N-19/20'	-	-	-	-	4"	PVC	-	INC 1	
P631C	MANHOLE 'MMH-N-15'	EXISTING GENERATOR BUILDING (N) HOUSE TRANSFORMER T-2 SWITCH INPUT A	3-#2AWG	MV-105, 15KV, CU, EPR	#2AWG	THHN/THWN	-	-	MMH-N-19/20 MVPB-N-3 MVPB-N-4	INC 2	SPLICE TO P511C IN MMH-N-15
P701	SWITCHGEAR '007-02-NMV-SGR-01', 52-CP-13	MANHOLE 'MMH-N-17/18'	3 - 500KCMIL	MV-105, 15KV, CU, EPR	#4/0AWG	THHN/THWN	-	-	MMH-N-13, MMH-N-15	RMJV	SPLICE TO EXISTING FEEDER TO SUB-6N1
P702	SWITCHGEAR '007-02-NMV-SGR-02', 52-CP-24	MANHOLE 'MMH-N-17/18'	3 - 500KCMIL	MV-105, 15KV, CU, EPR	#4/0AWG	THHN/THWN	-	-	MMH-N-14, MMH-N-16	RMJV	SPLICE TO EXISTING FEEDER TO SUB-6N2



RBB ARCHITECTS INC

Joseph A. Balbons, AIA
Sylvia Botero, AIA
Kevin S. Boots, AIA

10980 Wilshire Boulevard
Los Angeles, California
90024-3905

Telephone 310 473 3555
Facsimile 310 473 3555
www.rbbinc.com



AGENCY APPROVALS

OSHPD # 1240005-19-01

CONSULTANT



Long Beach // Irvine // Los Angeles
San Diego // San Jose // Seattle

p2sinc.com

ISSUE RECORD

04/09/2025 D ADDENDUM D
03/14/2025 A ADDENDUM A
02/10/2025 BID SET
DATE DESCRIPTION




HARBOR-UCLA MEDICAL CENTER
PHASE 2E INC 1 - RETROFIT OF
GENERATOR BLDG. SWITCHGEAR

1000 West Carson Street, Torrance, CA 90509

MILESTONE: HCAI SUBMITTAL
MILESTONE DATE: 12/18/24
RBB PROJECT: 1712105 SCALE:

DESCRIPTION
CONDUIT AND CABLE
SCHEDULE

DU1-402.3

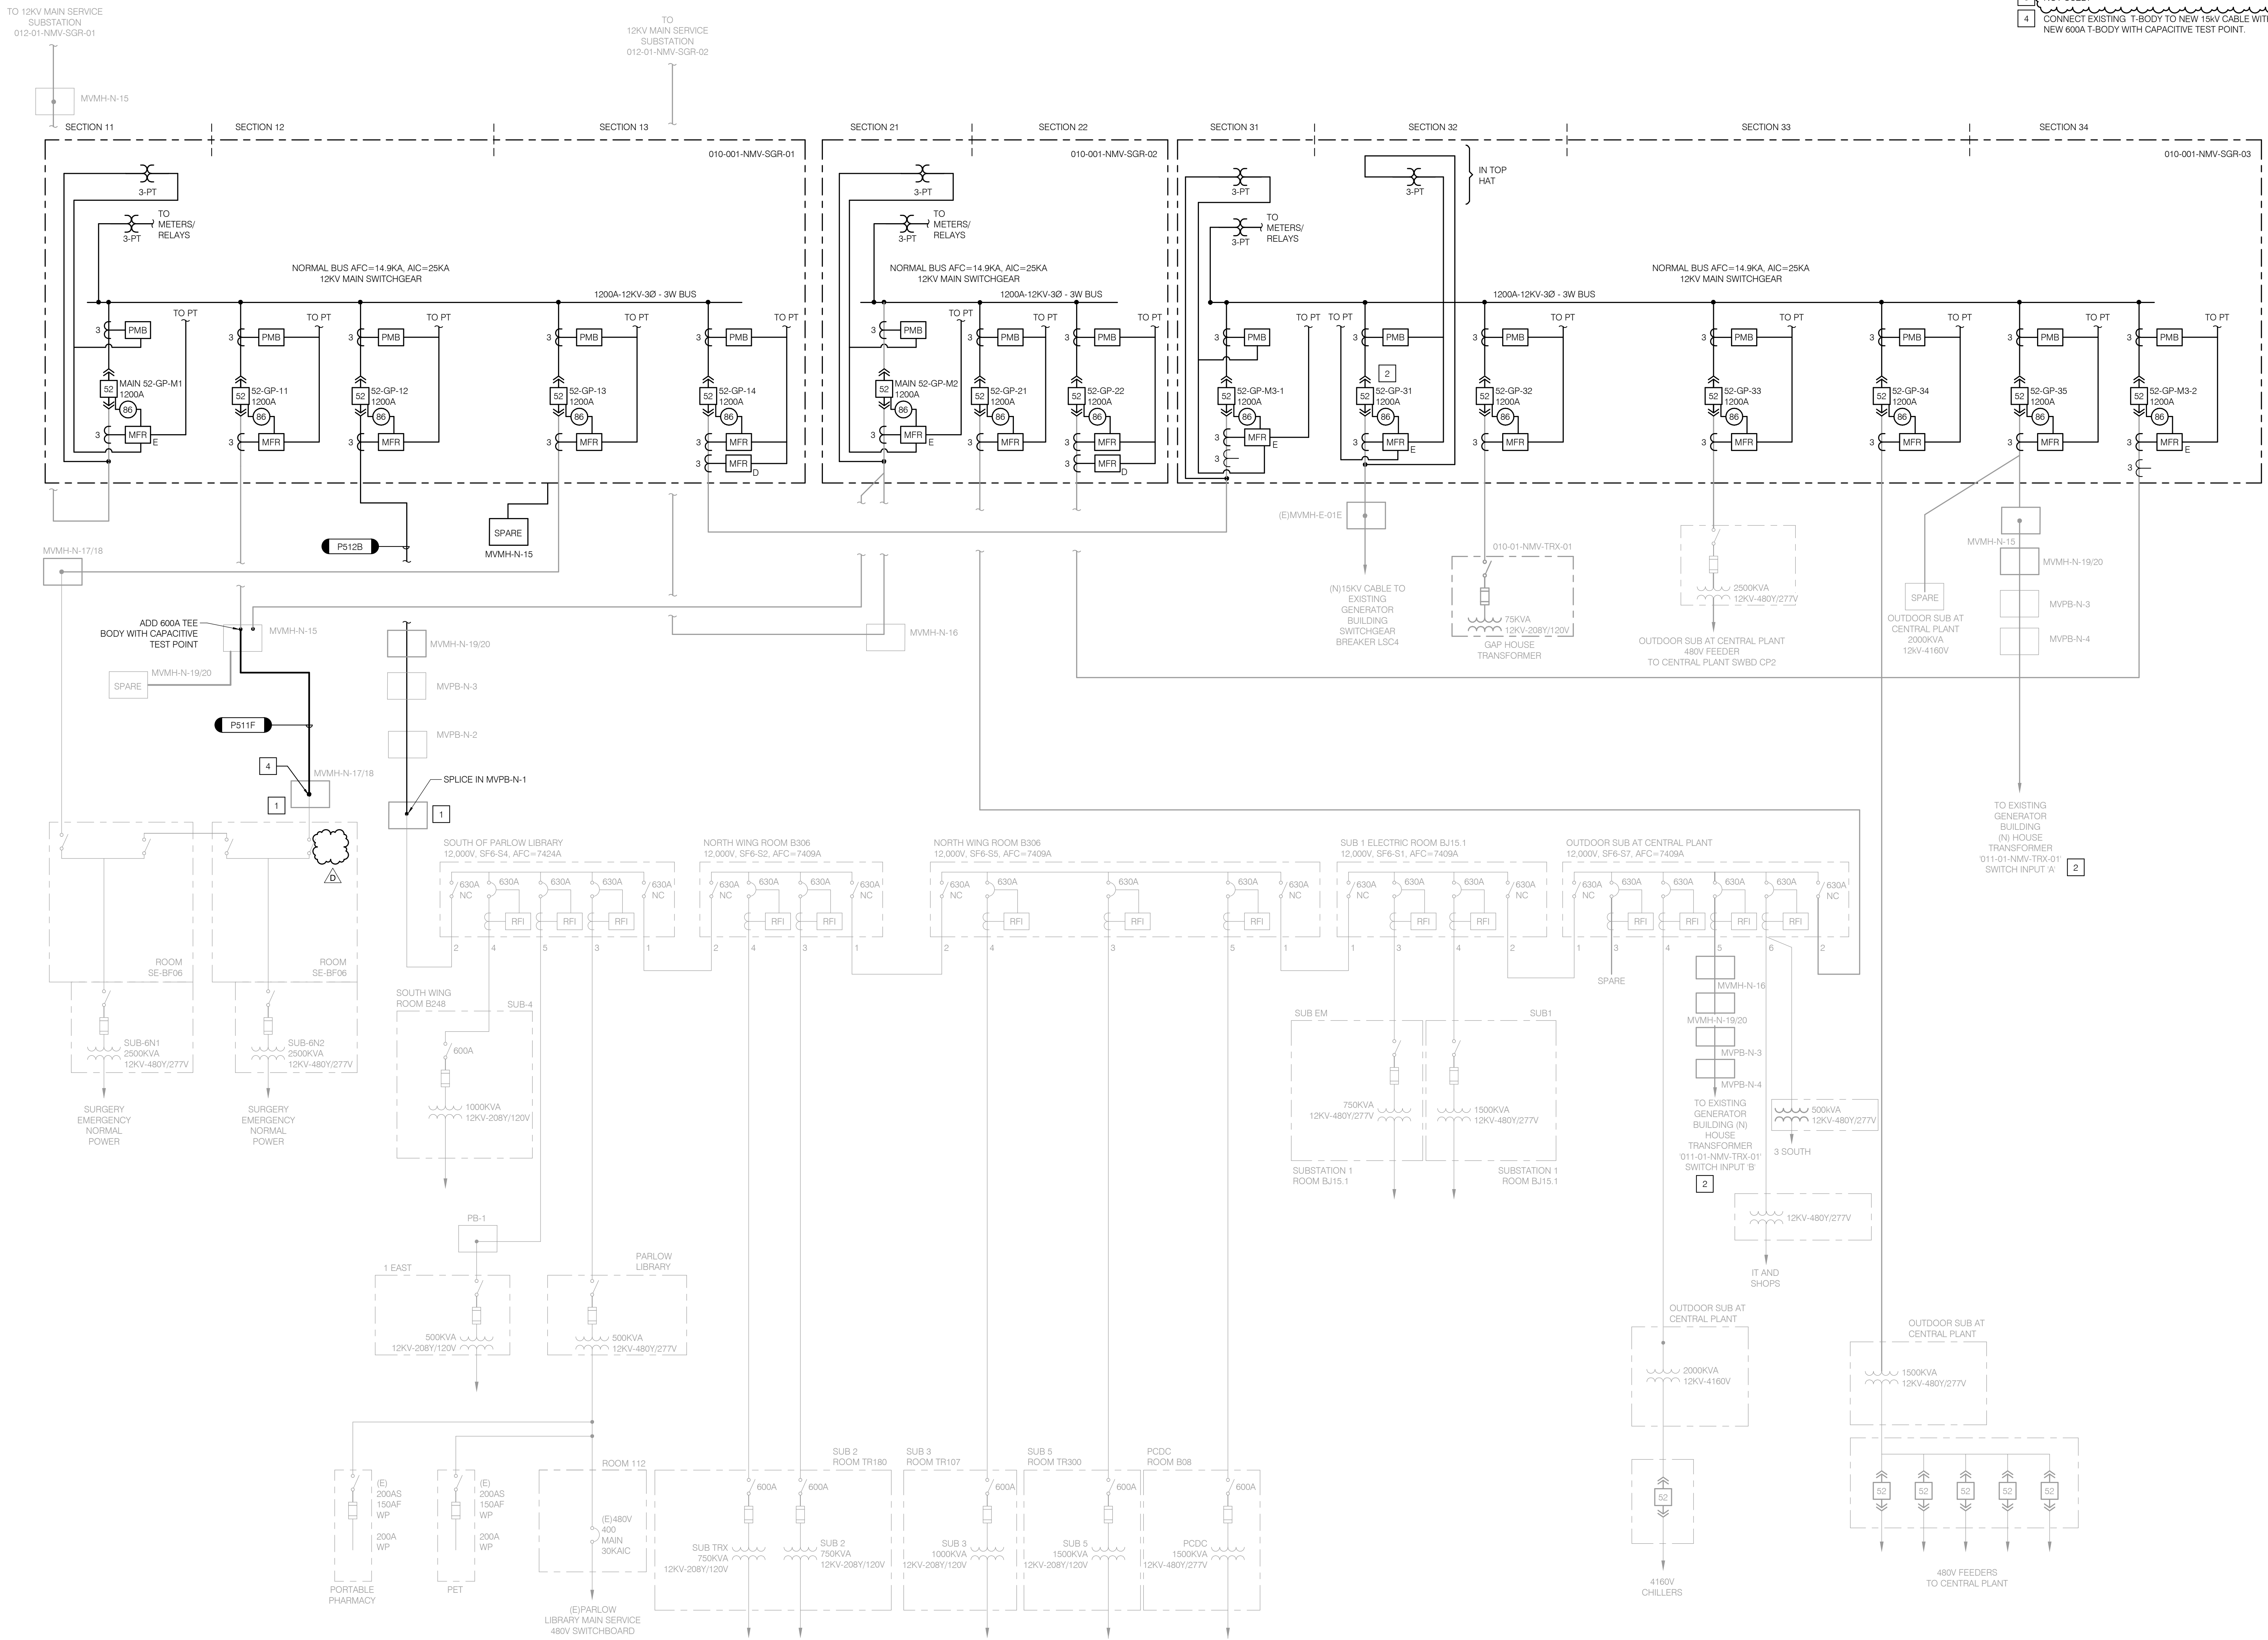

GENERAL NOTES

1. MAXIMUM LOAD ON SWITCHGEAR BUS IS 3.6 MVA AT THIS MILESTONE.

NOTES

1. NEW LOAD REMOVED FROM GENERATOR BUILDING SWITCHGEAR.
2. NEW TRANSFORMER INSTALLED BY INC.2 CONTRACTOR
3. NOT USED
4. CONNECT EXISTING T-BODY TO NEW 15KV CABLE WITH NEW 600A T-BODY WITH CAPACITIVE TEST POINT.




RBB ARCHITECTS INC

Joseph A. Balbons, AIA
Sylvia Botero, AIA
Kevin S. Boots, AIA

10980 Wilshire Boulevard
Los Angeles, California
90024-3905

Telephone 310 473 3555
Facsimile 310 473 3555
www.rbbinc.com

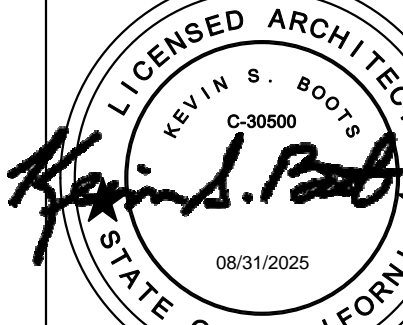

AGENCY APPROVALS

OSHPD # 1240005-19-01

CONSULTANT

p2s ENG

Long Beach // Irvine // Los Angeles
San Diego // San Jose // Seattle

p2sinc.com

ISSUE RECORD

DATE	DESCRIPTION
04/09/2025	D ADDENDUM D
03/14/2025	A ADDENDUM A
02/10/2025	BID SET
01/31/2025	3 HCAI BACKCHECK 2
04/04/2024	HCAI SUBMITTAL



HARBOR-UCLA MEDICAL CENTER
PHASE 2E INC 1 - RETROFIT OF
GENERATOR BLDG. SWITCHGEAR

1000 West Carson Street, Torrance, CA 90509

MILESTONE: HCAI SUBMITTAL

MILESTONE DATE: 12/12/23

RBB PROJECT: 1712105 SCALE: 12" = 1'-0"

DESCRIPTION
2ND CUTOVER GAP SINGLE
LINE DIAGRAM

(MILESTONE 4)

DU1-542




RBB ARCHITECTS INC

Joseph A. Ballbons, AIA
Sylvia Botero, AIA
Kevin S. Boots, AIA

10980 Wilshire Boulevard
Los Angeles, California
90024-3905

Telephone 310 473 3555
Facsimile 310 473 3555
www.rbbinc.com

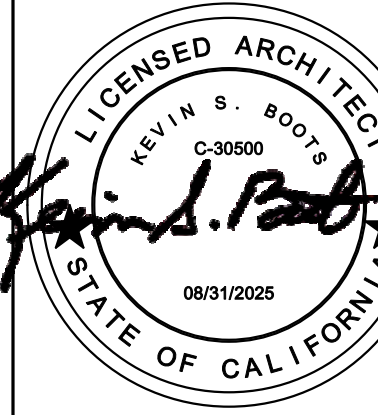

AGENCY APPROVALS

OSHPD # 1240005-19-02

CONSULTANT

ISSUE RECORD

04/09/2025	D	ADDENDUM D
06/13/2024	-	HCAI SUBMITTAL
04/18/2024	-	HCAI SUBMITTAL
DATE	△	DESCRIPTION



HARBOR-UCLA MEDICAL CENTER
PHASE 2E INC 2 - GENERATOR BLDG.
RETROFIT

1000 West Carson Street, Torrance, CA 90509

MILESTONE: HCAI SUBMITTAL
MILESTONE DATE: 10/25/2024
RBB PROJECT: 1712076 SCALE: 1/4" = 1'-0"

DESCRIPTION
DOOR SCHEDULE, DOORS
FRAMES, HARDWARE
MOUNTING, FINISH SCHEDULE

A300.2



Door Schedule																												
Number	Room Description	DOOR / OPENING							Fire Rating	FRAME				HARDWARE									NOTES					
		Width	Height	Thickness	Door Type	Door Panel Construction	Finish	Glass		Frame Type	DETAILS			Hardware Group	Closer	Panic Device	Mag Hold/Smoke	Smoke Seals	Protective Plates	Weather Seals	Keylock	Privacy Lock	Latchset					
											Head Detail	Jamb Detail	Other Jamb Detail															Threshold Detail
001	(E) ELECTRICAL SWITCHGEAR	3' - 6"	7' - 0"	1 3/4"	A	HM	STL			A	11/A320.2	10/A320.2		9/A320	01	Yes	Yes		Yes	Yes	Yes	Yes						
002	(E) ELECTRICAL SWITCHGEAR	8' - 4"	10' - 0"	1 3/4"	J1	STL	STL			A	5/320.2	4/1320.2		3/320.2														
006	EMERGENCY GENERATOR	3' - 2"	7' - 0"	1 3/4"	A	S.C.				A					01		Yes							1	9	22	44	
007	(E) ELECTRICAL SWITCHGEAR	4' - 0"	7' - 0"	1 3/4"	A	S.C.				A					01		Yes							19				
008	(E) ELECTRICAL SWITCHGEAR	8' - 4"	7' - 0"	1 3/4"	A2	S.C.				A2					02		Yes	No						19				

CONSTRUCTION		FACE		GLAZING		FOOTNOTES		
ALUM	ALUMINUM	ALUM	ALUMINUM	1	1/4" CLEAR	1-	HARDWARE BY DOOR MANUFACTURER	16- WON DOOR
GL	GLASS	GL	GLASS	2	1/4" CLEAR TEMPERED	2-	RHR LEAF ACTIVE	17- OVERHEAD STOP
S.S.	STAINLESS STEEL	HDWD	HARDWOOD VENEER - STAIN GRAD	3	1/2" CLEAR	3-	LHR LEAF ACTIVE	18- AUTOMATIC FLUSHBOLT
STL	STEEL	PG	HARDWOOD VENEER - PAINT GRAD	4	1/2" CLEAR TEMPERED	4-	COMBINATION LOCK	19- EXISTING DOOR
H.C.	WOOD - HOLLOW CORE	LAM	PLASTIC LAMINATE	5	1/4" WIRED	5-	LIGHT TIGHT	20- AUTOMATIC DOOR
S.C.	WOOD - SOLID CORE	S.S.	STAINLESS STEEL	6	FIRE RATED	6-	SMOKE PARTITION DOOR	21- RELOCATED EXISTING DOOR
W.S.	WOOD - SHIELDING LEAD	STL	STEEL - PRIME COAT	7	LEADED GLASS	7-	MECHANICAL UNDERCUT	22- CONTRACTOR TO VERIFY WIDTH
-	NONE	RFG	RF SHIELDED GLASS	--	NONE	8-	DELAYED ACTION CLOSER	23- DELAYED ACTIVATED PANIC DEVICE
HM	HOLLOW METAL	WD	WOOD		RF SHIELDED GLASS	9-	FRAME BY DOOR MANUFACTURER	24- TIMED OPENING/LOCKING FEATURE
MC	MINERAL CORE	MRR	MIRROR	NOTE: IN A 20-MINUTE FIRE DOOR ASSEMBLY, THE GLAZING MATERIAL IN THE DOOR ITSELF SHALL HAVE A MINIMUM FIRE-PROTECTION- RATED GLAZING OF 20-MINUTES... -2016 CBC, SECTION 716.5.3.2			10- INSTALLED IN CURTAINWALL	25- TOTAL DOOR
(E)	EXISTING	FR	FIBER REINFORCED FACE				11- HOSPITAL LATCH	26- LEAD LINED DOOR
HM2	INSULATED HOLLOW METAL	--	NONE				12- ELECTRONIC INTERLOCK PRIVACY LOCK	27- RF SHIELDED DOOR
MTL	METAL	STLG	STEEL GRILL				13- ELECTRIC LOCK	28- WONDOR POCKET DOOR
WS2	WOOD - SHIELDING RF	COR	CORIAN VENEER				14- CARD READER	29- RADIUSED WONDOR AND POCKET
		MTL	METAL				15- FOR GLASS TYPE SEE EXTERIOR ELEVATIONS	30- INTERIOR WINDOW
		PM-2	PLASTIC MATERIAL					31- RF SHIELDED INTERIOR WINDOW
								32- LEAD LINED INTERIOR WINDOW
								33- INTEGRATED BLINDS
								34- W/ SHADE
								35- KEYPAD
								36- PUSH PLATE
								37- BUZZER
								38- GREEN CODE
								39- SMOKE GUARD
								40- AI PHONE/CARD ACCESS
								41- MAG HOLD OPEN
								42- CASED OPENING
								43- EXTERIOR WINDOW
								44- MOTOR OPERATED ROLLING DOOR


DOOR TYPES

FRAME TYPES

HARDWARE MOUNTING HEIGHT

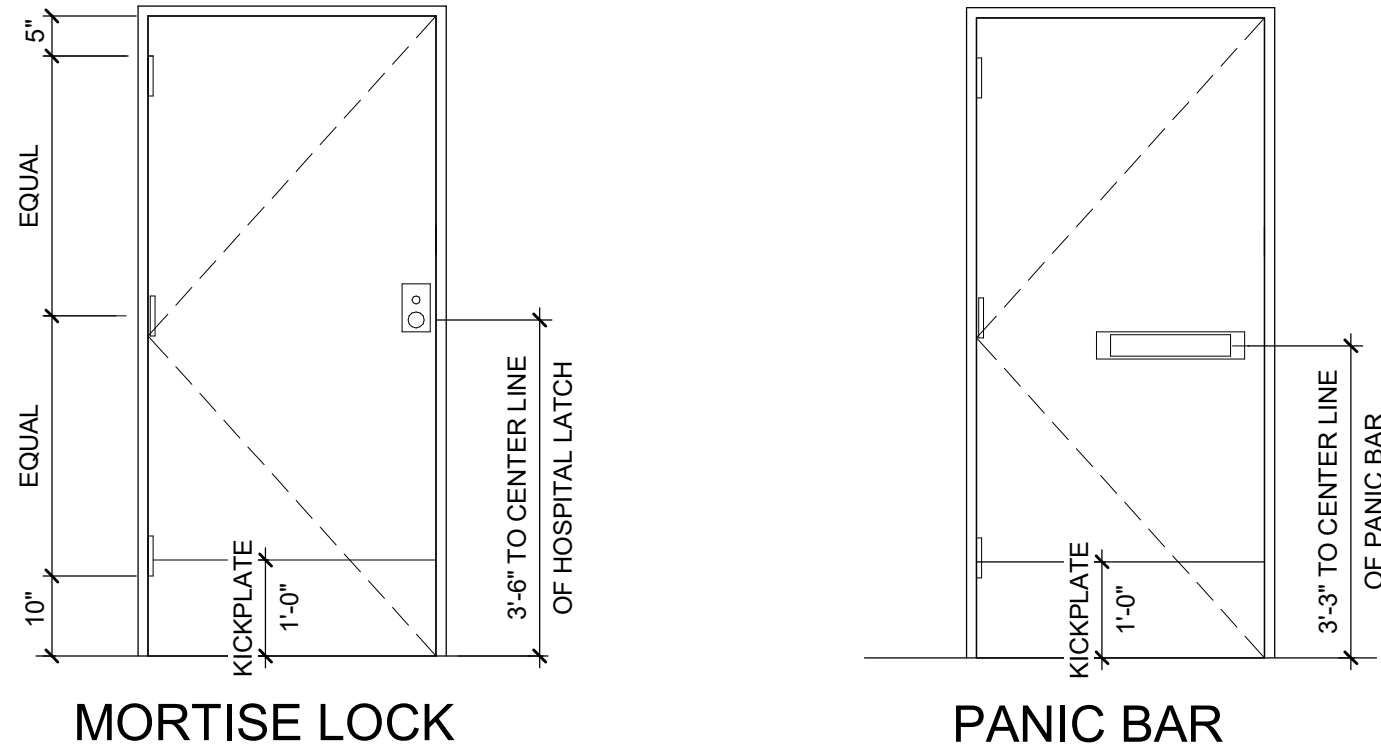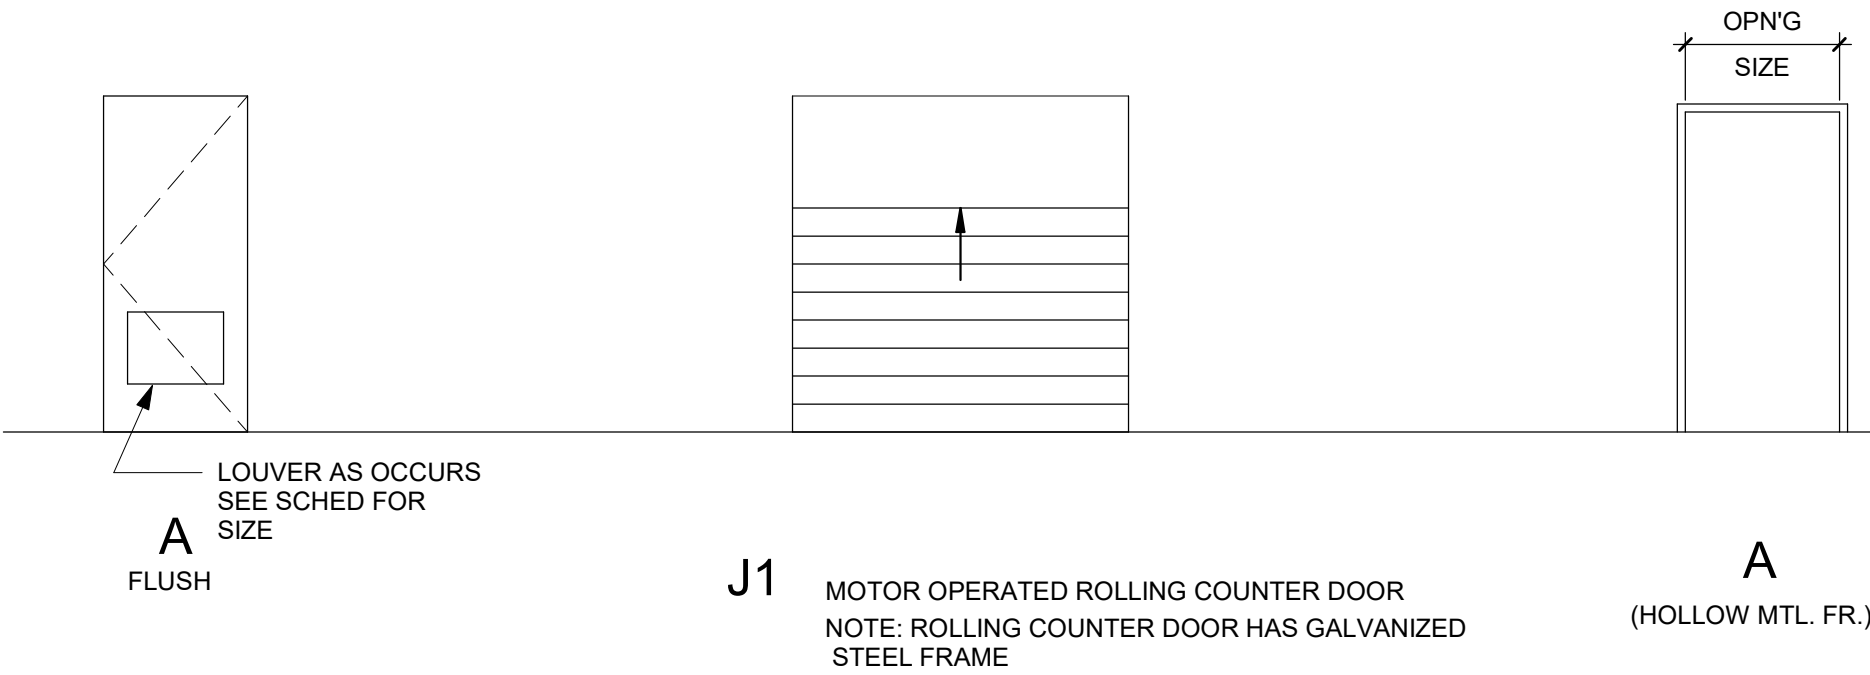

Print Date: 4/10/2025 1:17:12 PM

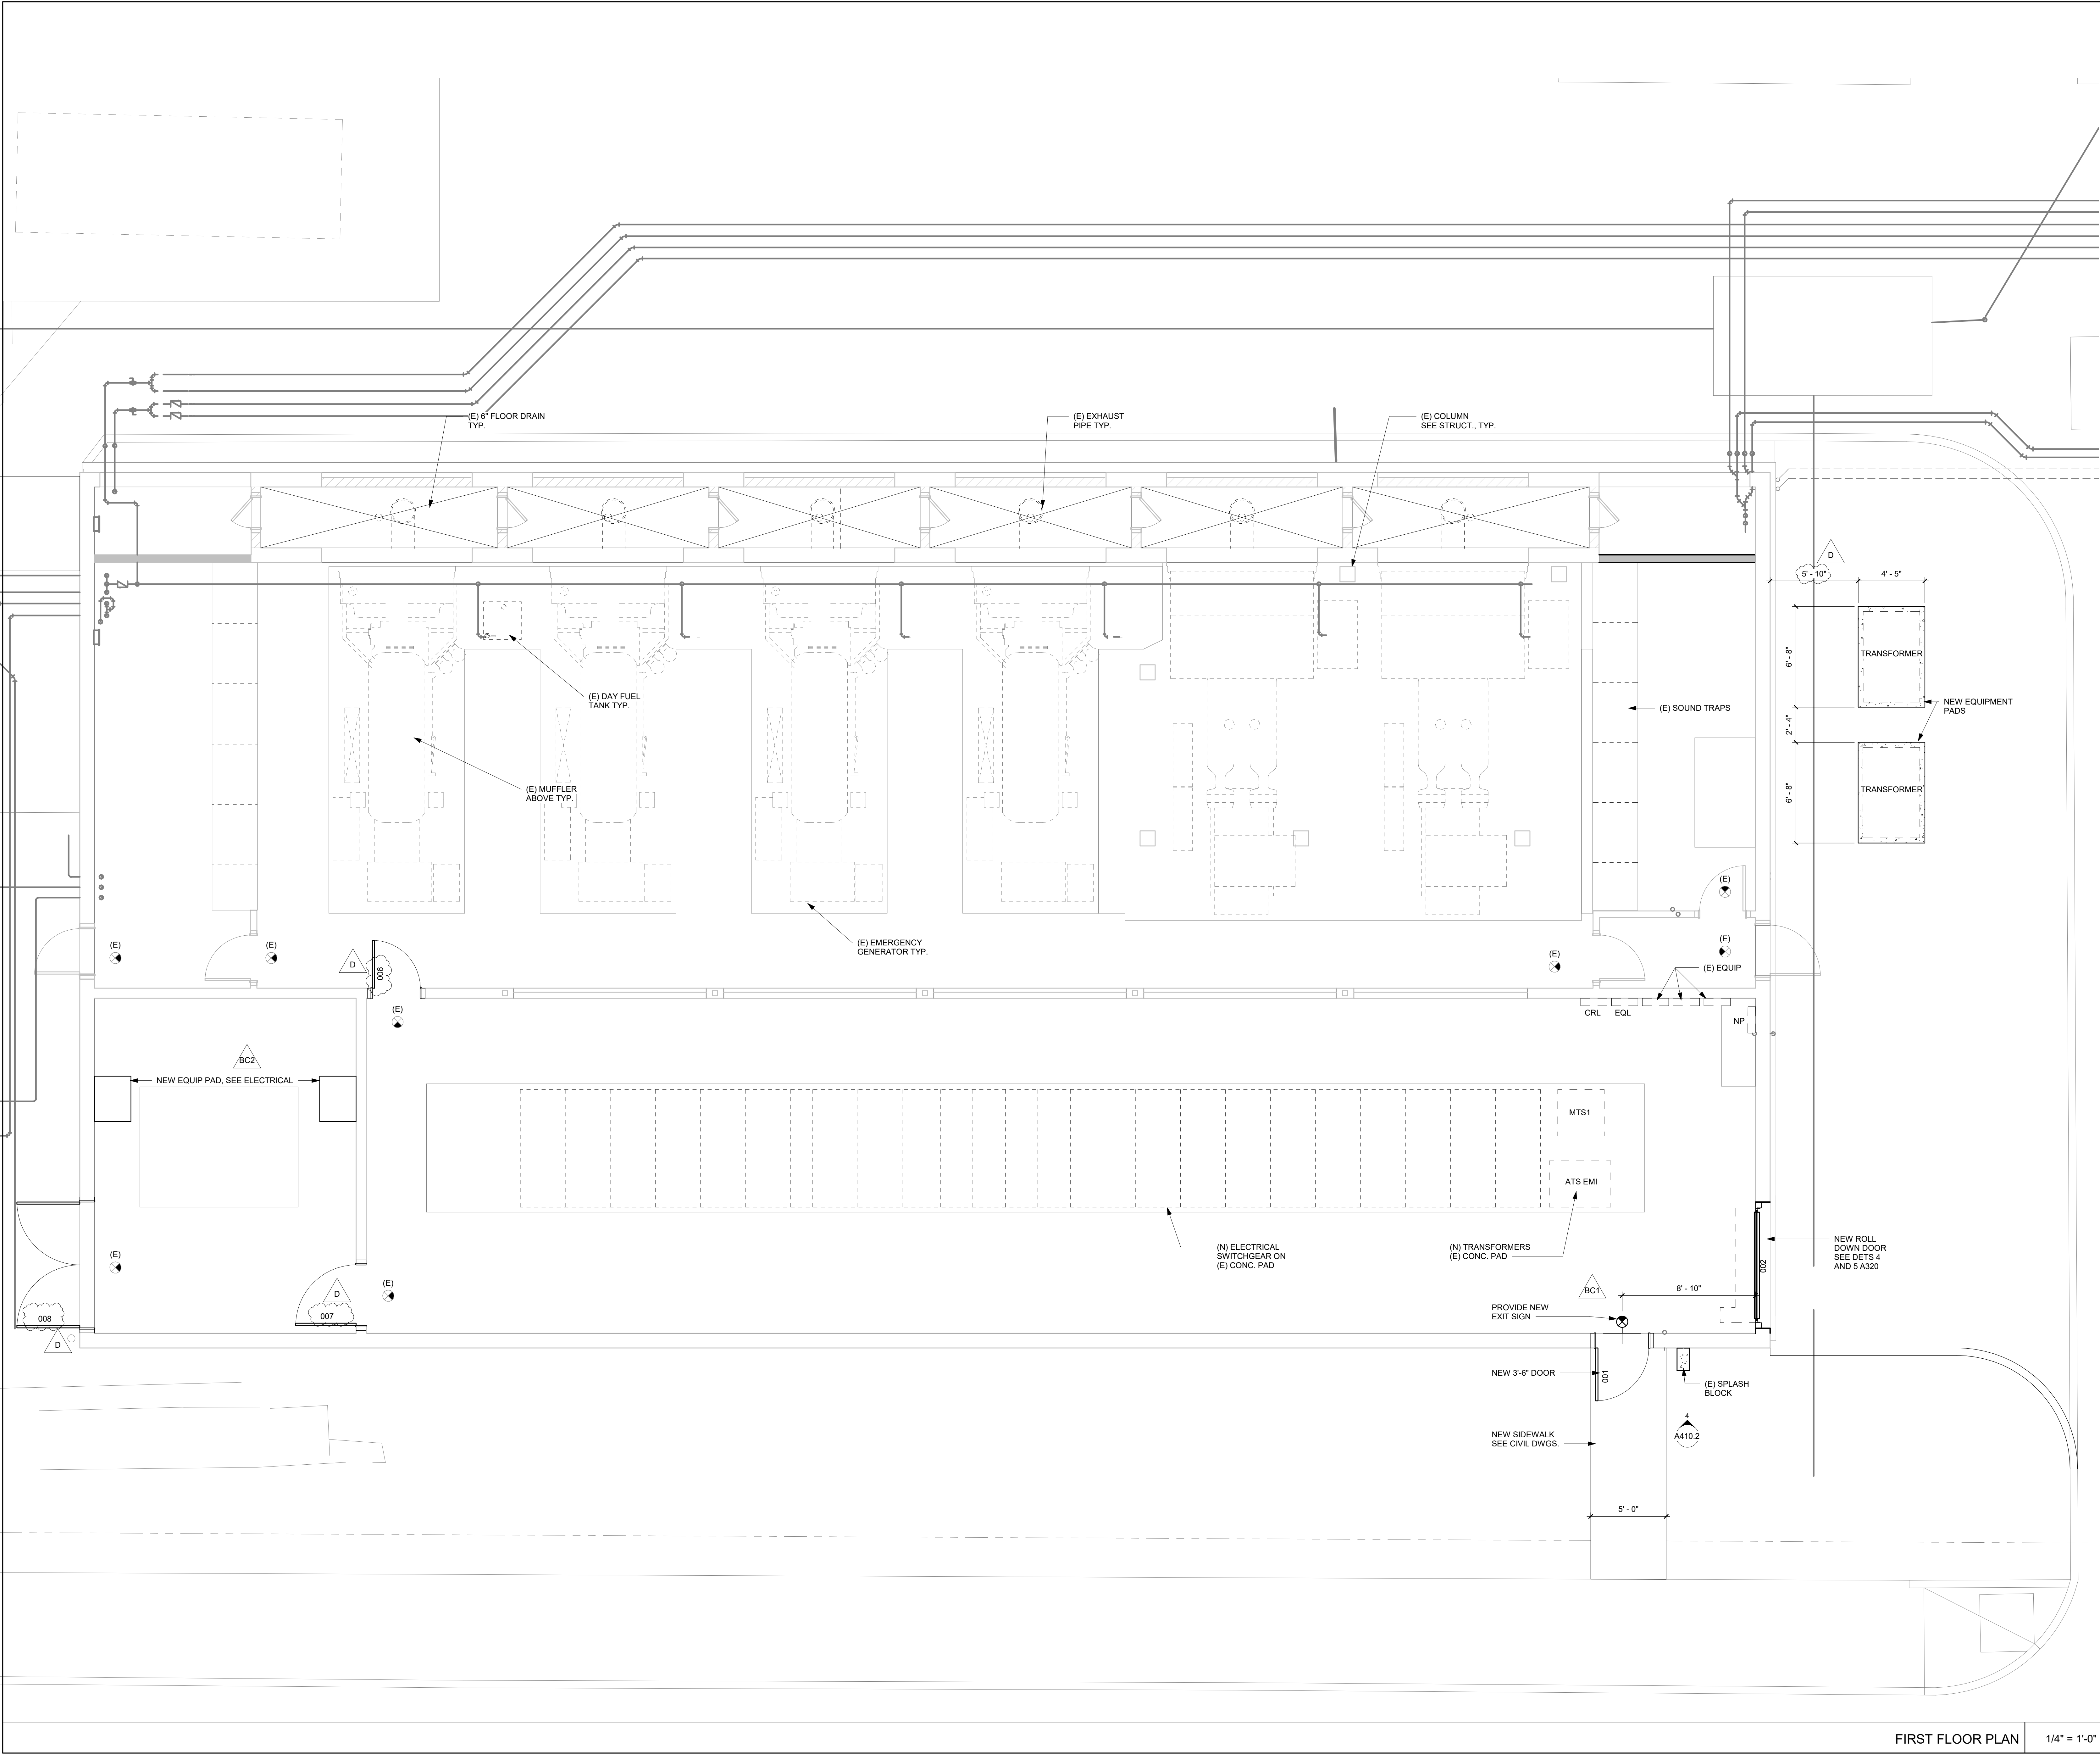

FIRST FLOOR PLAN

1/4" = 1'-0"

1




RBB ARCHITECTS INC

Joseph A. Balbons, AIA
Sylvia Botero, AIA
Kevin S. Boots, AIA

10980 Wilshire Boulevard
Los Angeles, California
90024-3905

Telephone 310 473 3555
Facsimile 310 473 3555
www.rbbinc.com

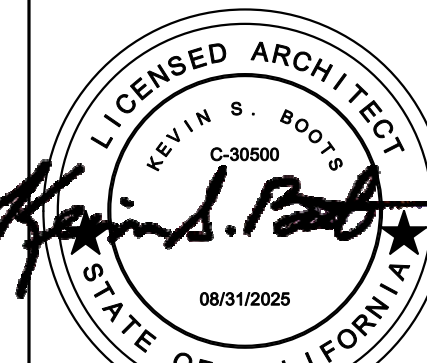

AGENCY APPROVALS

OSHPD # 1240005-19-02

CONSULTANT

ISSUE RECORD

DATE	DESCRIPTION
04/09/2025	D ADDENDUM D
01/31/2025	BC2 HCAI BACKCHECK 2
10/25/2024	BC1 HCAI BACKCHECK 1
06/13/2024	- HCAI SUBMITTAL
04/18/2024	- HCAI SUBMITTAL


Harbor-UCLA
MEDICAL CENTER
HARBOR-UCLA MEDICAL CENTER
PHASE 2E INC 2 - GENERATOR BLDG.
RETROFIT

1000 West Carson Street, Torrance, CA 90509

MILESTONE: HCAI SUBMITTAL
MILESTONE DATE: 10/25/2024
RBB PROJECT: 1712076 SCALE: 1/4" = 1'-0"

DESCRIPTION
GENERATOR BUILDING
RETROFIT PLAN

A511.2

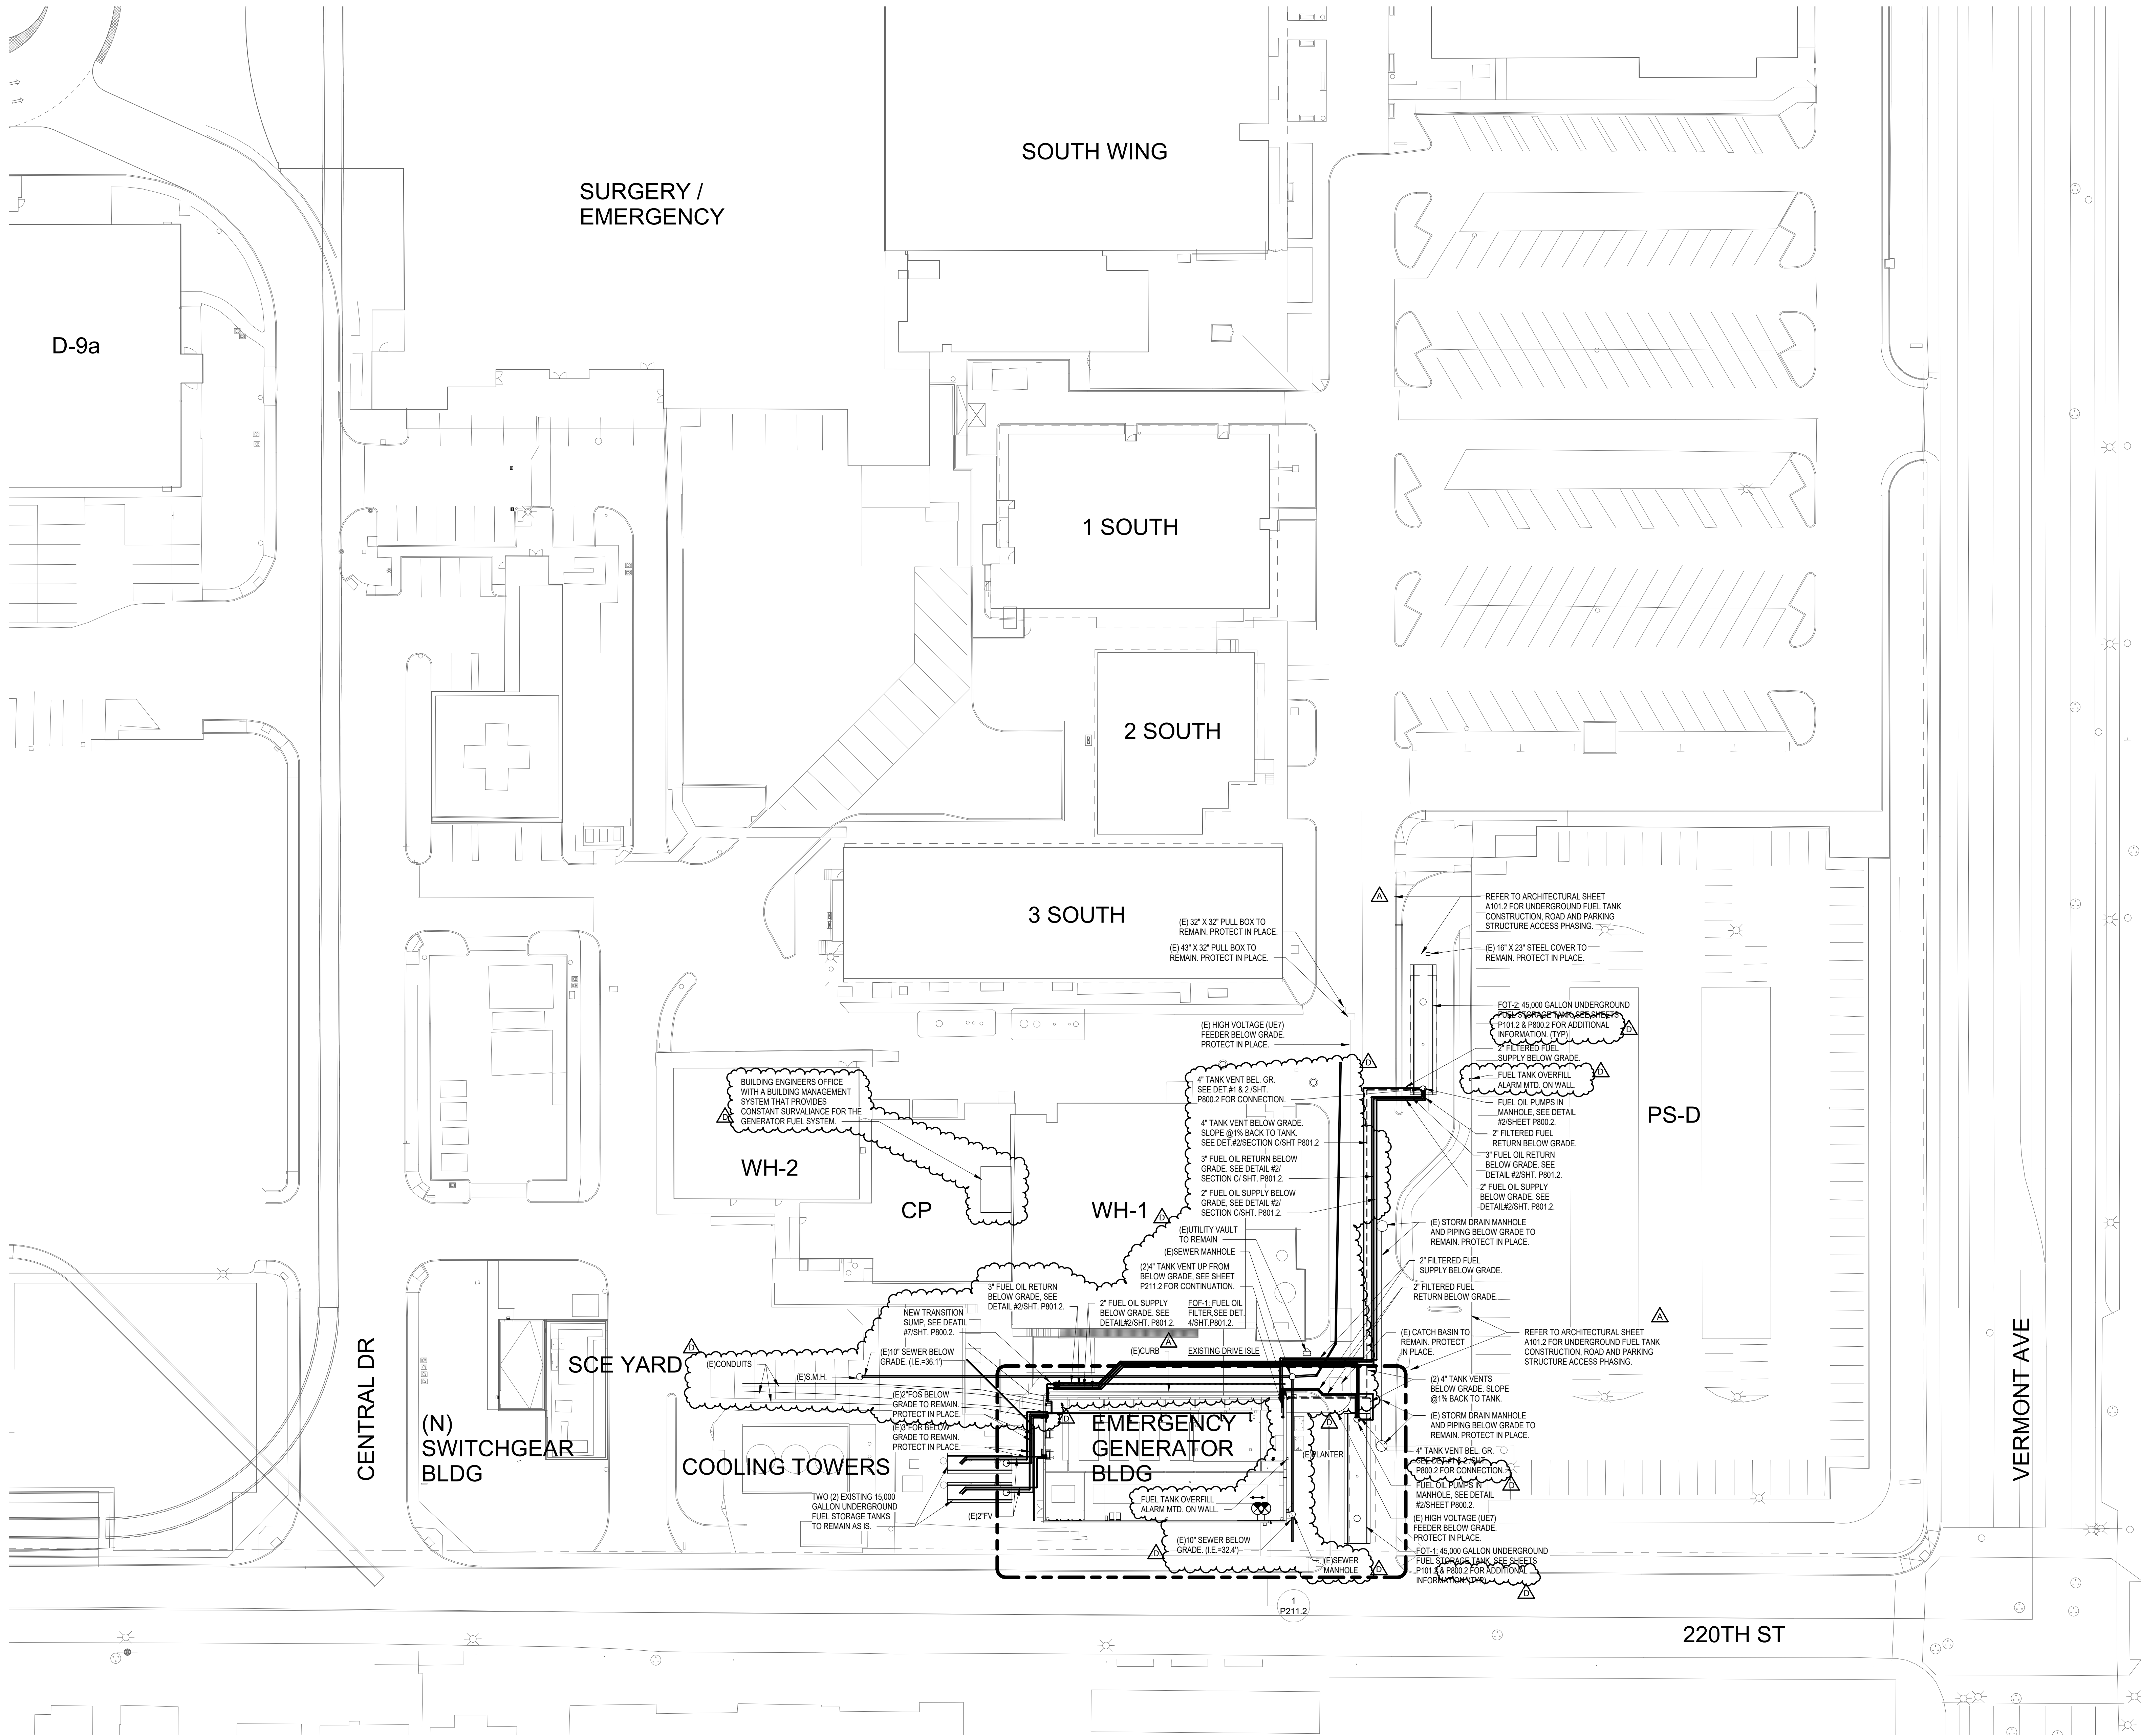


RBB ARCHITECTS INC

Joseph A. Balbons, AIA
Sylvia Botero, AIA
Kevin S. Boots, AIA

10980 Wilshire Boulevard
Los Angeles, California
90024-3905

Telephone 310 473 3555
Facsimile 310 473 3555
www.rbbinc.com

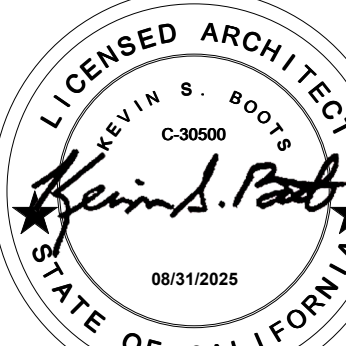

AGENCY APPROVALS

OSHPD # 1240005-19-02

CONSULTANT



515 South Figueroa Street, Suite 1400
Los Angeles, California 90071
213.907.8400 www.tklsc.com
Project Leader - Michael Huynh
Plumbing Lead - Ron Brick
tklsc Job #2017-0456-035

ISSUE RECORD

DATE	DESCRIPTION
04/09/2025	D ADDENDUM D
03/14/2025	A ADDENDUM A
02/10/2025	BID SET
01/31/2025	BC2 HCAI BACKCHECK 2
10/25/2024	BC1 HCAI BACKCHECK 1
06/13/2024	HCAI SUBMITTAL
04/18/2024	HCAI SUBMITTAL



HARBOR-UCLA MEDICAL CENTER

PHASE 2E INC2 - GENERATOR BUILDING RETROFIT

1000 West Carson Street, Torrance, CA 90502


MILESTONE: HCAI SUBMITTAL

MILESTONE DATE: 6/13/2024

RBB PROJECT: 1712076 SCALE: 1" = 30'-0"

DESCRIPTION
PLUMBING PARTIAL SITE PLAN

P101.2

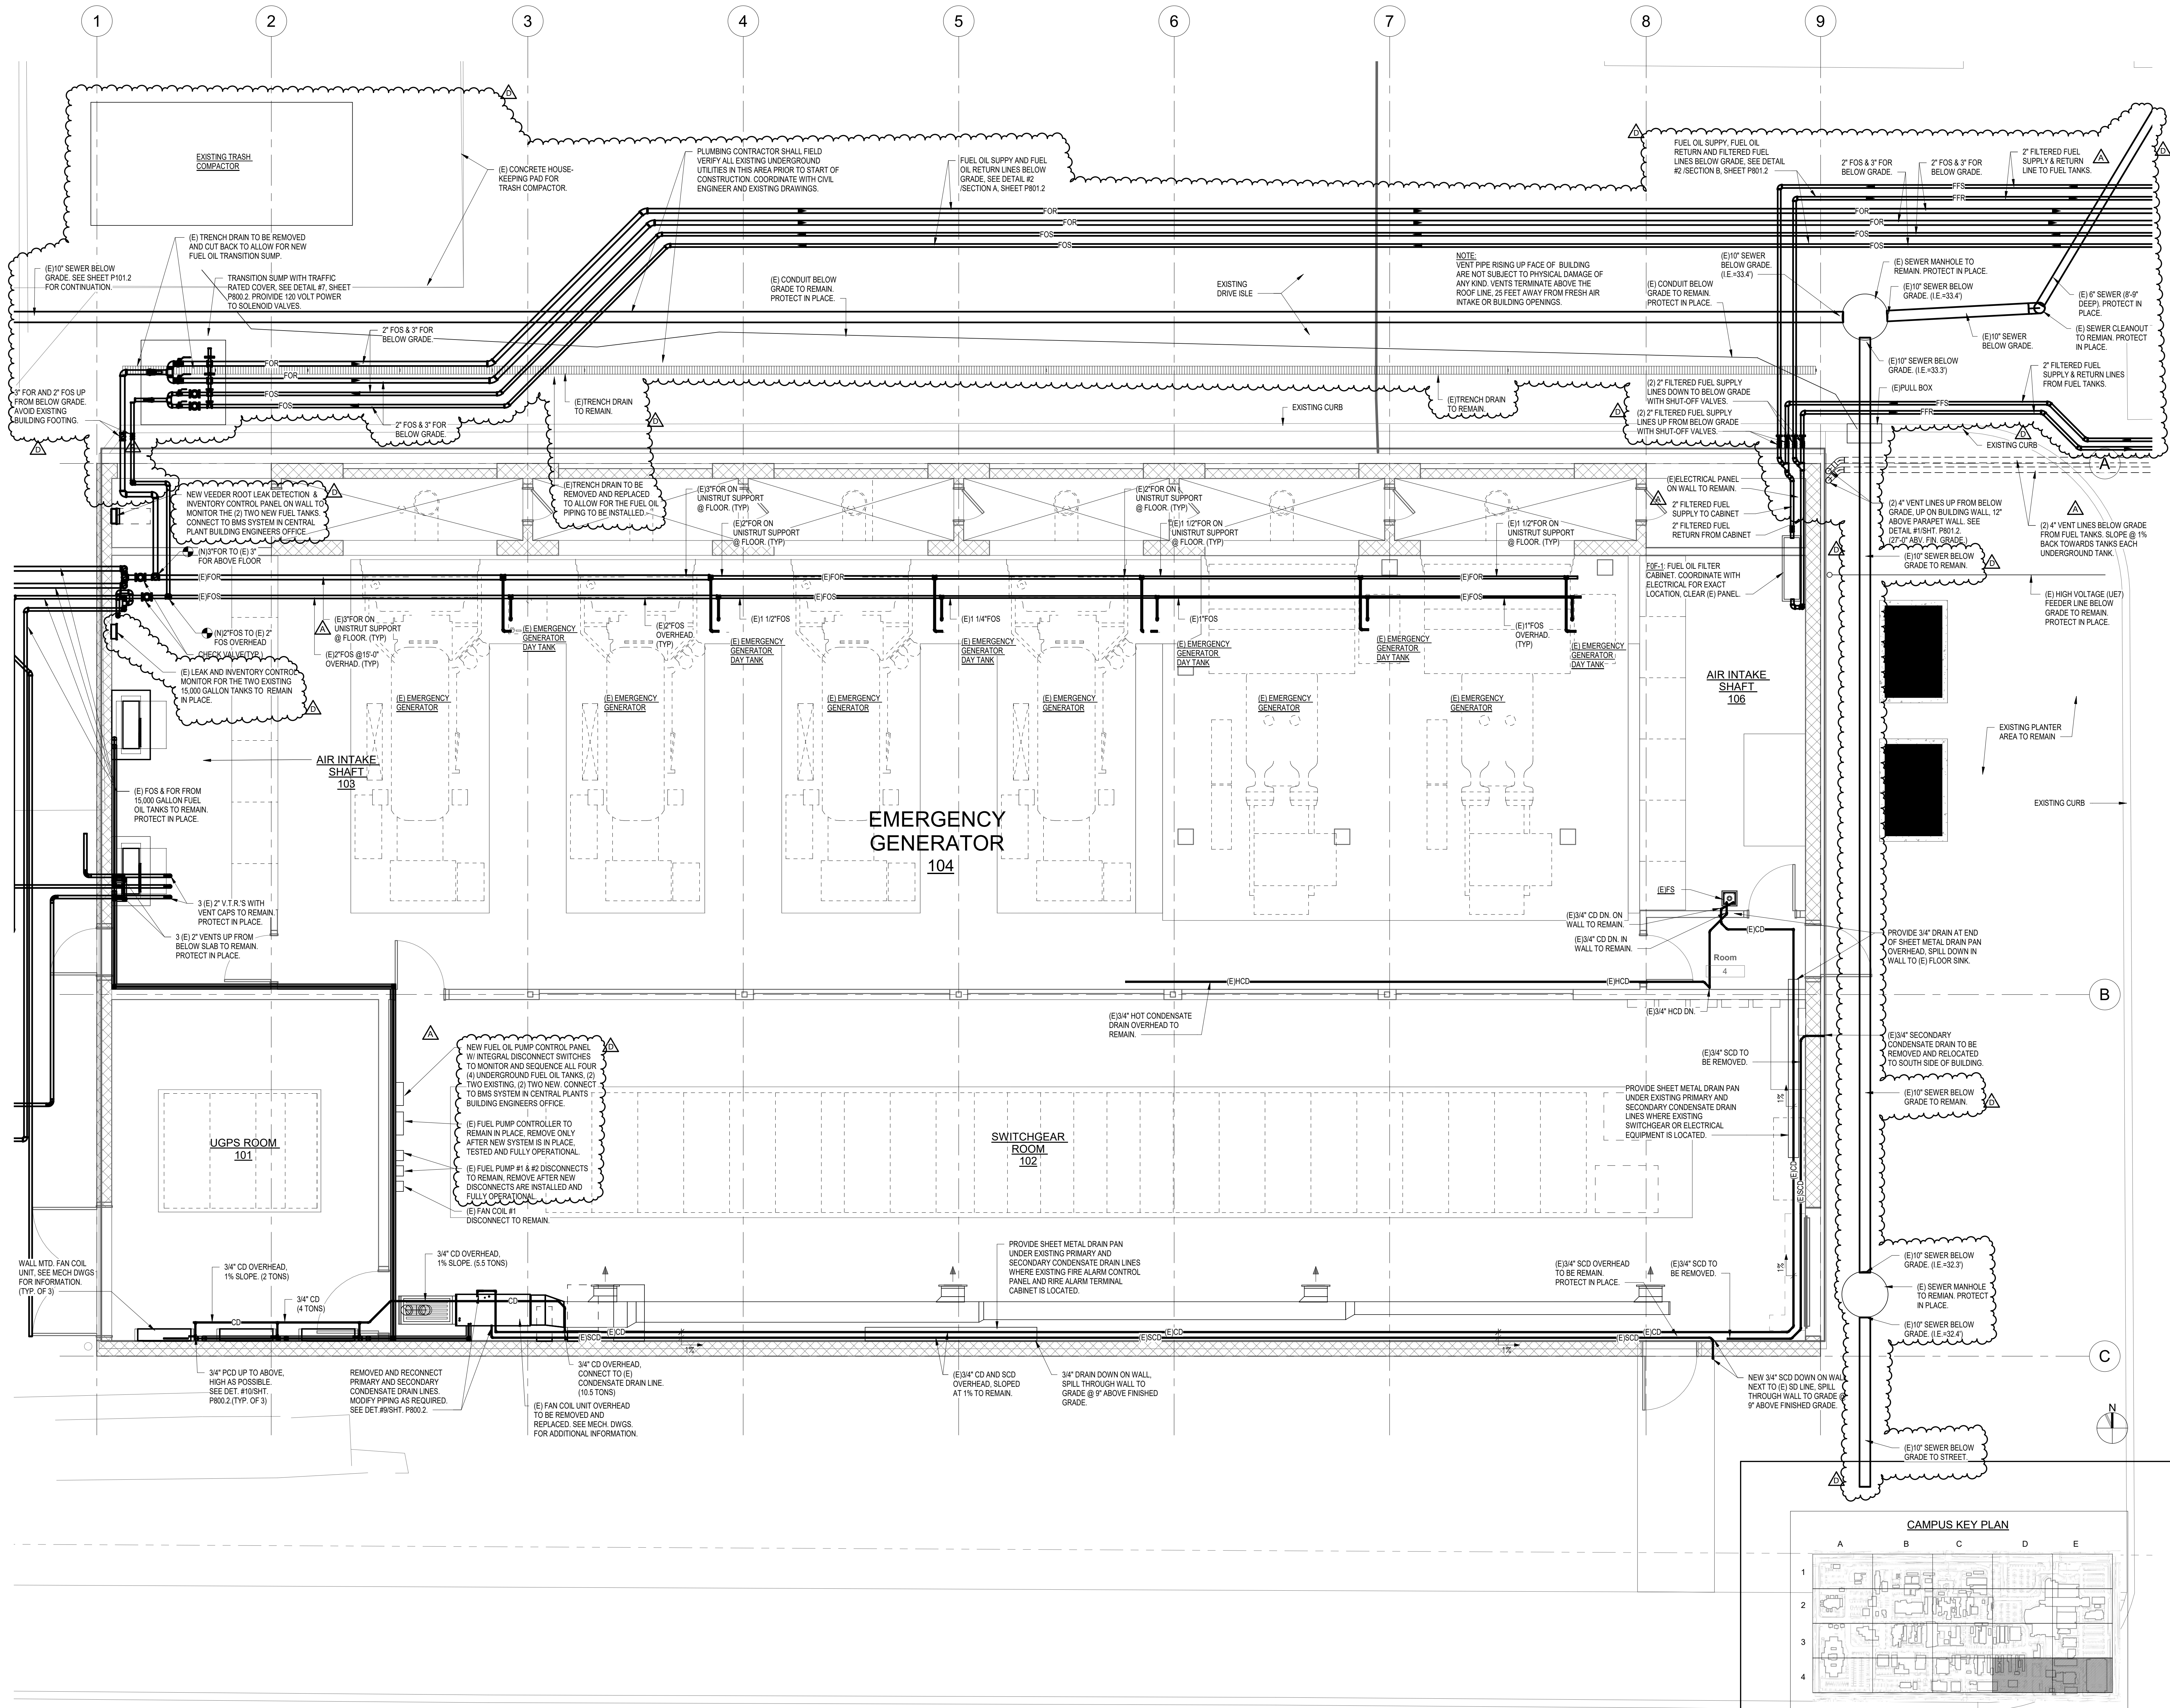


RBB ARCHITECTS INC

Joseph A. Balbons, AIA
Sylvia Botero, AIA
Kevin S. Boots, AIA

10980 Wilshire Boulevard
Los Angeles, California
90024-3905

Telephone 310 473 3555
Facsimile 310 473 3555
www.rbbinc.com

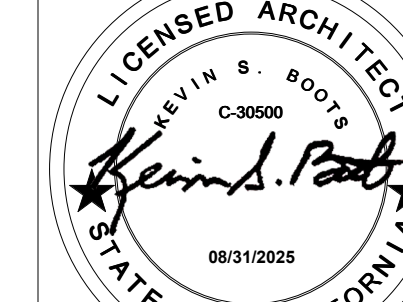

AGENCY APPROVALS

OSHPD # 1240005-19-02

CONSULTANT

tklsc
COLLABORATIVE

515 South Figueroa Street, Suite 1400
Los Angeles, California 90071
213.507.8400 www.tklsc.com
Project Leader - Michael Huynh
Plumbing Lead - Ron Brick
tklsc Job #2017-0456-035

ISSUE RECORD

04/09/2025	D	ADDENDUM D
03/14/2025	A	ADDENDUM A
02/10/2025		BID SET
01/31/2025	BC2	HCAI BACKCHECK 2
10/25/2024	BC1	HCAI BACKCHECK 1
06/13/2024		HCAI SUBMITTAL
04/18/2024		HCAI SUBMITTAL
DATE	△	DESCRIPTION

Harbor-UCLA
MEDICAL CENTER
HARBOR-UCLA MEDICAL CENTER

PHASE 2E INC2 - GENERATOR
BUILDING RETROFIT

1000 West Carson Street, Torrance, CA 90502


MILESTONE: HCAI SUBMITTAL

MILESTONE DATE: 6/13/2024

RBB PROJECT: 1712076 SCALE: 1/4" = 1'-0"

DESCRIPTION
PLUMBING LEVEL 1 PLAN

P211.2

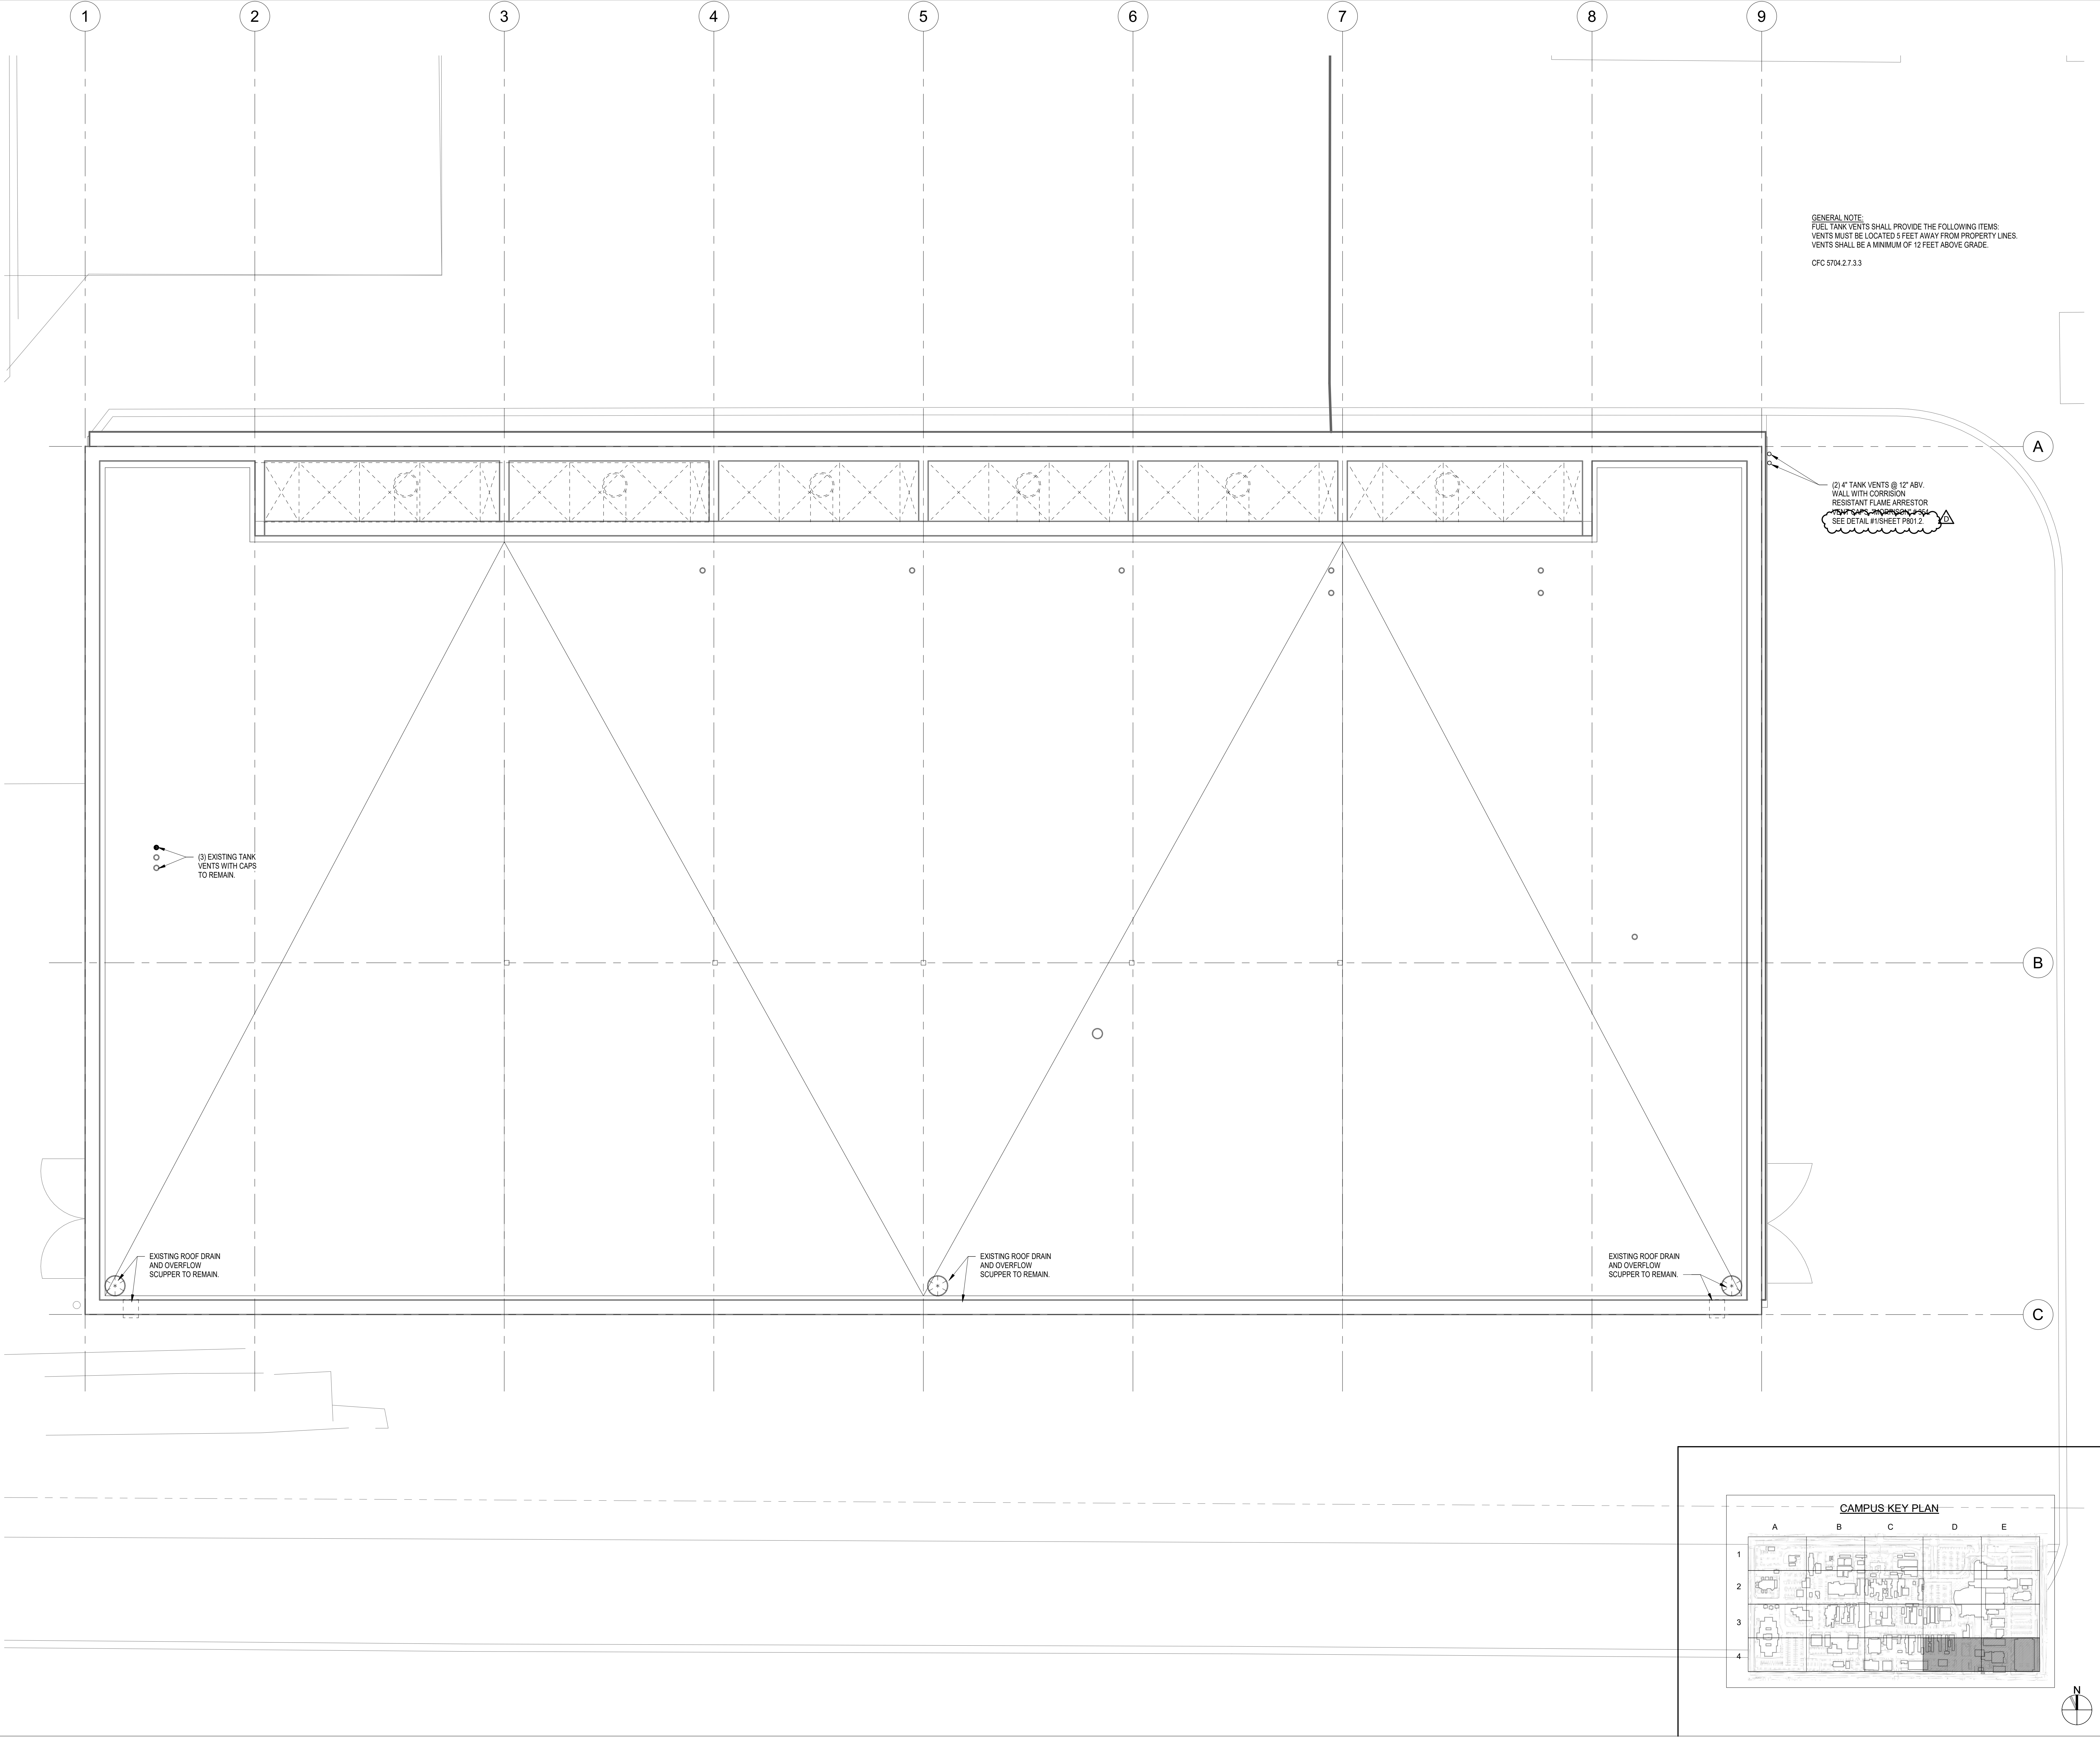


RBB ARCHITECTS INC

Joseph A. Balbons, AIA
Sylvia Botero, AIA
Kevin S. Boots, AIA

10980 Wilshire Boulevard
Los Angeles, California
90024-3905

Telephone 310 473 3555
Facsimile 310 473 3555
www.rbbinc.com

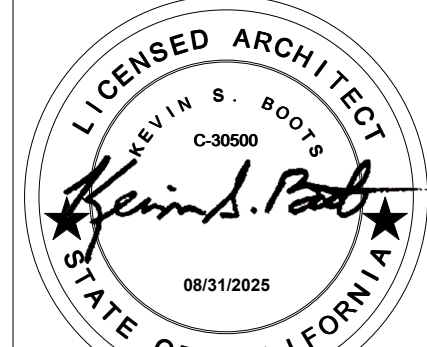

AGENCY APPROVALS

OSHPD # 1240005-19-02

CONSULTANT



515 South Figueroa Street, Suite 1400
Los Angeles, California 90071
213.507.8400 www.tklsc.com
Project Leader - Michael Huynh
Plumbing Lead - Ron Brick
tklsc Job #2017-0456-035

ISSUE RECORD

DATE	DESCRIPTION
04/09/2025	D ADDENDUM D
10/21/2025	BID SET
10/25/2024	BC1 HCAI BACKCHECK 1
06/13/2024	HCAI SUBMITTAL
04/18/2024	HCAI SUBMITTAL



HARBOR-UCLA MEDICAL CENTER

PHASE 2E INC2 - GENERATOR BUILDING RETROFIT

1000 West Carson Street, Torrance, CA 90502

MILESTONE: HCAI SUBMITTAL


MILESTONE DATE: 6/13/2024

RBB PROJECT: 1712076 SCALE: 1/4" = 1'-0"

DESCRIPTION
PLUMBING ROOF PLAN

P220.2

Print Date: 4/10/2025 5:12:18 AM

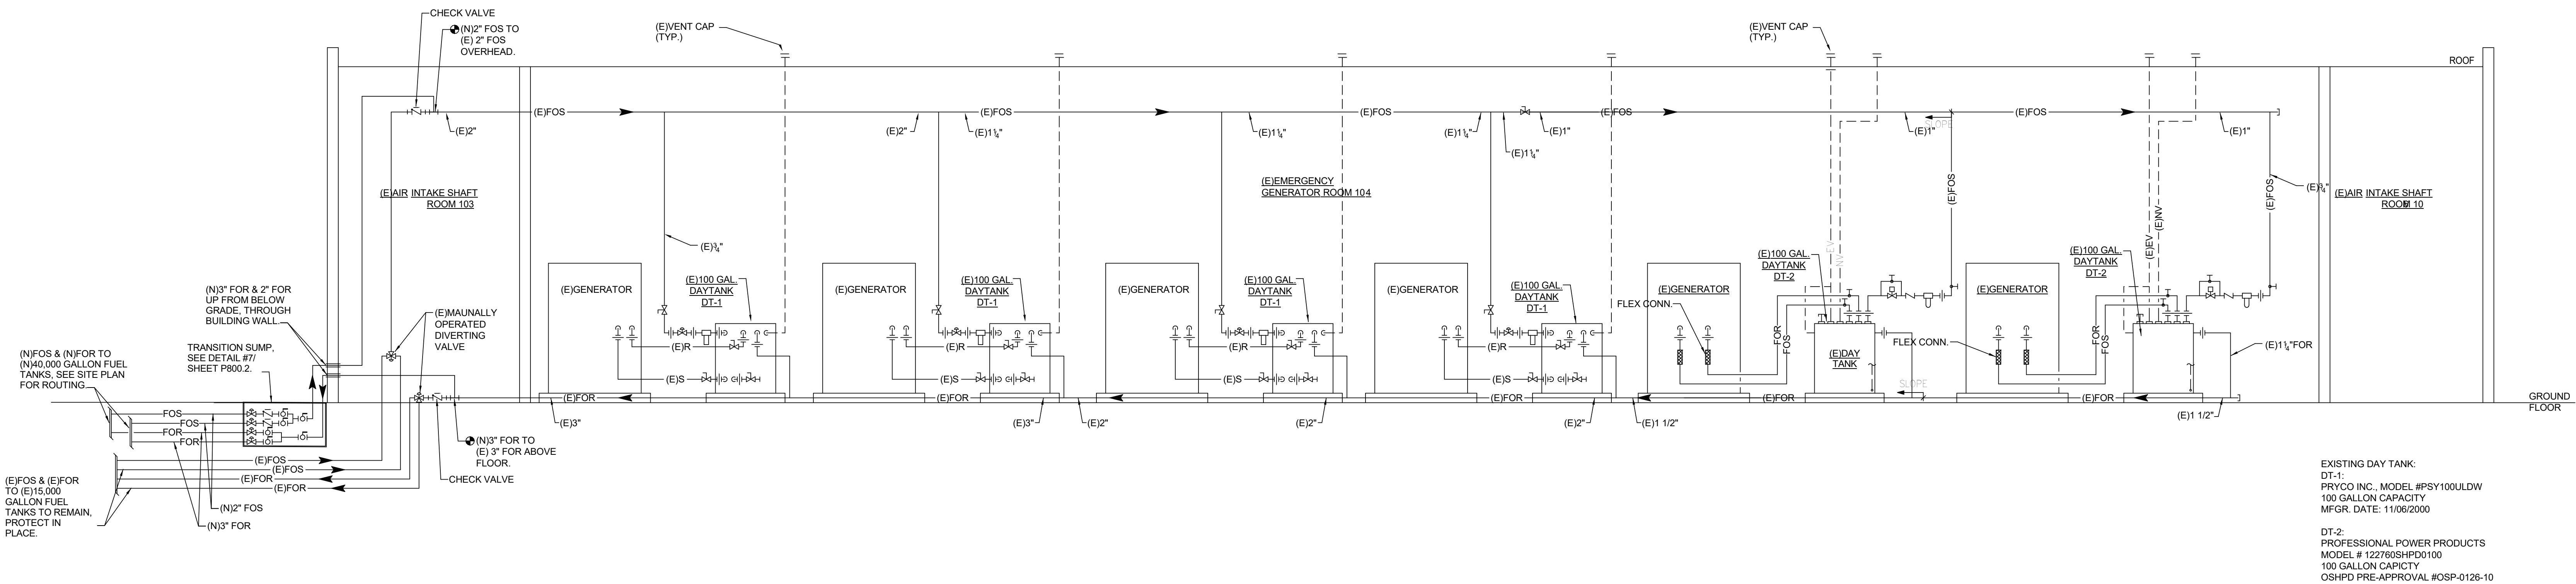

EXISTING DAY TANK:
DT-1:
PRYCO INC. MODEL #PSY100ULDW
100 GALLON CAPACITY
MFG. DATE: 11/06/2000
DT-2:
PROFESSIONAL POWER PRODUCTS
MODEL # 122760SHPPD0100
100 GALLON CAPCTY
OSHPD PRE-APPROVAL #OSP-0126-10

EXISTING GENERATOR / DAY TANK PIPING DETAIL

SCALE
NONE 1

- A. ON FALLING LEVEL IN EXISTING DAY TANKS, TANK FLOAT SWITCH #1 SHALL START THE PRIMARY FILL PUMP AND ENERGIZE THE NORMALLY CLOSED SOLENOID VALVE IN THE FILL SUPPLY LINE.
- B. ON RISING LEVEL IN EXISTING DAY TANK, TANK FLOAT SWITCH #2 SHALL STOP THE PRIMARY FILL PUMP AND DE-ENERGIZE THE NORMALLY CLOSED SOLENOID VALVE IN THE FILL SUPPLY LINE.
- C. IN THE EVENT THAT THE PRIMARY FILL PUMP DOES NOT FILL EXISTING DAY TANK TO "PUMP OFF" LEVEL, A DROP IN FUEL LEVEL TO TANK FLOAT SWITCH #1 WILL START THE SECOND PUMP. SEQUENCE A, B, & C WOULD BE TYPICAL FOR EACH OF THE FOUR (4) FUEL OIL STORAGE TANKS (2 EXISTING AND 2 NEW TANKS). ONLY PRIMARY OR LAG PUMP FOR EACH TANK WILL BE ENERGIZED AT ONE TIME.
- D. DAY TANK HIGH FUEL LEVEL ALARM - DAY TANK HIGH FUEL LEVEL SHALL BE SENSED BY THE TANK FLOAT SWITCH #3. IN THE EVENT OF A HIGH FUEL LEVEL CONDITION IN DAY TANK, THE FCM SHALL:
1. ACTIVATE AN ALARM AT THE FCM PANEL.
 2. SEND A SIGNAL TO THE EMERGENCY GENERATOR FOR ENGINE SHUTDOWN.
 3. DEACTIVATE FILL PUMPS AND DE-ENERGIZE CLOSE THE SOLENOID VALVE IN THE FILL SUPPLY LINE.
 4. SEND AN ALARM SIGNAL TO THE BUILDING AUTOMATION SYSTEM.
- E. DAY TANK LOW FUEL LEVEL ALARM - DAY TANK LOW FUEL LEVEL SHALL BE SENSED BY THE TANK FLOAT SWITCH #4. IN THE EVENT OF A LOW FUEL LEVEL CONDITION IN DAY TANK, THE FCM SHALL:
1. ACTIVATE AN ALARM AT THE FCM PANEL.
 2. SEND A SIGNAL TO THE EMERGENCY GENERATOR FOR ENGINE SHUTDOWN.
 3. DEACTIVATE FILL PUMPS AND DE-ENERGIZE CLOSE THE SOLENOID VALVE IN THE FILL SUPPLY LINE.
 4. SEND AN ALARM SIGNAL TO THE BUILDING AUTOMATION SYSTEM.
- F. SECONDARY CONTAINMENT ALARM - CONTAMINATION OF THE SECONDARY CONTAINMENT AREA OF THE DAY TANK SHALL BE SENSED BY A LEAK DETECTION SWITCH. IN THE EVENT OF CONTAMINATION OF THE SECONDARY CONTAINMENT AREA, THE FCM SHALL:
1. ACTIVATE AN ALARM AT THE FCM PANEL.
 2. SEND A SIGNAL TO THE EMERGENCY GENERATOR FOR ENGINE SHUTDOWN.
 3. DEACTIVATE FILL PUMPS AND DE-ENERGIZE CLOSE THE SOLENOID VALVE IN THE FILL SUPPLY LINE.
 4. SEND AN ALARM SIGNAL TO THE BUILDING AUTOMATION SYSTEM.
- G. ALL MONITORING POINTS DESCRIBED ABOVE SHALL BE TIED BACK TO THE BUILDING MANAGEMENT SYSTEM LOCATED IN THE EXISTING CENTRAL PLANTS BUILDING ENGINEERS OFFICE. ENGINEERS OFFICE WILL BE CONTINUALLY OCCUPIED.

FUEL CONTROL AND MONITORING (FCM)

SEQUENCE OF OPERATION

SCALE
NONE 2

OSHPD # 1240005-19-02

CONSULTANT

tklsc
COLLABORATIVE

515 South Figueroa Street, Suite 1400
Los Angeles, California 90071
213.907.8400 www.tklsc.com
Project Leader - Michael Huynh
Plumbing Lead - Ron Brick
tklsc Job #2017-0456-035

ISSUE RECORD

04/09/2025	D	ADDENDUM D
02/10/2025		BID SET
01/31/2025	BC2	HCAI BACKCHECK 2
10/25/2024	BC1	HCAI BACKCHECK 1
06/13/2024		HCAI SUBMITTAL
DATE	△	DESCRIPTION

Harbor-UCLA
MEDICAL CENTER
HARBOR-UCLA MEDICAL CENTER

PHASE 2E INC2 - GENERATOR
BUILDING RETROFIT

1000 West Carson Street, Torrance, CA 90502

MILESTONE: HCAI SUBMITTAL


MILESTONE DATE: 6/13/2024

RBB PROJECT: 1712076 SCALE: 12" = 1'-0"


DESCRIPTION
DIAGRAMS & NOTES


P301.2

1. FOR SEQUENCE OF OPERATION NOTES, SEE SHEET P303.2.

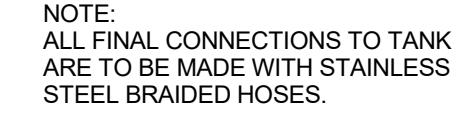

1

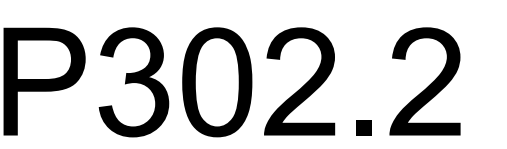

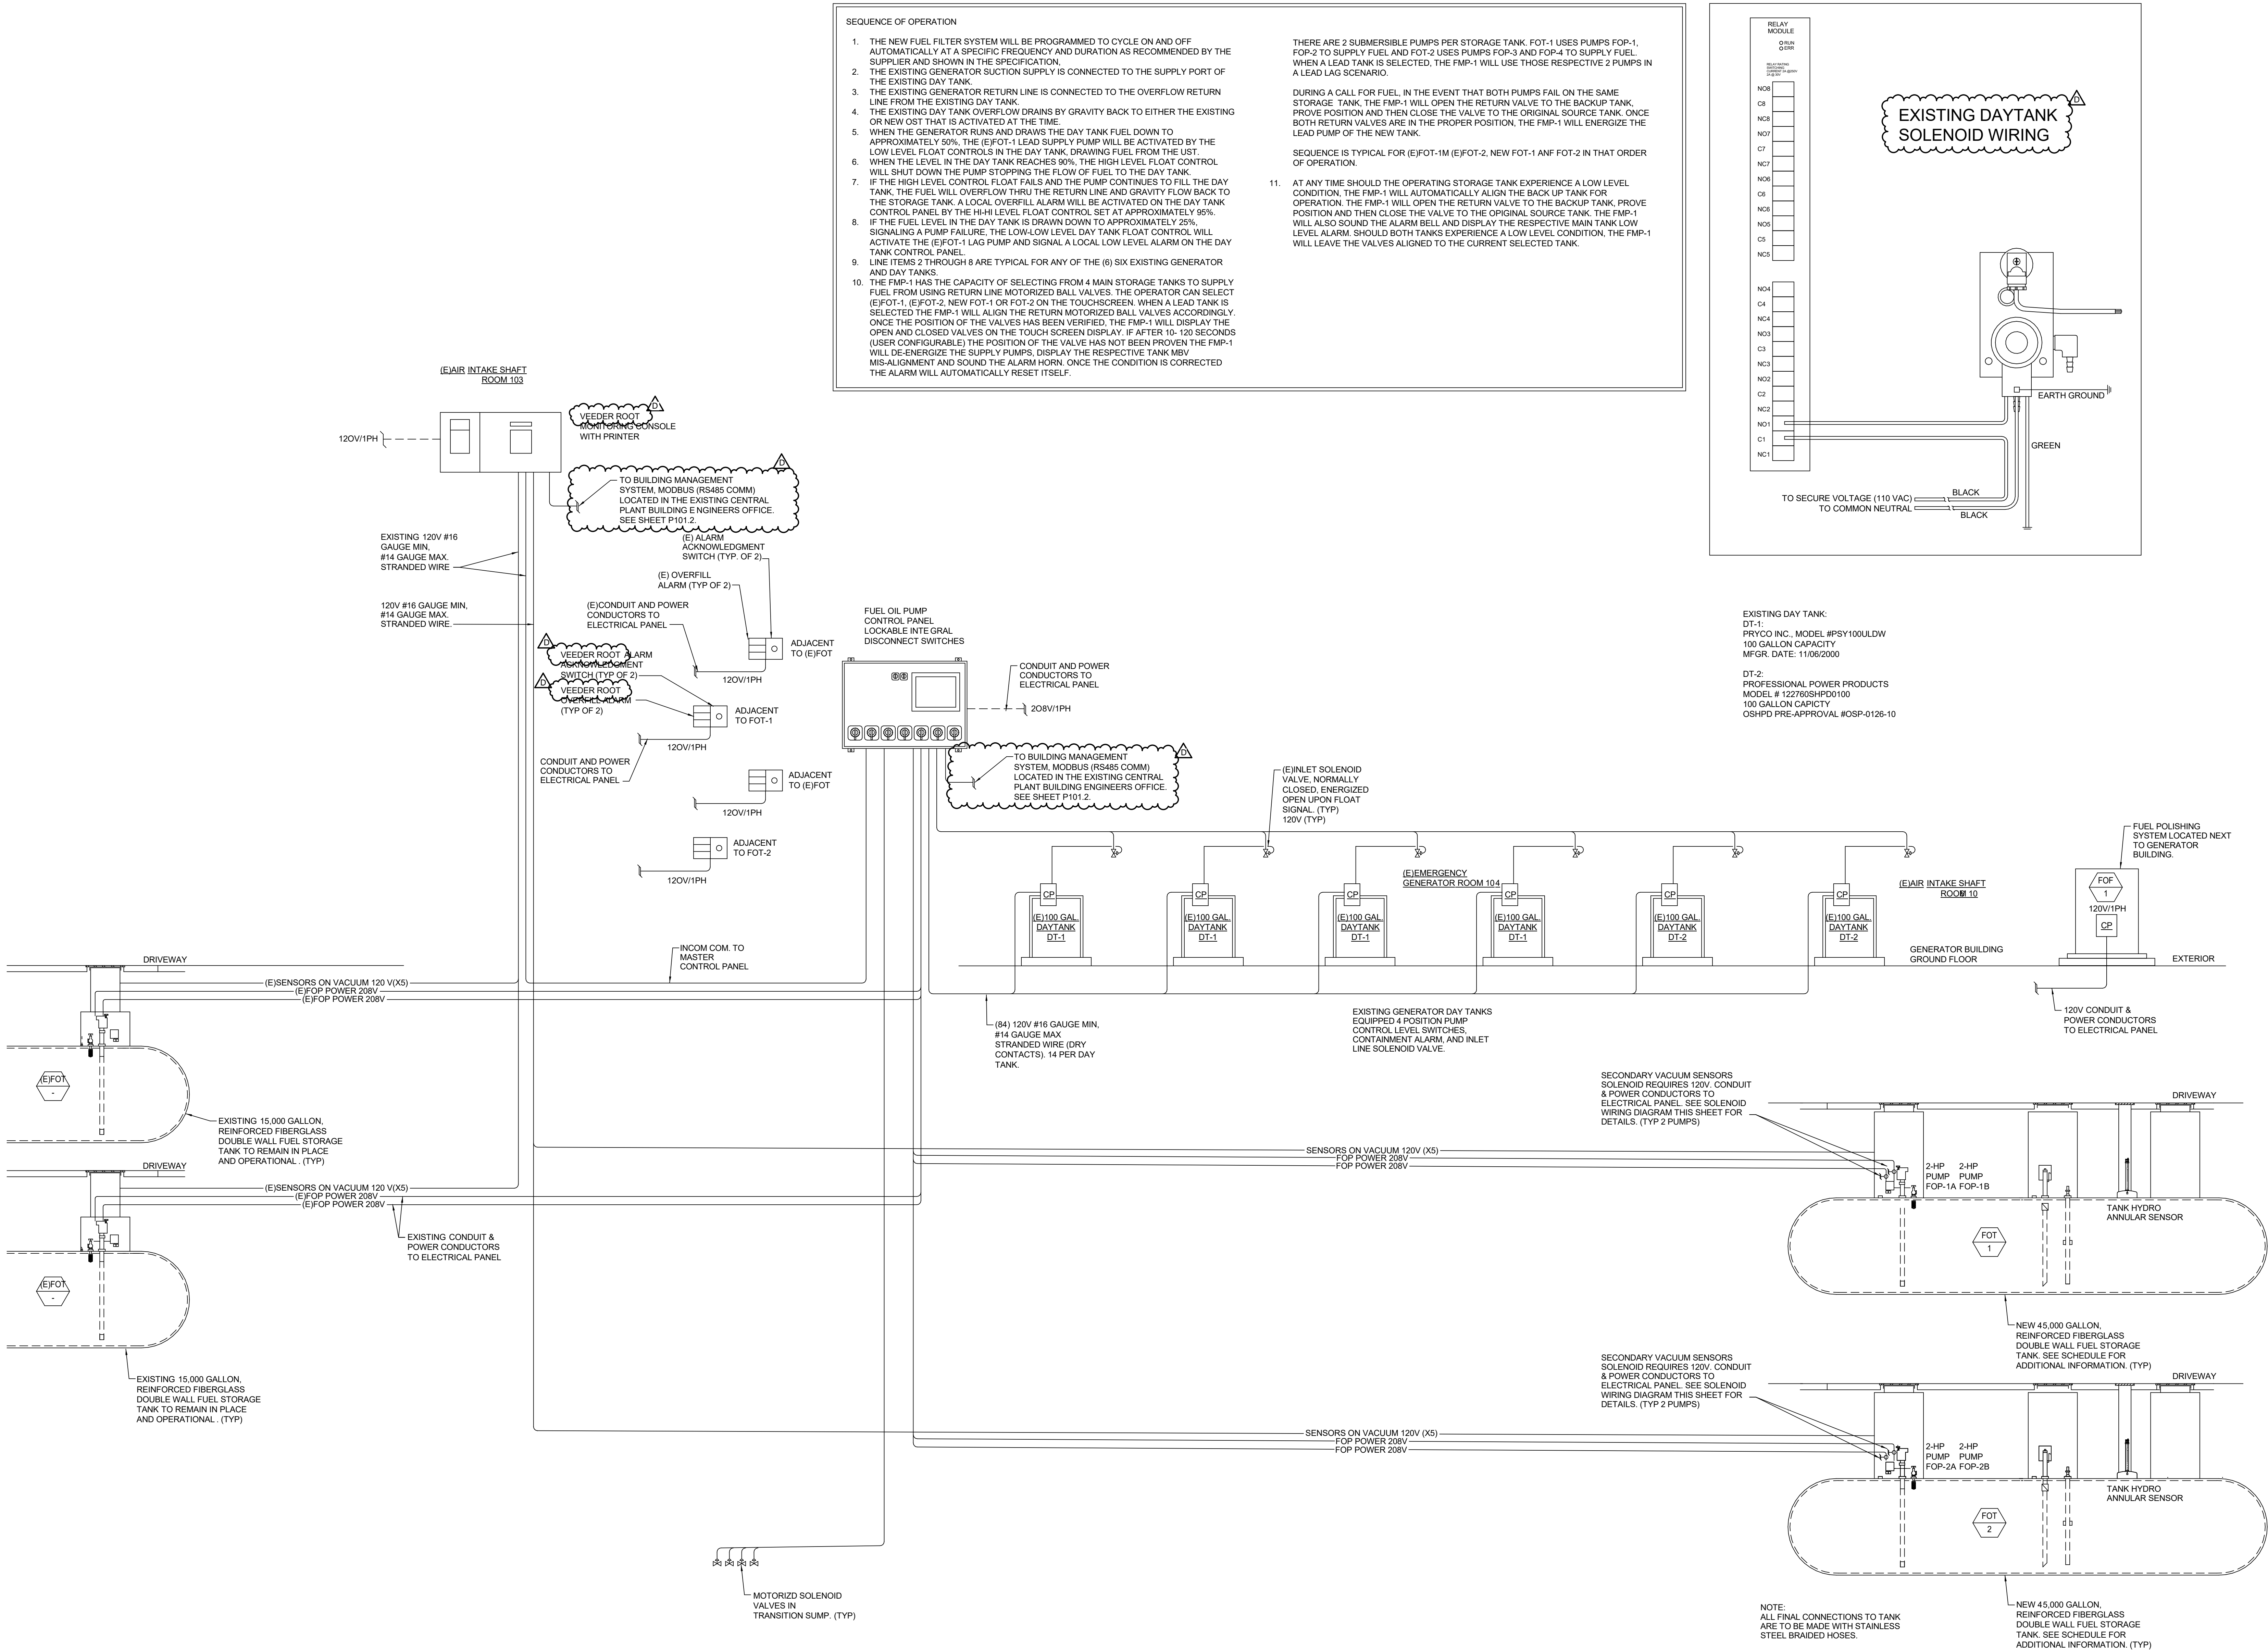

CONTROLS AND MONITORING DIAGRAM - POWER WIRING

SCALE
NONE 1

SEQUENCE OF OPERATION

1. THE NEW FUEL FILTER SYSTEM WILL BE PROGRAMMED TO CYCLE ON AND OFF AUTOMATICALLY AT A SPECIFIC FREQUENCY AND DURATION AS RECOMMENDED BY THE SUPPLIER AND SHOWN IN THE SPECIFICATION.

2. THE EXISTING GENERATOR SUCTION SUPPLY IS CONNECTED TO THE SUPPLY PORT OF THE EXISTING DAY TANK.

3. THE EXISTING GENERATOR RETURN LINE IS CONNECTED TO THE OVERFLOW RETURN LINE FROM THE EXISTING DAY TANK.

4. THE EXISTING DAY TANK OVERFLOW DRAINS BY GRAVITY BACK TO EITHER THE EXISTING OR NEW DST THAT IS ACTIVATED AT THE TIME.

5. WHEN THE GENERATOR RUNS AND DRAWS THE DAY TANK FUEL DOWN TO APPROXIMATELY 50%, THE (E)FOT-1 LEAD SUPPLY PUMP WILL BE ACTIVATED BY THE LOW LEVEL FLOAT CONTROLS IN THE DAY TANK, DRAWING FUEL FROM THE UST.

6. WHEN THE LEVEL IN THE DAY TANK REACHES 90%, THE HIGH LEVEL FLOAT CONTROL WILL SHUT DOWN THE PUMP STOPPING THE FLOW OF FUEL TO THE DAY TANK.

7. IF THE HIGH LEVEL CONTROL FLOAT FAILS AND THE PUMP CONTINUES TO FILL THE DAY TANK, THE FUEL WILL OVERFLOW THRU THE RETURN LINE AND GRAVITY FLOW BACK TO THE STORAGE TANK. A LOCAL OVERFILL ALARM WILL BE ACTIVATED ON THE DAY TANK CONTROL PANEL BY THE H-HI LEVEL FLOAT CONTROL, SET AT APPROXIMATELY 95%.

8. IF THE FUEL LEVEL IN THE DAY TANK IS DRAWN DOWN TO APPROXIMATELY 25%, SIGNALING A PUMP FAILURE, THE LOW-LOW LEVEL DAY TANK FLOAT CONTROL WILL ACTIVATE THE (E)FOT-1 LAG PUMP AND SIGNAL A LOCAL LOW LEVEL ALARM ON THE DAY TANK CONTROL PANEL.

9. LINE ITEMS 2 THROUGH 8 ARE TYPICAL FOR ANY OF THE (6) SIX EXISTING GENERATOR AND DAY TANKS.

10. THE FMP-1 HAS THE CAPACITY OF SELECTING FROM 4 MAIN STORAGE TANKS TO SUPPLY FUEL FROM USING RETURN LINE MOTORIZED BALL VALVES. THE OPERATOR CAN SELECT (E)FOT-1, (E)FOT-2, NEW FOT-1 OR FOT-2 ON THE TOUCHSCREEN. WHEN A LEAD TANK IS SELECTED THE FMP-1 WILL ALIGN THE RETURN MOTORIZED BALL VALVES ACCORDINGLY. ONCE THE POSITION OF THE VALVES HAS BEEN VERIFIED, THE FMP-1 WILL DISPLAY THE OPEN AND CLOSED VALVES ON THE TOUCH SCREEN DISPLAY. IF AFTER 10-120 SECONDS (USER CONFIGURABLE) THE POSITION OF THE VALVE HAS NOT BEEN PROVEN THE FMP-1 WILL DE-ENERGIZE THE SUPPLY PUMPS, DISPLAY THE RESPECTIVE TANK MBV MIS-ALIGNMENT AND SOUND THE ALARM HORN. ONCE THE CONDITION IS CORRECTED THE ALARM WILL AUTOMATICALLY RESET ITSELF.

THERE ARE 2 SUBMERSIBLE PUMPS PER STORAGE TANK. FOT-1 USES PUMPS FOP-1, FOP-2 TO SUPPLY FUEL AND FOT-2 USES PUMPS FOP-3 AND FOP-4 TO SUPPLY FUEL. WHEN A LEAD TANK IS SELECTED, THE FMP-1 WILL USE THOSE RESPECTIVE 2 PUMPS IN A LEAD LAG SCENARIO.

DURING A CALL FOR FUEL, IN THE EVENT THAT BOTH PUMPS FAIL ON THE SAME STORAGE TANK, THE FMP-1 WILL OPEN THE RETURN VALVE TO THE BACKUP TANK, PROVE POSITION AND THEN CLOSE THE VALVE TO THE ORIGINAL SOURCE TANK. ONCE BOTH RETURN VALVES ARE IN THE PROPER POSITION, THE FMP-1 WILL ENERGIZE THE LEAD PUMP OF THE NEW TANK.

SEQUENCE IS TYPICAL FOR (E)FOT-1M (E)FOT-2, NEW FOT-1 ANF FOT-2 IN THAT ORDER OF OPERATION.

11. AT ANY TIME SHOULD THE OPERATING STORAGE TANK EXPERIENCE A LOW LEVEL CONDITION, THE FMP-1 WILL AUTOMATICALLY ALIGN THE BACK UP TANK FOR OPERATION. THE FMP-1 WILL OPEN THE RETURN VALVE TO THE BACKUP TANK, PROVE POSITION AND THEN CLOSE THE VALVE TO THE ORIGINAL SOURCE TANK. THE FMP-1 WILL ALSO SOUND THE ALARM BELL AND DISPLAY THE RESPECTIVE MAIN TANK LOW LEVEL ALARM. SHOULD BOTH TANKS EXPERIENCE A LOW LEVEL CONDITION, THE FMP-1 WILL LEAVE THE VALVES ALIGNED TO THE CURRENT SELECTED TANK.

EXISTING DAY TANK:
DT-1:
PRYCO INC., MODEL #PSY100ULDW
100 GALLON CAPACITY
MFG. DATE: 11/06/2009
DT-2:
PROFESSIONAL POWER PRODUCTS
MODEL # 122760SHPD0100
100 GALLON CAPACITY
OSHPD PRE-APPROVAL #OSP-0126-10

RBB

RBB ARCHITECTS INC

Joseph A. Balbons, AIA
Sylvia Botero, AIA
Kevin S. Boots, AIA

10980 Wilshire Boulevard
Los Angeles, California
90024-3905

Telephone 310 473 3555
Facsimile 310 473 3555
www.rbbinc.com

PROFESSIONAL ENGINEER
No. 128150
EXP. 12-31-26
STATE OF CALIFORNIA

LICENSED ARCHITECT
No. 128150
EXP. 12-31-26
STATE OF CALIFORNIA

08/01/2025

AGENCY APPROVALS

OSHPD # 1240005-19-02

CONSULTANT

tklsc

COLLABORATIVE

515 South Figueroa Street, Suite 1400
Los Angeles, California 90071
213.907.8400 www.tklsc.com
Project Leader - Michael Huynh
Plumbing Lead - Ron Brick
tklsc Job #2017-0456-035

ISSUE RECORD

DATE	DESCRIPTION
04/09/2025	D ADDENDUM D
02/10/2025	BID SET
01/31/2025	BC2 HCAI BACKCHECK 2
10/25/2024	BC1 HCAI BACKCHECK 1
06/13/2024	HCAI SUBMITTAL

Harbor-UCLA
MEDICAL CENTER

HARBOR-UCLA MEDICAL CENTER

PHASE 2E INC2 - GENERATOR
BUILDING RETROFIT

1000 West Carson Street, Torrance, CA 90502

MILESTONE:

HCAI SUBMITTAL

MILESTONE DATE:

6/13/2024

RBB PROJECT:

1712076

SCALE:



12" = 1'-0"

DESCRIPTION

CONTROLS AND MONITORING
DIAGRAM - POWER WIRING

P303.2

SEQUENCE OF OPERATION
1. FOR SEQUENCE OF OPERATION NOTES, SEE SHEET P303.2.

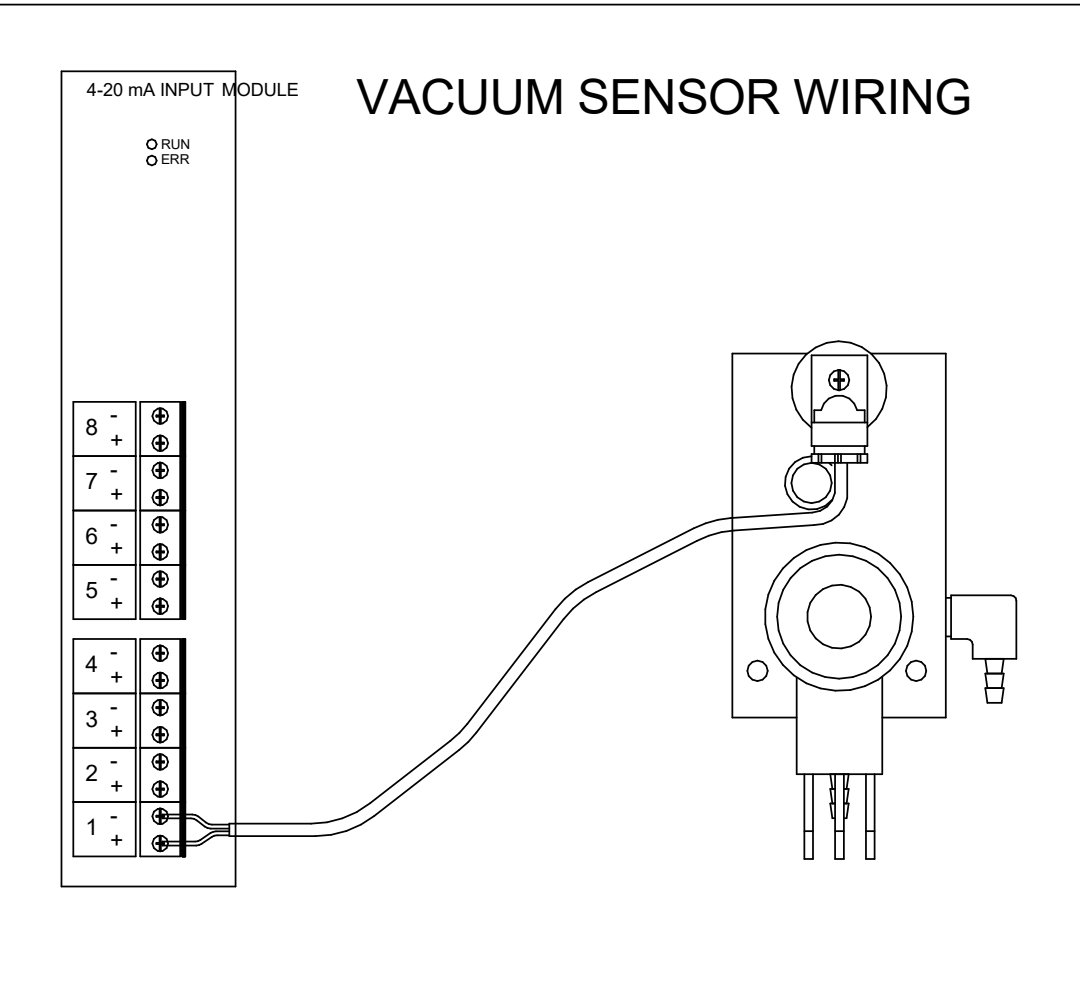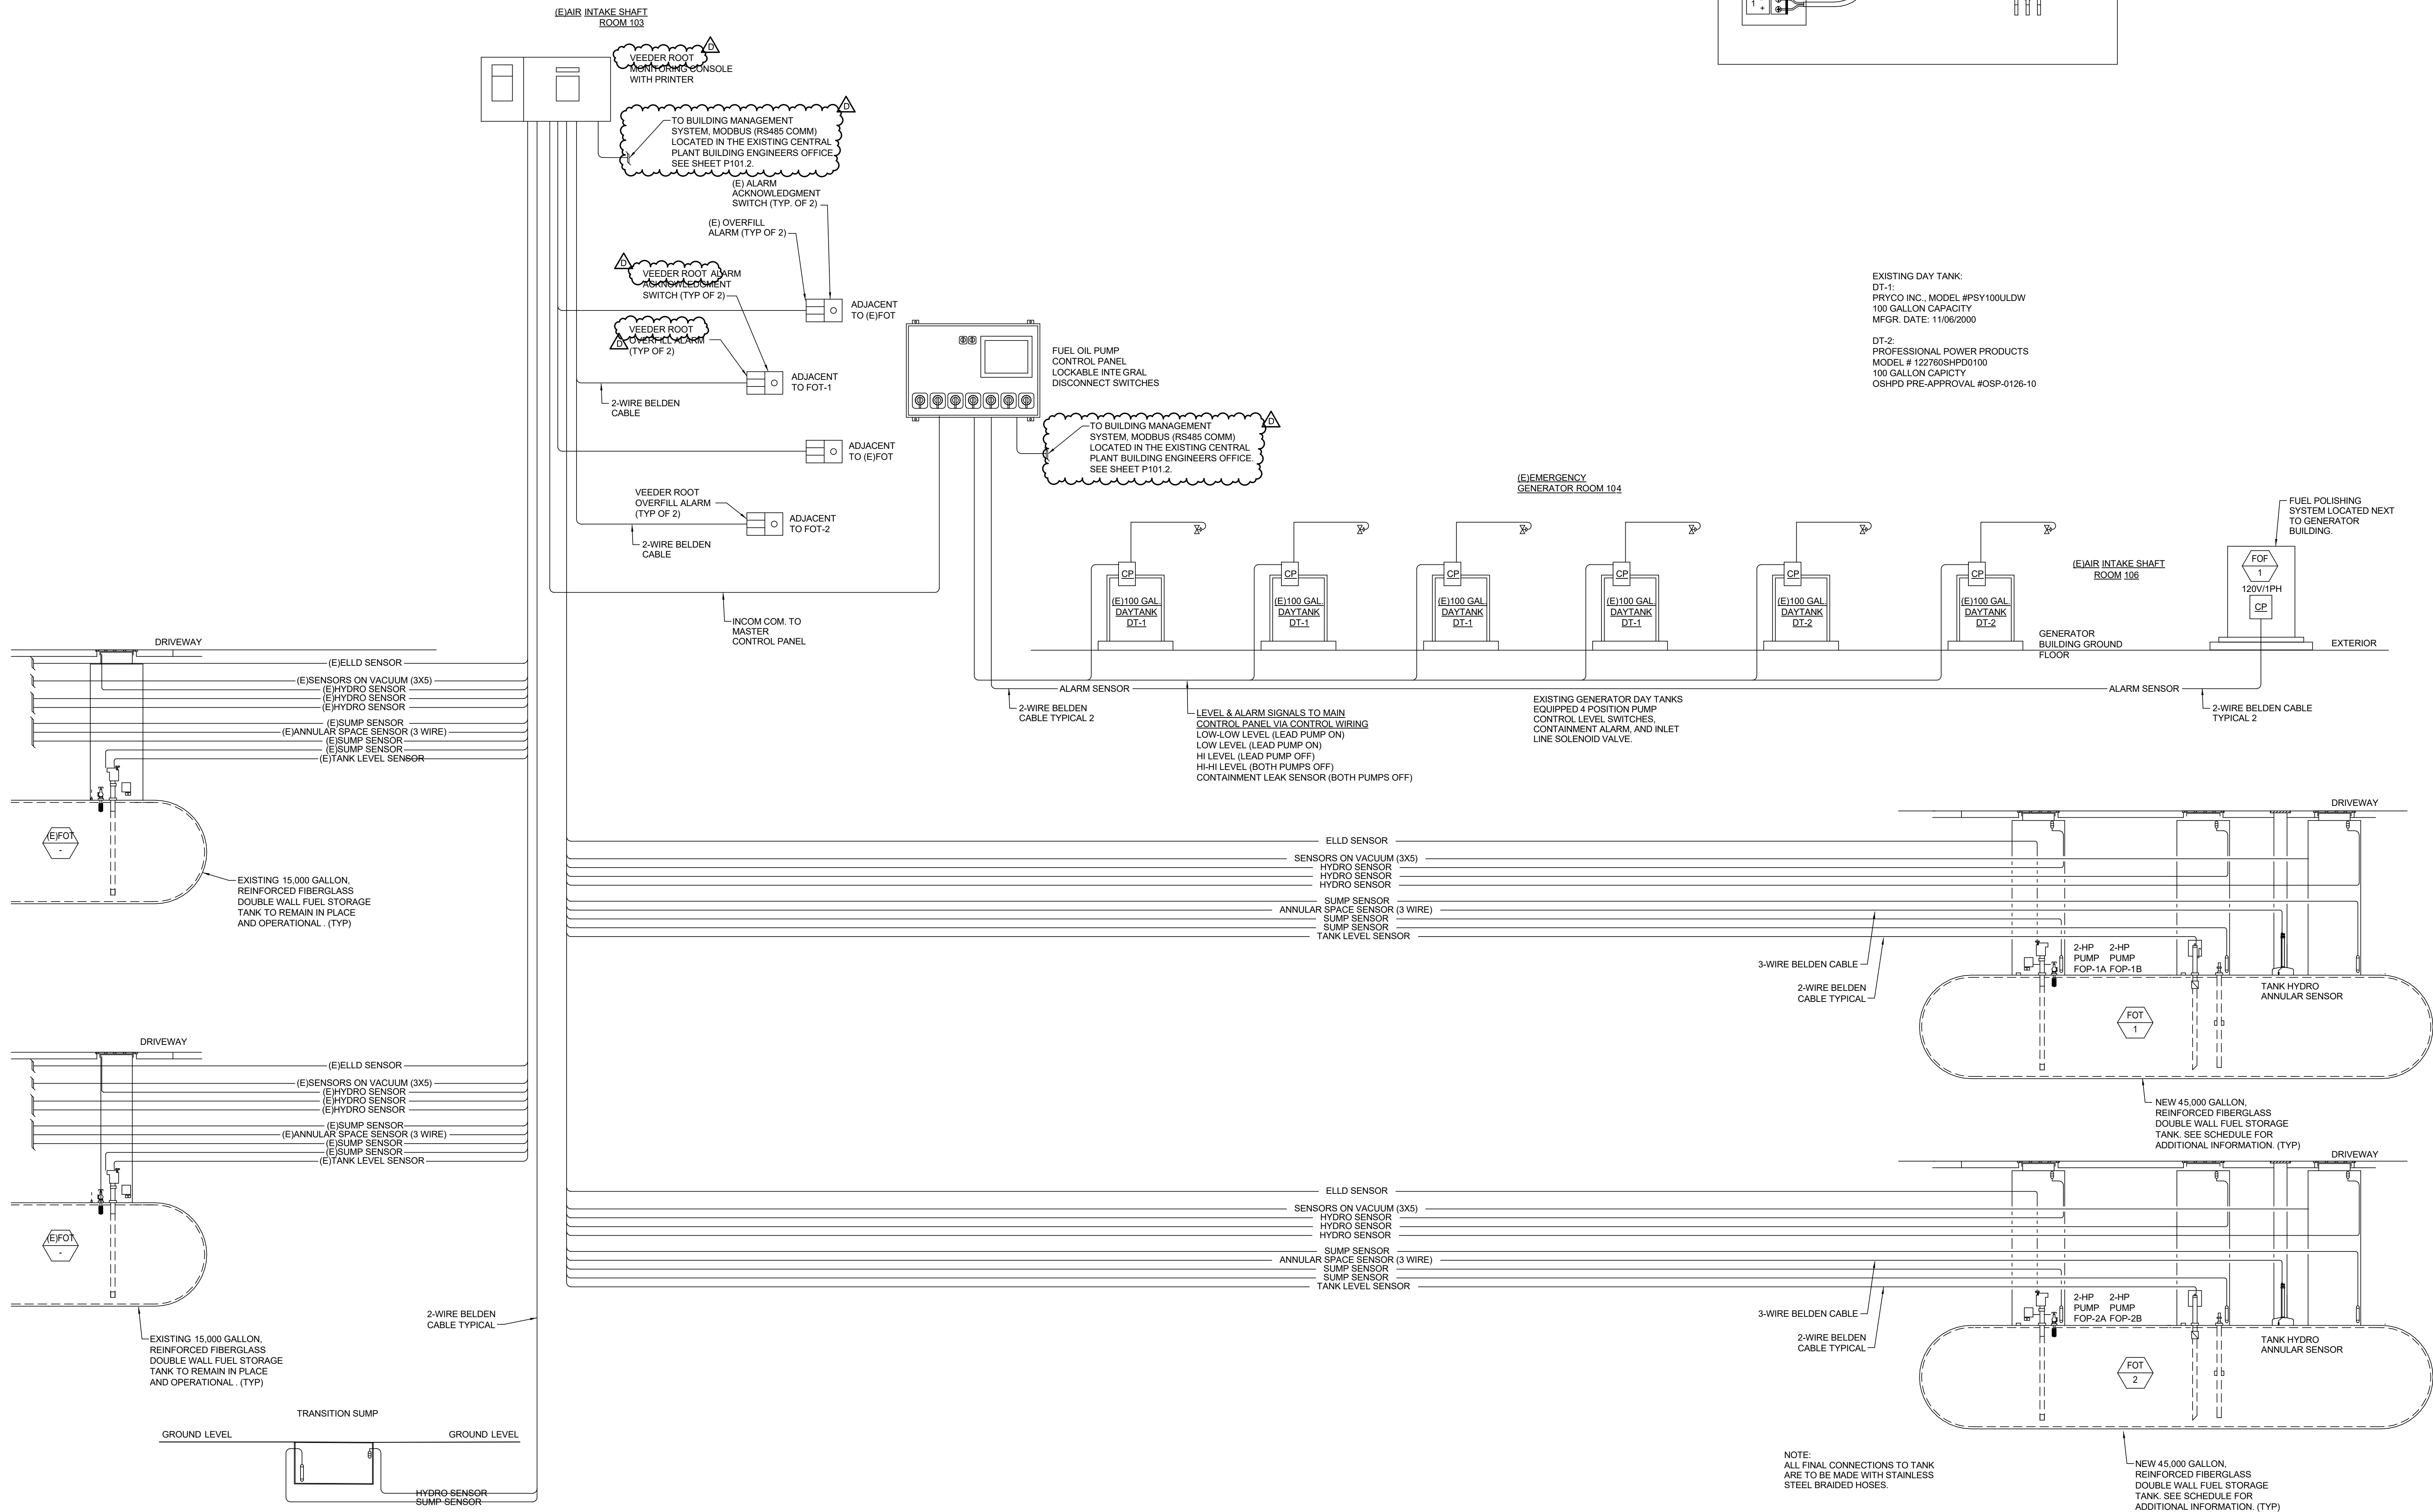

EXISTING DAY TANK:
DT-1:
PRYCO INC., MODEL #PSY100ULDW
100 GALLON CAPACITY
MFR. DATE: 11/06/2000
DT-2:
PROFESSIONAL POWER PRODUCTS
MODEL # 122760SHPD0100
100 GALLON CAPACITY
OSHPD PRE-APPROVAL #OSP-0126-10

FUEL POLISHING
SYSTEM LOCATED NEXT
TO GENERATOR
BUILDING.




RBB ARCHITECTS INC

Joseph A. Balbons, AIA
Sylvia Botero, AIA
Kevin S. Boots, AIA

10980 Wilshire Boulevard
Los Angeles, California
90024-3905

Telephone 310 473 3555
Facsimile 310 473 3555
www.rbbinc.com

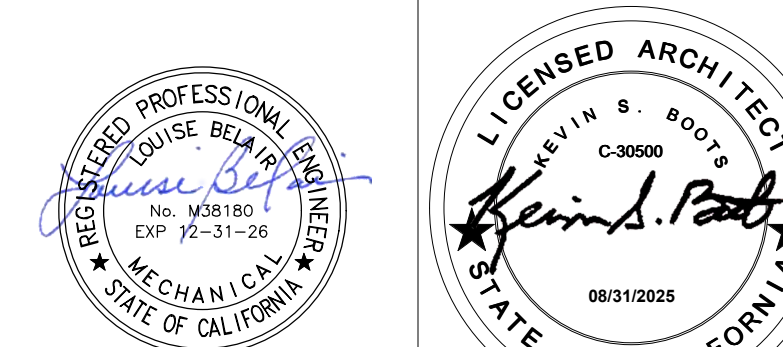

AGENCY APPROVALS

OSHPD # 1240005-19-02

CONSULTANT

tklsc
COLLABORATIVE

515 South Figueroa Street, Suite 1400
Los Angeles, California 90071
213.507.8400 www.tklsc.com
Project Leader - Michael Huynh
Plumbing Lead - Ron Brick
tklsc Job #2017-0456-035

ISSUE RECORD

04/09/2025	D	ADDENDUM D
02/10/2025		BID SET
01/31/2025	BC2	HCAI BACKCHECK 2
10/25/2024	BC1	HCAI BACKCHECK 1
06/13/2024		HCAI SUBMITTAL
DATE	△	DESCRIPTION

Harbor-UCLA
MEDICAL CENTER
HARBOR-UCLA MEDICAL CENTER

PHASE 2E INC2 - GENERATOR
BUILDING RETROFIT

1000 West Carson Street, Torrance, CA 90502

MILESTONE: HCAI SUBMITTAL

MILESTONE DATE: 6/13/2024




RBB PROJECT: 1712076 SCALE: 12" = 1'-0"

DESCRIPTION
CONTROLS AND MONITORING
DIAGRAM - LOW VOLTAGE
WIRING

P304.2

CONTROLS AND MONITORING DIAGRAM - LOW VOLTAGE WIRING

SCALE
NONE
1

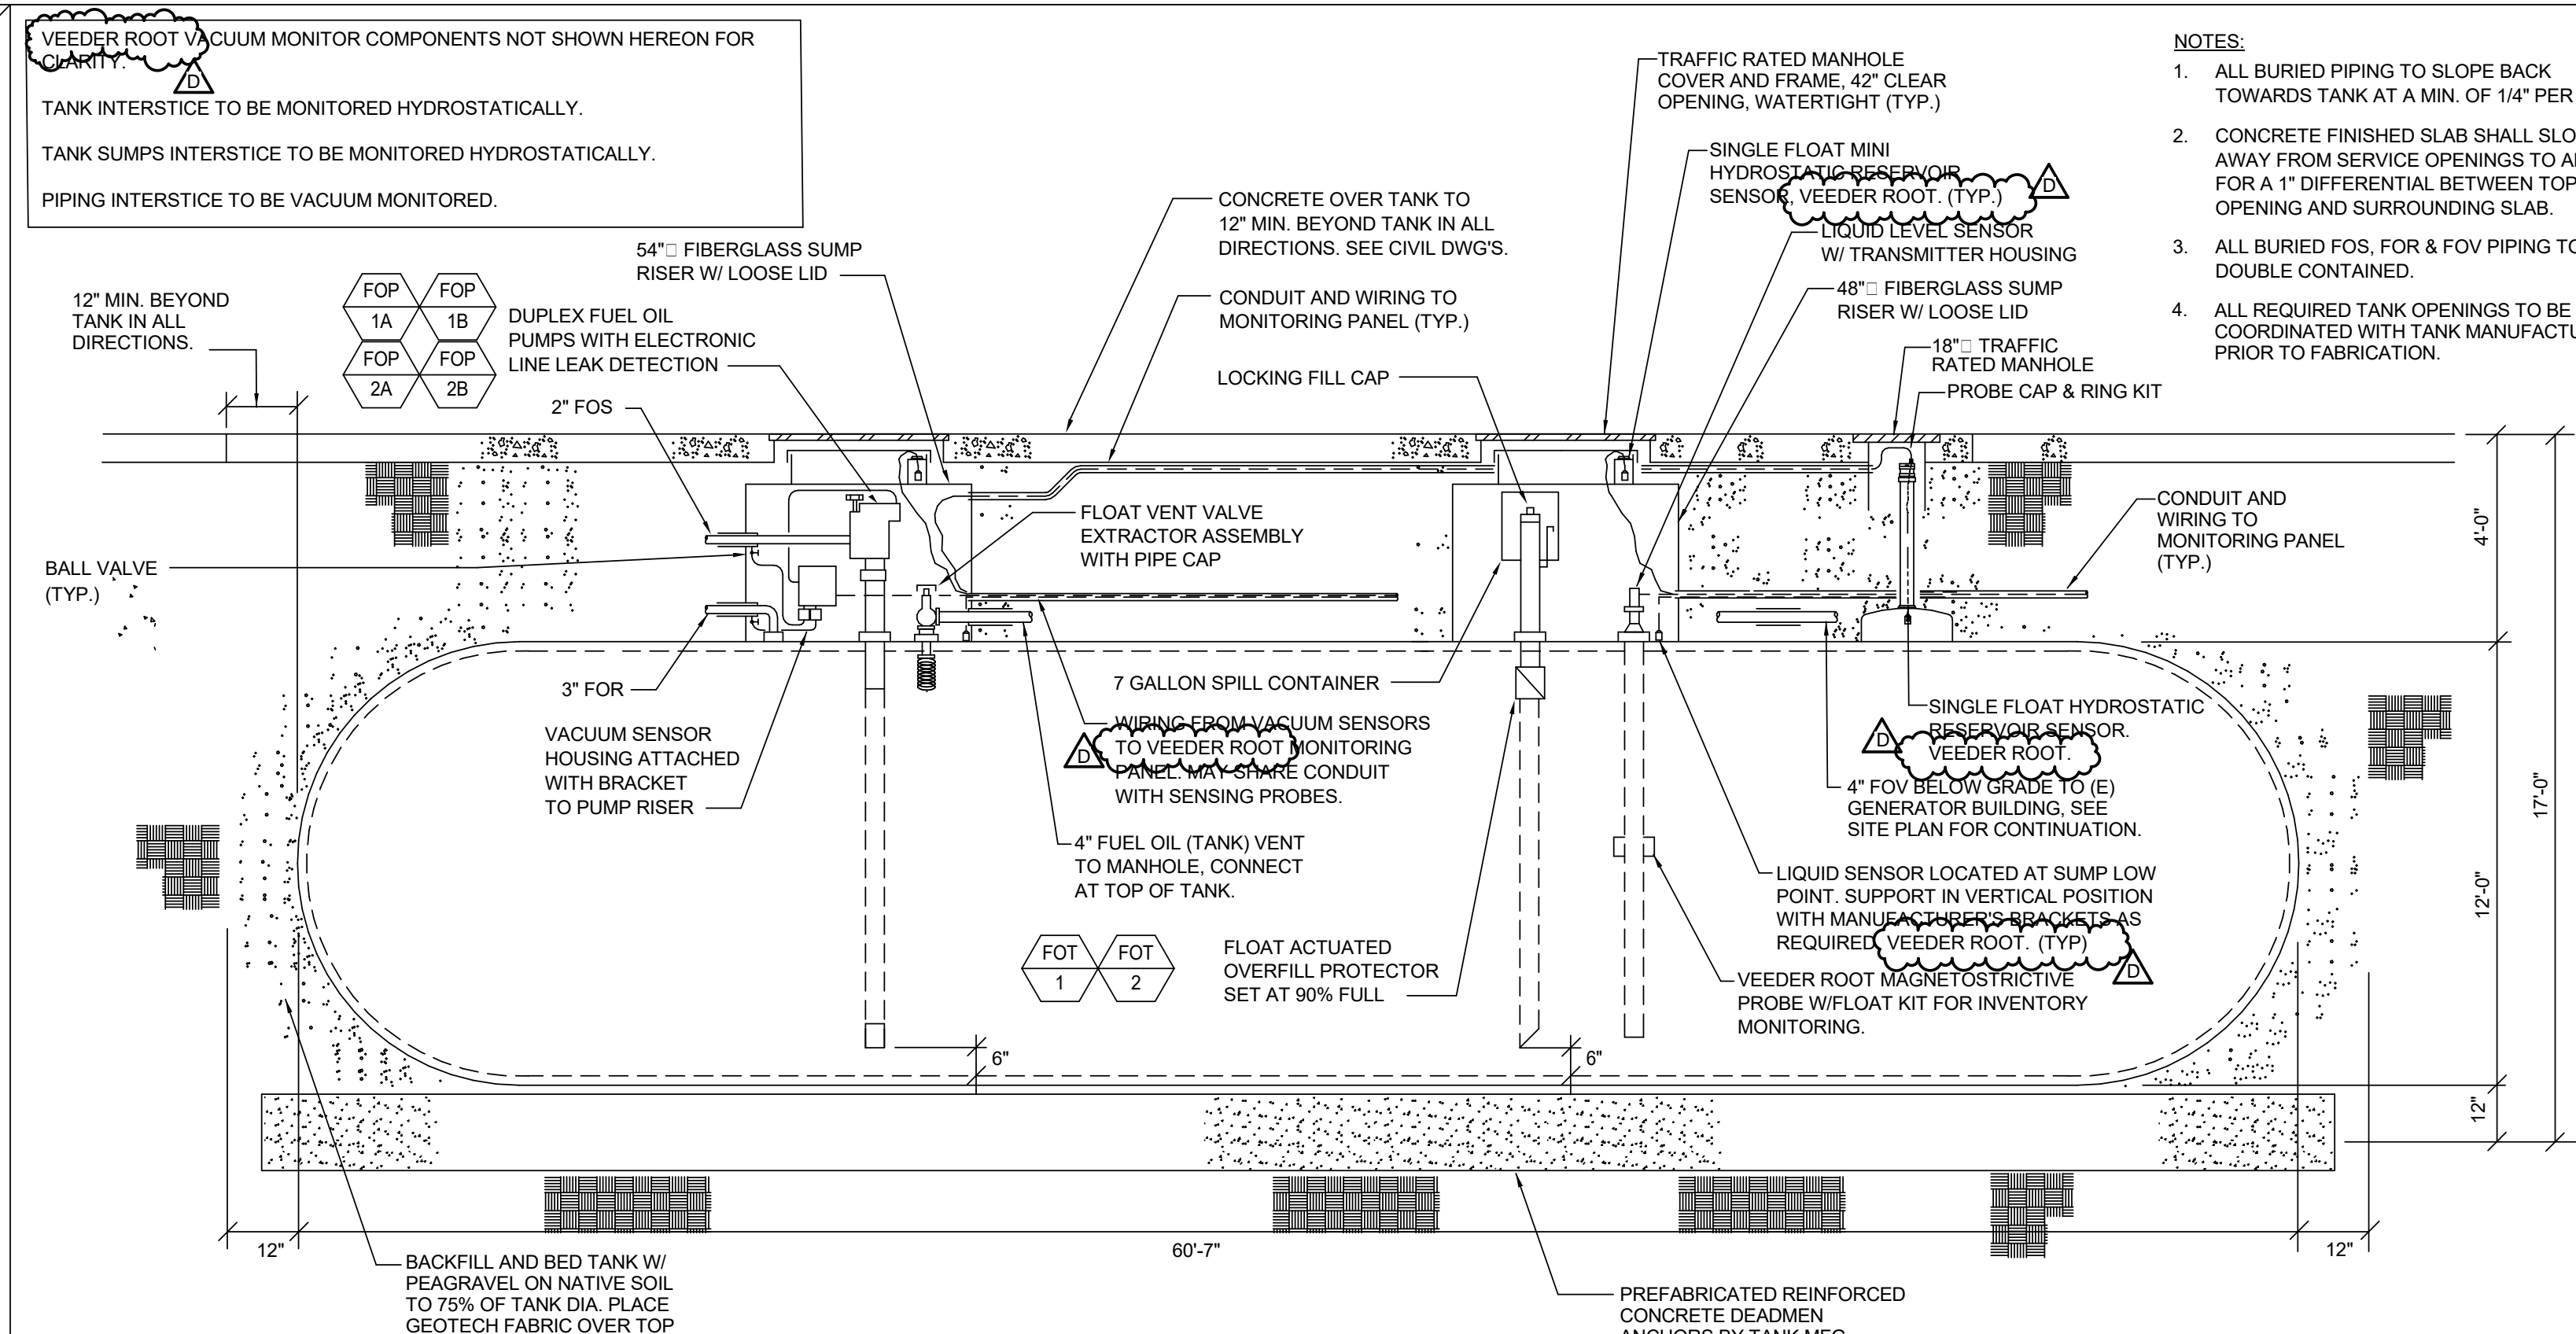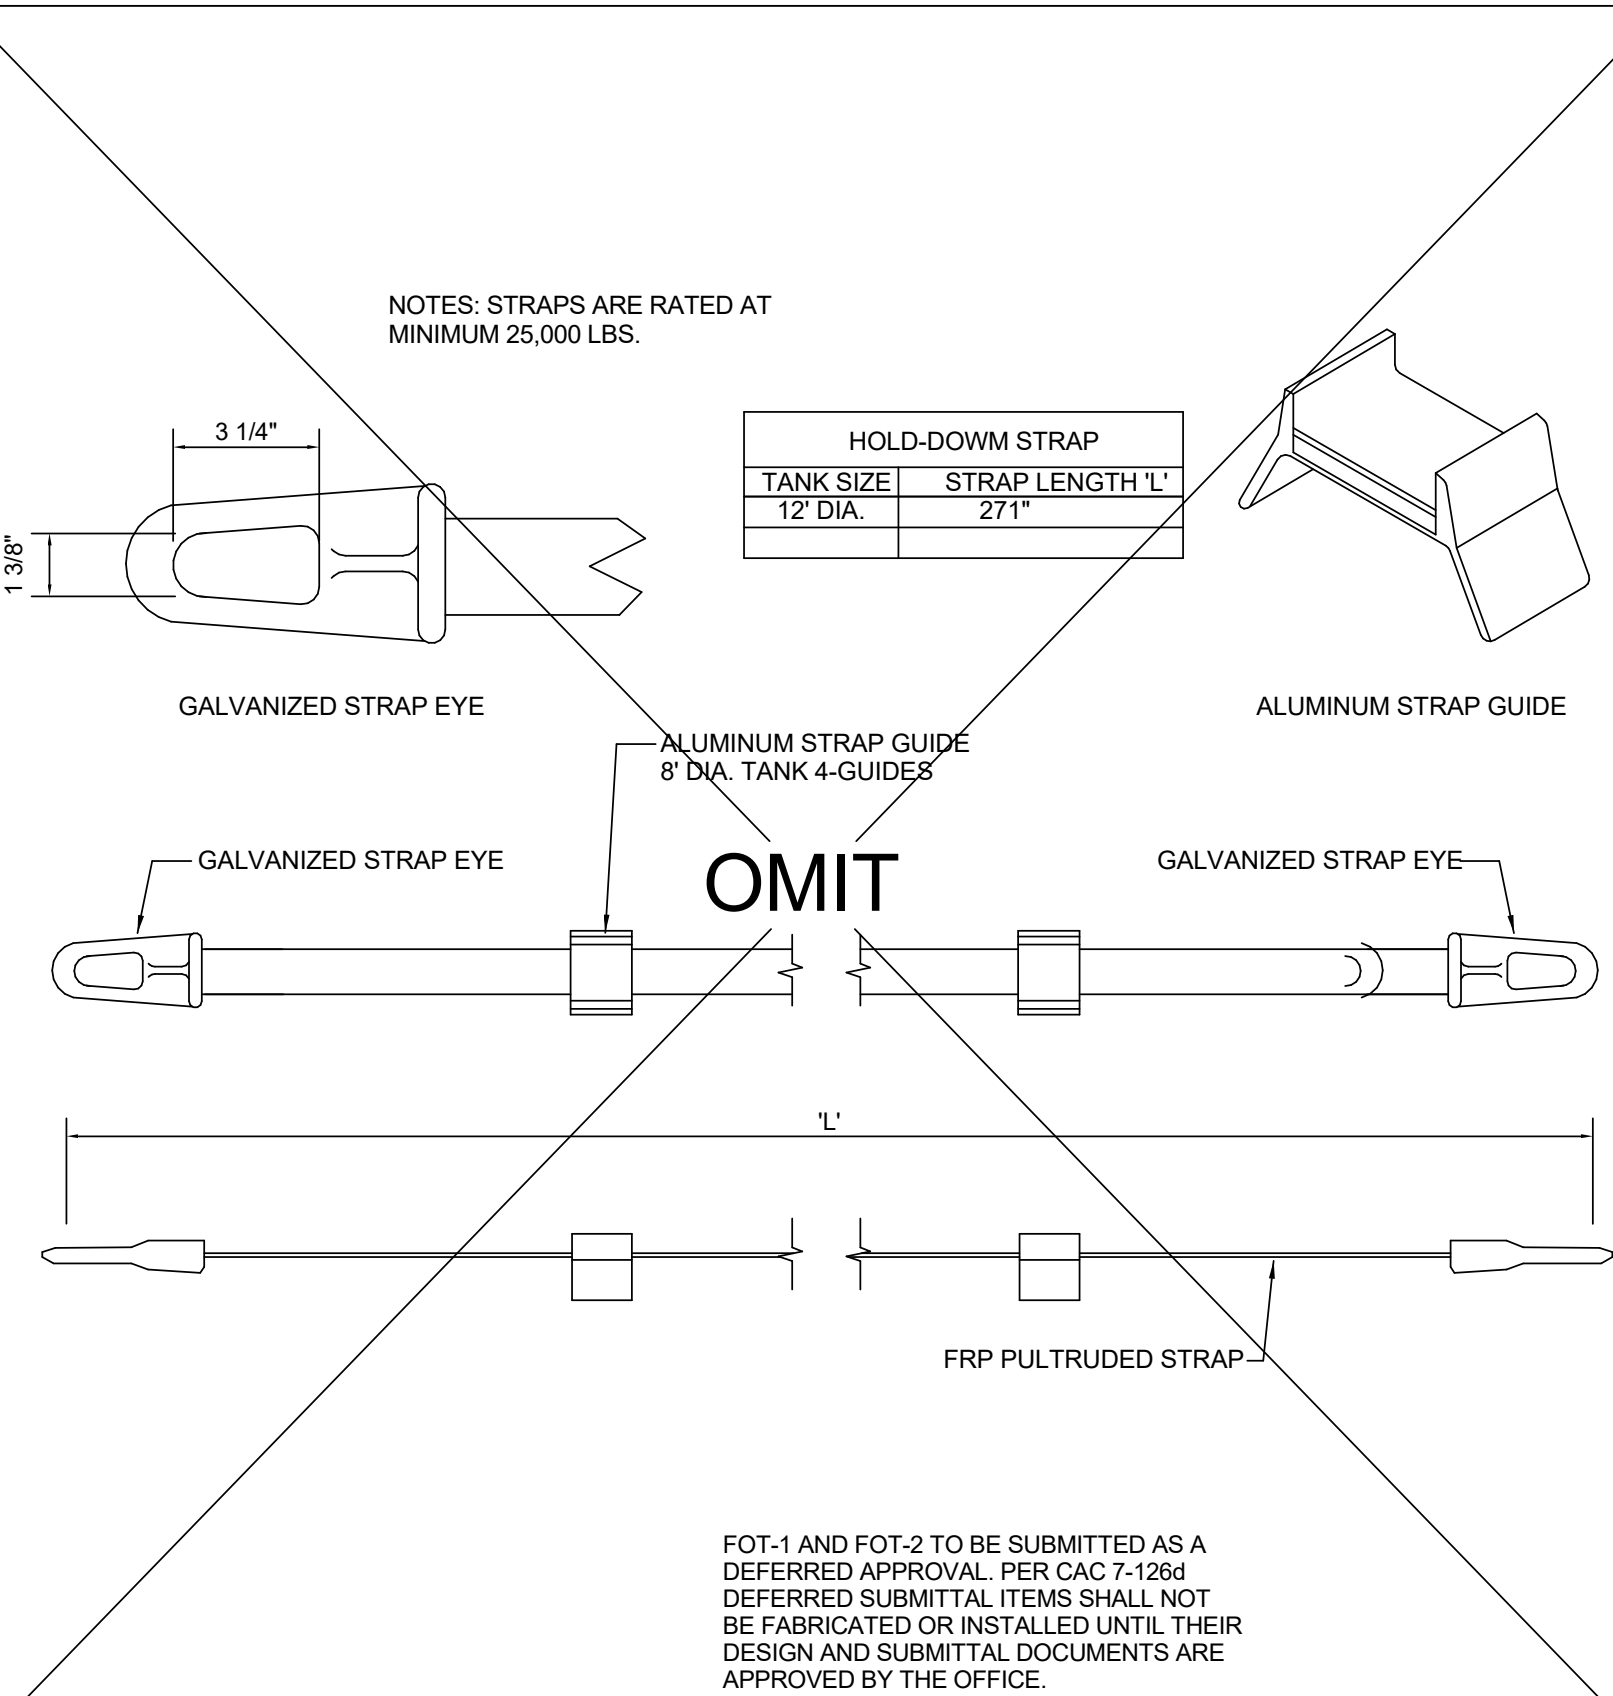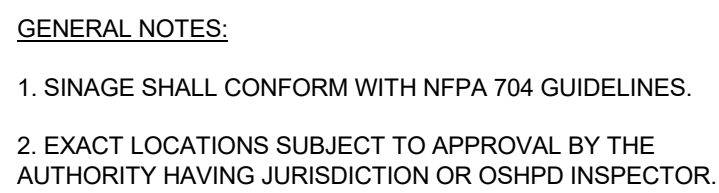

NOTES:


1. ALL BURIED PIPING TO SLOPE BACK TOWARDS TANK AT A MIN. OF 1/4" PER FT.
2. CONCRETE FINISHED SLAB SHALL SLOPE AWAY FROM SERVICE OPENINGS TO ALLOW FOR A 1" DIFFERENTIAL BETWEEN TOP OF OPENING AND SURROUNDING SLAB.
3. ALL BURIED FOS, FOR & FOV PIPING TO BE DOUBLE CONTAINED.
4. ALL REQUIRED TANK OPENINGS TO BE COORDINATED WITH TANK MANUFACTURER PRIOR TO FABRICATION.










Joseph A. Balbona, AIA
Sylvia Botero, AIA
Kevin S. Boots, AIA

10980 Wilshire Boulevard
Los Angeles, California
90024-3905

Telephone 310 473 3555
Facsimile 310 473 3555
www.rbbinc.com

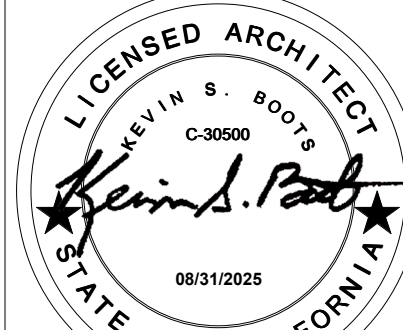

AGENCY APPROVALS

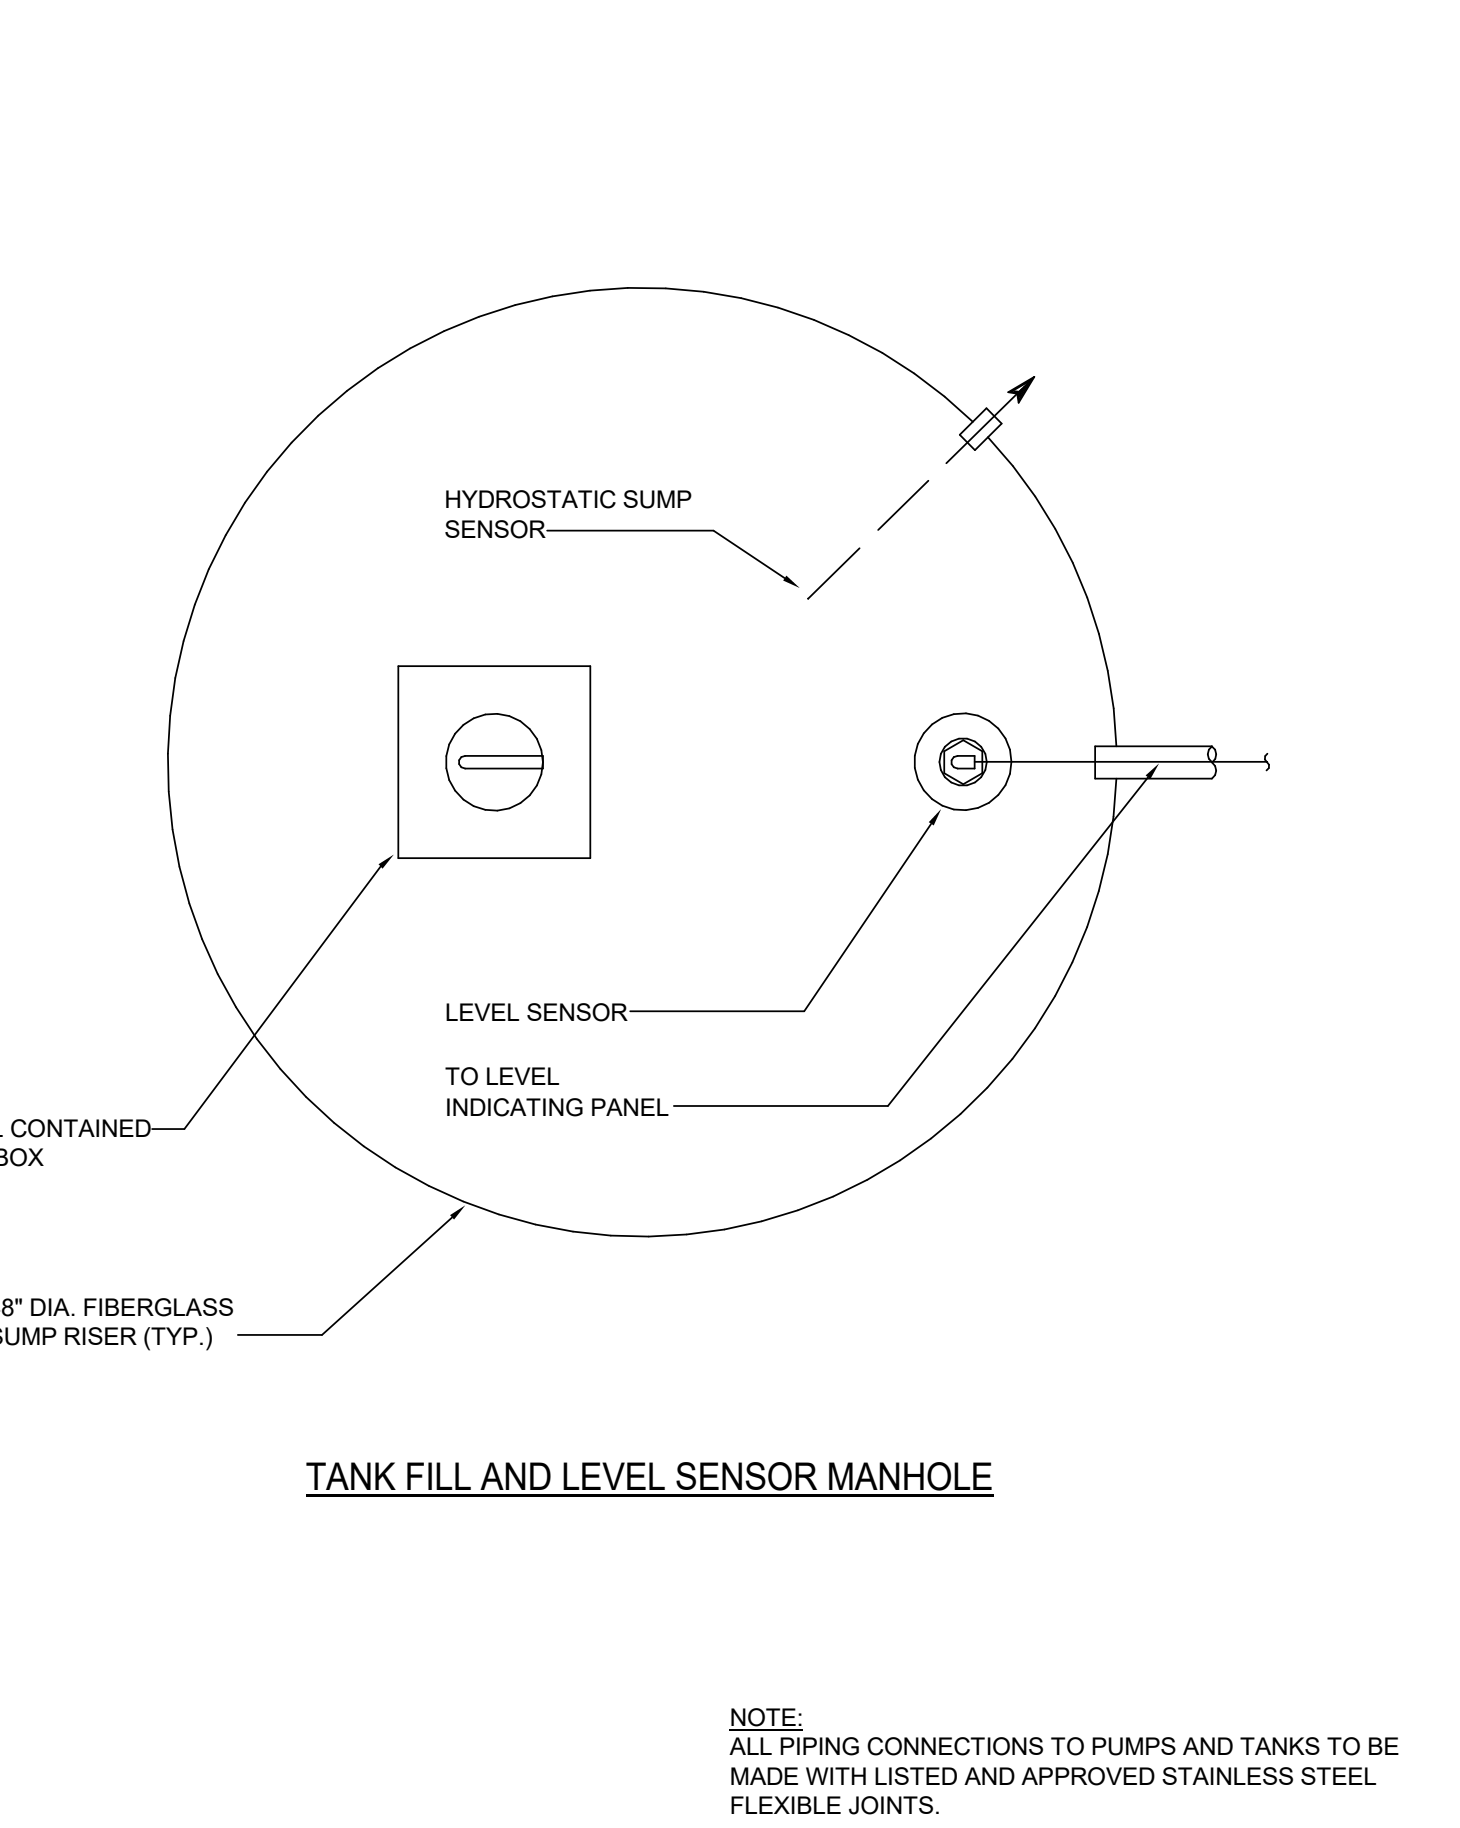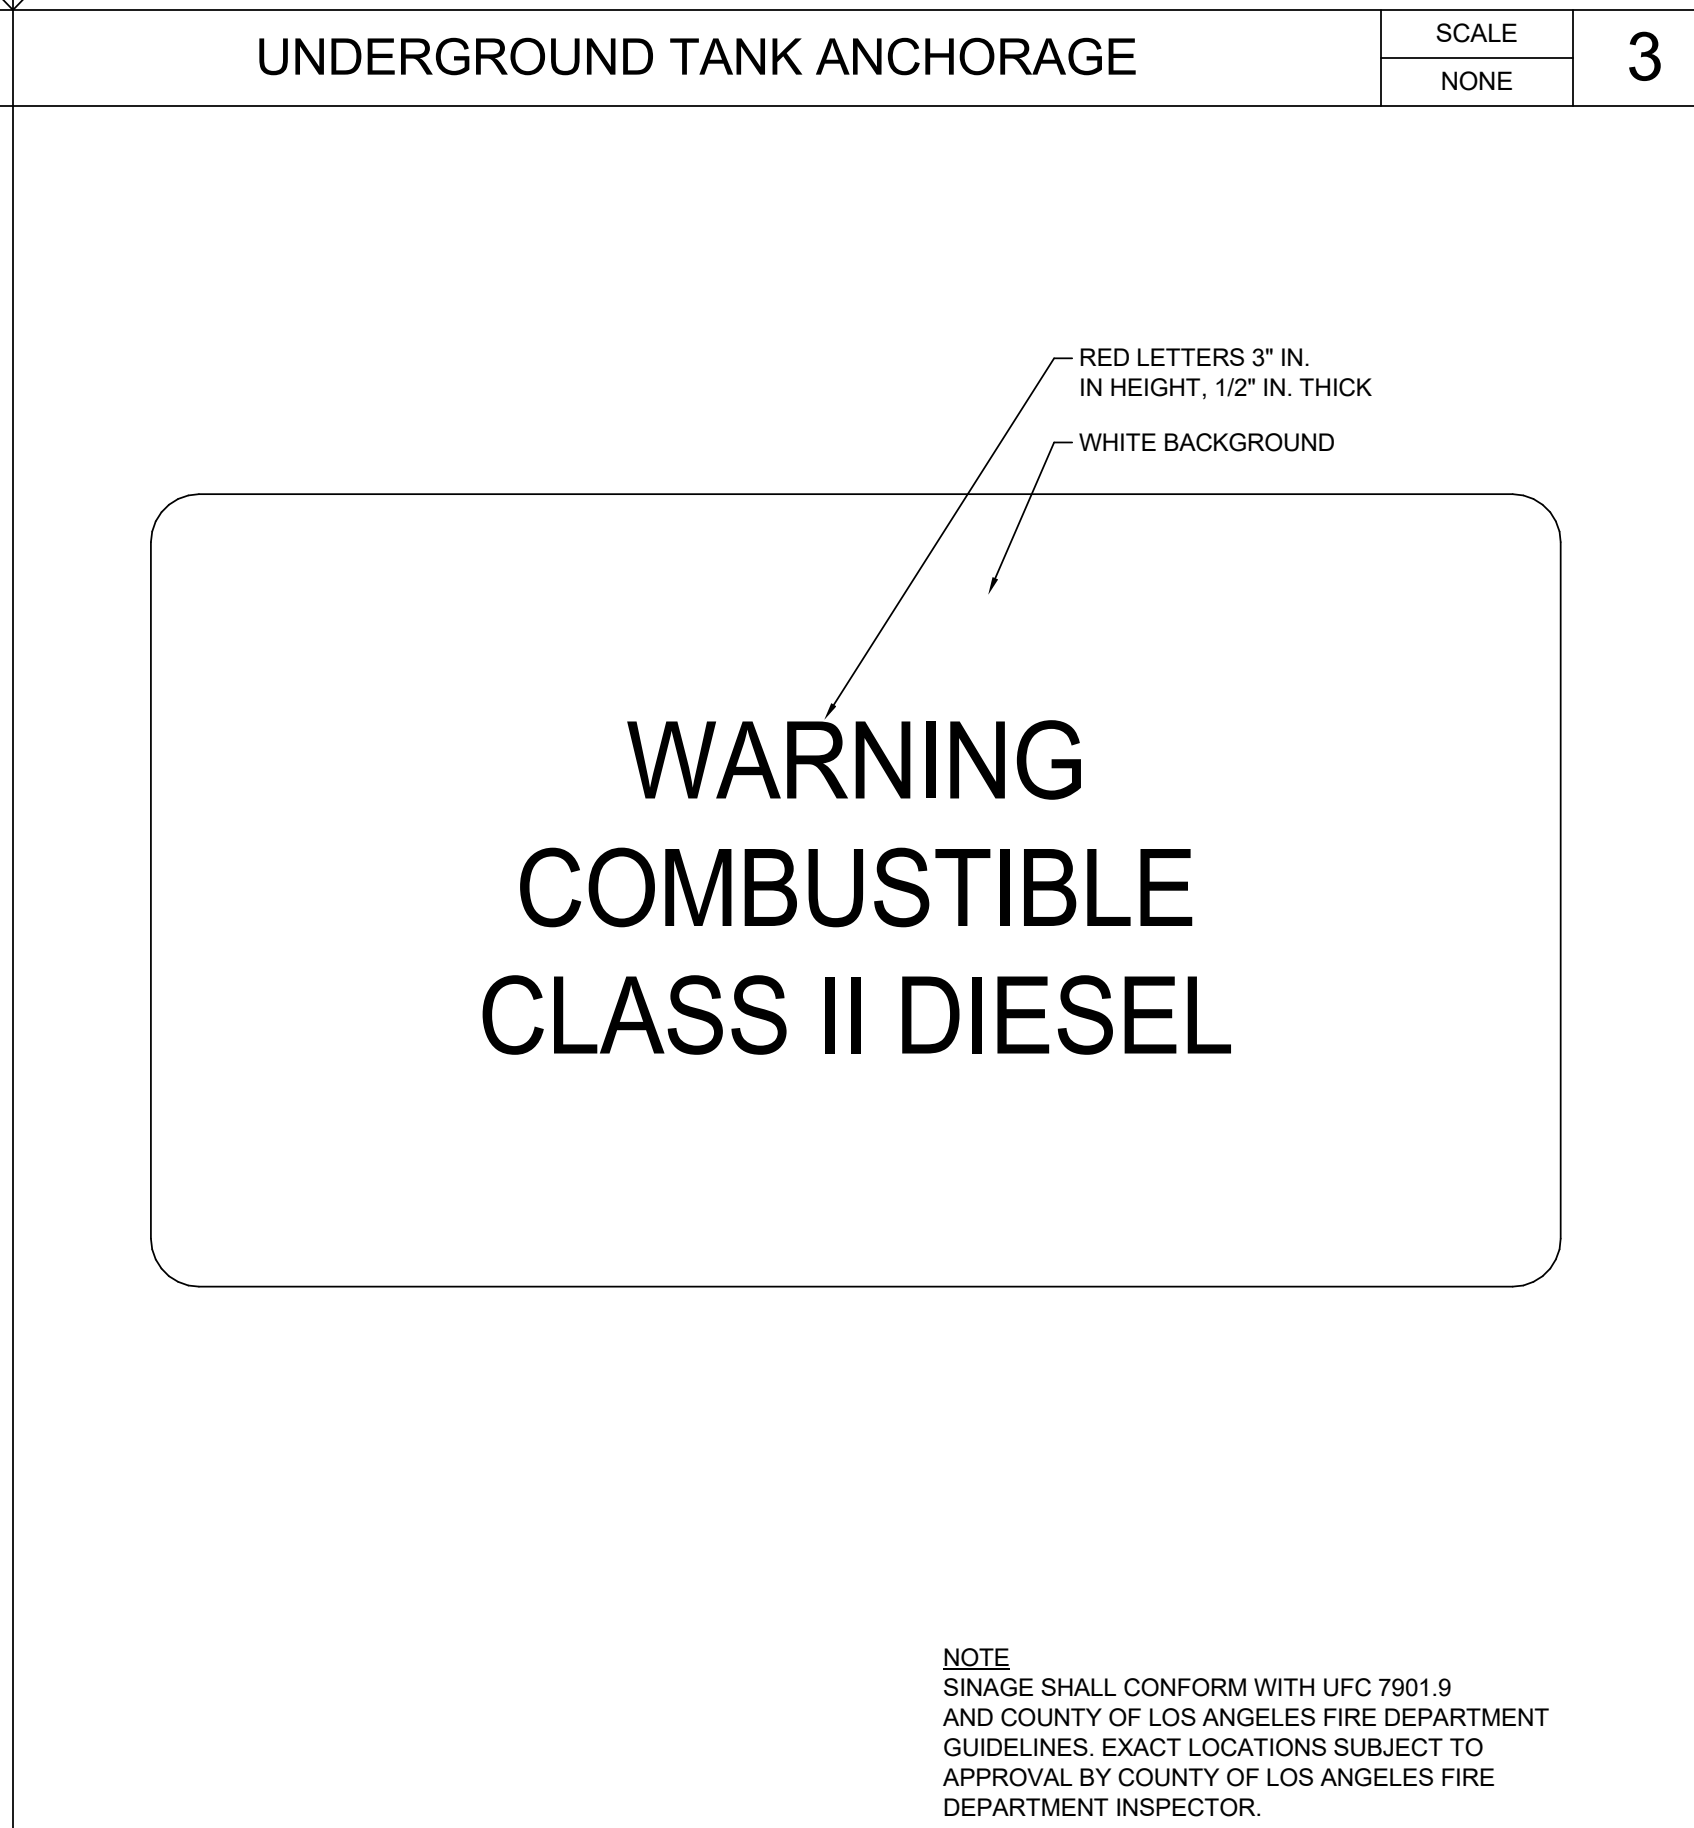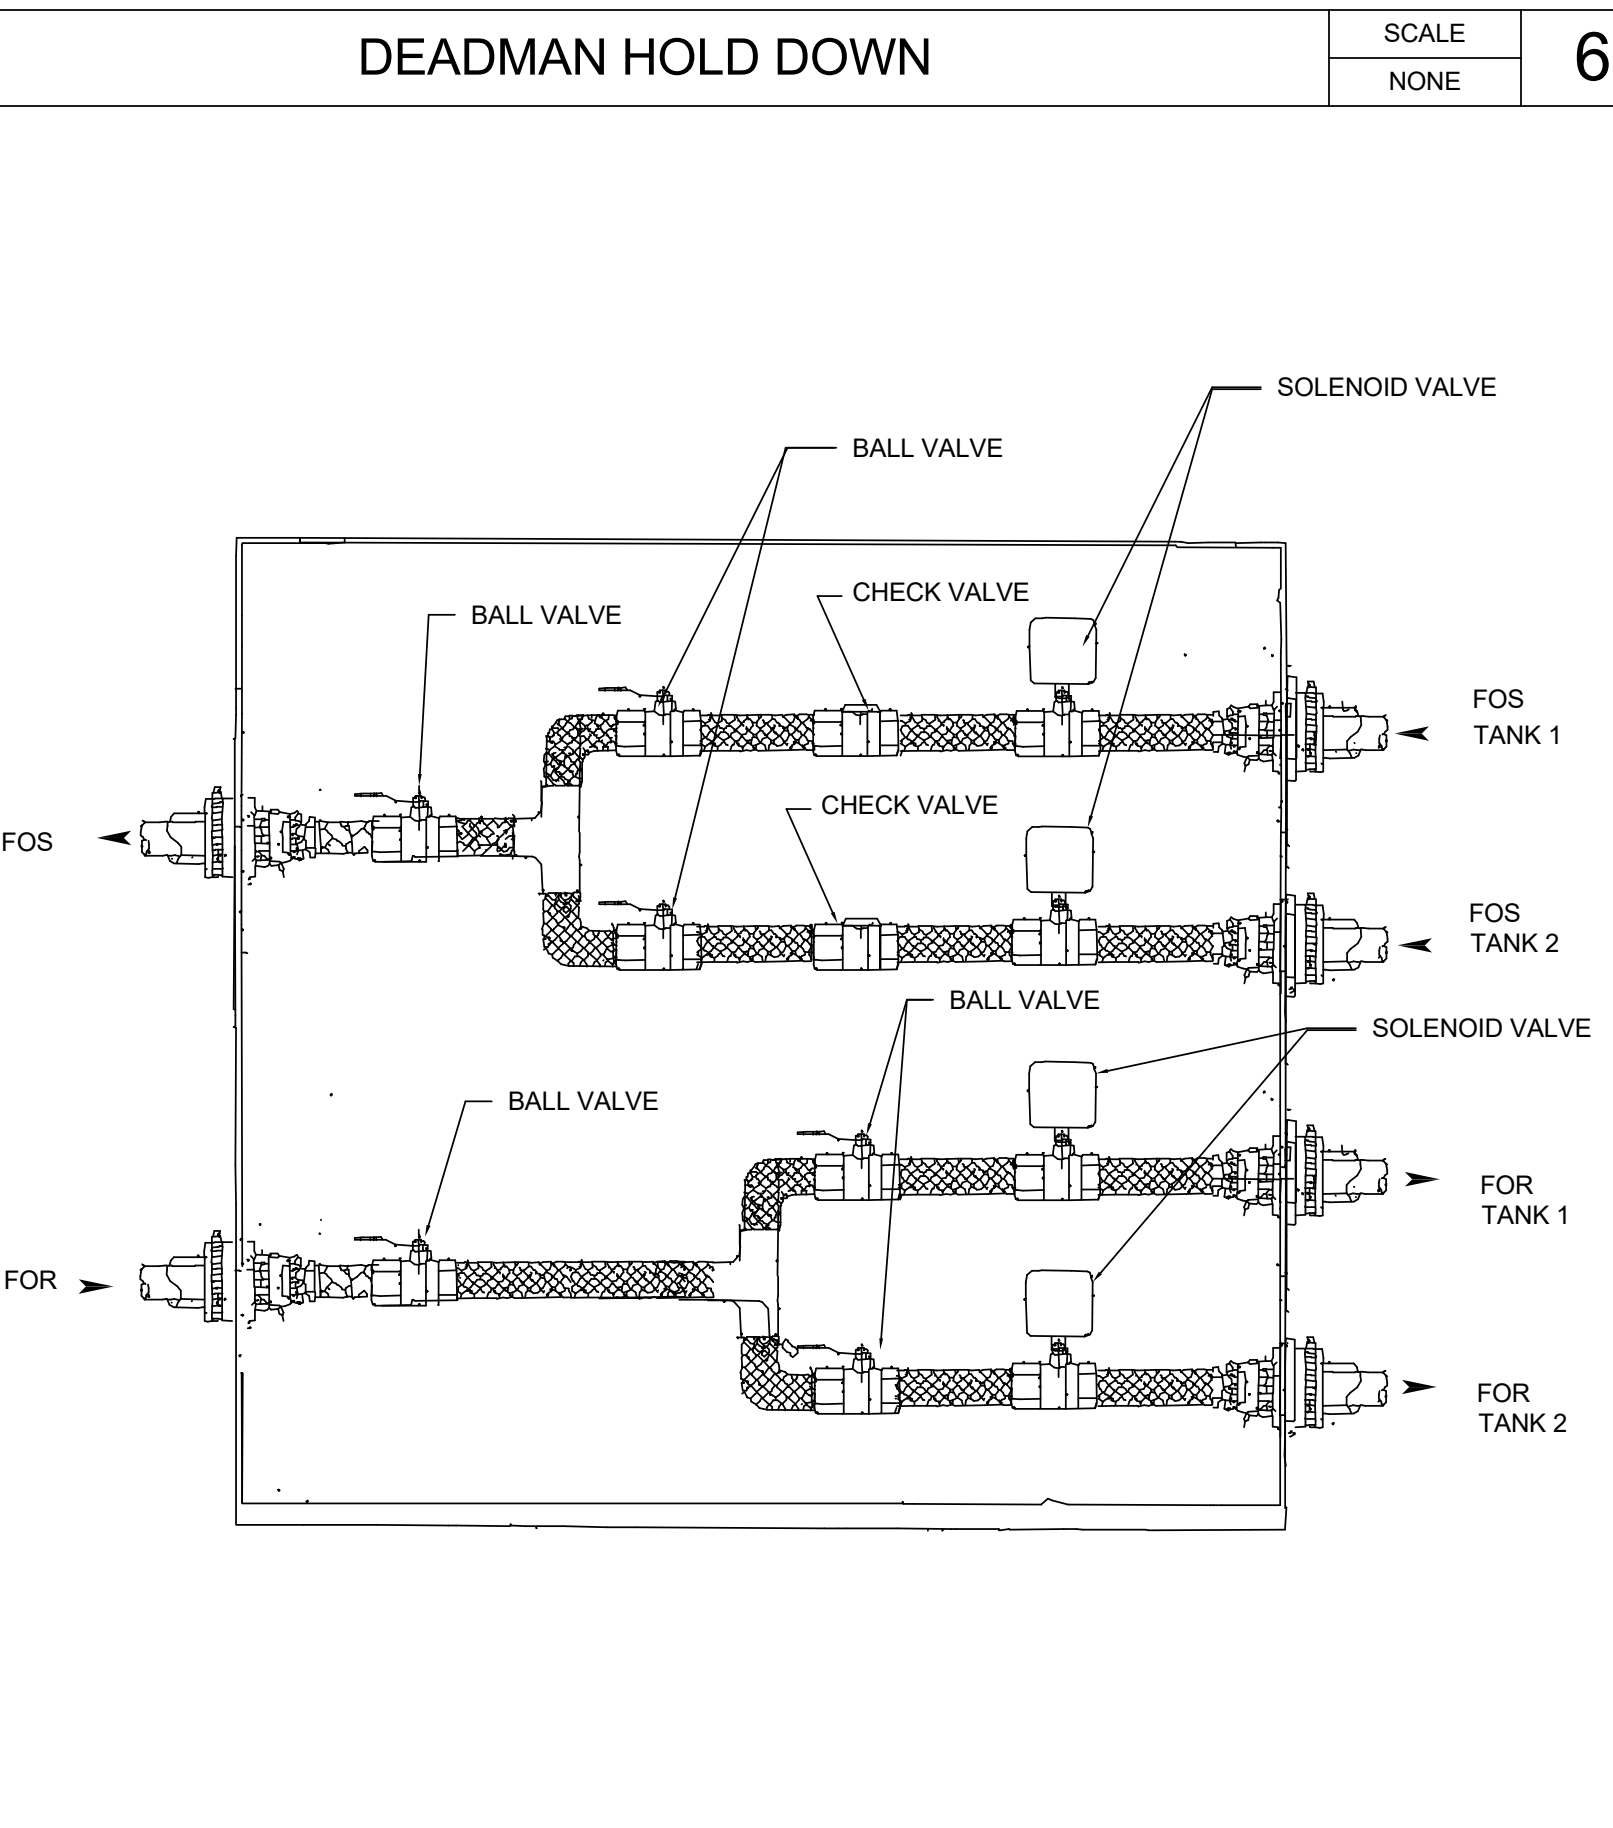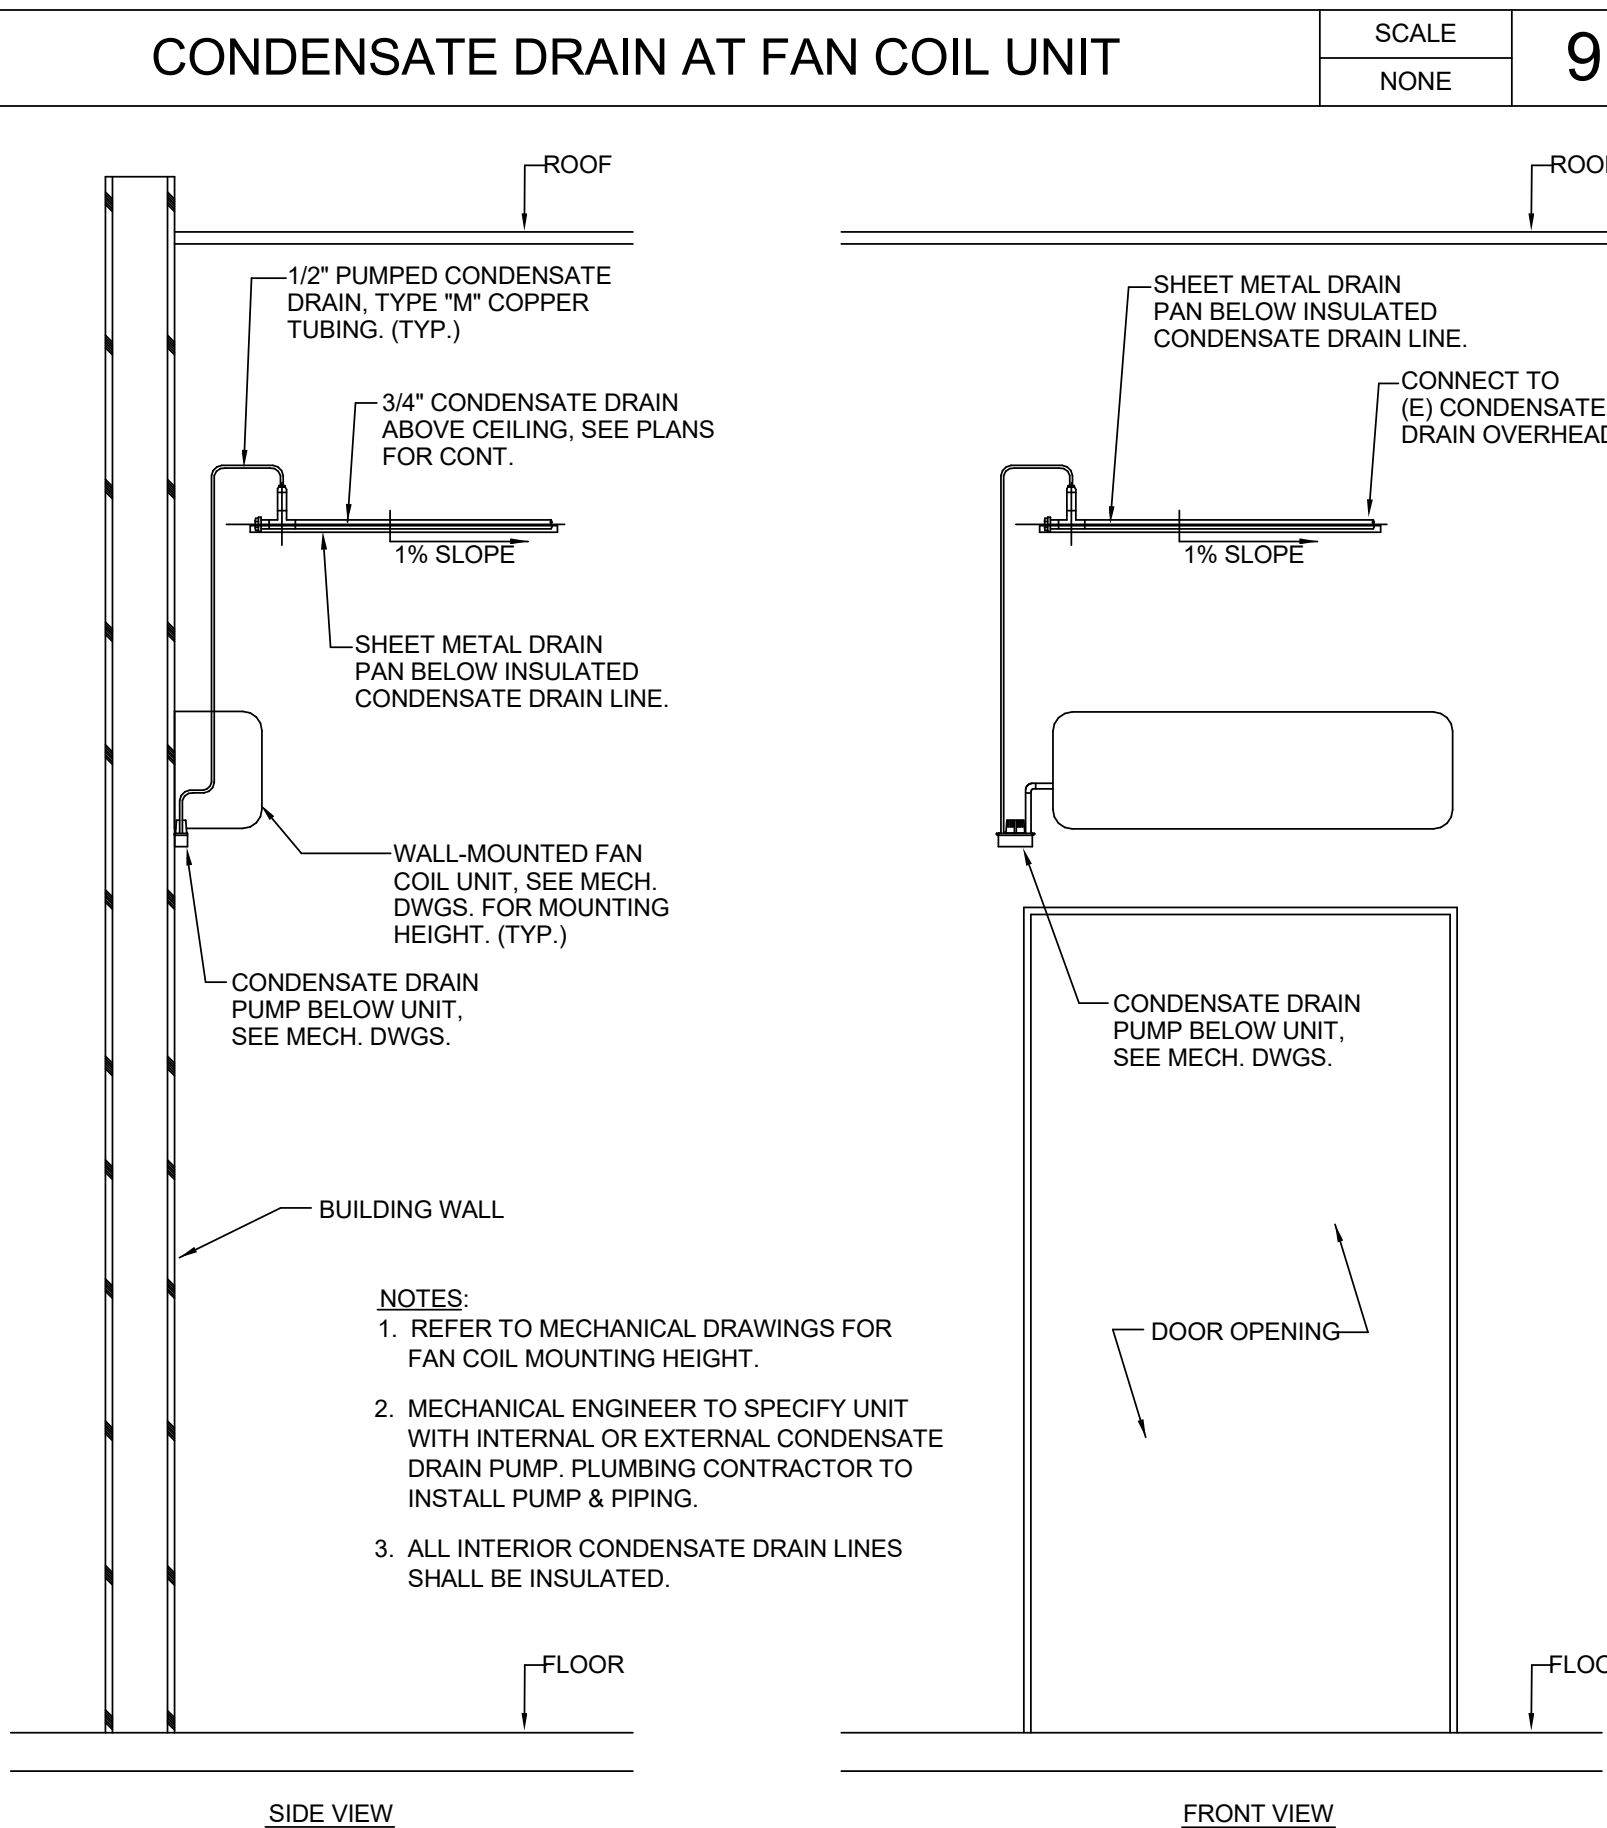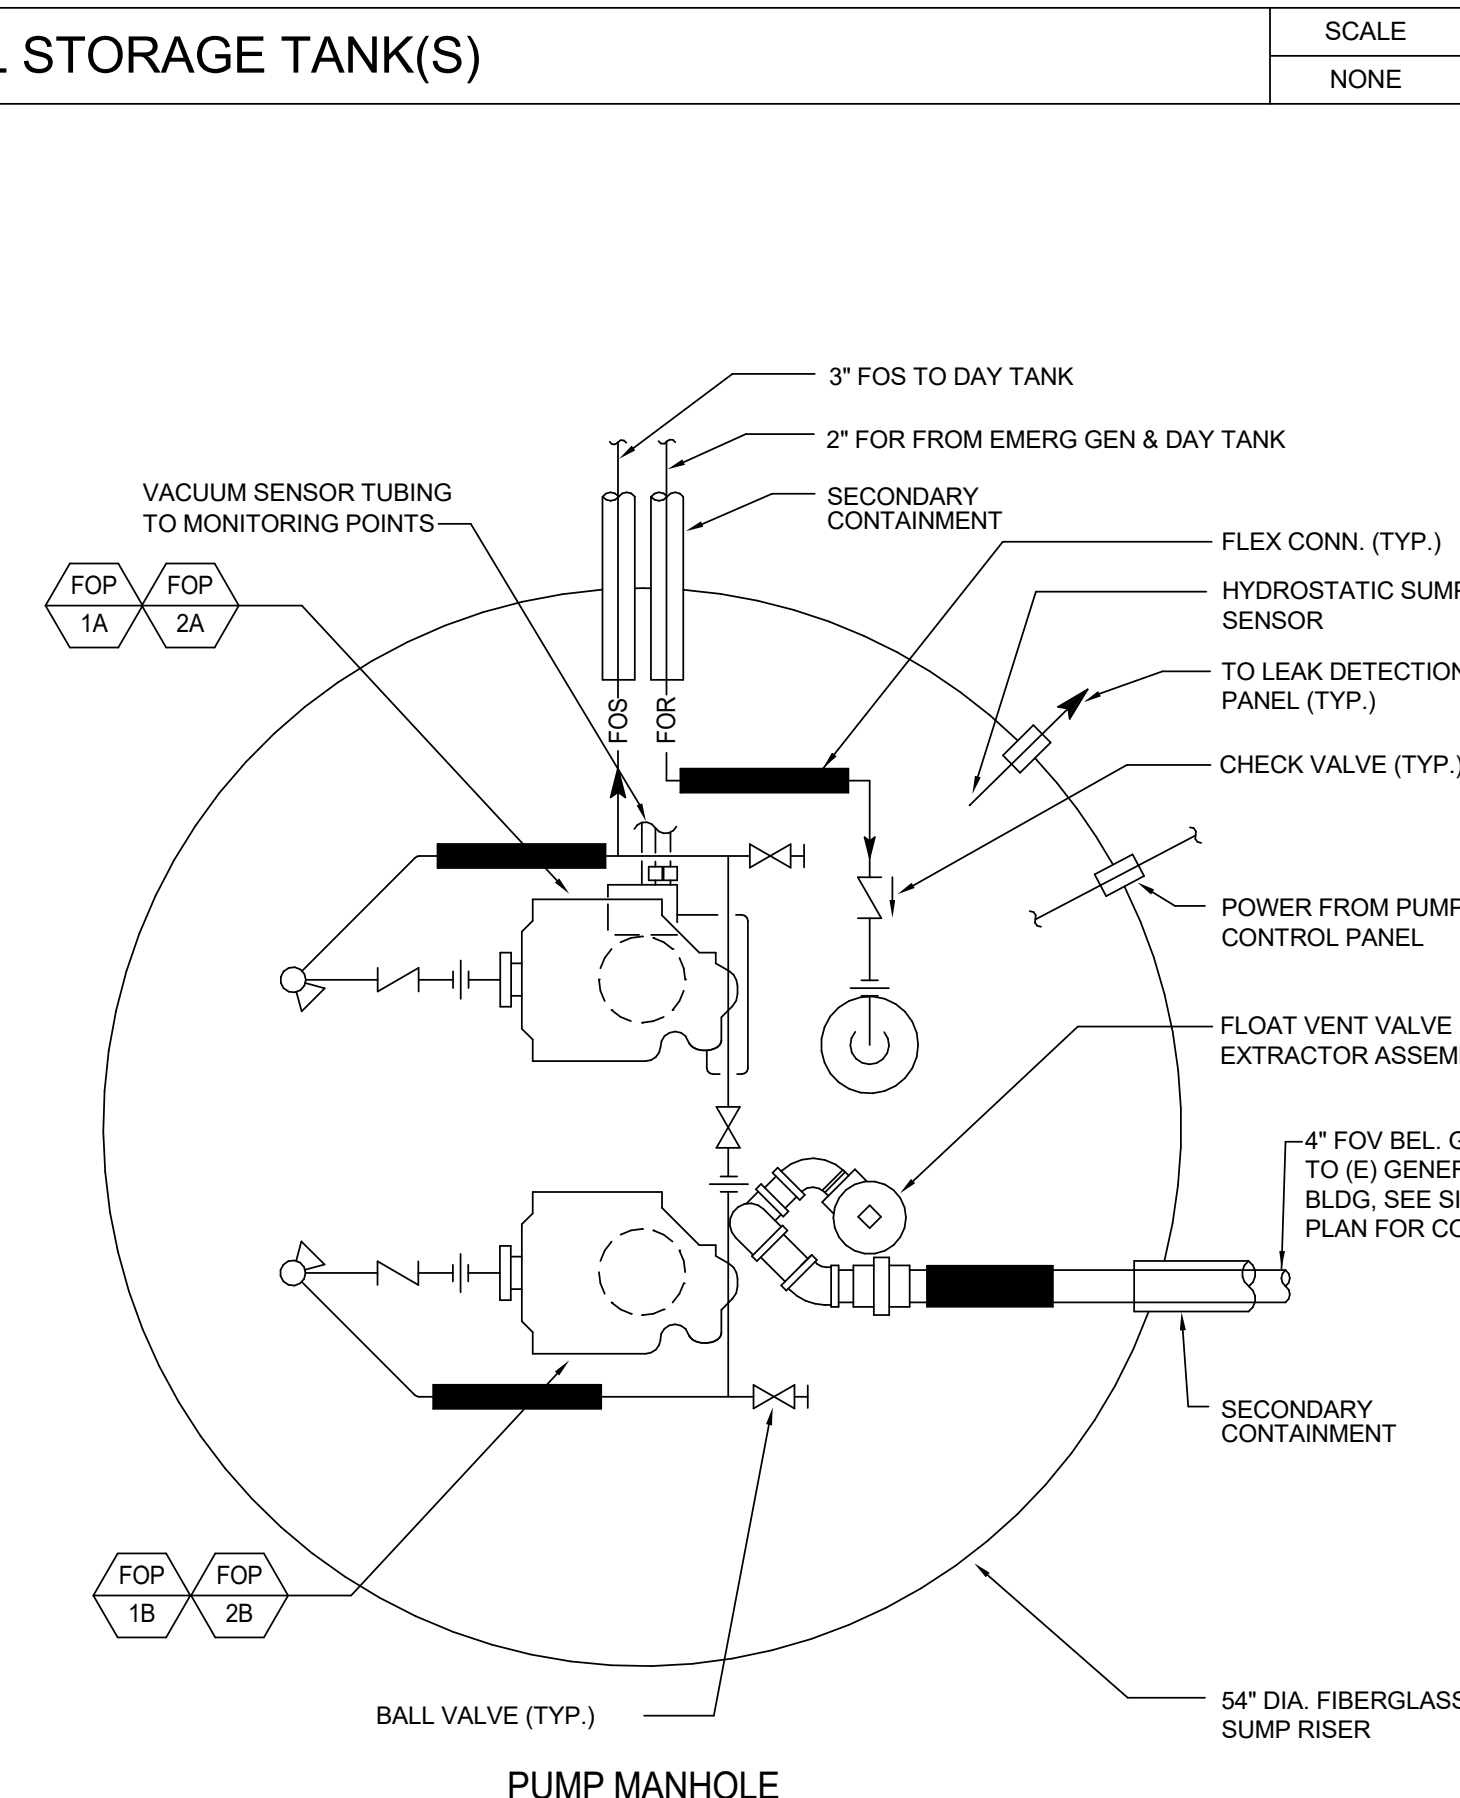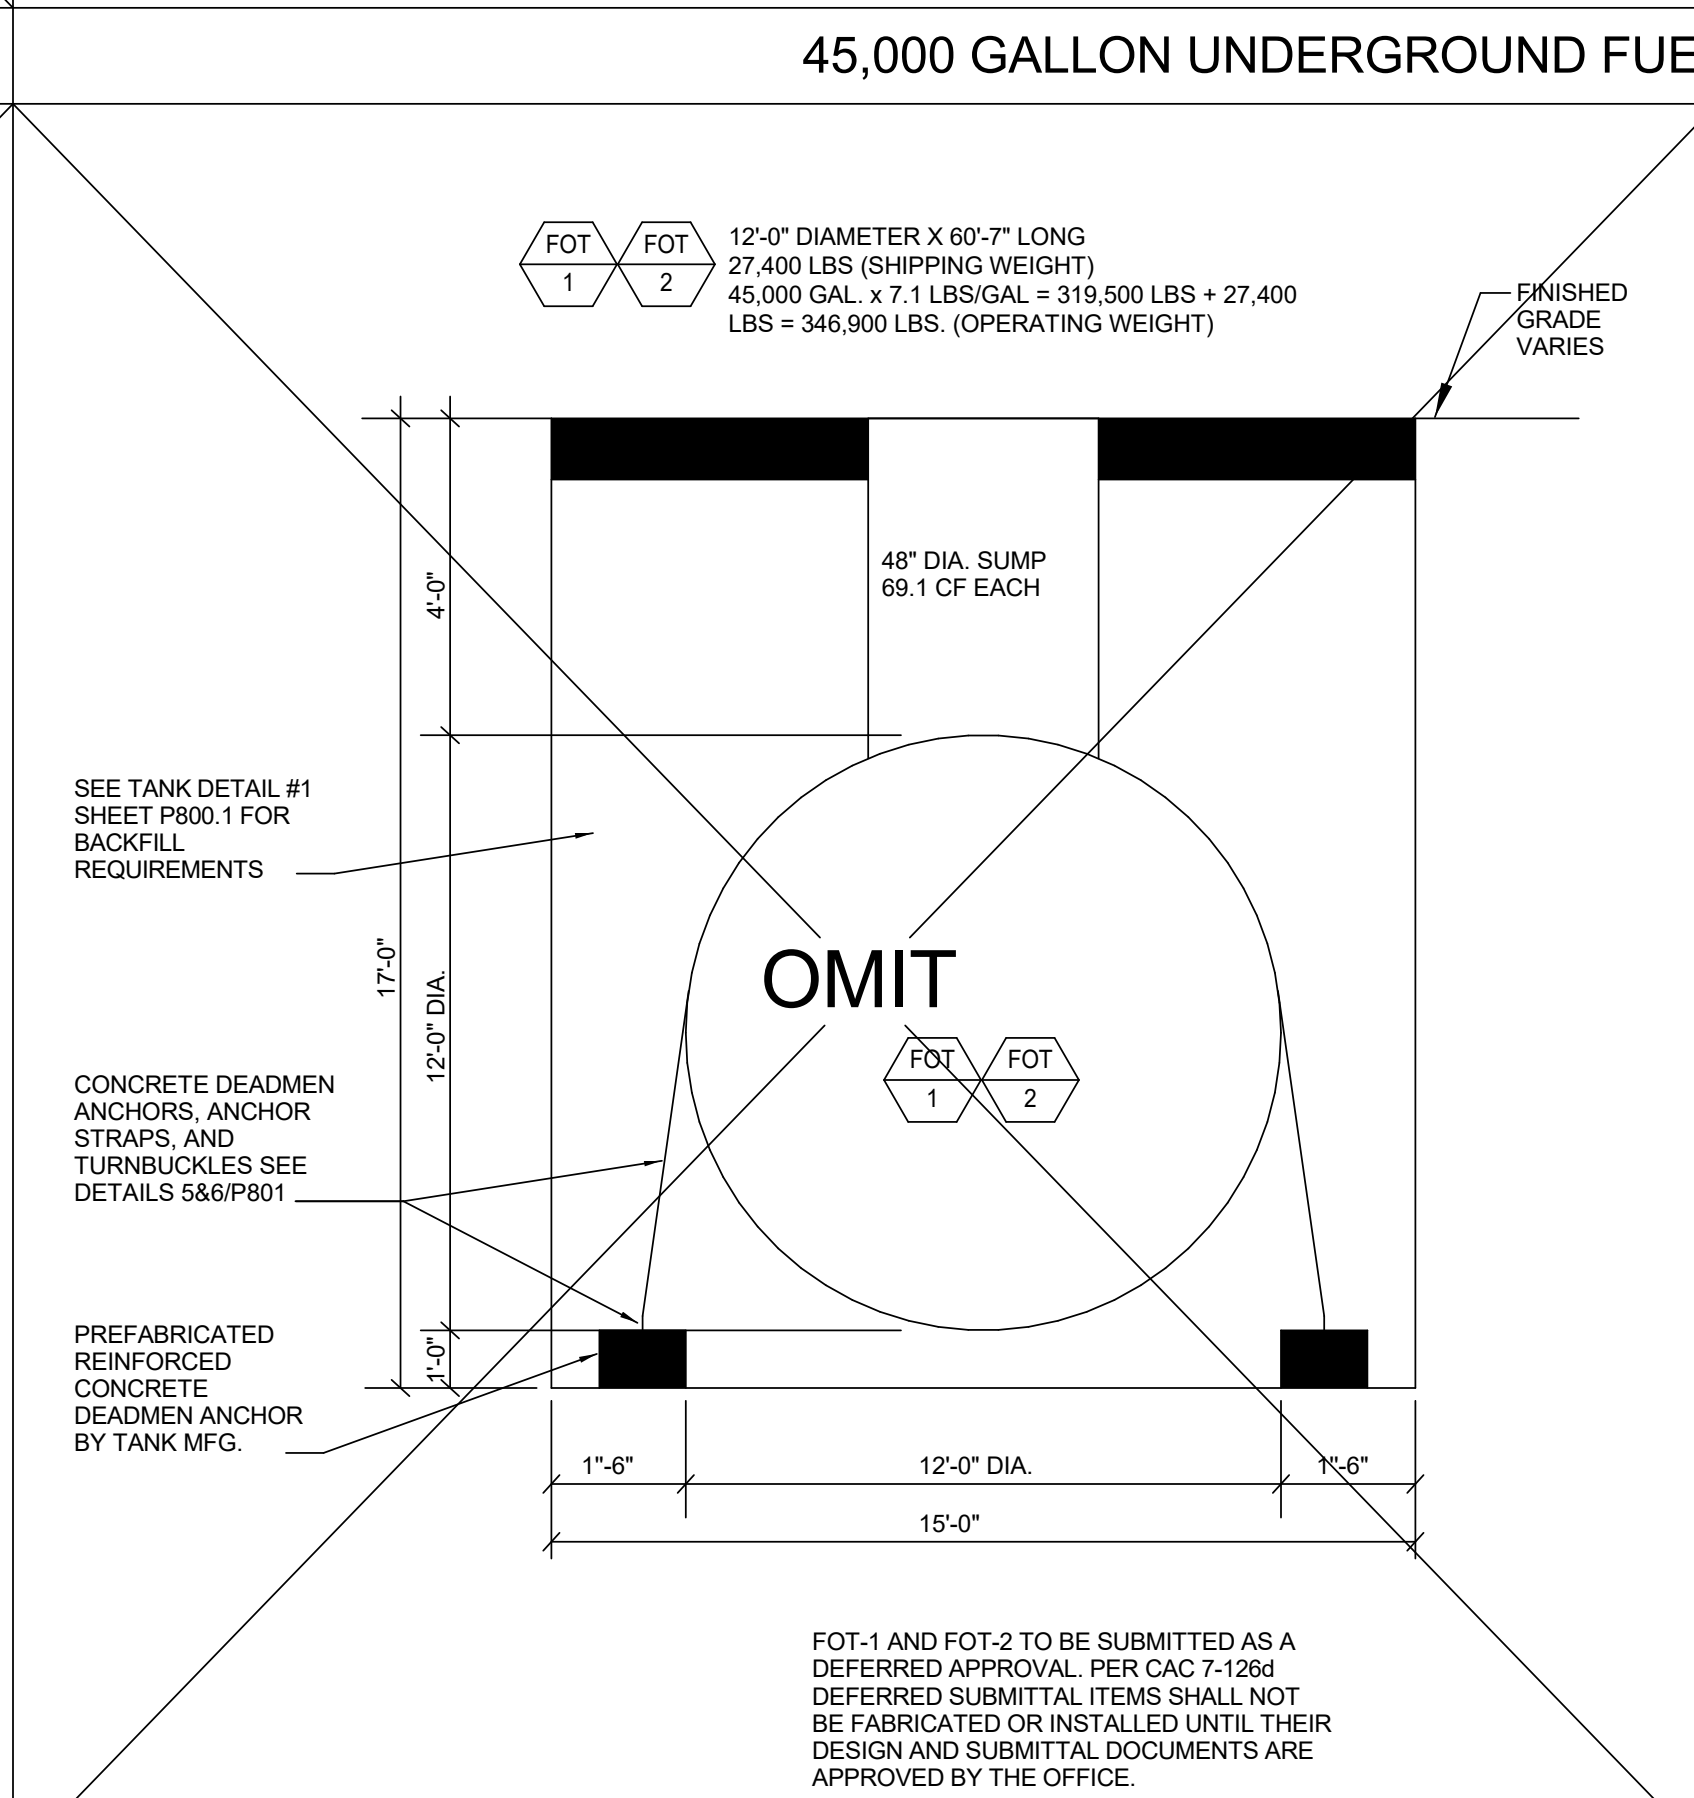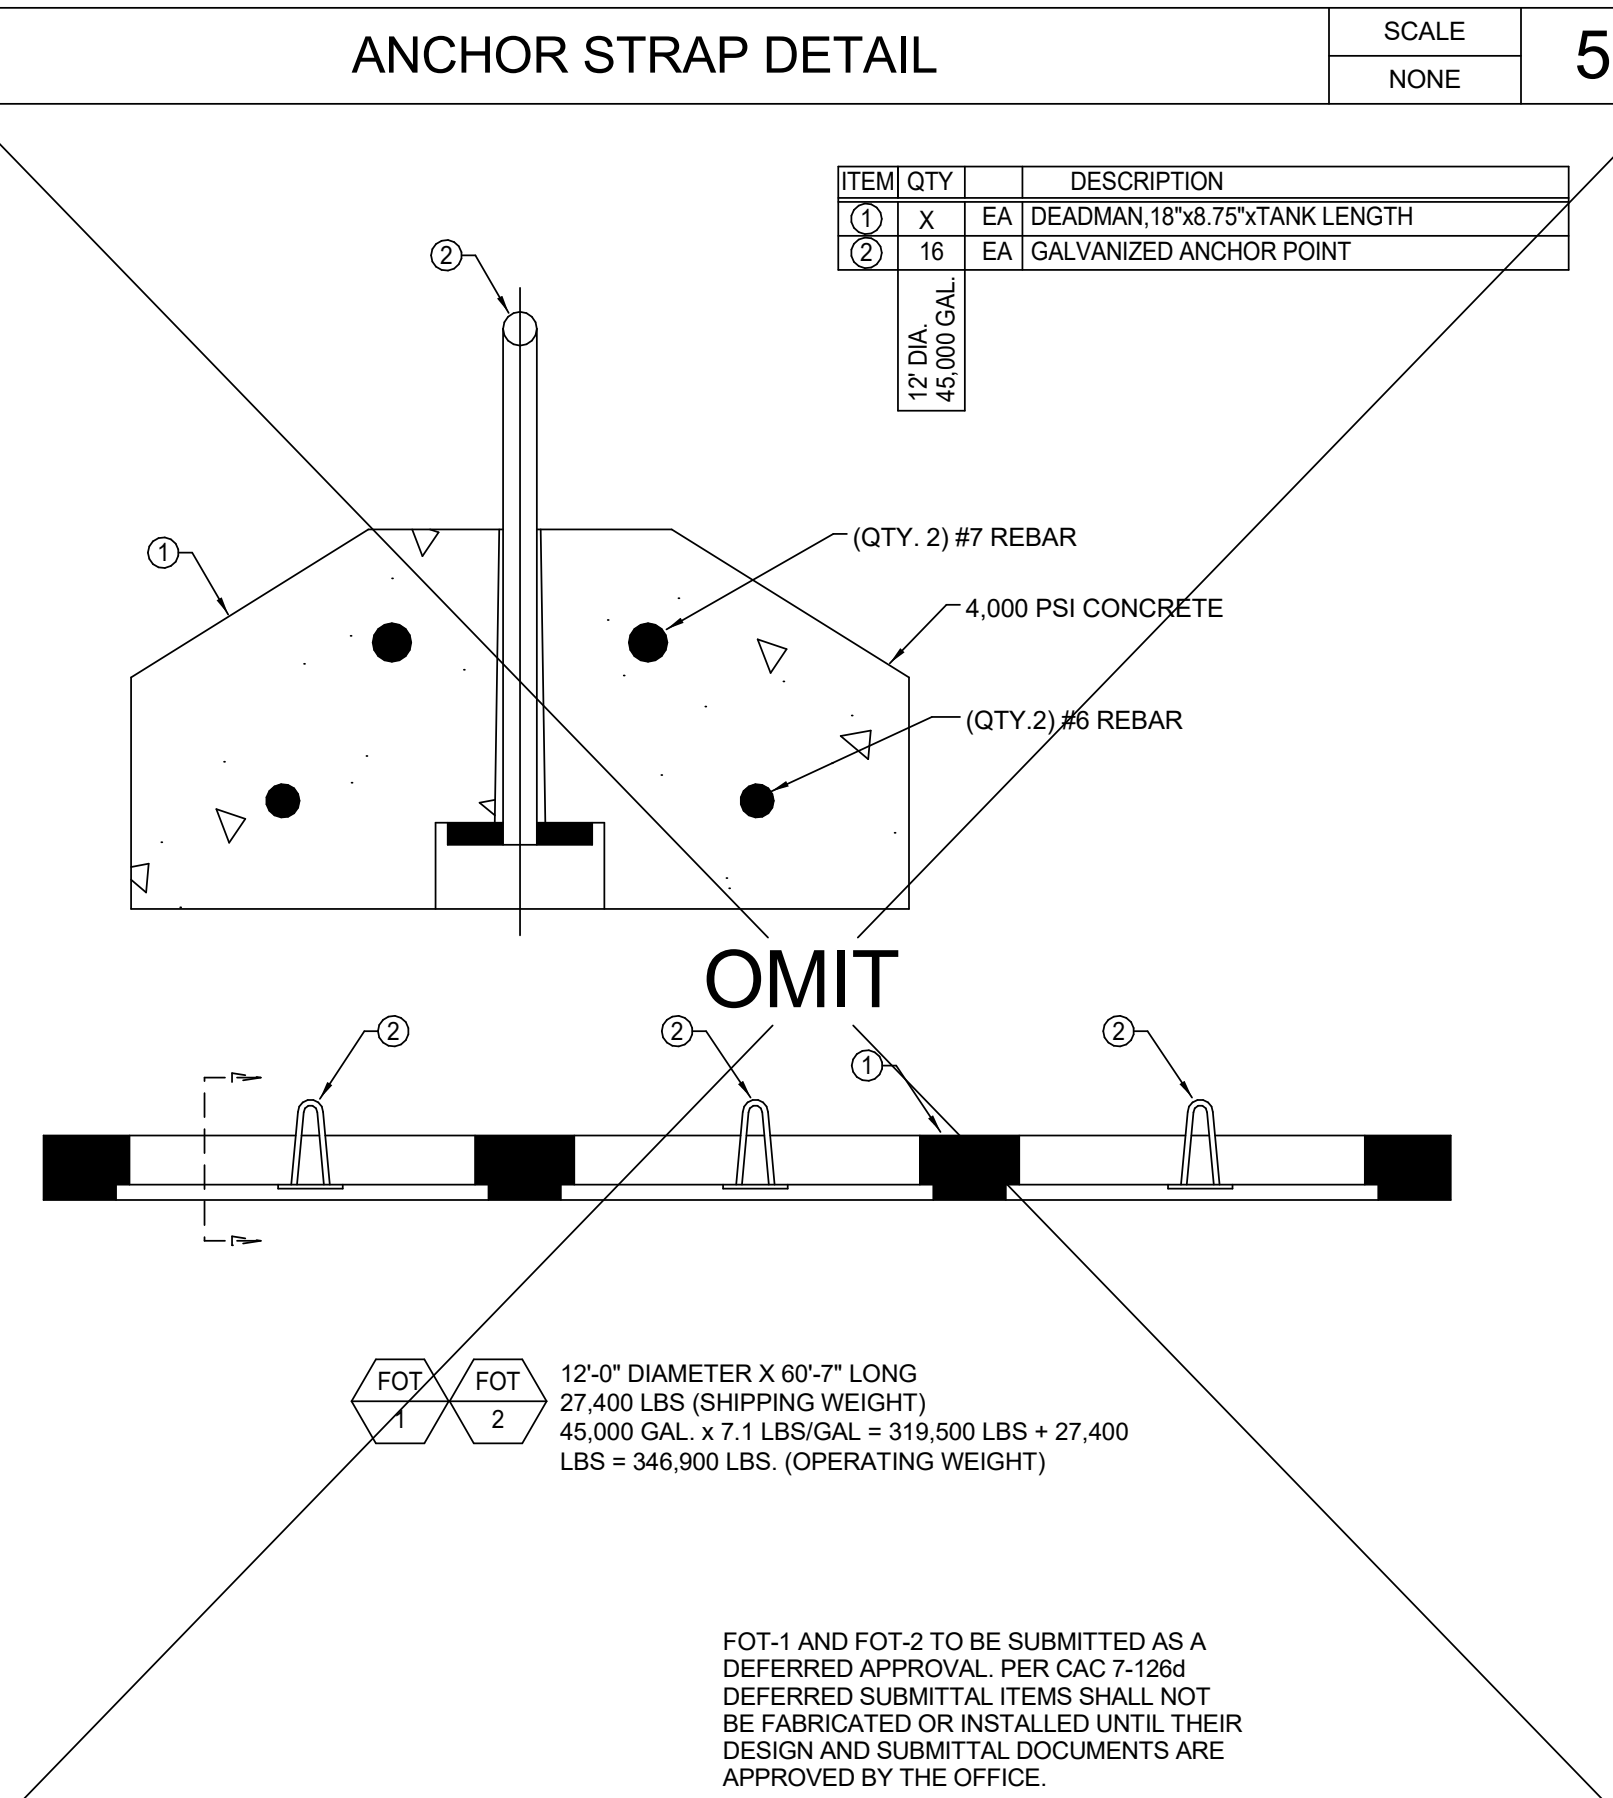

OSHPD # I240005-19-02

CONSULTANT

tk1sc
COLLABORATIVE

515 South Figueroa Street, Suite 1400
Los Angeles, California 90071
213.607.8400 www.tk1sc.com
Project Leader - Michael Huynh
Plumbing Lead - Ron Brick
tk1sc Job #:2017-0456-035

ISSUE RECORD

04/09/2025	D	ADDENDUM D
02/10/2025		BID SET
01/31/2025	BC2	HCAI BACKCHECK 2
10/25/2024	BC1	HCAI BACKCHECK 1
06/13/2024		HCAI SUBMITTAL
04/18/2024		HCAI SUBMITTAL
DATE	△	DESCRIPTION



PHASE 2E INC2 - GENERATOR BUILDING RETROFIT

1000 West Carson Street, Torrance, CA 90502





MILESTONE: HCAI SUBMITTAL

MILESTONE DATE: 6/13/2024

BBB PROJECT: 1712076 SCALE: 12" = 1'-0"

DESCRIPTION
PLUMBING DETAILS

P800.2

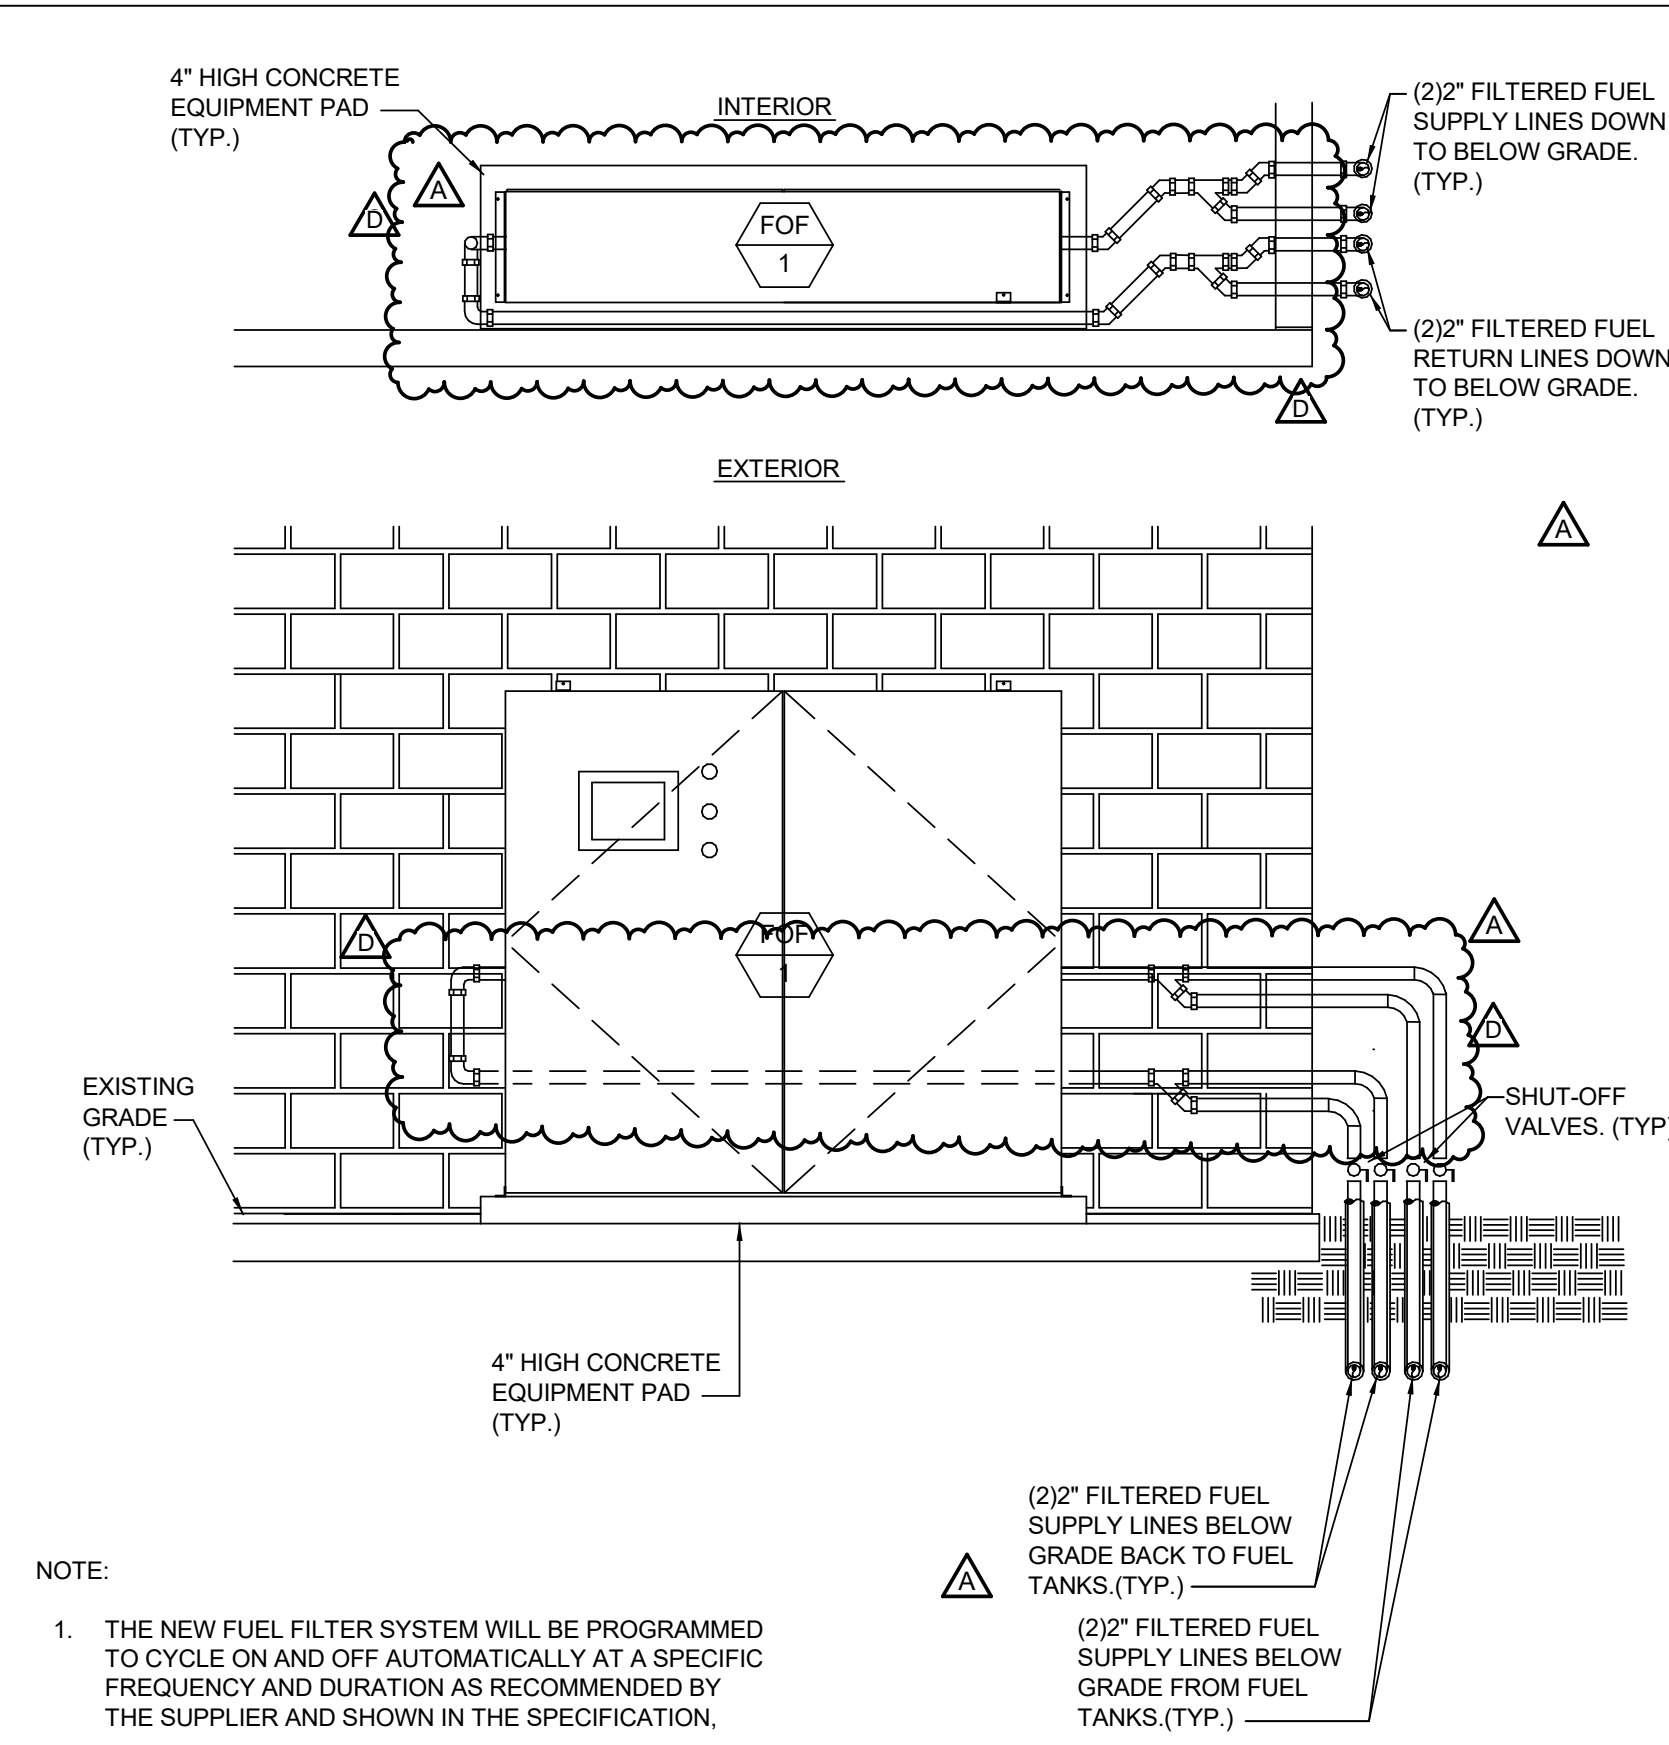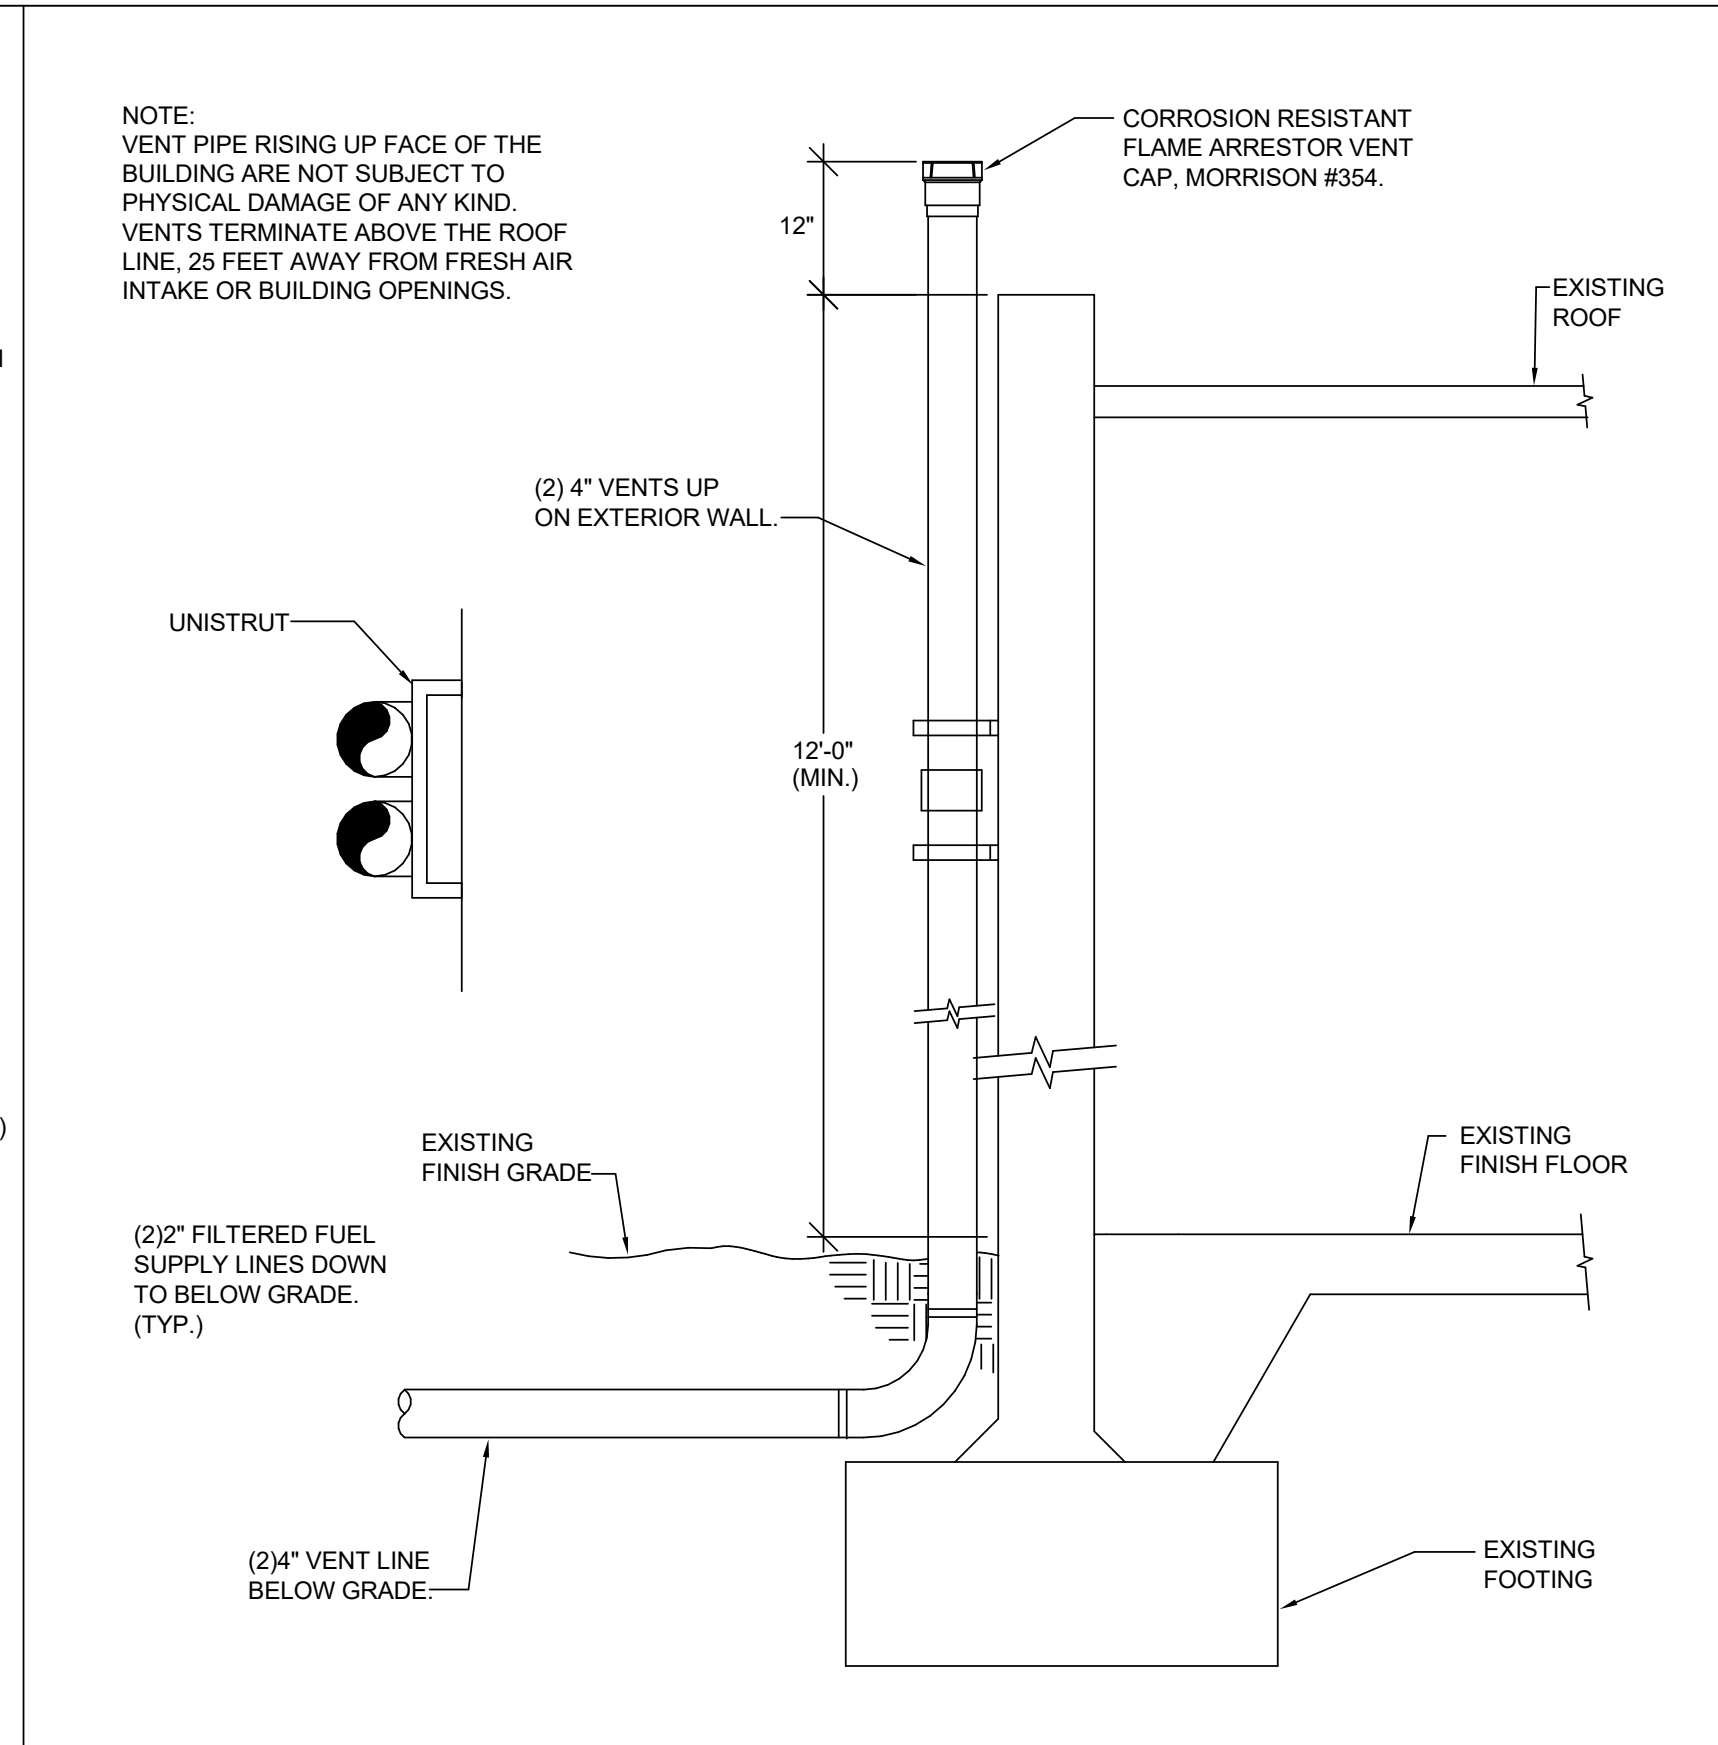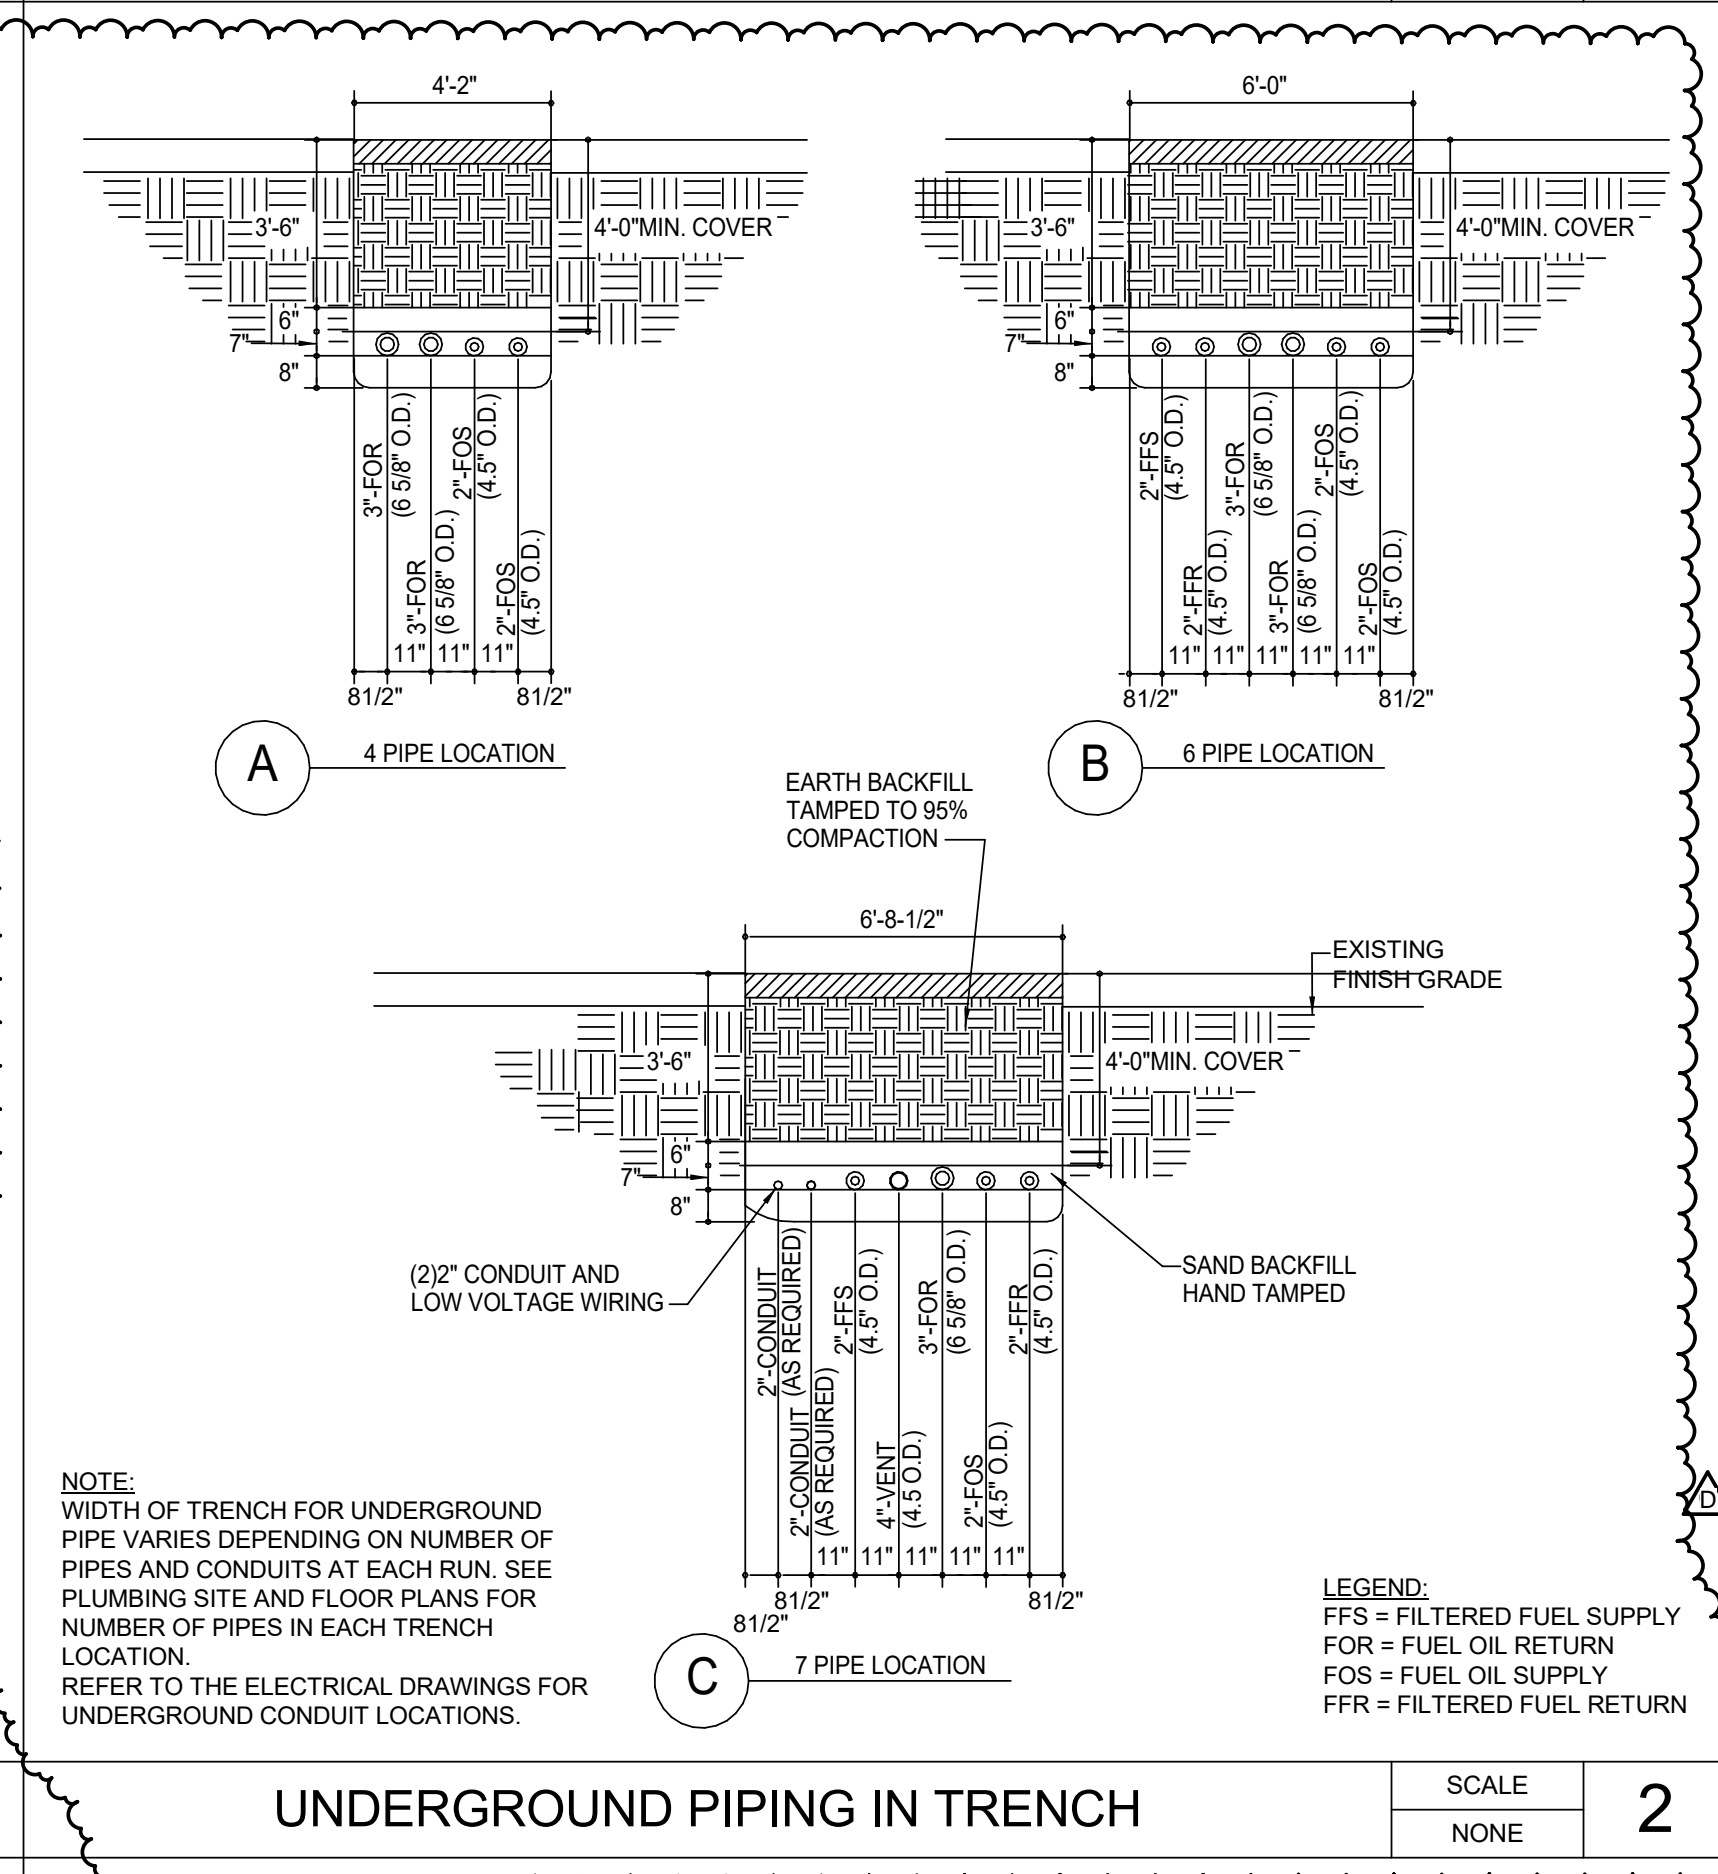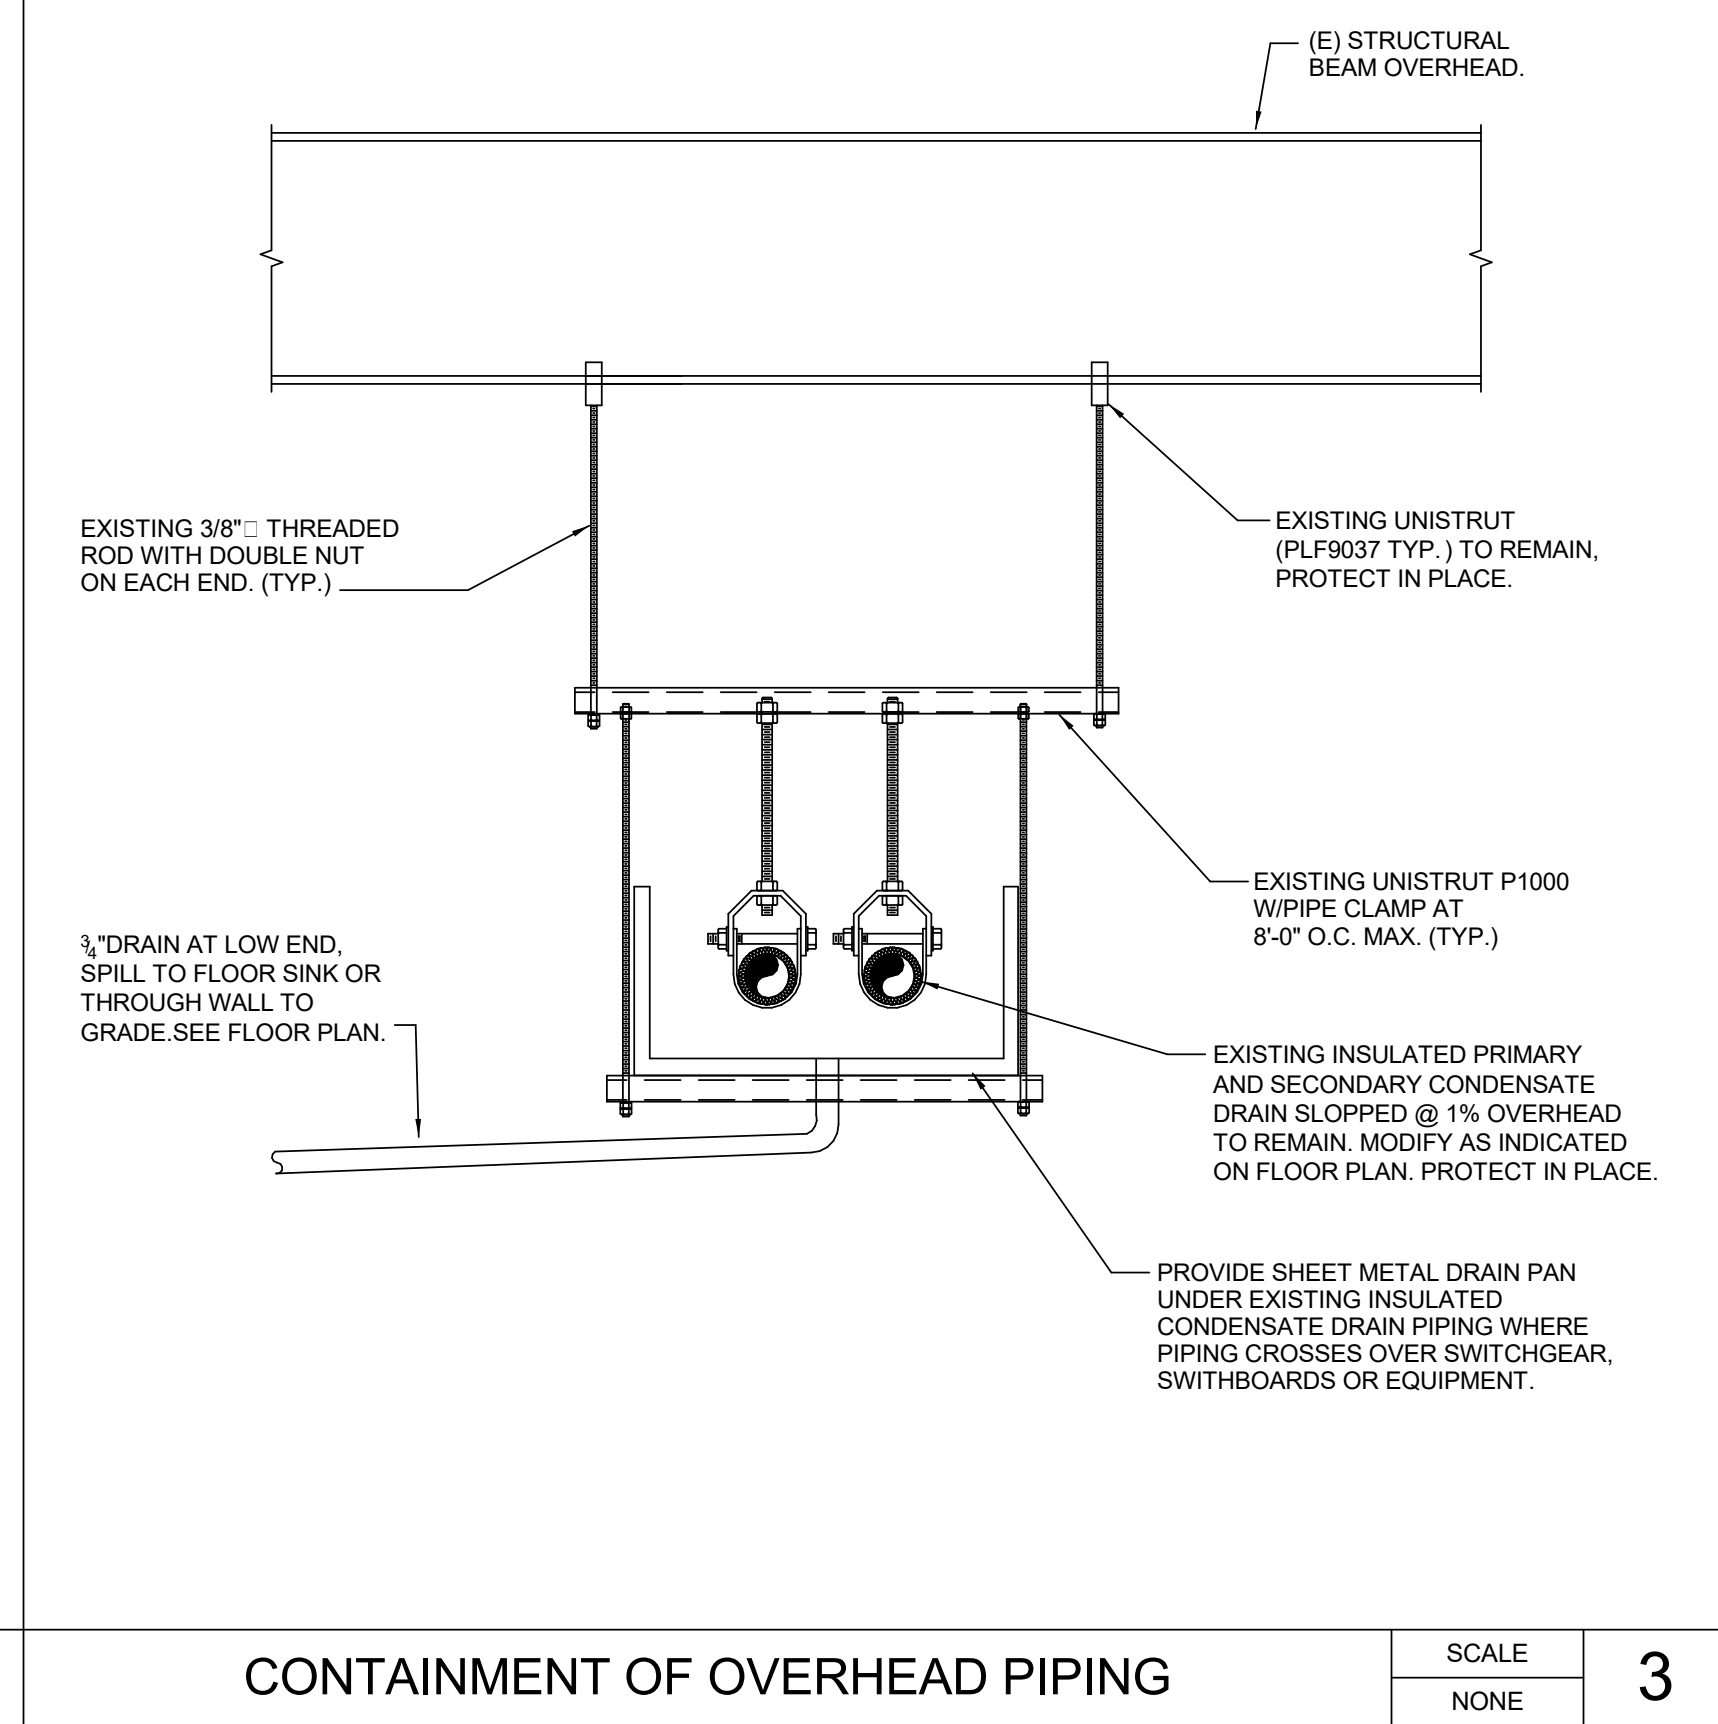																								
==			SCALE NONE	10	--			SCALE NONE	7	FUEL OIL FILTER CABINET			SCALE NONE	4	FUEL TANK VENTS TERMINATION			SCALE NONE	1					
																		SCALE NONE	5	UNDERGROUND PIPING IN TRENCH			SCALE NONE	2
==			SCALE NONE	11	--			SCALE NONE	8	--			SCALE NONE	6				SCALE NONE	3					
--			SCALE NONE	12	--			SCALE NONE	9	--			SCALE NONE	6	CONTAINMENT OF OVERHEAD PIPING			SCALE NONE	3					



RBB ARCHITECTS INC

Joseph A. Balbons, AIA
Sylvia Botero, AIA
Kevin S. Boots, AIA

10980 Wilshire Boulevard
Los Angeles, California
90024-3905

Telephone 310 473 3555
Facsimile 310 473 3555
www.rbbinc.com



AGENCY APPROVALS

OSHPD # 1240005-19-02

CONSULTANT



515 South Figueroa Street, Suite 1400
Los Angeles, California 90071
213.507.8400 www.tklsc.com
Project Leader - Michael Huynh
Plumbing Lead - Ron Brick
tklsc Job #2017-0456-035

ISSUE RECORD

DATE	DESCRIPTION
04/09/2025	D - ADDENDUM D
03/14/2025	A - ADDENDUM A
02/10/2025	BID SET
01/31/2025	BC2 HCAI BACKCHECK 2
10/25/2024	BC1 HCAI BACKCHECK 1
DATE	DESCRIPTION



HARBOR-UCLA MEDICAL CENTER

PHASE 2E INC2 - GENERATOR BUILDING RETROFIT

1000 West Carson Street, Torrance, CA 90502

MILESTONE: HCAI SUBMITTAL


MILESTONE DATE: 6/13/2024

RBB PROJECT: 1712076 SCALE: 12" = 1'-0"


DESCRIPTION
PLUMBING DETAILS

P801.2

#	EQUIPMENT TYPE	EQUIPMENT ID	MANUFACTURER	DESCRIPTION/CATALOG #	ANCHORAGE DETAIL (#/SHEET #)	OSP CERTIFICATION #	CLASSIFICATION	FURNISHMENT	TESTING BY QUINN CONTRACTOR PROVIDED	TESTING BY 3RD PARTY CONTRACTOR PROVIDED
1A	12KV SWITCHGEAR	011-01-EMV-SGR-01	EATON	VACCLAD-W, 15KV, 1200A, 25KAIC	6/S602.2	OSP-0019	FIXED	OWNER	YES	
1B	12KV SWITCHGEAR	011-01-EMV-SGR-02.03	EATON	VACCLAD-W, 15KV, 1200A, 25KAIC	6/S602.2	OSP-0019	FIXED	OWNER	YES	
2A	12KV-208V TRANSFORMER	011-01-NMV-TRX-01	EATON	CA202003EN, 150KVA, 12KV-208Y/120V, RADIAL FEED	8/S602.2	OSP-0008	FIXED	CONTRACTOR		YES
2B	12KV-208V TRANSFORMER	011-01-NMV-TRX-02	EATON	CA202003EN, 150KVA, 12KV-208Y/120V, LOOP FEED	1/S603.2	OSP-0008	FIXED	CONTRACTOR		YES
3A	ENCLOSED CIRCUIT BREAKER	011-01-LNP-BDS-01	EATON	SLG630E WITH LGE3500AAG CIRCUIT BREAKER	1/S603.2	OSP-0338	FIXED	CONTRACTOR		YES
3B	ENCLOSED CIRCUIT BREAKER	011-01-DNP-BDS-01	EATON	SFD100 WITH FDC2100 CIRCUIT BREAKER	1/S603.2	OSP-0338	FIXED	CONTRACTOR		YES
3C	ENCLOSED CIRCUIT BREAKER	011-01-DNP-BDS-02	EATON	SFD100 WITH FDC2100 CIRCUIT BREAKER	1/S603.2	OSP-0338	FIXED	CONTRACTOR		YES
3D	ENCLOSED CIRCUIT BREAKER	011-01-ENP-BDS-01	EATON	SLG630E WITH LGE3500AAG CIRCUIT BREAKER	1/S603.2	OSP-0338	FIXED	CONTRACTOR		YES
4A	AUTOMATIC TRANSFER SWITCH W/ BYPASS	011-01-LNP-ATS-01	ASCO	J7ACTSB30600C5XC	16/S602.2	OSP-0032	FIXED	CONTRACTOR		YES
4B	AUTOMATIC TRANSFER SWITCH W/ BYPASS	011-01-LNP-ATS-01	ASCO	J7ACTSB30600C5XC	16/S602.2	OSP-0032	FIXED	CONTRACTOR		YES
5A	208/120V PANELBOARD	011-01-LEP-PNL-01	SCHNEIDER ELECTRIC	208Y/120V, 800A, 3PH 4W, 500A/3P MCB, 30CKT	3/S603.2	OSP-0016	FIXED	CONTRACTOR		YES
5B	208/120V PANELBOARD	011-01-LLS-PNL-01	EATON	208Y/120V, 225A, 3PH 4W, 225A/3P MCB, 30CKT	3/S603.2	OSP-0009	FIXED	CONTRACTOR		YES
5C	208/120V PANELBOARD	011-01-LCR-PNL-01	EATON	208Y/120V, 225A, 3PH 4W, 225A/3P MCB, 30CKT	3/S603.2	OSP-0009	FIXED	CONTRACTOR		YES
5D	208/120V PANELBOARD	011-01-LEQ-PNL-01	EATON	208Y/120V, 125A, 3PH 4W, 125A/3P MCB, 30CKT	3/S603.2	OSP-0009	FIXED	CONTRACTOR		YES
6A	BATTERY RACK	011-01-DNP-BAT-01	C&D TECHNOLOGY	RD01266	11/S602.2	OSP-0569	FIXED	CONTRACTOR		YES
6B	BATTERY RACK	011-01-DNP-BAT-02	C&D TECHNOLOGY	RD01266	11/S602.2	OSP-0569	FIXED	CONTRACTOR		YES
7A	BATTERY CHARGER	011-01-DNP-BCH-01	LA MARCHE	TPSD-75-130V-550-017-537	5/S602.2	OSP-0340	FIXED	CONTRACTOR		YES
7B	BATTERY CHARGER	011-01-DNP-BCH-02	LA MARCHE	TPSD-75-130V-550-017-537	5/S602.2	OSP-0340	FIXED	CONTRACTOR		YES
8A	125VDC PANELBOARD	011-01-DNP-PPL-01	EATON	125VDC, 2W, 250A, 100A/2P MCB, 28CKT	3/S603.2	OSP-0009	FIXED	CONTRACTOR		YES
8B	125VDC PANELBOARD	011-01-DNP-PPL-02	EATON	125VDC, 2W, 250A, 100A/2P MCB, 28CKT	3/S603.2	OSP-0009	FIXED	CONTRACTOR		YES
8C	125VDC PANELBOARD	011-01-DNP-PPL-02	EATON	125VDC, 2W, 250A, 100A/2P MCB, 28CKT	3/S603.2	OSP-0009	FIXED	CONTRACTOR		YES
9	FIBER PATCH PANEL	VARIES, SEE ELECTRICAL PLANS	COMMSCOPE	WBE-EMT-BK-4P-MOD	EXEMPT PER CBC 1616A.1.18	-	FIXED	CONTRACTOR		YES
11	ATS-GEN TERMINAL CABINET	ATS-GEN TERMINAL CABINET	HOFFMAN	A2424312WFSSLP	8/S603.2		FIXED	CONTRACTOR		YES
14	GENERATOR QUICK CONNECT	011-01-LEP-QQC-01	ASCO	3QC-UCAA-3-0800-F00F	8/S603.2	OSP-0032	FIXED	CONTRACTOR		YES
15	SPLICE BOX	VARIES, SEE ELECTRICAL PLANS	HOFFMAN	A24RC48	9/S603.2		FIXED	CONTRACTOR		YES
16	LOW VOLTAGE PULL BOX	VARIES, SEE ELECTRICAL PLANS	HOFFMAN				FIXED	CONTRACTOR		YES
17	MEDIUM VOLTAGE PULL BOX	VARIES, SEE ELECTRICAL PLANS	HOFFMAN				FIXED	CONTRACTOR		YES

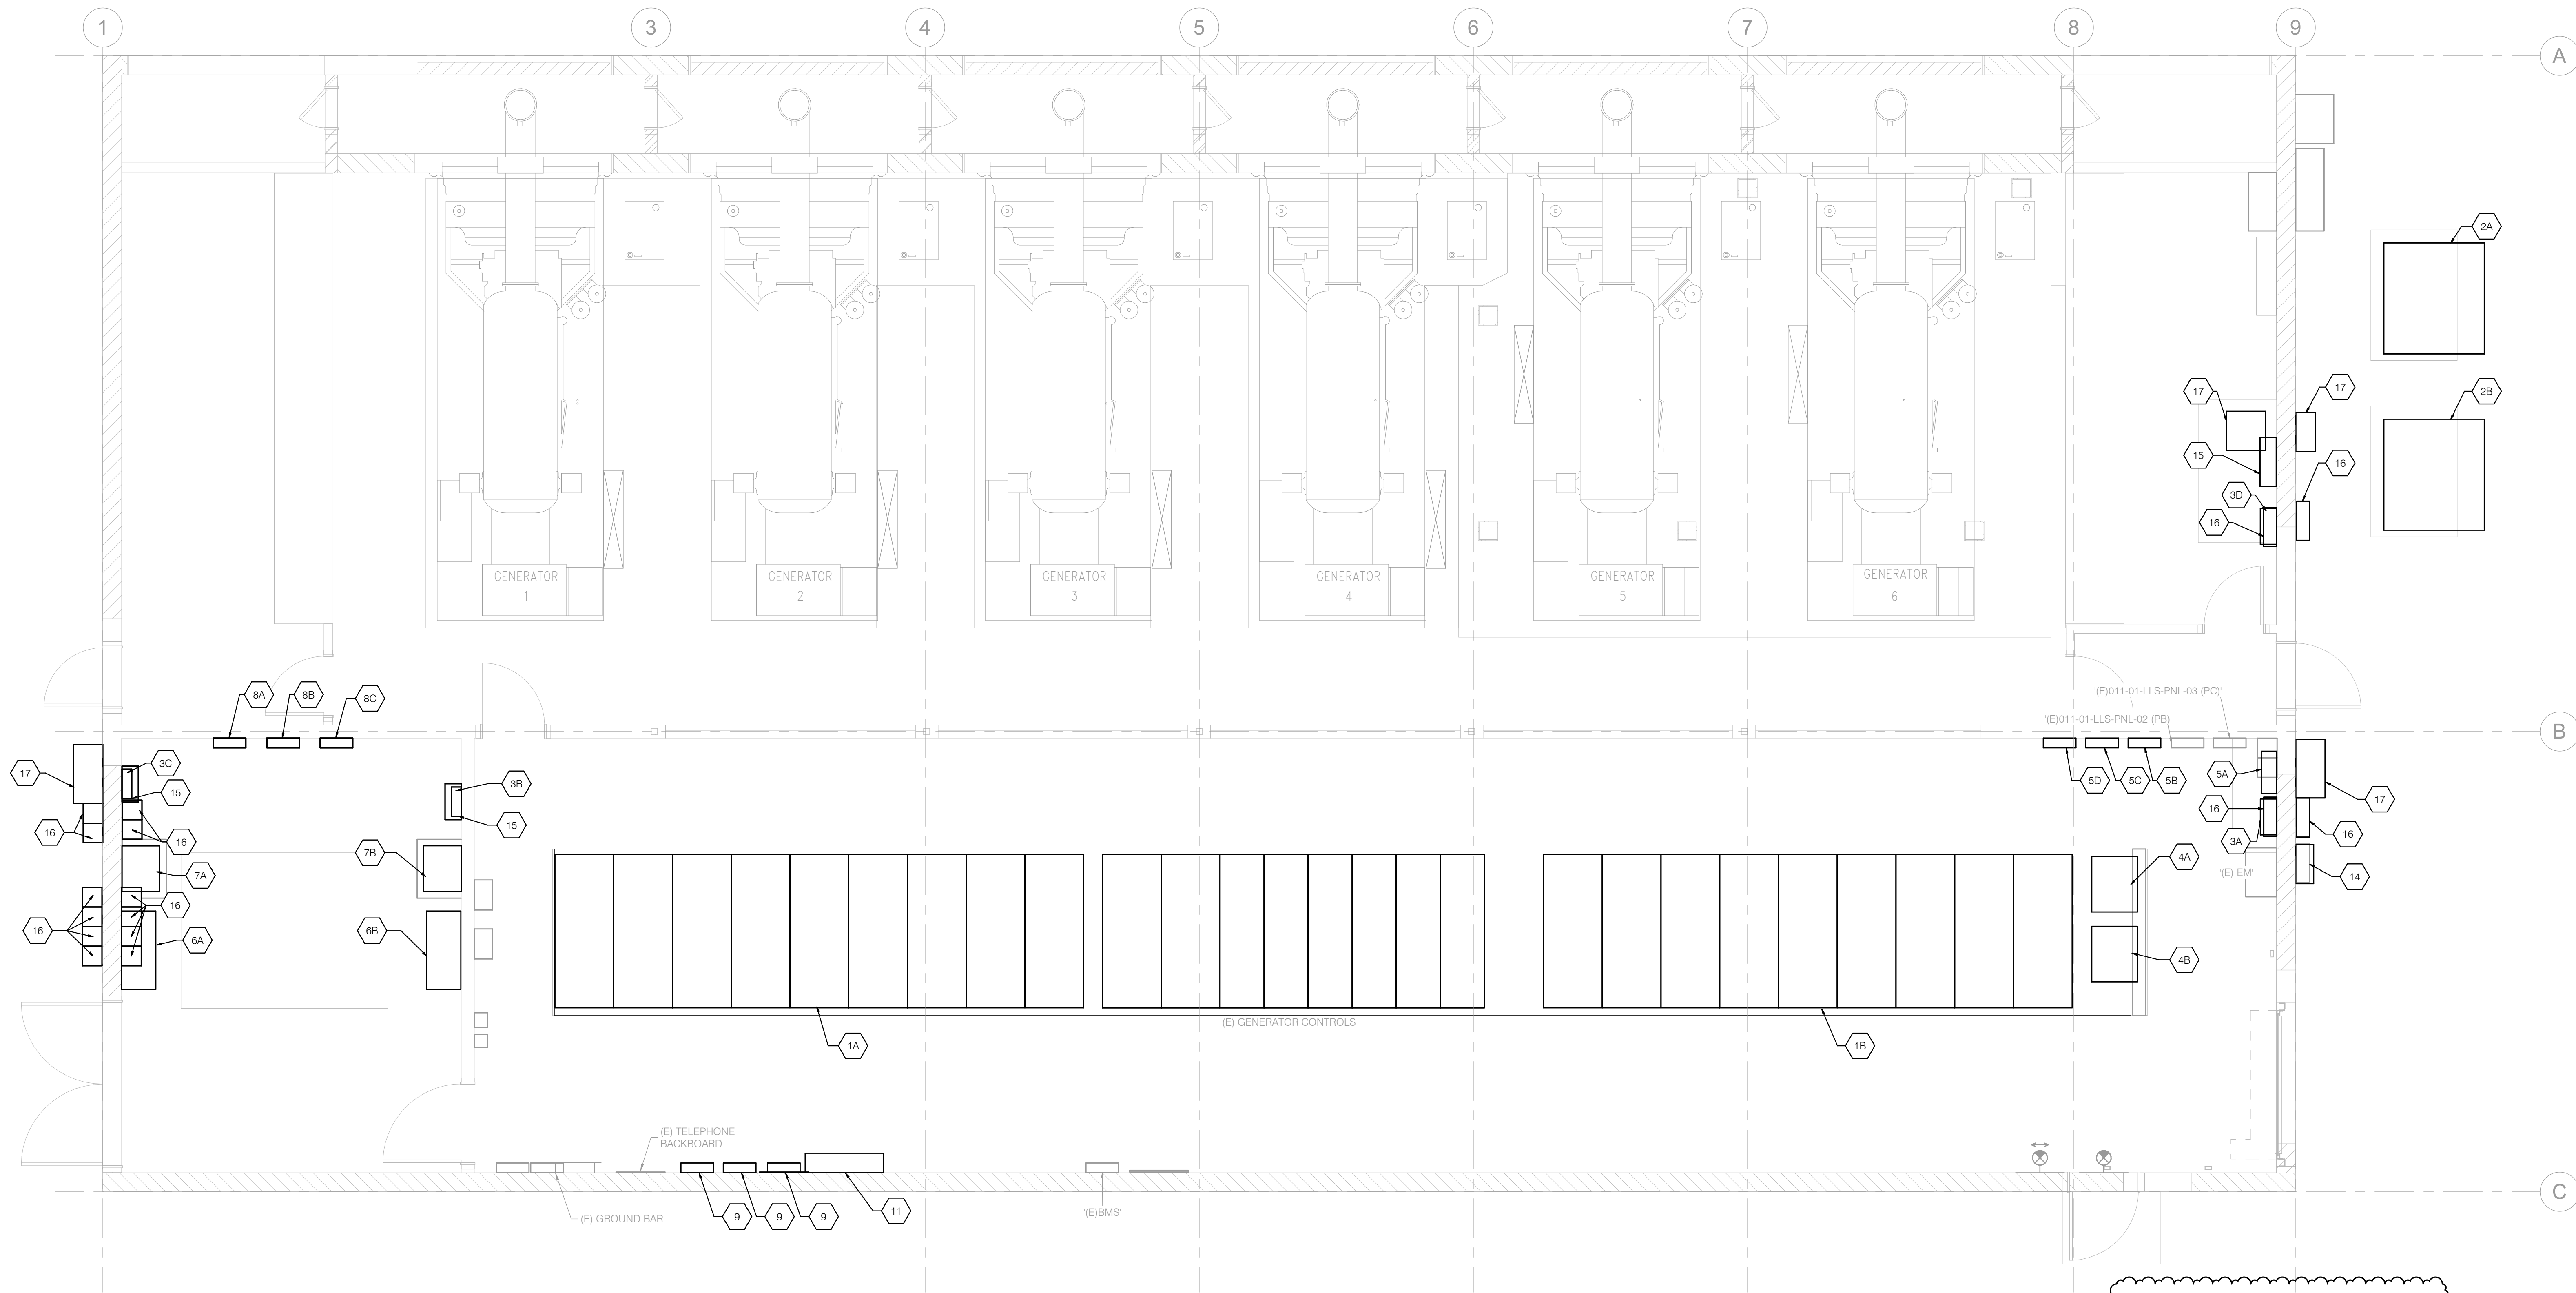

- GENERAL NOTES**
- CONTRACTOR TO PROVIDE POWER AND ARC FLASH STUDY FOR LOW VOLTAGE 600 VOLTS AND LESS EQUIPMENT.
 - CONTRACTOR TO PROVIDE STRUCTURAL DESIGN CALCULATIONS STUDY WITH SEISMIC FOR ANCHORING THE SWITCHGEAR TO THE HOUSE KEEPING PAD PER SPEC 26 1913 MEDIUM-VOLTAGE METAL CLAD SWITCHGEAR.
 - CONTRACTOR TO ADD WARNING LABELS FOR EXPOSED 12KV CONDUITS AND PULL BOXES TO WITH YELLOW BACK GROUND 'DANGER HIGH VOLTAGE'.
 - CONTRACTOR TO COORDINATE WORK AND WITH QUINN AND CAT COMPANIES

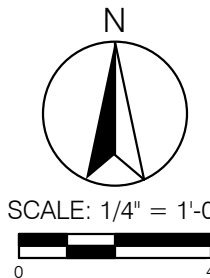


RBB ARCHITECTS INC

Joseph A. Balbons, AIA
Sylvia Botero, AIA
Kevin S. Boots, AIA

10980 Wilshire Boulevard
Los Angeles, California
90024-3905

Telephone 310 473 3555
Facsimile 310 473 3555
www.rbbinc.com

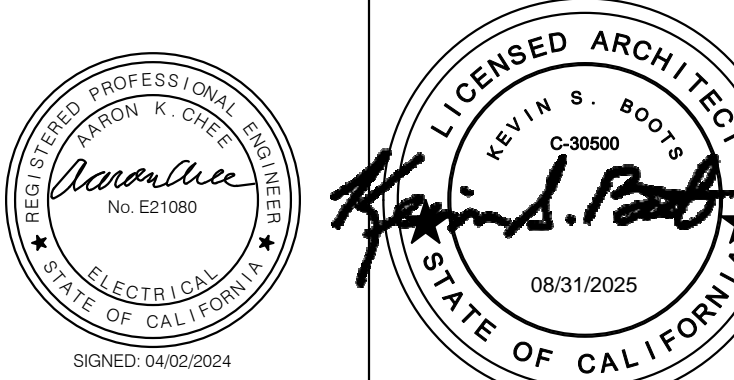

AGENCY APPROVALS

OSHPD # 1240005-19-01
CONSULTANT

p2s ENG

Long Beach // Irvine // Los Angeles
San Diego // San Jose // Seattle

p2sinc.com

ISSUE RECORD

DATE	DESCRIPTION
04/09/2025	D - ADDENDUM D
04/01/2025	4 - HCAI BACKCHECK 3
03/14/2025	A - ADDENDUM A
01/31/2025	3 - HCAI BACKCHECK 2
08/08/2024	- HCAI BACKCHECK 1
06/13/2024	1 - HCAI SUBMITTAL
04/18/2024	- HCAI SUBMITTAL

Harbor-UCLA
MEDICAL CENTER
HARBOR-UCLA MEDICAL CENTER
PHASE 2E INC 2 - GENERATOR BLDG.
RETROFIT

1000 West Carson Street, Torrance, CA 90509


MILESTONE: HCAI SUBMITTAL

MILESTONE DATE: 10/25/2024

RBB PROJECT: 1712105 SCALE: 1/4" = 1'-0"

DESCRIPTION
EQUIPMENT PLAN - GEN BLDG

DU2-004

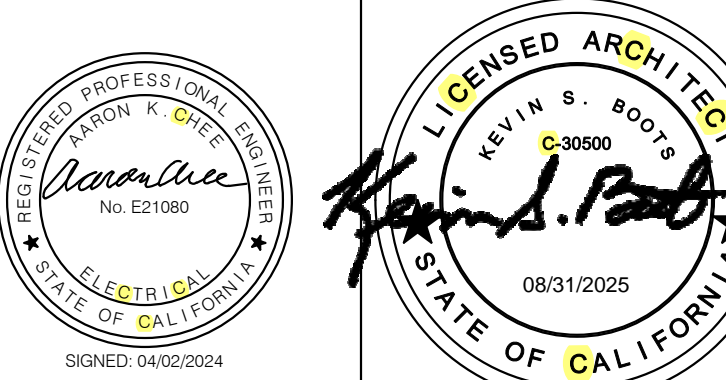

OSHPD # I240005-19-01

CONSULTANT



Long Beach // Irvine // Los Angeles
San Diego // San Jose // Seattle

p2sinc.com

ISSUE RECORD

DATE		DESCRIPTION
04/09/2025	D	ADDENDUM D
04/01/2025	4	HCAI BACKCHECK 3
03/14/2025	A	ADDENDUM A
01/31/2025	3	HCAI BACKCHECK 2
10/25/2024	2	HCAI BACKCHECK 1
06/13/2024	1	HCAI SUBMITTAL
04/18/2024		HCAI SUBMITTAL



**HARBOR-UCLA MEDICAL CENTER
PHASE 2E INC 2 - GENERATOR BLDG.
RETROFIT**

1000 West Carson Street, Torrance, CA 90509

MILESTONE: HCAI SUBMITTAL

MILESTONE DATE: 10/25/2024

RBB PROJECT: 1712105 SCALE: As indicated

DESCRIPTION
OVERALL SITE PLAN


DU2-005

GENERAL NOTES

1. REFER TO TABLE FOR HCAI NUMBERED BUILDINGS

NOTES


1. PROVIDE (2) 2" UNDERGROUND CONDUITS. IN ONE CONDUIT PROVIDE #46 AWG & 1#6AWG CND FOR FUEL PUMPS. REFER TO 2/P800.2. COORDINATE WITH PLUMBING CONTRACTOR.
2. PROVIDE TRAFFIC RATED 2.5LX2WX3H LOW VOLTAGE PULLBOX.
3. PROVIDE 2.5LX2WX3H LOW VOLTAGE PULLBOX WITH LOCKING COVER.
4. INSTALL OWNER FURNISHED WALL-MOUNTED ANNUNCIATOR PANEL IN THE CONTROL ROOM.

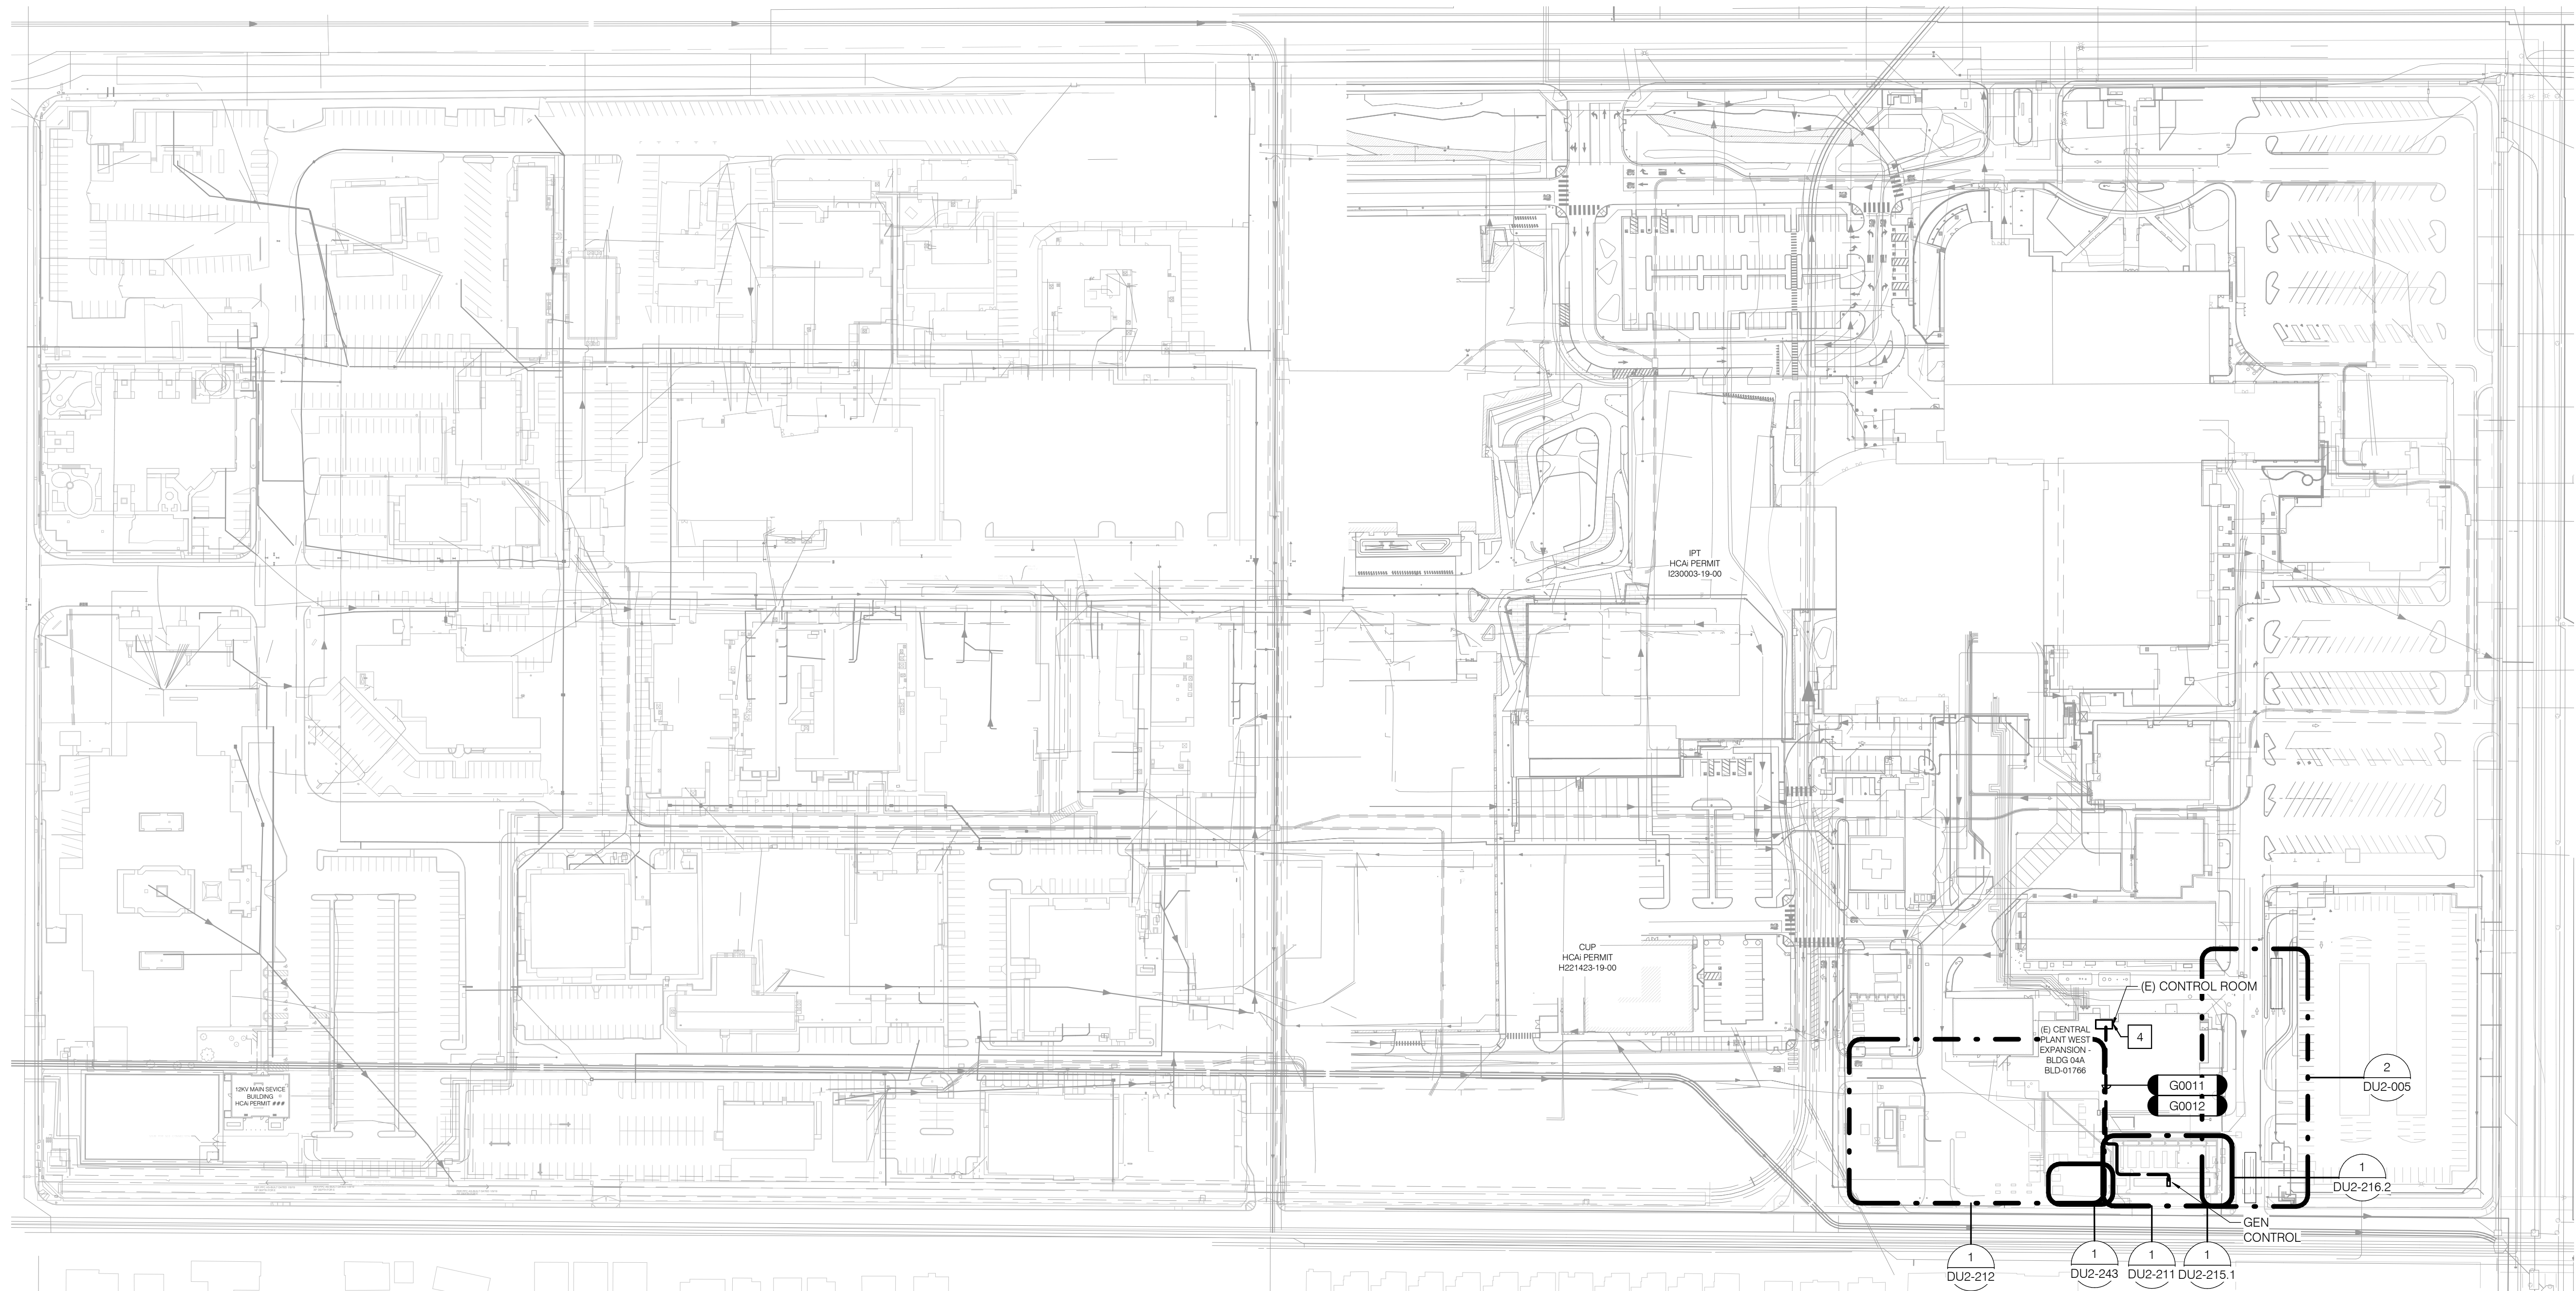

1 OVERALL SITE PLAN


SCALE: 1" = 100'-0"

SCALE: 1" = 100'-0"

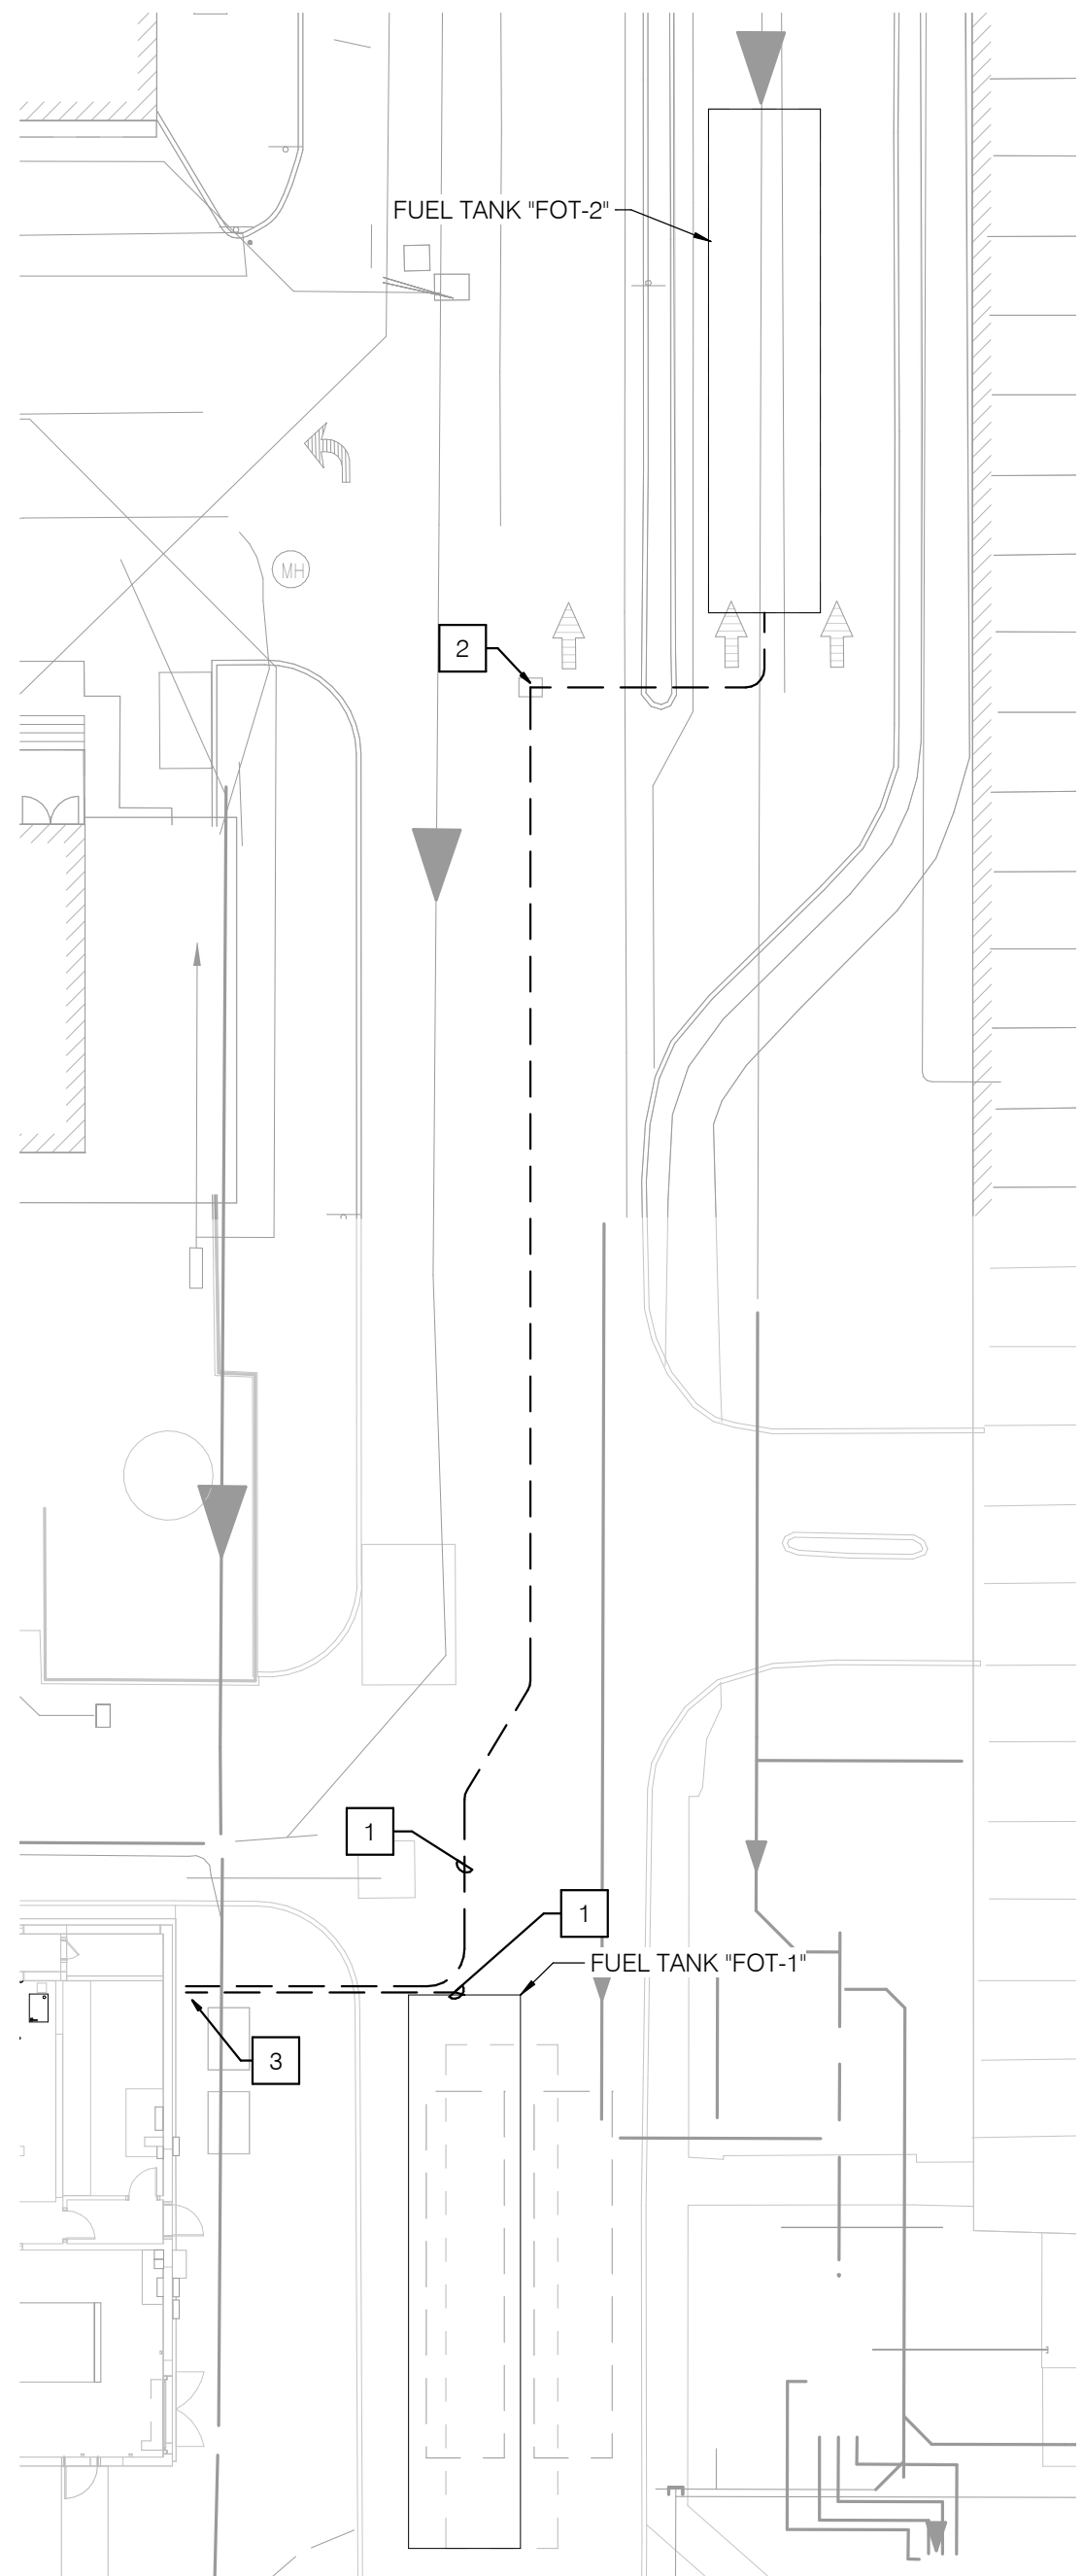


2 UNDERGROUND FUEL TANK ROUNTING

SCALE: 1" = 20'-0"

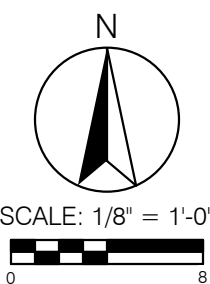

Print Date: 4/14/2025 11:55:14 AM

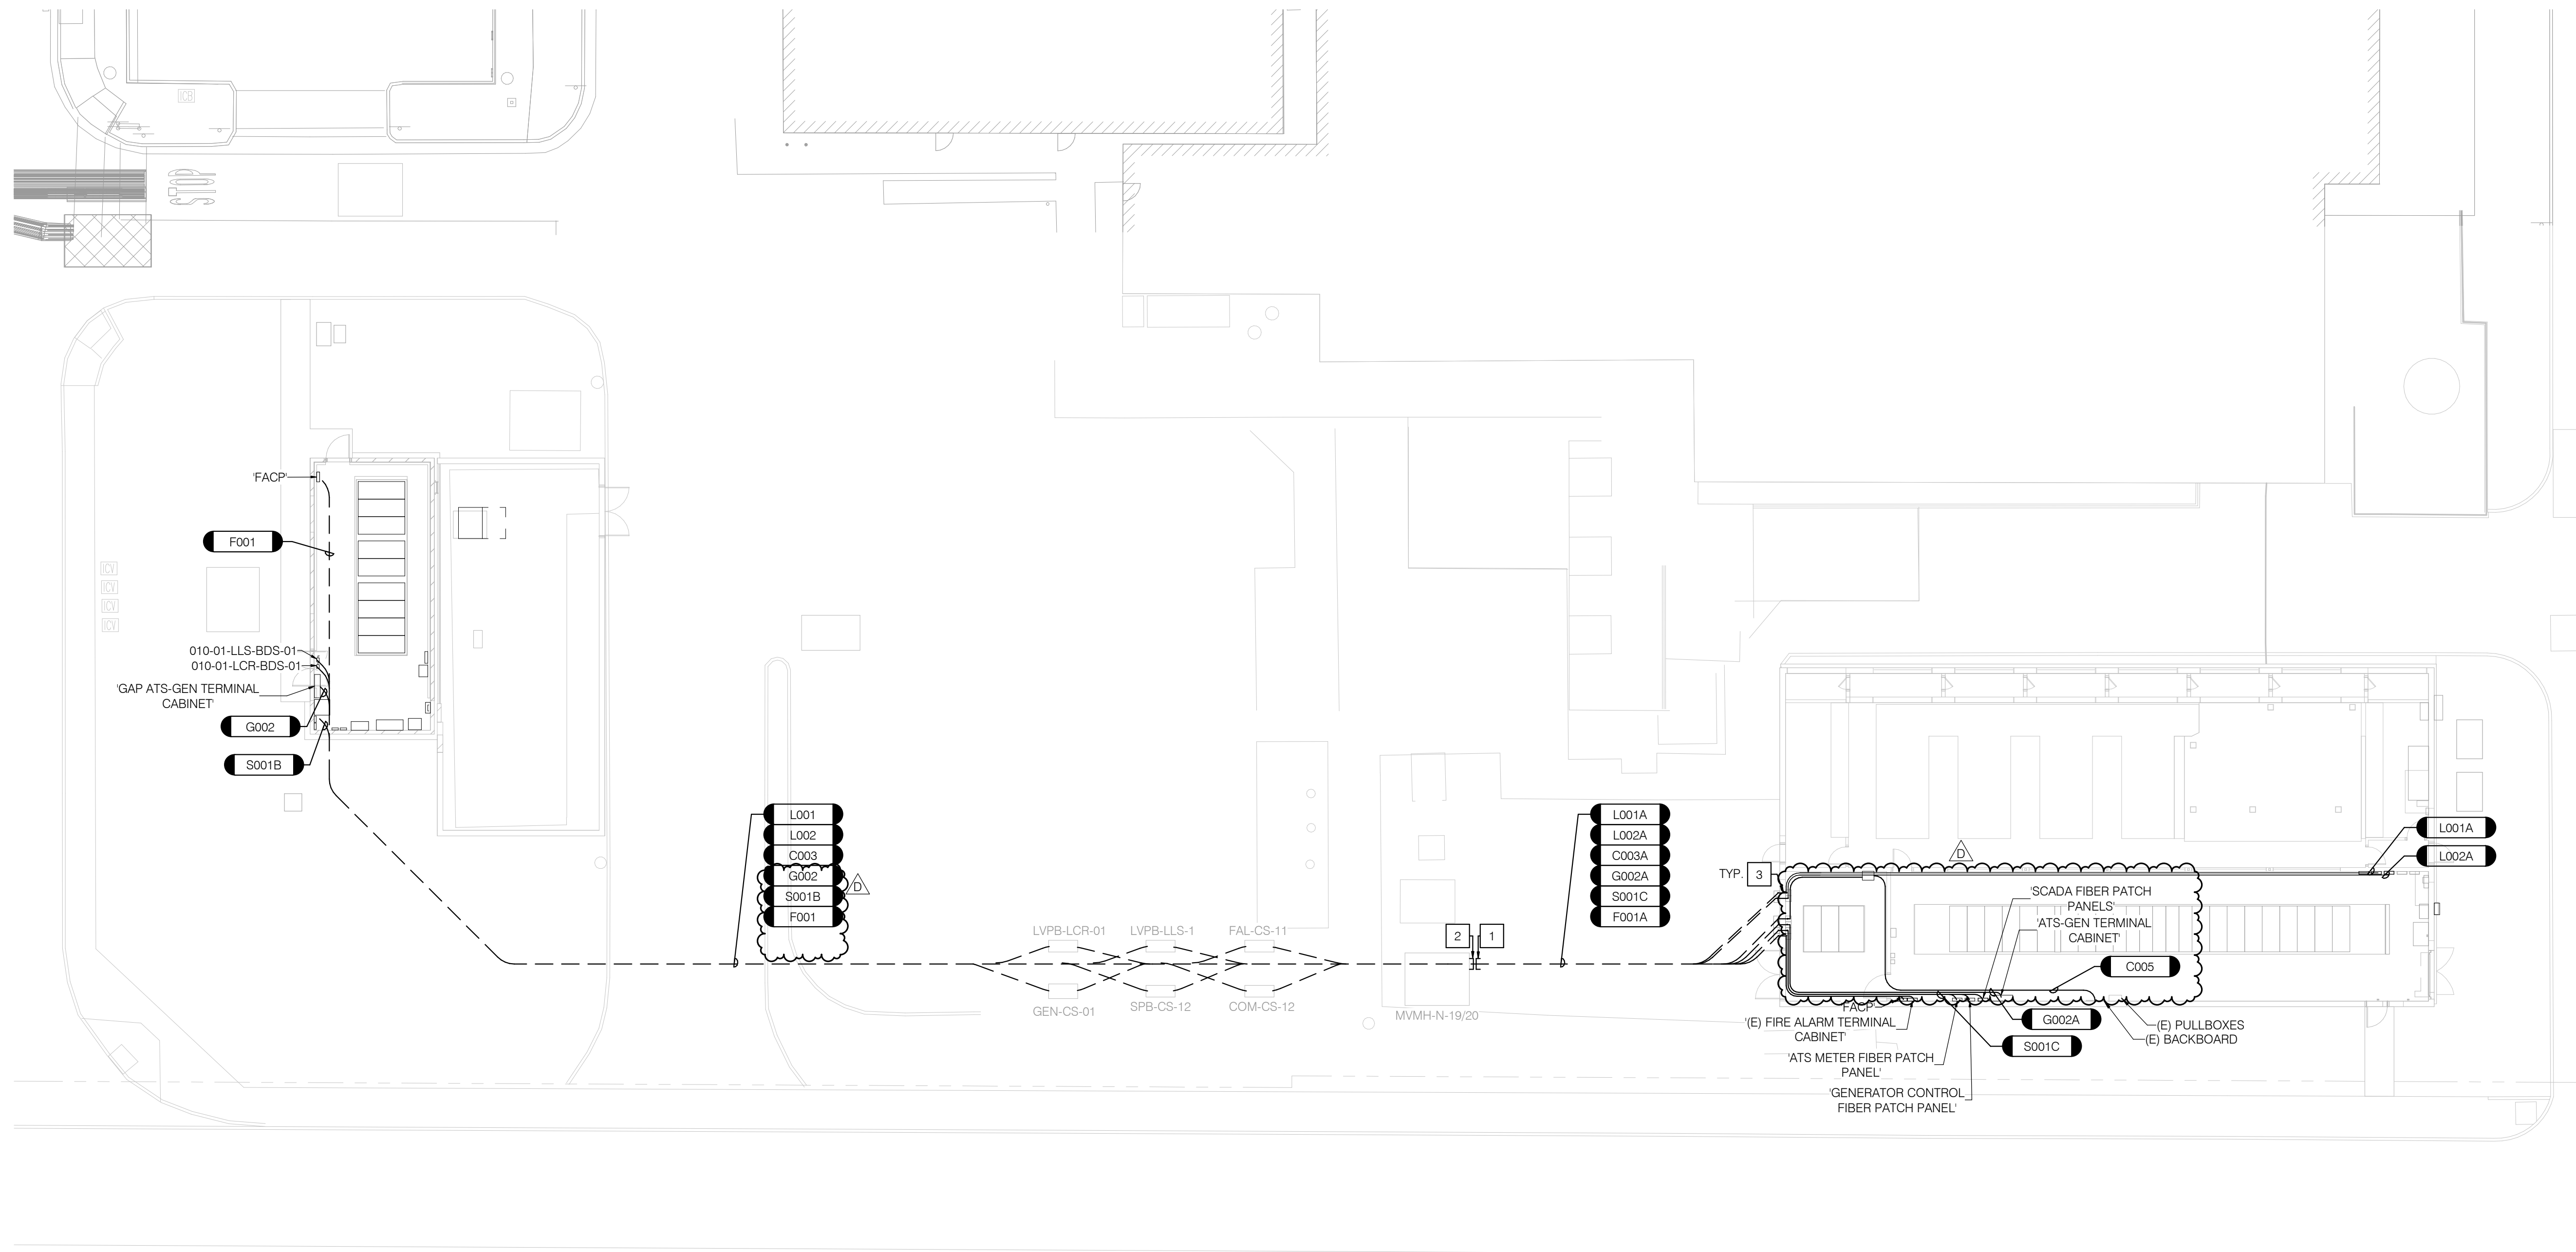

GENERAL NOTES

- A. FOLLOW SINGLE LINE SHEET DU2-511 AND DU2-513.
B. NO SPLICE IN PULLBOXES INSTALLED BY INC 1 OR INC 2 CONTRACTOR.

NOTES

- 1 UNDERGROUND EAST CONDUITS BY INC 2 CONTRACTOR.
REMOVE CAP AND CONNECT CONDUIT TO INC 1 STUB OUT.
- 2 UNDERGROUND WEST CONDUITS BY INC 1 CONTRACTOR.
REMOVE CAP AND CONNECT CONDUIT TO INC 2 STUB OUT.
- 3 CORE DRILL AND SEAL AROUND CONDUITS.




RBB ARCHITECTS INC

Joseph A. Balbons, AIA
Sylvia Botero, AIA
Kevin S. Boots, AIA

10980 Wilshire Boulevard
Los Angeles, California
90024-3905

Telephone 310 473 3555
Facsimile 310 473 3555
www.rbbinc.com

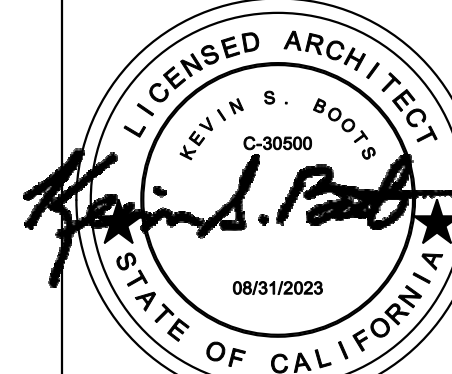

AGENCY APPROVALS

OSHPD # 1240005-19-01

CONSULTANT



Long Beach // Irvine // Los Angeles
San Diego // San Jose // Seattle

p2sinc.com

ISSUE RECORD

DATE	DESCRIPTION
04/09/2025	D ADDENDUM D
04/01/2025	A HCAI BACKCHECK 3
03/14/2025	A ADDENDUM A
02/10/2025	BID SET
01/31/2025	3 HCAI BACKCHECK 2
10/25/2024	2 HCAI BACKCHECK 1
DATE	DESCRIPTION



HARBOR-UCLA MEDICAL CENTER
PHASE 2E INC 2 - GENERATOR BLDG.
RETROFIT


1000 West Carson Street, Torrance, CA 90509

MILESTONE: HCAI SUBMITTAL
MILESTONE DATE: 10/25/2024
RBB PROJECT: 1712105 SCALE: 1/16" = 1'-0"

DESCRIPTION
ENLARGED 208/120V, SCADA,
FIRE, COM, GEN START SITE UG
POWER PLAN

DU2-213


(MILESTONE 1)

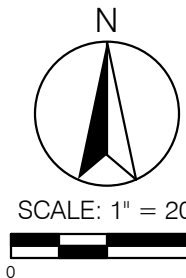

Joseph A. Balbona, AIA
Sylvia Botero, AIA
Kevin S. Boots, AIA

10980 Wilshire Boulevard
Los Angeles, California
90024-3905

Telephone 310 473 3555
Facsimile 310 473 3555
www.rbbinc.com

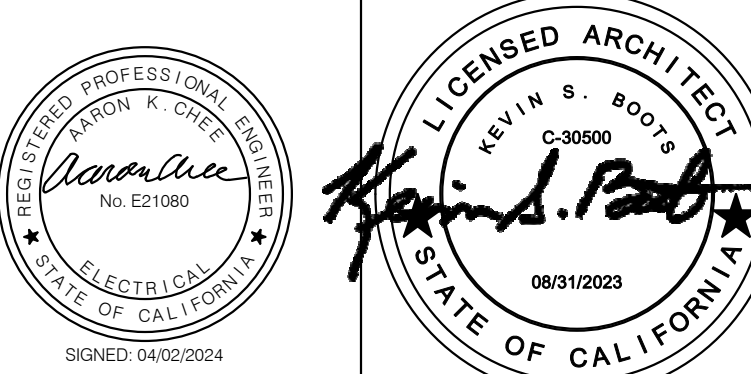

AGENCY APPROVALS

OSHPD # I240005-19-01

CONSULTANT



Long Beach // Irvine // Los Angeles
San Diego // San Jose // Seattle

p2sinc.com

ISSUE RECORD

04/09/2025	D	ADDENDUM D
03/14/2025	A	ADDENDUM A
01/31/2025	3	HCAI BACKCHECK 2
10/25/2024	2	HCAI BACKCHECK 1
06/13/2024	1	HCAI SUBMITTAL
04/18/2024		HCAI SUBMITTAL
DATE	△	DESCRIPTION



**HARBOR-UCLA MEDICAL CENTER
PHASE 2E INC 2 - GENERATOR BLDG.
RETROFIT**

1000 West Carson Street, Torrance, CA 90509


MILESTONE: HCAI SUBMITTAL

MILESTONE DATE: 10/25/2024


RBB PROJECT: 1712105 SCALE: 1/4" = 1'-0"


DESCRIPTION
ENLARGED SCADA, ATS-GEN
CONTROL, FIRE, AND COM PLAN

DU2-214

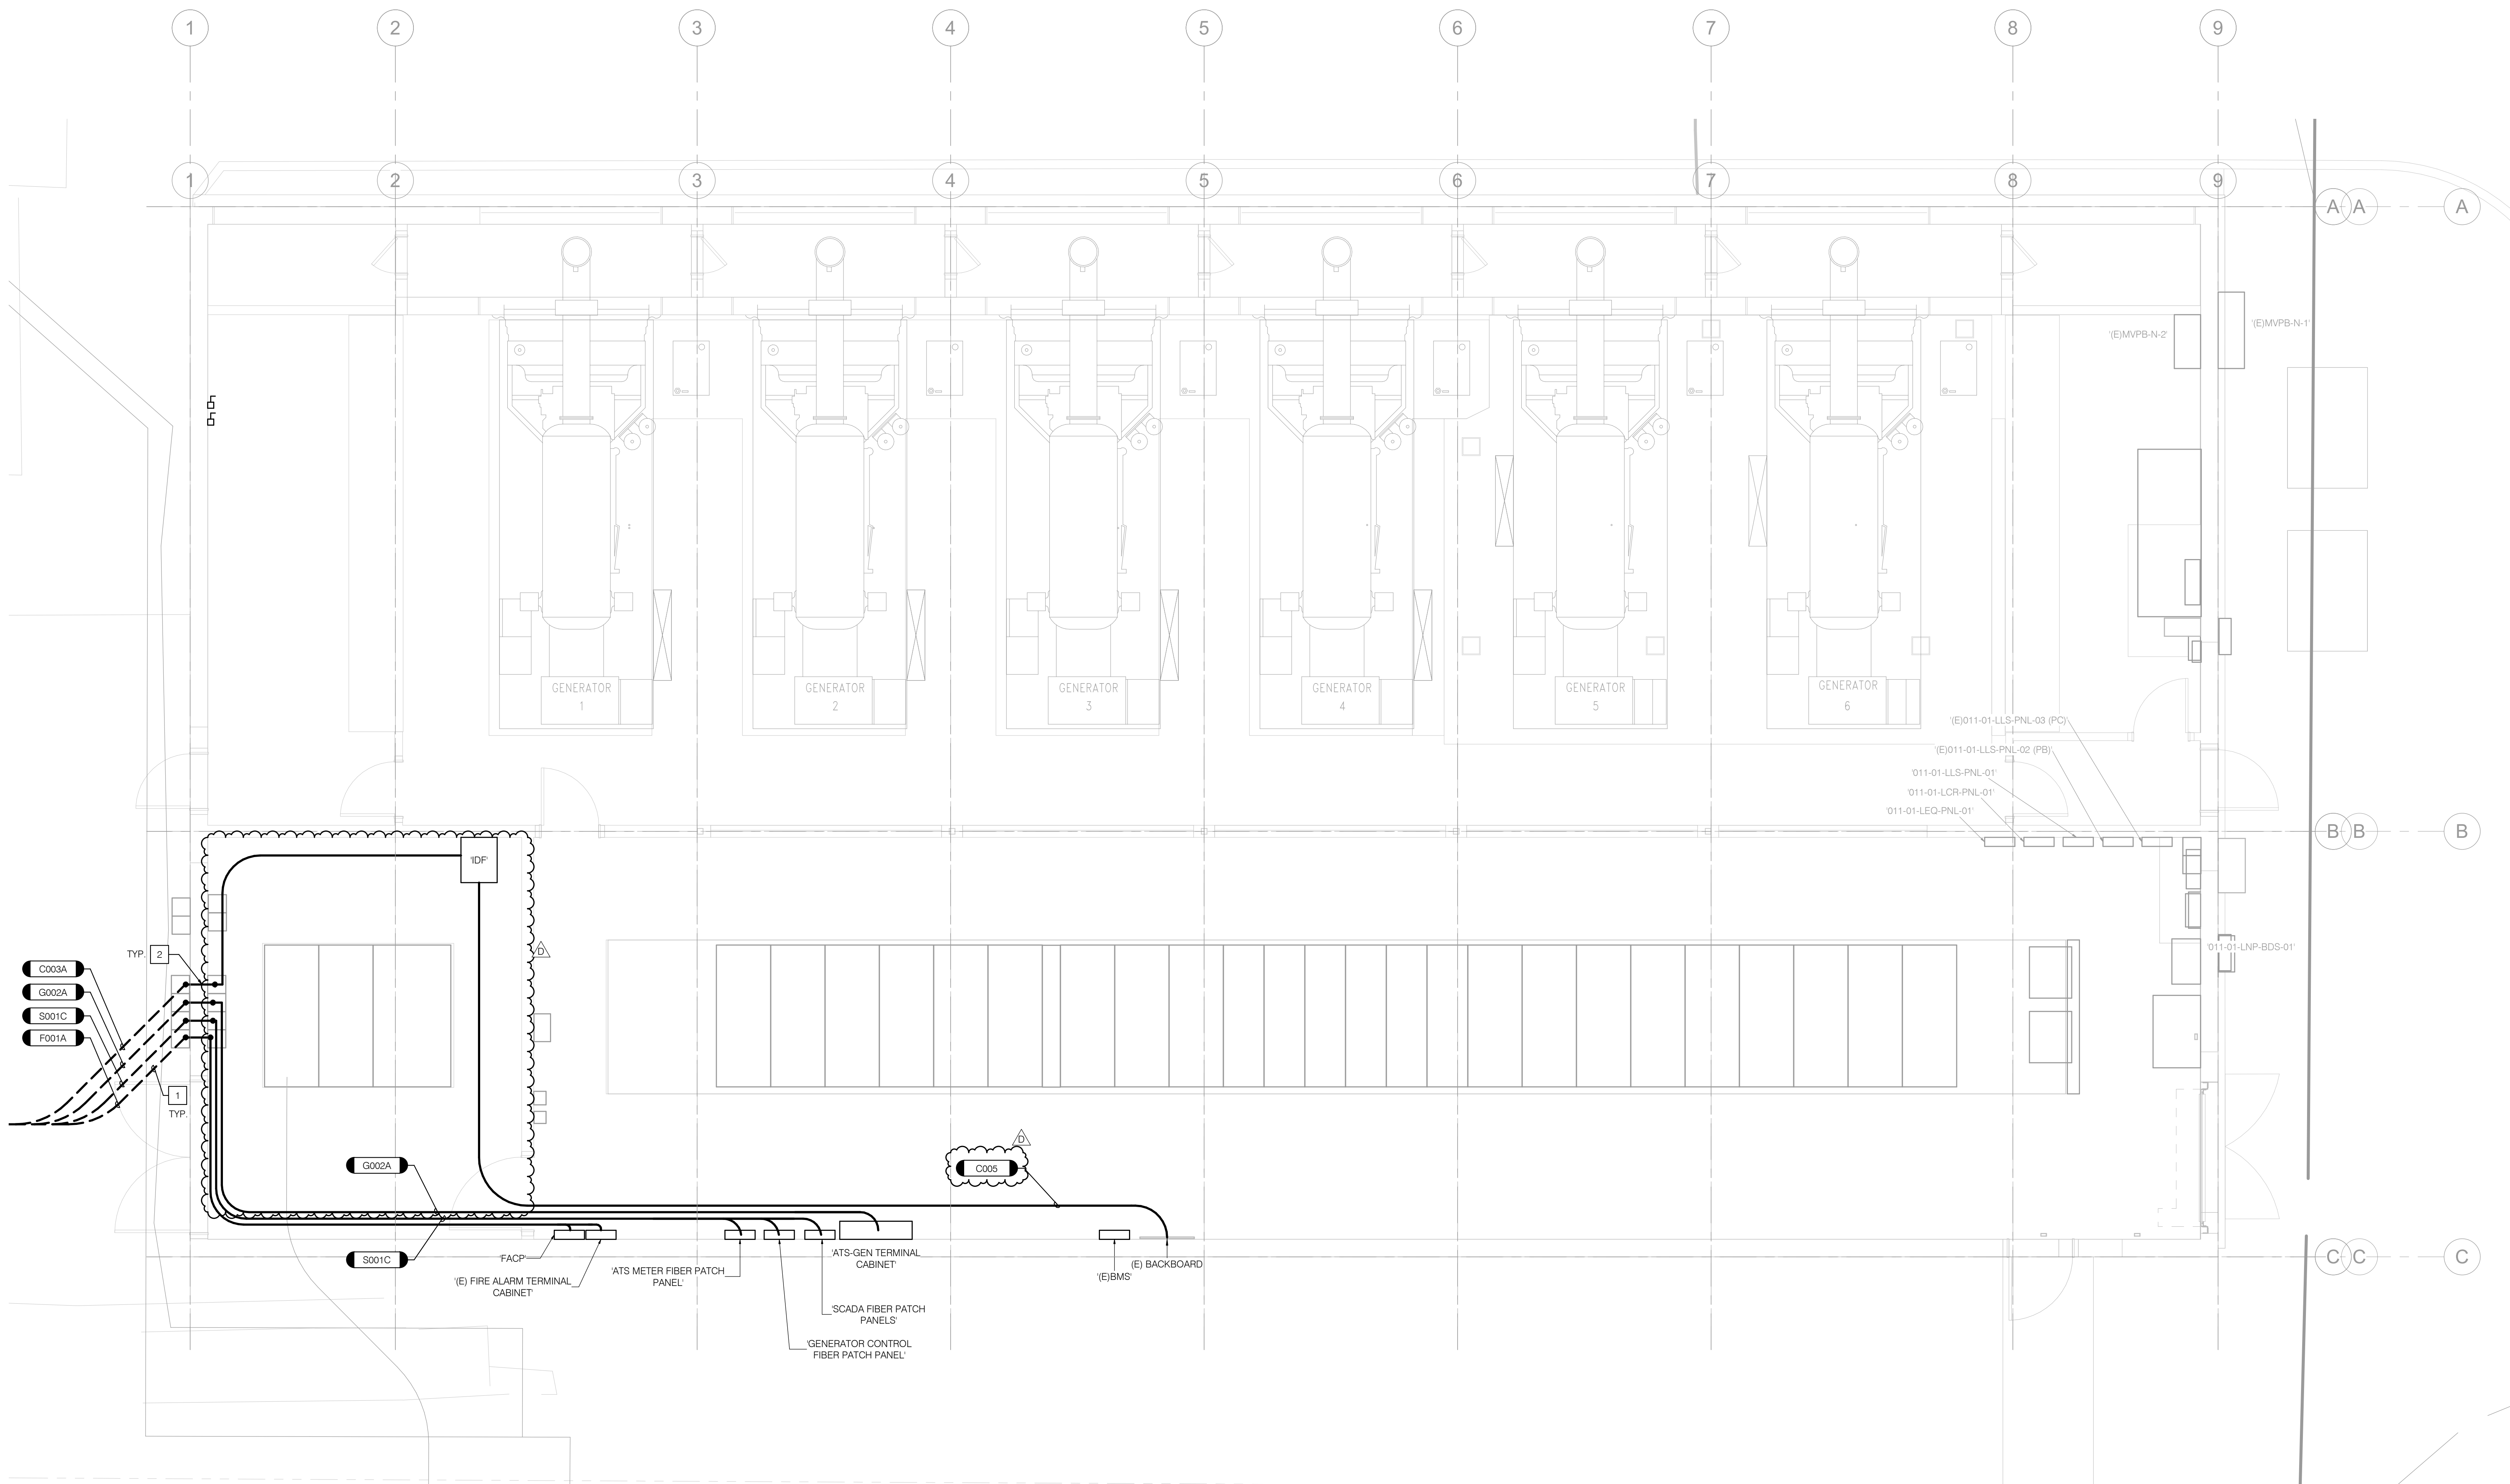


(MILESTONE 1)

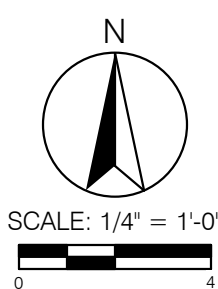

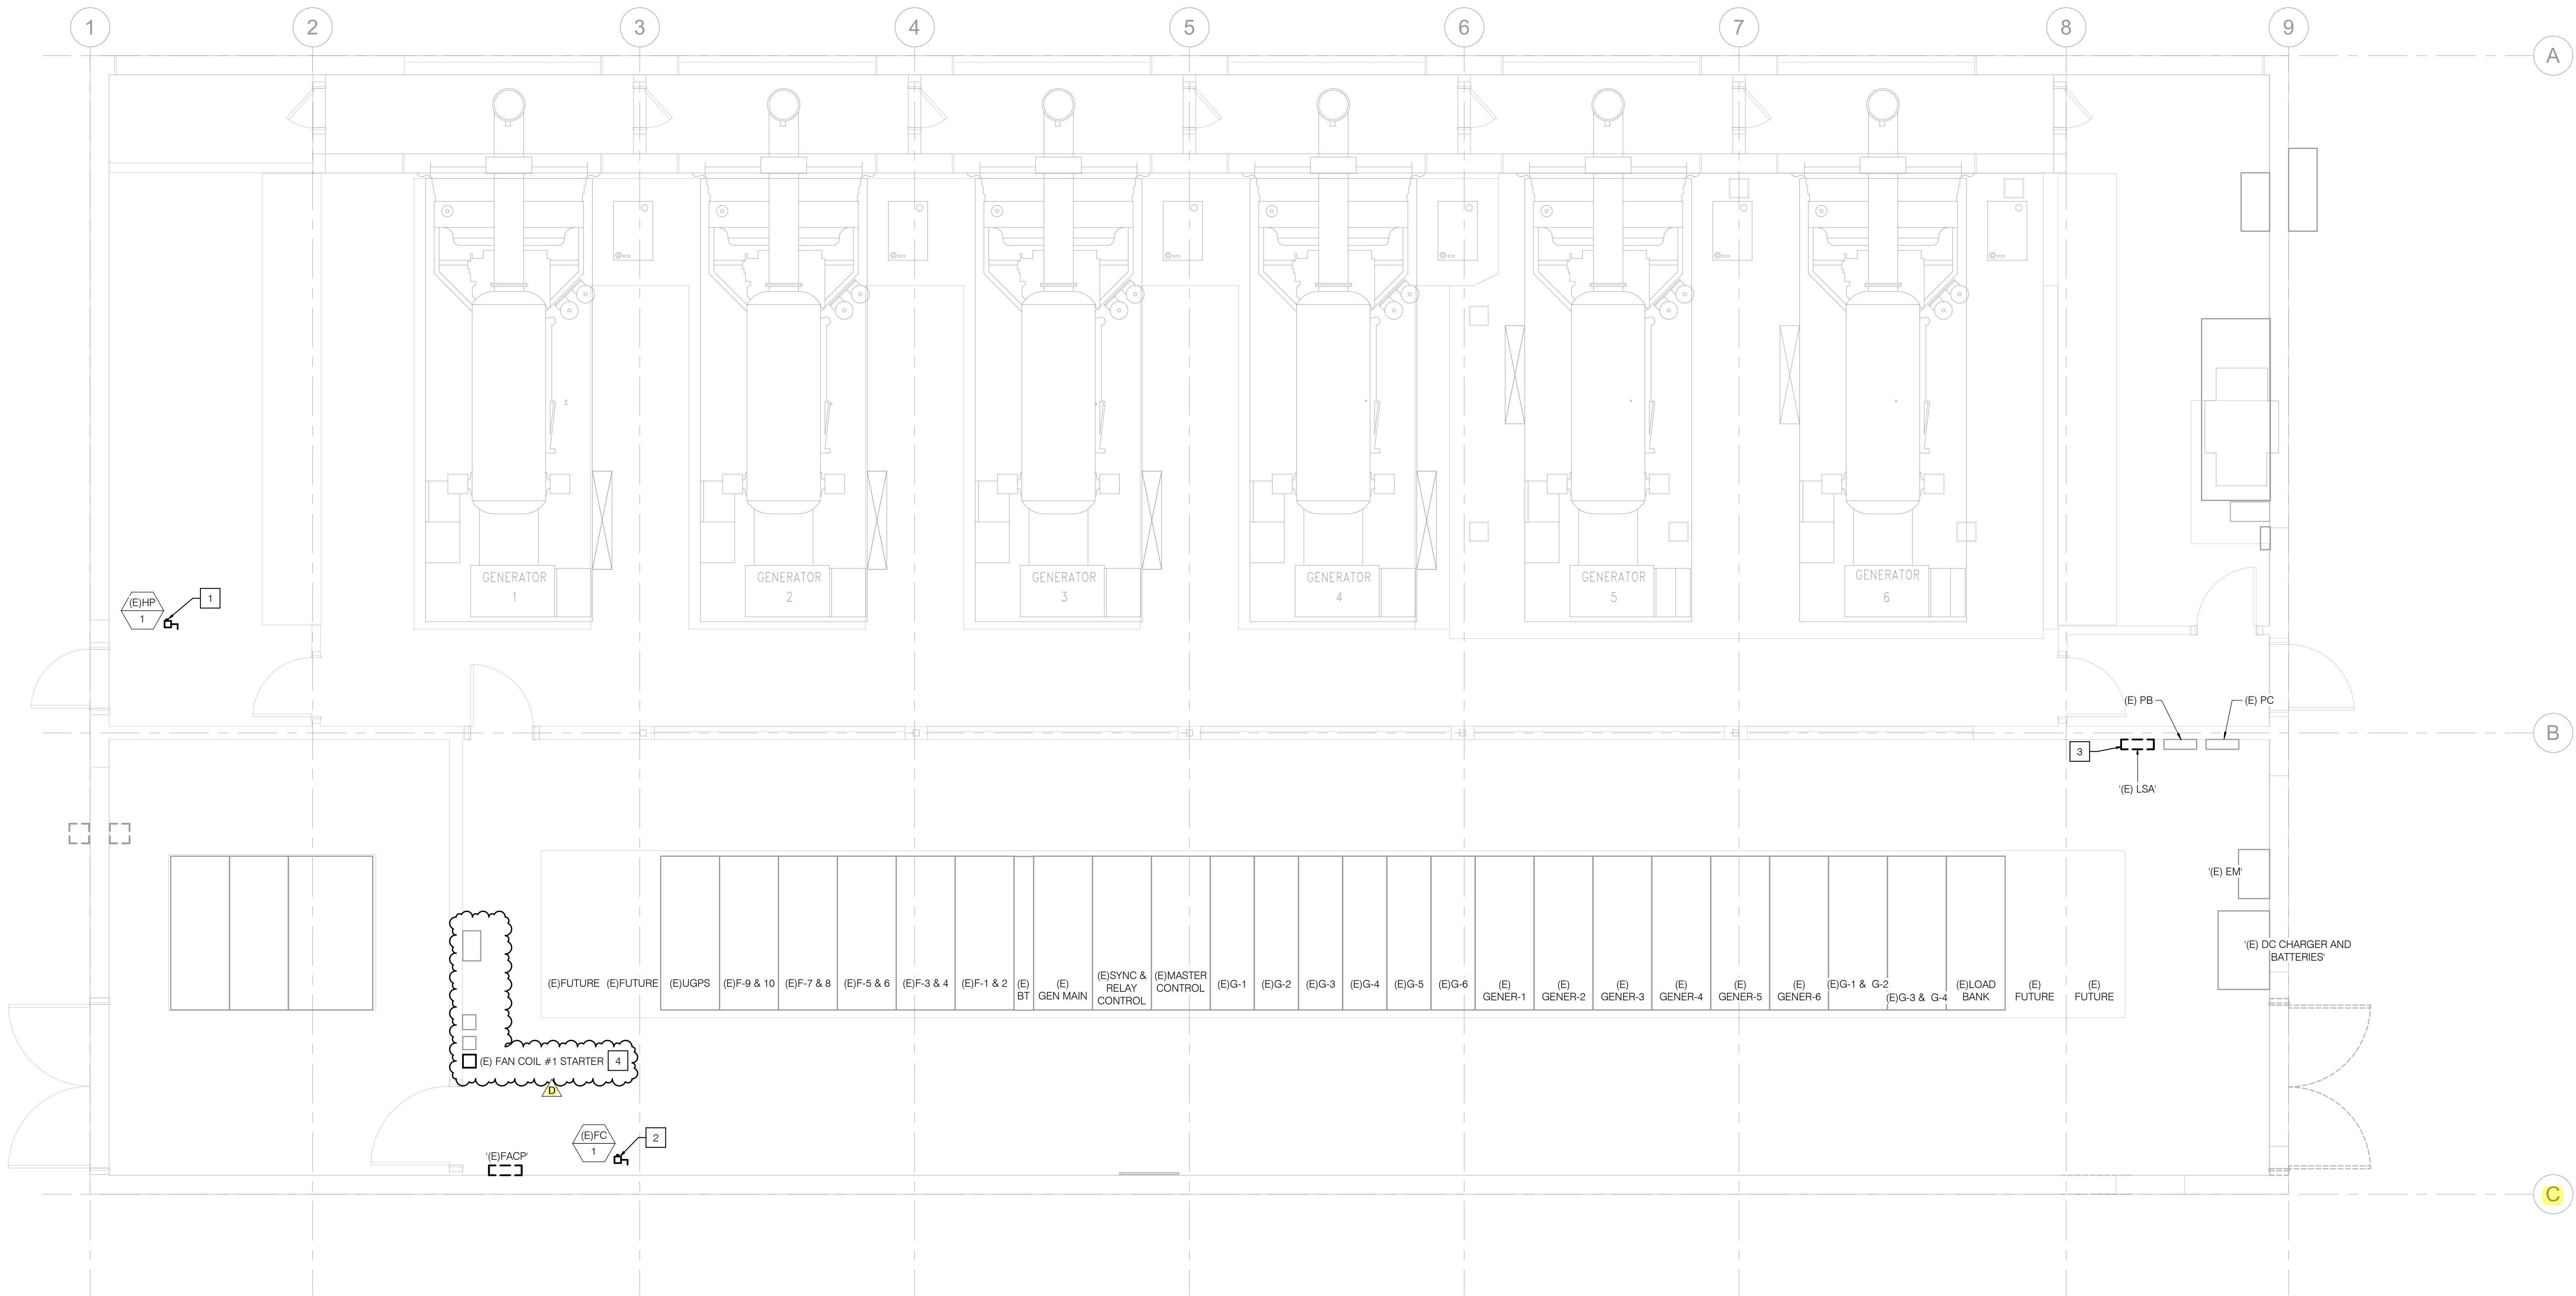

- NOTES
- 1 DEMOLISH (E) HEAT PUMP UNIT HP-1 AND CABLE BACK TO SOURCE. RETAIN SOME CONDUIT FOR REUSE.
 - 2 DEMOLISH (E) FAN COIL UNIT FC-1 AND CABLE BACK TO SOURCE. RETAIN SOME CONDUIT FOR REUSE.
 - 3 DEMOLISH (E) PANEL LSA. SEE SINGLE LINE DRAWING DU2-511.
 - 4 DEMOLISH (E) STARTER FOR FC-1 AND CABLE BACK TO SOURCE. RETAIN SOME CONDUIT FOR FUTURE REUSE.

(MILESTONE 1)

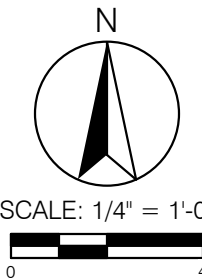


RBB ARCHITECTS INC

Joseph A. Balbons, AIA
Sylvia Botero, AIA
Kevin S. Boots, AIA

10980 Wilshire Boulevard
Los Angeles, California
90024-3905

Telephone 310 473 3555
Facsimile 310 473 3555
www.rbbinc.com

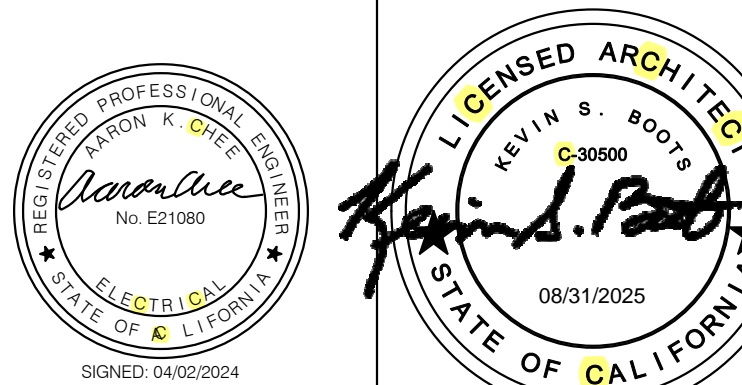

AGENCY APPROVALS

OSHPD # 1240005-19-01

CONSULTANT

p2s ENG

Long Beach // Irvine // Los Angeles
San Diego // San Jose // Seattle

p2sinc.com

ISSUE RECORD

DATE	DESCRIPTION
04/09/2025	D ADDENDUM D
04/01/2025	A HCAI BACKCHECK 3
03/14/2025	A ADDENDUM A
10/25/2024	2 HCAI BACKCHECK 1
06/13/2024	1 HCAI SUBMITTAL
04/18/2024	HCAI SUBMITTAL

Harbor-UCLA
MEDICAL CENTER

**HARBOR-UCLA MEDICAL CENTER
PHASE 2E INC 2 - GENERATOR BLDG.
RETROFIT**

1000 West Carson Street, Torrance, CA 90509


MILESTONE: HCAI SUBMITTAL

MILESTONE DATE: 10/25/2024

RBB PROJECT: 1712105 SCALE: 1/4" = 1'-0"

DESCRIPTION
**ENLARGED DEMOLITION
208/120VAC POWER PLAN - GEN
BLDG**

DU2-215.1

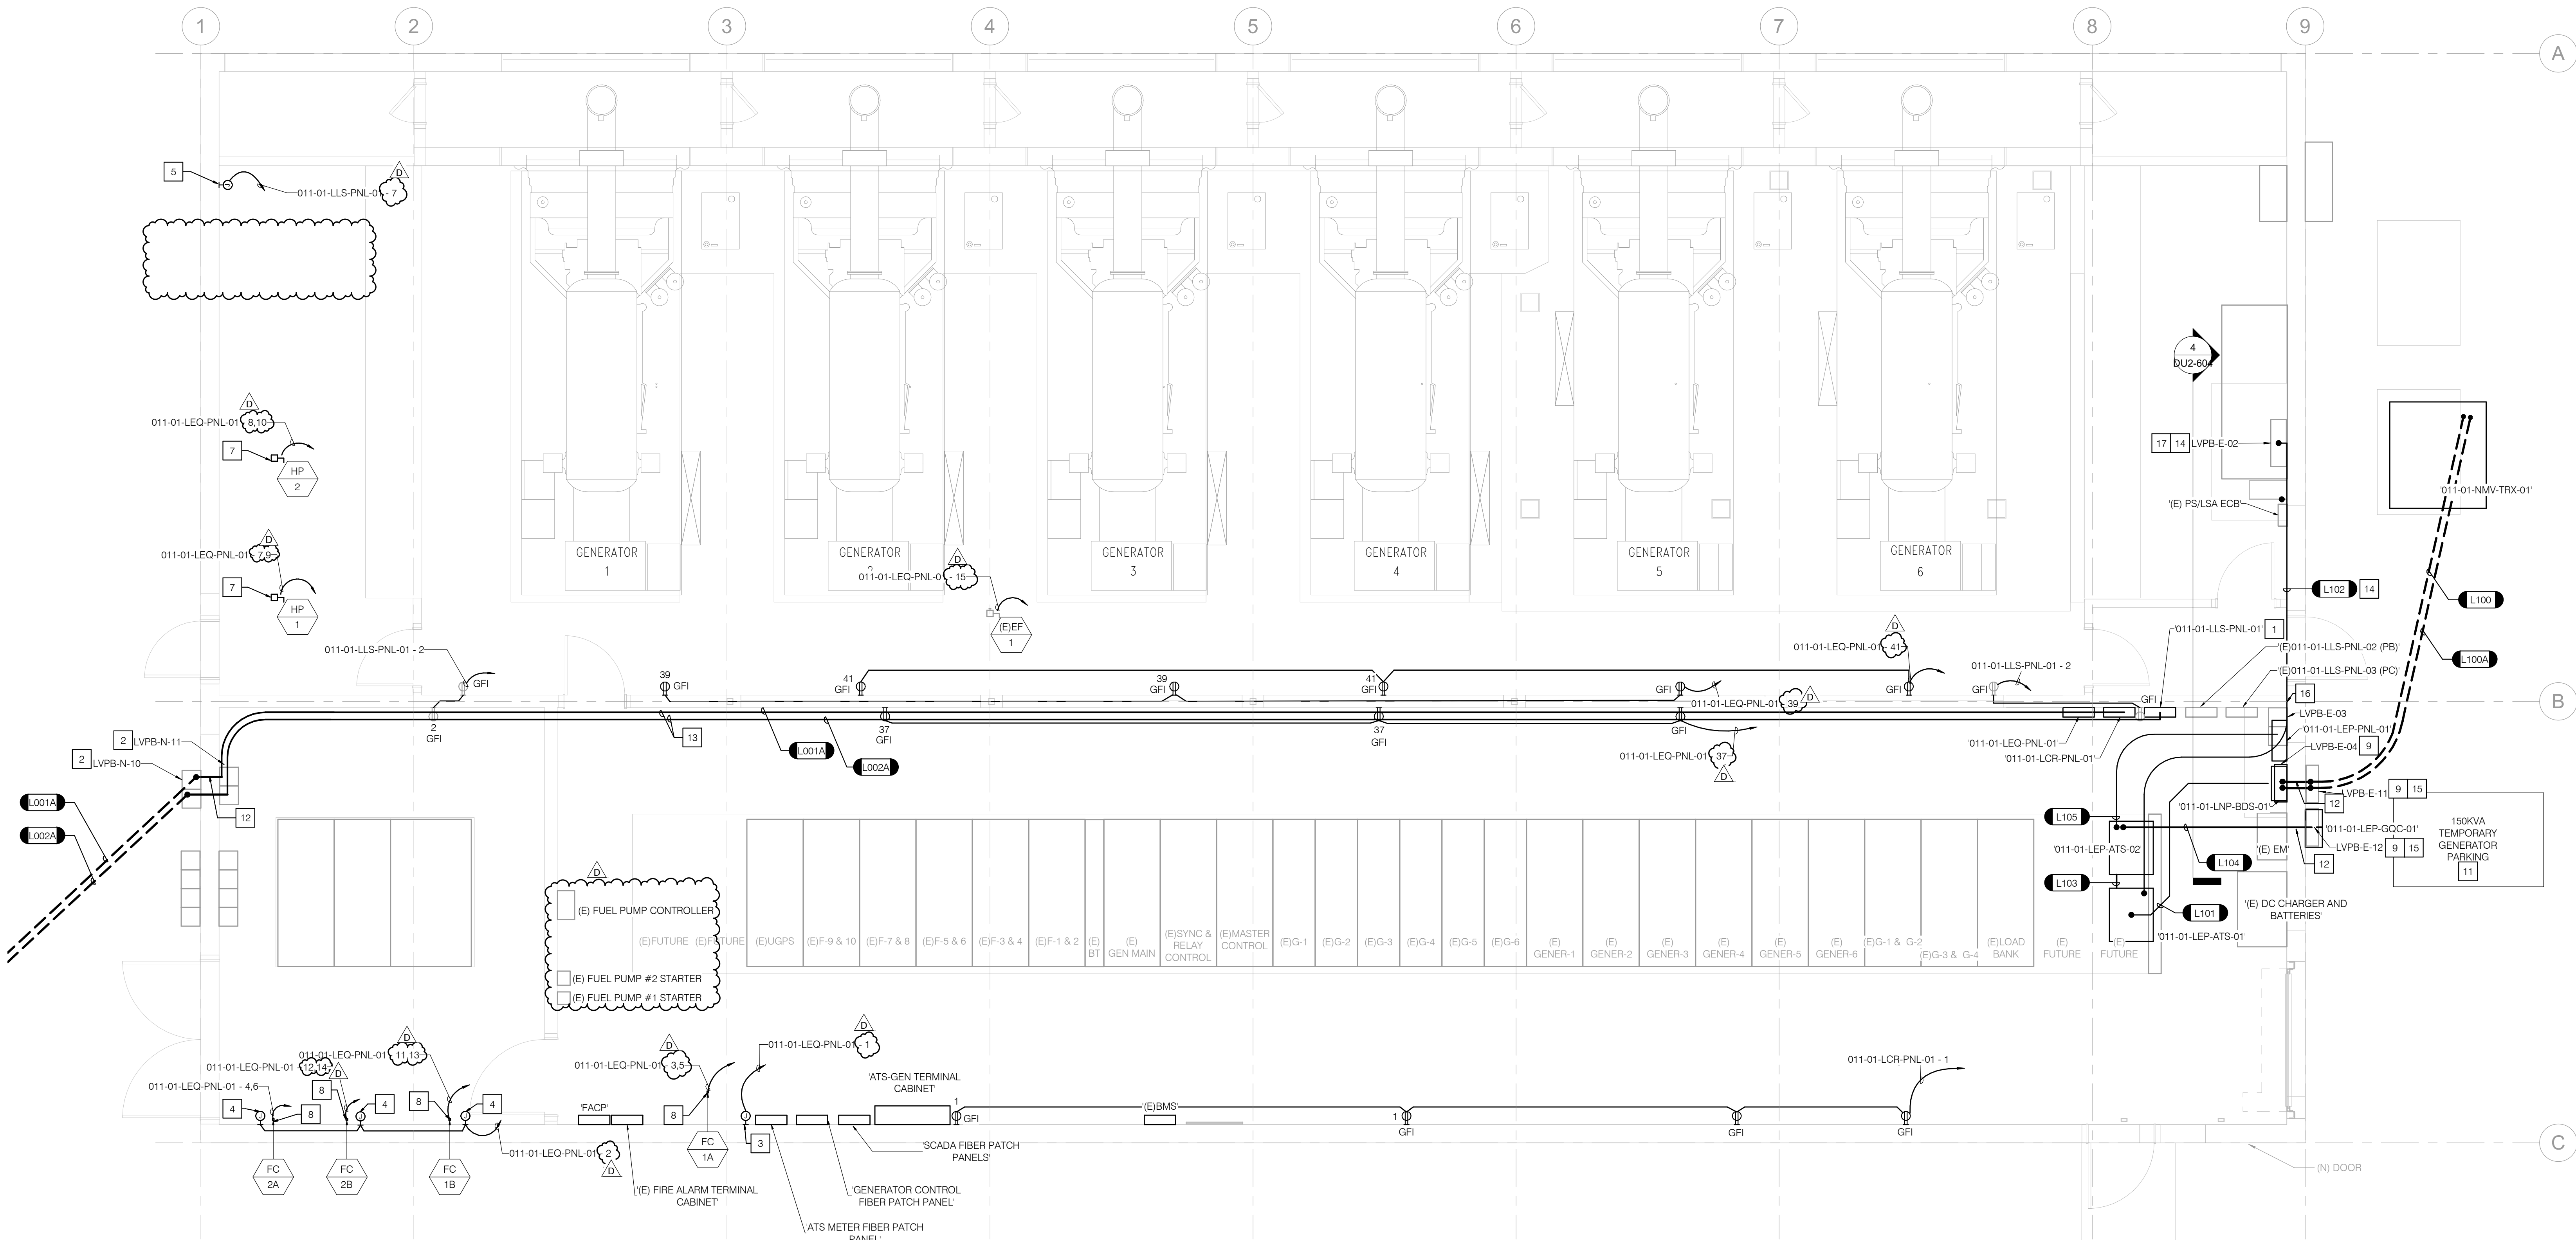

GENERAL NOTES

1. FOLLOW SINGLE LINE SHEET DU2-513.
2. FOLLOW DC SINGLE LINE DIAGRAM ON SHEET DU2-401.4.

NOTES

- 1 (E) PANEL DEMOLISHED PER SINGLE LINE SHEET DU2-511. CIRCUITS TO BE MOVED TO (E) PANEL PC PER PHASING SCHEDULES ON SHEET DU2-401.2 (N) PANEL TO BE INSTALLED IN PLACE.
- 2 PROVIDE MINIMUM 12"L X 12"W X 8"D LOW VOLTAGE PULLBOX.
- 3 PROVIDE 120V/1P POWER TO MECHANICAL CONTROLS TRANSFORMER.
- 4 PROVIDE 120V/1P POWER TO CONDENSATE DRAIN PUMP.
- 5 PROVIDE 120V/1P POWER TO LEAK DETECTION AND TANK MONITORING PANEL.
- 6 NOT USED.
- 7 PROVIDE 60AS/35AF 2P DISCONNECT FOR HEAT PUMP UNIT.
- 8 PROVIDE TOGGLE SWITCH DISCONNECT FOR FAN COIL UNIT.
- 9 PROVIDE MINIMUM 24"L X 24"W X 8"D LOW VOLTAGE PULL BOX.
- 10 NOT USED.
- 11 TEMPORARY GENERATOR MUST BE PARKED 5' FROM DOOR.
- 12 CORE DRILL AND SEAL AROUND CONDUITS.
- 13 MOUNT CONDUIT TO UNISTRUT ON WALL.
- 14 IN TERMINAL BOX LVPB-E-02 INSTALL MULTI TAP INSULATED CONNECTOR ON END OF CABLES.
- 15 PULLBOX WITH PAD LOCKABLE COVER.
- 16 SEAL HOLE AROUND CONDUITS.
- 17 PROVIDE MINIMUM 30"L X 30"W X 10"D LOW VOLTAGE SPLICE BOX.




RBB ARCHITECTS INC

Joseph A. Balbons, AIA
Sylvia Botero, AIA
Kevin S. Boots, AIA

10980 Wilshire Boulevard
Los Angeles, California
90024-3905

Telephone 310 473 3555
Facsimile 310 473 3555
www.rbbinc.com

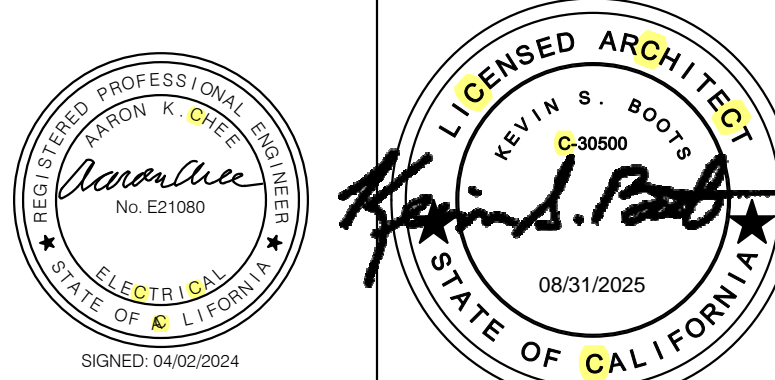

AGENCY APPROVALS

OSHPD # 1240005-19-01

CONSULTANT

P2S ENG

Long Beach // Irvine // Los Angeles
San Diego // San Jose // Seattle

p2sinc.com

ISSUE RECORD

DATE	DESCRIPTION
04/09/2025	D ADDENDUM D
04/01/2025	A HCAI BACKCHECK 3
03/14/2025	A ADDENDUM A
10/25/2024	2 HCAI BACKCHECK 1
06/13/2024	1 HCAI SUBMITTAL
04/18/2024	HCAI SUBMITTAL

Harbor-UCLA
MEDICAL CENTER
HARBOR-UCLA MEDICAL CENTER
PHASE 2E INC 2 - GENERATOR BLDG.
RETROFIT


1000 West Carson Street, Torrance, CA 90509

MILESTONE: HCAI SUBMITTAL
MILESTONE DATE: 10/25/2024
RBB PROJECT: 1712105 SCALE: 1/4" = 1'-0"

DESCRIPTION
ENLARGED 208/120VAC POWER
PLAN - GEN BLDG

DU2-215.2

(MILESTONE 1)

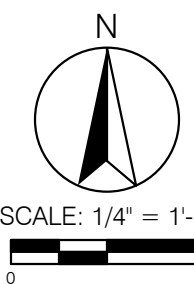

LIGHT FIXTURE SCHEDULE

TYPE	FIXTURE DESCRIPTION	MANUFACTURER & MODEL	TOTAL V-A	LAMP TYPE	LUMENS	COLOR TEMP	CRI	VOLTAGE	MTG	REMARKS
X1	EMERGENCY EXIT SIGN	PROGRESS LIGHTING #PETPE-UR-30-RC	3.6	LED				120/277		
S2	LED LINEAR WALL LIGHT	COLUMBIA LIGHTING #MPS4-9-40-HLHE-W-ED-U-NXS	41.7	LED	5800	4000K	90	U	WALL	MOUNT ON 2" 6" STEM, 8" 9" AFF.
S1	LED LINEAR WALL PACK	LITHONIA LIGHTING # TWX3-LED-P1-40K-MVOLT-PE-DBLND	65	LED	9450	4000K	90	MVOLT	WALL	
L1	LED LINEAR PENDANT LIGHT	COLUMBIA LIGHTING #MPS4-9-40-HLHE-W-ED-U-NXS	41.7	LED	5800	4000K	90	U	PENDANT	MOUNT ON 2" 6" STEM, 8" 9" AFF.

NOTES

1. INSTALL EATON FLIP OPEN FUSE BLOCKS WITH 3 AMP CO FUSES FOR ALL 3 PHASES. INSTALLED IN PROTECTIVE BOX.
2. INSTALL 4#12 AWG CABLES FROM TRANSFORMER OUTPUT LUGS TO FLIP OPEN FUSE.
3. PULLBOX LVPB-E-04.
4. INSTALL CABLE FROM TRANSFORMER TO PULL BOX LVPB-E-04 AND EXTEND CONDUIT AND CABLE ABOVE PULL BOX TO 3 POLE TOGGLE SWITCH.
5. FROM TOGGLE SWITCH USE ONE PHASE TO RUN TO EMERGENCY RELAY.
6. TOGGLE SWITCH TO BE TURNED OFF IN MILESTONE 2 AND KEPT OFF UNTIL MILESTONE 3 AND TRANSFORMER 011-01-NMV-TRX-01 INPUT SWITCH IS CHANGED TO INPUT B. SEE SINGLE LINE DU2-633.




RBB ARCHITECTS INC

Joseph A. Balbons, AIA
Sylvia Botero, AIA
Kevin S. Boots, AIA

10980 Wilshire Boulevard
Los Angeles, California
90024-3905

Telephone 310 473 3555
Facsimile 310 473 3555
www.rbbinc.com

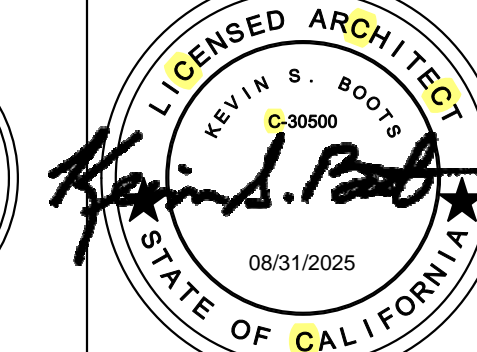

AGENCY APPROVALS

OSHPD # 1240005-19-01

CONSULTANT

p2s ENG

Long Beach // Irvine // Los Angeles
San Diego // San Jose // Seattle

p2sinc.com

ISSUE RECORD

DATE	DESCRIPTION
04/09/2025	D - ADDENDUM D
03/14/2025	A - ADDENDUM A
01/31/2025	3 - HCAI BACKCHECK 2
10/25/2024	2 - HCAI BACKCHECK 1
06/13/2024	1 - HCAI SUBMITTAL

Harbor-UCLA
MEDICAL CENTER
HARBOR-UCLA MEDICAL CENTER
PHASE 2E INC 2 - GENERATOR BLDG.
RETROFIT

1000 West Carson Street, Torrance, CA 90509


MILESTONE: HCAI SUBMITTAL

MILESTONE DATE: 10/25/2024


RBB PROJECT: 1712105 SCALE: As indicated

DESCRIPTION
ENLARGED NEW LIGHTING
PLAN - GEN BLDG


DU2-216.2

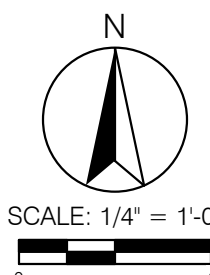


(MILESTONE 1)

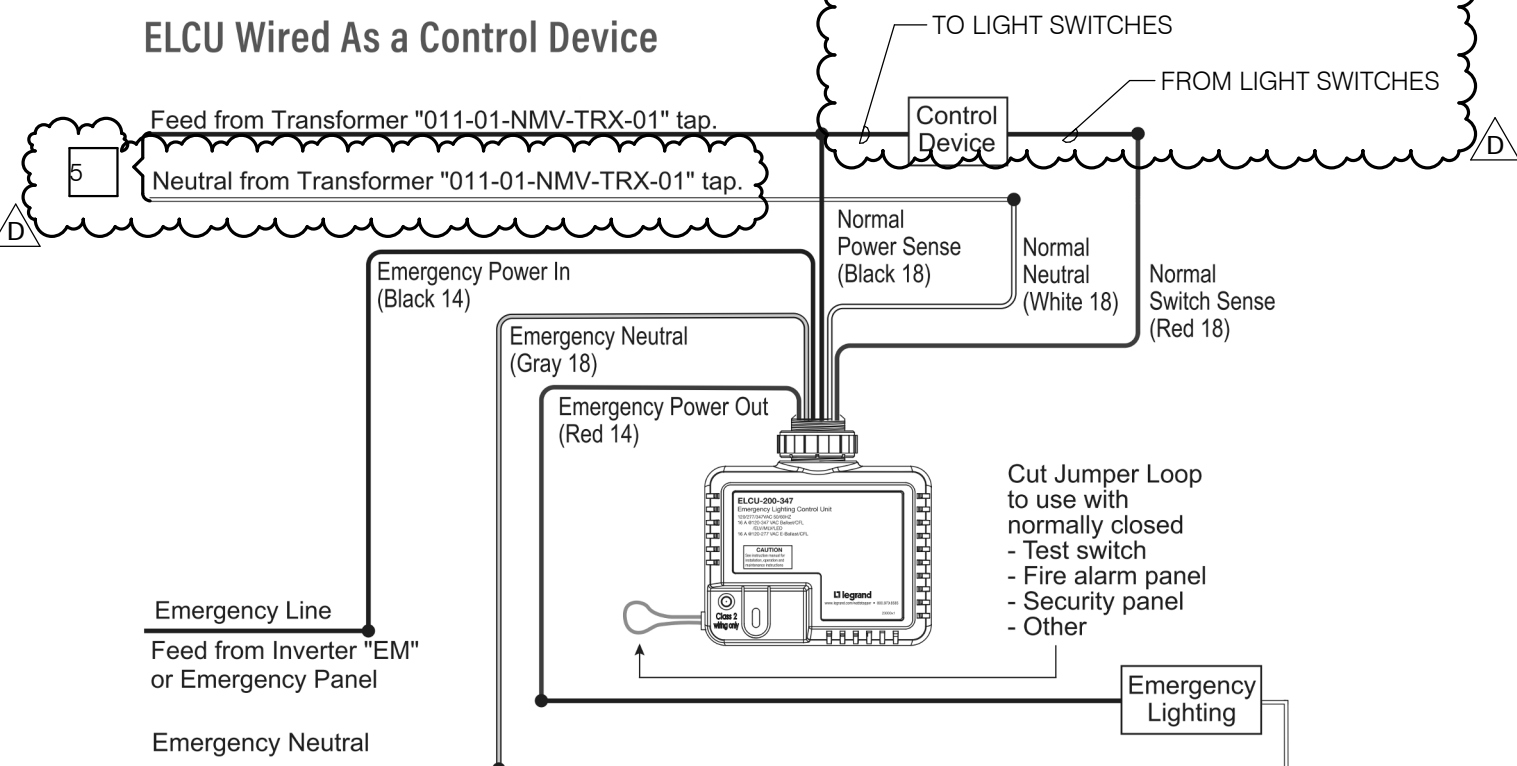

2 EMERGENCY RELAY WIRING DIAGRAM
SCALE: NONE

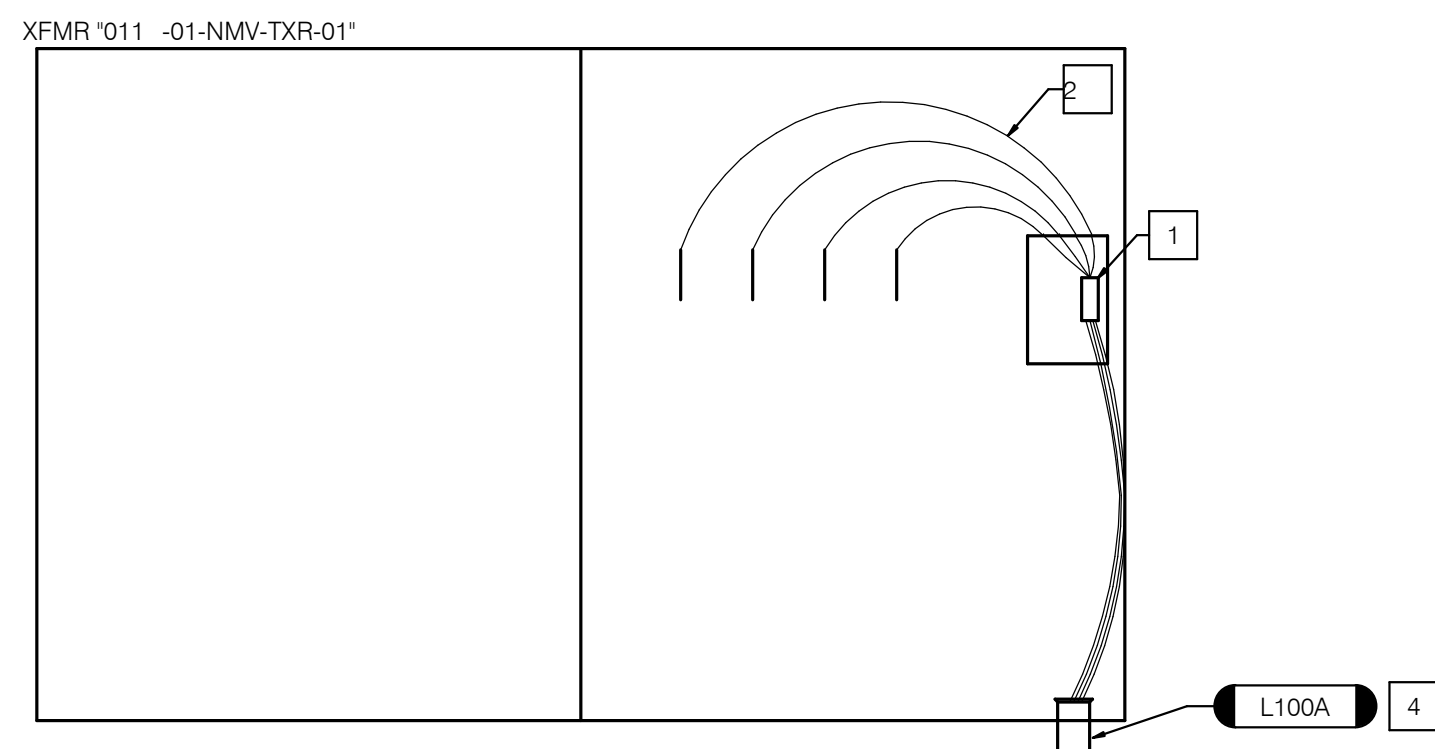

3 HOUSE TRANSFORMER 011-01-NMV-TRX-01 TAP
SCALE: NONE

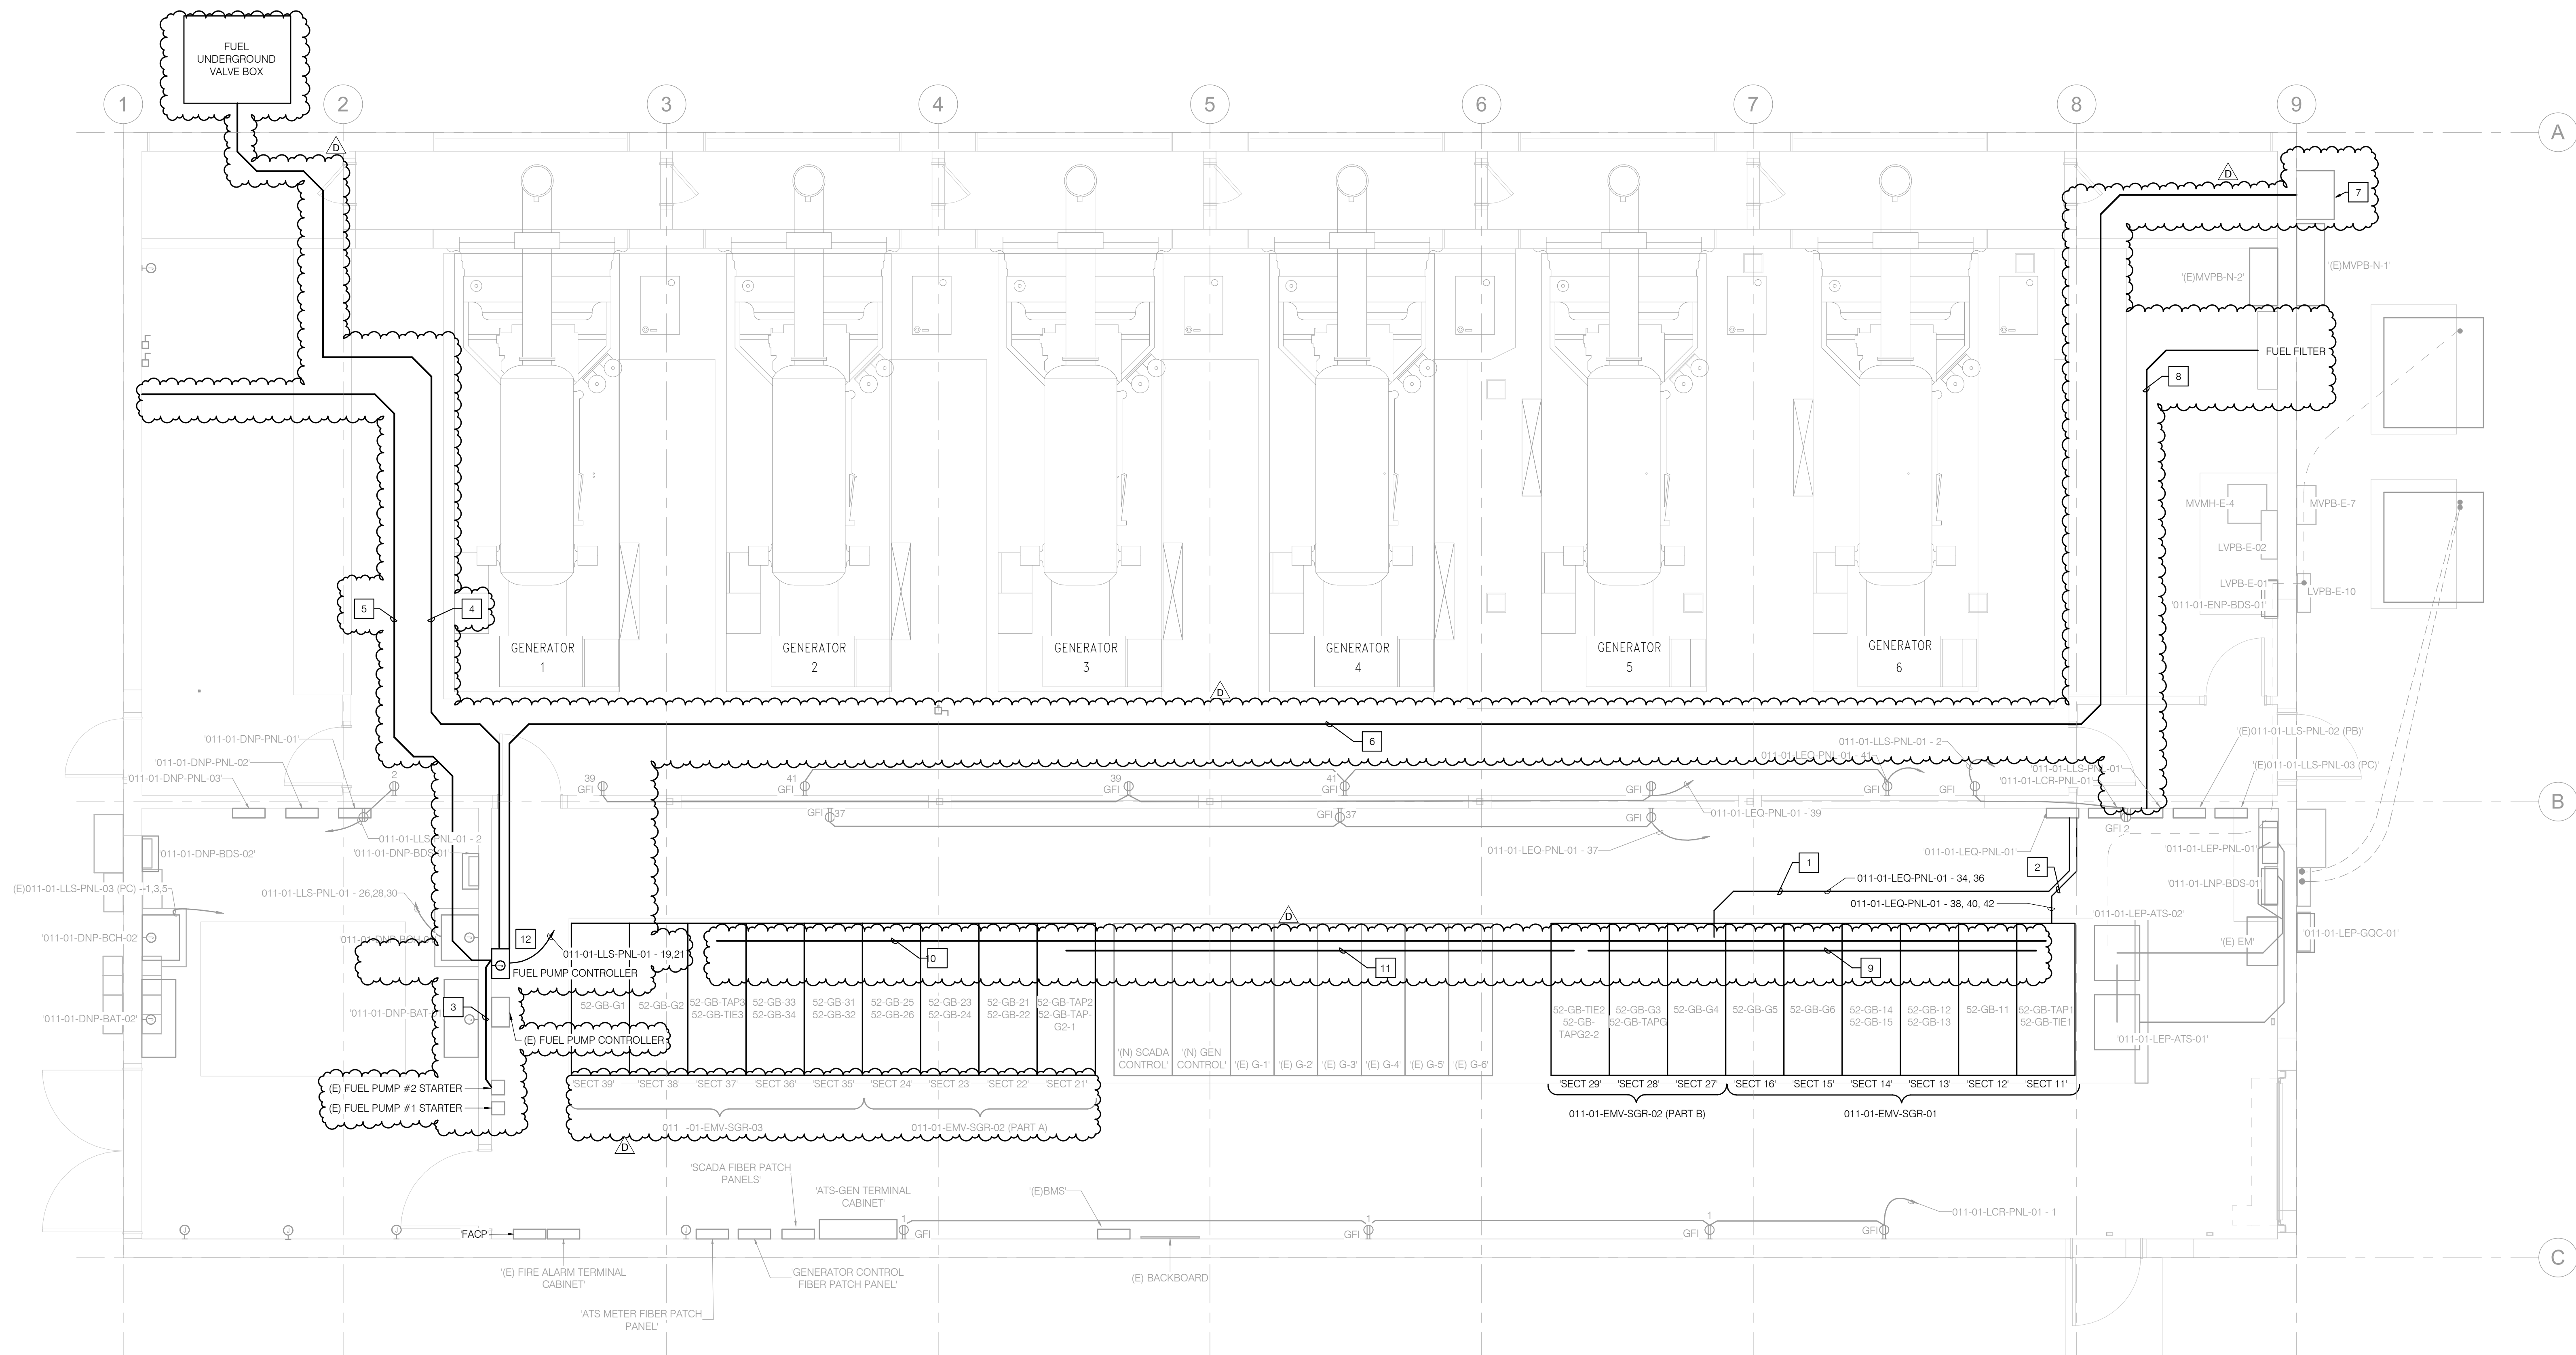

GENERAL NOTES

A. FOLLOW SINGLE LINE SHEET DU2-513.

NOTES

1. PROVIDE 3/4" - 4#12 AWG & 1#12 AWG GND FOR SWITCHGEAR HEATER BLOCKS AND LIGHTS.
2. PROVIDE 3/4" - 6#12 AWG & 1#12 AWG GND FOR SWITCHGEAR HEATER BLOCKS AND LIGHTS.
3. PROVIDE (2) 3/4" CONDUIT FROM PULL BOX UNDER STARTERS FOR RECONNECTION OF FUEL PUMPS TO NEW CONTROL PANEL.
4. PROVIDE (2) 3/4" FROM UNDERGROUND FUEL VALVE BOX TO FUEL PUMP CONTROL PANEL. PROVIDE 6#12 AWG AND 1#12 AWG GND CABLES IN CONDUIT.
5. PROVIDE (2) 3/4" FROM EXISTING FUEL VALVES TO FUEL PUMP CONTROL PANEL.
6. PROVIDE (4) 1 1/4" FROM FUEL PUMP CONTROLLER TO PULLBOX. PROVIDE 4#6 AWG AND 1#8 AWG GND CABLES IN TWO OF THE CONDUITS.
7. TRANSITION AT PULLBOX TO (4) 2" UNDERGROUND CONDUITS TO FUEL TANKS. PULLBOX TO BE LOCKABLE.
8. PROVIDE 3/4" WITH 3#12 AWG AND 1#12 AWG CABLES FROM PANEL 011-01-LLS-PNL-01 TO FUEL FILTER SYSTEM.
9. PROVIDE 3/4" WITH 3#10 AWG AND 1#10 AWG CABLES FROM CTS IN SECTION 29 TO DIFFERENTIAL IN SECTION 11.
10. PROVIDE 3/4" WITH 3#10 AWG AND 1#10 AWG CABLES FROM CTS IN SECTION 11 TO DIFFERENTIAL IN SECTION 37.
11. PROVIDE 3/4" WITH 3#10 AWG AND 1#10 AWG CABLES FROM CTS IN SECTION 29 TO DIFFERENTIAL IN SECTION 21.
12. PROVIDE 208/2P POWER TO FUEL CONTROL PANEL IN 3/4" WITH 3#10 AWG AND 1 #12 AWG GND.




RBB ARCHITECTS INC

Joseph A. Ballbons, AIA
Sylvia Botero, AIA
Kevin S. Boots, AIA

10980 Wilshire Boulevard
Los Angeles, California
90024-3905

Telephone 310 473 3555
Facsimile 310 473 3555
www.rbbinc.com

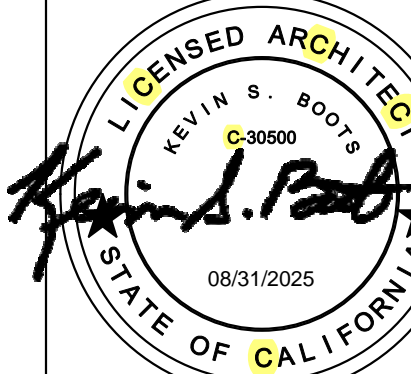

AGENCY APPROVALS

OSHPD # 1240005-19-01

CONSULTANT



Long Beach // Irvine // Los Angeles
San Diego // San Jose // Seattle

p2sinc.com

ISSUE RECORD

DATE	DESCRIPTION
04/09/2025	D ADDENDUM D
03/14/2025	A ADDENDUM A
01/31/2025	3 HCAI BACKCHECK 2
10/25/2024	2 HCAI BACKCHECK 1
06/13/2024	1 HCAI SUBMITTAL
04/18/2024	HCAI SUBMITTAL
DATE	DESCRIPTION



HARBOR-UCLA MEDICAL CENTER
PHASE 2E INC 2 - GENERATOR BLDG.
RETROFIT

1000 West Carson Street, Torrance, CA 90509


MILESTONE: HCAI SUBMITTAL

MILESTONE DATE: 10/25/2024

RBB PROJECT: 1712105 SCALE: 1/4" = 1'-0"

DESCRIPTION
ENLARGED 208/120VAC POWER
PLAN - GEN BLDG

(MILESTONE 4)

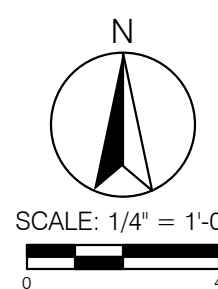

DU2-245

Print Date: 4/9/2025 6:06:27 PM

LOCATION : BUILDING 11			VOLTAGE/PHASE :			120/208V, 3Ø, 4W			FED FROM : HOUSE XFMR				
FLOOR : LEVEL 1			BUS AMPS :			225A			RATING : 10 KAIC				
MOUNTING : SURFACE			MAIN BREAKER :			MLO							
CKT	TYPE	LOADS	BKR/POLE	VOLT.:			VOLT.:			BKR/POLE	LOADS	TYPE	
				A	B	C	A	B	C				
1	P	(E) EM LTG UNIT	35 A	2	1,500		360		1	20 A	(E) RECEPT	R	
3					1,500		500		1	20 A	(E) TELEPHONE	R	
5		SPARE	20 A	1					1	20 A	(E) FACP	P	
7		SPARE	20 A	1				500	1	20 A	SPACE	8	
9		LLD ALARM	20 A	1	400						SPACE	10	
11		LLD CONTROLLER	20 A	1		400					SPACE	12	
13		SPACE									SPACE	14	
15		SPACE									SPACE	16	
17		SPACE									SPACE	18	
19		SPACE									SPACE	20	
21		SPACE									SPACE	22	
23		SPACE									SPACE	24	
25												26	
27		MAIN	50 A	3								28	
29												30	
31												32	
33												34	
35												36	
37												38	
39												40	
41					1,500	1,900	400	360	500	500			42
TOTAL 3A =				1,860	VOLT-AMPS								
TOTAL 0B =				2,400	VOLT-AMPS								
TOTAL 0C =				900	VOLT-AMPS								
TOTAL PANEL =				5,160	VA @ 208V, 3Ø =				14.3 AMPS				

(E) PANEL: PC			LOCATION: BUILDING 11				VOLTAGE/PHASE: 120/208V, 3Ø, 4W				FED FROM: (E) PANEL 2				
			FLOOR: LEVEL 1				BUS AMPS: 235A				MAIN BUS RATING: 10 KAC				
			MOUNTING: SURFACE				MAIN BREAKER: MLO								
CKT	TYPE	LOADS	BKPR/POLE	VOLT-AMPS			VOLT-AMPS			BKPR/POLE	LOADS	TYPE			
				A	B	C	A	B	C						
1				500			300			1	20 A	(E) MECH CTR DT CONT	M	2	
3	M	(E) FUEL PUMP	20 A 2		500			360		1	20 A	(E) ELEC RMS RBC	R	4	
5					500				100	1	20 A	(E) FUEL ALARM	P	6	
7	M	(E) FUEL PUMP 2	20 A 2		500					1	20 A	SPARE	P	8	
9					1,800			200		1	20 A	(E) CONTROL CVB CC	P	10	
11	P	(E) STAT. BATT.	30A 2			1,800			200	1	20 A	(E) CONTROL VT CVB	P	12	
13		SPARE	20 A 1	0			1,520			1	20 A	(E) LTG 101, 102	L	14	
15	M	(E) EF-1	20 A 1		500			1,360		1	20 A	(E) LTG 102	L	16	
17		SPARE	20 A 1			0				1	20 A	SPARE	P	18	
19		SPARE	30A 1	0						1	20 A	(E) FUEL CONT. RELAY	P	20	
21	M	(E) GS PUMP	20 A 1		1,200			1,200		1	20 A	(E) LTG 104	L	22	
23	P	(E) GS BATT CHGR	30 A 1			1,200			800	1	20 A	(E) LTG 104	L	24	
25	P	(E) GS HTR JWH	30 A 1	1,800			1,500			1	20 A	(E) LTG 103, 4, 6	L	26	
27	P	(E) GS HTR JWH	30 A 1		1,800			1,800		1	20 A	(E) EXTERIOR LTG	L	28	
29							1,200			1,200	1	20 A	(E) G6 PUMP	M	30
31	P	(E) GS HTR GEN SPACE	20 A 1		1,200			1,200		1	20 A	(E) G6 BATT CHGR	P	32	
33		SPACE	-	-	-	-			1,800	1	30 A	(E) G6 HTR JWH	P	34	
35		SPACE	-	-	-	-				1	30 A	(E) G6 HTR JWH	P	36	
37		SPACE	-	-	-	-			1,200	2	20 A	(E) G6 HTR GEN SPACE	P	40	
39		SPACE	-	-	-	-				-	-	SPACE	P	42	
41				4,000	5,800	4,700	4,520	7,920	4,100						

TOTAL ØA = 8,520 VOLT-AMPS

TOTAL ØB = 13,720 VOLT-AMPS

TOTAL ØC = 8,800 VOLT-AMPS

TOTAL PANEL = 31,040 VA @ 208V, 3Ø = 86.2 AMPS

(E) PANEL: PB			LOCATION : BUILDING 11 FLOOR : LEVEL 1 MOUNTING : SURFACE			VOLTAGE/PHASE : BUS AMPS : MAIN BREAKER :			120/208V, 3Ø, 4W 400A MLO			FED FROM : (E) HOUSE XFMR RATING : 10 KAIC							
CKT	TYPE	LOADS	BKR/POLE		VOLT-AMPS				VOLT-AMPS			BKR/POLE	LOADS	TYPE	CKT				
					A	B	C		A	B	C								
1		PANEL PC	150A 3						1,000			1	20 A	(E) G2 BATT	P 2				
3						13,720			200			1	20 A	(E) G2 TANK	P 4				
5										1,000		1	20 A	(E) G2 HTR	P 6				
7					8,520				1,656			1	20 A	(E) G2 PUMP	M 8				
9									2,500			1	30 A	(E) G2 HTR JWR	P 10				
11								7,600				2,500	1	30 A	(E) G2 HTR JWR	P 12			
13	P	(E) G3 HTR		20 A	1	1,000			1,000			1	20 A	(E) G4 HTR	P 14				
15	P	(E) G3 BATT		20 A	1		1,000			1,000		1	20 A	(E) G4 BATT	P 16				
17	P	(E) G3 TANK	20 A	1			200				200	1	20 A	(E) G4 TANK	P 18				
19	M	(E) G3 PUMP	20 A	1	1,656				1,656			1	20 A	(E) G4 PUMP	M 20				
21	P	(E) G3 HTR JWR	30 A	1		2,500			2,500			1	30 A	(E) G4 HTR JWR	P 22				
23	P	(E) G3 HTR JWR	30 A	1			2,500				2,500	1	30 A	(E) G4 HTR JWR	P 24				
25					3,213				1,000			1	20 A	(E) G1 HTR	P 26				
27	M	(E) HP-1	40 A	3		3,213			1,000			1	20 A	(E) G1 BATT	P 28				
29							3,213				200	1	20 A	(E) G1 TANK	P 30				
31	M	(E) FC-1	20 A	2	562				1,656			1	20 A	(E) G1 PUMP	P 32				
33						562			2,500			1	30 A	(E) G1 HTR JWR	P 34				
35		SPACE	-	-								2,500	1	30 A	(E) G1 HTR JWR	P 36			
37		SPACE	-	-								1	20 A	SPARE	P 38				
39		SPACE	-	-								1	20 A	SPARE	P 40				
41		SPACE	-	-								1,000	1	20 A	EXIST. SERV	P 42			
					14,951	20,995	13,513		7,968	9,700	9,900								
TOTAL ØA = 22,919 VOLT-AMPS																			
TOTAL ØB = 30,695 VOLT-AMPS																			
TOTAL ØC = 23,413 VOLT-AMPS																			
TOTAL PANEL = 77,027					VA @ 208V, 3Ø =					214.0 AMPS									


1. REFER TO SHEET DU2-006 FOR STEP SEQUENCE

- 1 POWER METER READING FROM 02/20/2024 TO 02/26/2024 INCLUDING 125% DEMAND FACTOR.
- 2 POWER METER READING FROM 02/20/2024 TO 02/26/2024 INCLUDING 125% DEMAND FACTOR SHOWS PANEL PB AT 162 AMPS. CONNECTED LOADS ARE SHOWN ON THE SCHEDULE.



10980 Wilshire Boulevard
Los Angeles, California
90024-3905

Telephone 310 473 3555
Facsimile 310 473 3555
www.rbbiinc.com

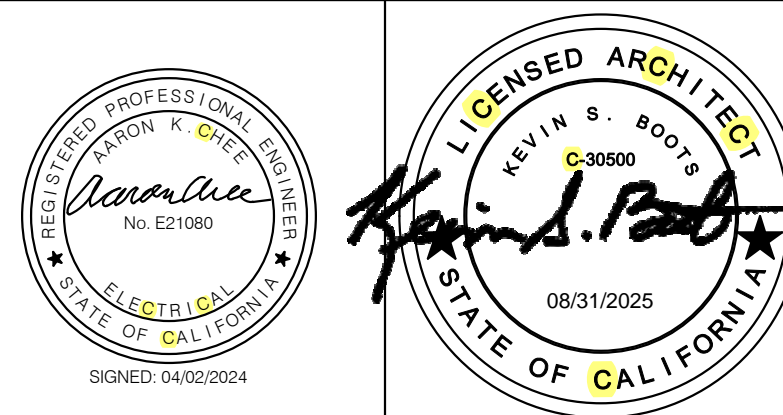

AGENCY APPROVALS

OSHPD # I240005-19-01

CONSULTANT



Long Beach // Irvine // Los Angeles
San Diego // San Jose // Seattle

p2sinc.com

ISSUE RECORD

DATE	DESCRIPTION
04/09/2025	D ADDENDUM D
04/01/2025	4 HCAl BACKCHECK 3
03/14/2025	A ADDENDUM A
01/03/2025	5 HCAl BACKCHECK 2
10/25/2024	2 HCAl BACKCHECK 1
06/13/2024	1 HCAl SUBMITTAL
04/18/2024	-



**HARBOR-UCLA MEDICAL CENTER
PHASE 2E INC 2 - GENERATOR BLDG
RETROFIT**

1000 West Carson Street, Torrance, CA 90509

MILESTONE: HCAI SUBMITTA

MILESTONE DATE: 10/25/202

RBB PROJECT: 1712105 SCALE:

DESCRIPTION

EXISTING PANEL SCHEDULES

DU2-401.1

NON-SEGREGATED

(E) PANEL: LSA

LOCATION : BUILDING 11

FLOOR : LEVEL 1

MOUNTING : SURFACE

VOLTAGE/PHASE: 120/208V, 3Ø, 4W

BUS AMPS : 100A

MAIN BREAKER : 50A/3P

FED FROM : HOUSE XFMR

MAIN BUS RATING : 10 KAIC

CKT	TYPE	LOADS	BKR/POLE	VOLT-AMPS			VOLT-AMPS			BKR/POLE	LOADS	TYPE	CKT
				A	B	C	A	B	C				
1		SPARE	35 A 2							1	20 A	SPARE	2
3										1	20 A	SPARE	4
5		SPARE	20 A 1							1	20 A	SPARE	6
7		SPARE	20 A 1								SPACE		8
9		SPARE	20 A 1								SPACE		10
11											SPACE		12
13											SPACE		14
15											SPACE		16
17											SPACE		18
19											SPACE		20
21											SPACE		22
23											SPACE		24
25													
27	MAIN		50 A 3										
29													
				0	0	0	0	0	0				
TOTAL ØA =				0 VOLT-AMPS									
TOTAL ØB =				0 VOLT-AMPS									
TOTAL ØC =				0 VOLT-AMPS									
LCL =				0 VOLT-AMPS									
TOTAL PANEL =				0			VA @ 208V, 3Ø =			0 AMPS			

NON-SEGREGATED

(E) PANEL: PC

LOCATION : BUILDING 11
FLOOR : LEVEL 1
MOUNTING : SURFACE

VOLTAGE/PHASE : 120/208V, 3Ø, 4W
BUS AMPS : 225A
MAIN BREAKER : MLO

FED FROM : (E) PB
MAIN BUS RATING : 10 KAIC

CKT	TYPE	LOADS	BKR/POLE	VOLT-AMPS			VOLT-AMPS			BKR/POLE	LOADS	TYPE	CKT	
				A	B	C	A	B	C					
1	M	(E) FUEL PUMP	20 A 2		500			300		1	20 A	(E) MECH CTR DT CONT	M 2	
3						500			360	1	20 A	(E) ELEC RMS RBC	R 4	
5	M	(E) FUEL PUMP 2	20 A 2				500			100	1	20 A	(E) FUEL ALARM	P 6
7						500			360	1	20 A	(E) RECPT	R 8	
9	P	(E) STAT. BATT.	30A 2			1,800			200	1	20 A	(E) CONTROL CVB CC	P 10	
11							1,800			200	1	20 A	(E) CONTROL VT CVB	P 12
13		(E) LLD ALARM	20 A 1	400				1,520		1	20 A	(E) LTG 101, 102	L 14	
15	M	(E) EF-1	20 A 1			500			1,360	1	20 A	(E) LTG 102	L 16	
17		(E) LLD CONTROLLER	20 A 1				400			500	1	20 A	(E) FACP	P 18
19		SPARE	30A 1		500					1	20 A	(E) FUEL CONT. RELAY	P 20	
21	M	(E) G5 PUMP	20 A 1			1,200			1,200	1	20 A	(E) LTG 104	L 22	
23	P	(E) G5 BATT CHGR	20 A 1				1,200			800	1	20 A	(E) LTG 104	L 24
25	P	(E) G5 HTR JWH	30 A 1	1,800				1,500		1	20 A	(E) LTG 103, 4, 6	L 26	
27	P	(E) G5 HTR JWH	30 A 1			1,800			1,800	1	20 A	(E) EXTERIOR LTG	L 28	
29	P	(E) G5 HTR GEN SPACE	20 A 1				1,200		1,200	1	20 A	(E) G6 PUMP	M 30	
31	P	(E) G5 HTR GEN SPACE	20 A 1		1,200			1,200		1	20 A	(E) G6 BATT CHGR	P 32	
33	R	(E) TELEPHONE	20 A 1			500			1,800	1	30 A	(E) G6 HTR JWH	P 34	
35								1,500				(E) G6 HTR JWH	P 36	
37	P	(E) EM LTG UNIT	35 A 2			1,500				1,800	1	30 A	(E) G6 HTR JWH	P 36
39		SPACE	-	-										
41		SPACE	-	-					1,200			(E) G6 HTR GEN SPACE	P 38	
42		SPACE	-	-						-	-	SPACE		40
				6,400 6,300 6,600 4,880 7,920 4,600										
TOTAL ØA =				11,280 VOLT-AMPS										
TOTAL ØB =				14,220 VOLT-AMPS										
TOTAL ØC =				11,200 VOLT-AMPS										
TOTAL PANEL =				36,700			VA @ 208V, 3Ø =			101.9 AMPS				

- GENERAL NOTES
- 1

REFER TO SHEET DU2-006 FOR STEP SEQUENCE
- 2

MOVING 120/208 VOLT LOADS BETWEEN PANELS SHALL BE DONE ONE AT A TIME TO MINIMIZE THE LOSS OF FUNCTION. IF THE GENERATORS START FINISH PUTTING ONE LOAD IN PROGRESS ON THE NEW PANEL OR PUT IT BACK ON THE ORIGINAL PANEL OF WHAT IS QUICKER.
- NOTES
- 1

IN THIS STEP MOVE LOAD FROM PANEL LSA TO PANEL PC.
- 2

IN THIS STEP ADD BREAKER WITH AMP RATING AS SHOWN TO PANEL PC THAT IS THE SAME MANUFACTURER AND SHORT CIRCUIT RATING AS THE ORIGINAL PANEL PC. MOVE LOAD FROM PANEL LSA TO PANEL PC.
- 3

MOVE LOADS THAT WAS ORIGINALLY ON PANEL LSA TO PANEL 011-01-LLS-PNL-01 IN THIS STEP
- 4

MOVE LOADS FROM PANEL 011-01-LLS-PNL-02 (PB) TO 011-01-LEQ-PNL-01.
- 5

MOVE LOADS FROM PANEL 011-01-LLS-PNL-03 (PC) TO 011-01-LEQ-PNL-01.
- 6

MOVE LOADS FROM PANEL 011-01-LLS-PNL-03 (PC) TO 011-01-LCR-PNL-01.
- 7

MOVE LOADS FROM PANEL 011-01-LLS-PNL-03 (PC) TO 011-01-LLS-PNL-01.
- 8

INSTALL LISTED SURGE PROTECTION DEVICES.
- 9

PROVIDE PANEL WITH LISTED SURGE PROTECTION DEVICES.

1

INC 2 MILESTONE 1 - STEP C

SCALE: NONE

EQUIPMENT BRANCH																			
PANEL:				011-01-LEQ-PNL-01															
LOCATION : BUILDING 11				VOLTAGE/PHASE : 120/208V, 3Ø, 4W				FED FROM : 011-01-LEP-PNL-01											
FLOOR : LEVE...				BUS AMPS : 225A				RATING : 10 KAIC											
MOUNTING : SURFACE				MAIN BREAKER :				MLO											
CKT	TYPE	LOADS	BKR/POLE	VOLT-AMPS			VOLT-AMPS			BKR/POLE	LOADS	TYPE	CKT						
1		SPARE	20 A 1	A	B	C	A	B	C	1	20 A	SPARE	2						
3		SPARE	15 A 2							2	15 A	SPARE	4						
5													6						
7		SPARE	35 A 2							2	35 A	SPARE	8						
9													10						
11		SPARE	15 A 12							2	15 A	SPARE	12						
13													14						
15	M	(E) EF-1	20 A 1		500					1	20 A	SPARE	16						
17		SPARE	20 A 1							1	20 A	SPARE	18						
19				3,213						1	20 A	SPARE	20						
21	M	(E) HP-1	40 A 3		3,213					1	20 A	SPARE	22						
23						3,213				1	20 A	SPARE	24						
25	M	(E) FC-1	20 A 2	562						1	20 A	SPARE	26						
27					562					1	20 A	SPARE	28						
29		SPARE	20 A 1							1	20 A	SPARE	30						
31		SPARE	20 A 1							1	20 A	SPARE	32						
33		SPARE	20 A 1							1	20 A	SPARE	34						
35	P	EXIST. SERV	20 A 1			1,000				1	20 A	SPARE	36						
37		SPARE	20 A 1							1	20 A	SPARE	38						
39		SPARE	20 A 1							1	20 A	SPARE	40						
41		SPARE	20 A 1							1	20 A	SPARE	42						
				3,775	4,275	4,213	0	0	0										
TOTAL ØA = 3,775 VOLT-AMPS																			
TOTAL ØB = 4,275 VOLT-AMPS																			
TOTAL ØC = 4,213 VOLT-AMPS																			
LCL = 125 VOLT-AMPS																			
TOTAL PANEL = 12,388				VA @ 208V, 3Ø = 34.4 AMPS															

GENERAL NOTES

- REFER TO SHEET DU2-006 FOR STEP SEQUENCE.

NOTES

- MV MOVE LOAD FROM PANEL 011-01-LLS-PNL-02 TO PANEL 011-01-LLS-PNL-03.
- WHEN ADDING LOAD FROM PANEL 011-01-LLS-PNL-03 CHANGE BREAKER WITH AMP RATING AS SHOWN TO PANEL 011-01-LLS-PNL-02 THAT IS THE SAME MANUFACTURERS AND SHORT CIRCUIT RATING AS THE ORIGINAL PANEL 011-01-LLS-02.
- MV MOVE LOADS BACK FROM PANEL 011-01-LLS-PNL-03 TO 011-01-LLS-PNL-02.
- IN PANEL 011-01-LLS-PNL-03 CHANGE BREAKERS IN 1, 3, 5, 7 WITH AMP RATING AS SHOWN WITH THE SAME MANUFACTURERS AND SHORT CIRCUIT RATING AS 011-01-LLS-PNL-03.
- LOADS ARE IN BUILDING 10, LIGHTING, FACP, AND GEN CONTROL PANEL.
- LOADS ARE IN BUILDING 10, LIGHTING, RECEPTACLES, AND SPARE.




RBB ARCHITECTS INC

Joseph A. Balbons, AIA
Sylvia Botero, AIA
Kevin S. Boots, AIA

10980 Wilshire Boulevard
Los Angeles, California
90024-3905

Telephone 310 473 3555
Facsimile 310 473 3555
www.rbbinc.com

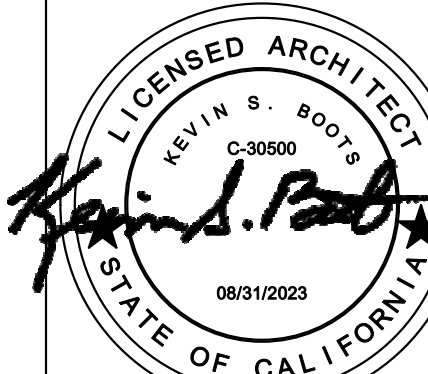

AGENCY APPROVALS

OSHPD # 1240005-19-01

CONSULTANT

P2S ENG

Long Beach // Irvine // Los Angeles
San Diego // San Jose // Seattle

p2sinc.com

ISSUE RECORD

10/09/2025	D	ADDENDUM D
03/14/2025	A	ADDENDUM A
01/31/2025	3	HCAI BACKCHECK 2
10/25/2024	2	HCAI BACKCHECK 1
06/13/2024	1	HCAI SUBMITTAL
DATE	△	DESCRIPTION

Harbor-UCLA
MEDICAL CENTER
HARBOR-UCLA MEDICAL CENTER
PHASE 2E INC 2 - GENERATOR BLDG.
RETROFIT

1000 West Carson Street, Torrance, CA 90509

MILESTONE: HCAI SUBMITTAL

MILESTONE DATE: 10/25/2024

RBB PROJECT: 1712105

SCALE:

DESCRIPTION
PHASING PANEL SCHEDULES

DU2-401.3

LIFE SAFETY BRANCH															
(E) PANEL: 011-01-LLS-PNL-03 (PC)															
LOCATION: BUILDING 11				VOLTAGE/PHASE: 120/208V, 3Ø,...				FED FROM: 011-01-LEP-PNL-01							
FLOOR: LEVEL 1				BUS AMPS: 225A				MAIN BUS... 10 KAIC							
MOUNTING: SURFACE				MAIN BREAKER: MLO											
CKT	TYPE	LOADS	BKR/POLE	VOLT-AMPS			VOLT-AMPS			BKR/POLE	LOADS	TYPE	CKT		
				A	B	C	A	B	C						
1						1,000			1	20 A	(E) G3 HTR	P	2		
3		SPARE	50 A 3					1,000		20 A	(E) G3 BATT	P	4		
5									20	1	20 A	(E) G3 TANK	P	6	
7		SPARE	20 A 1			1,656			1	20 A	(E) G3 PUMP	M	8		
9		SPARE	30A 2					2,500		1	30 A	(E) G3 HTR JWR	P	10	
11								2,500		1	30 A	(E) G3 HTR JWR	P	12	
13		SPARE	20 A 1			1,000			1	20 A	(E) G4 HTR	P	14		
15		SPARE	20 A 1					1,000		1	20 A	(E) G4 BATT	P	16	
17		SPARE	20 A 1						200	1	20 A	(E) G4 TANK	P	18	
19		SPARE	30A 1						1	20 A	(E) G4 PUMP	M	20		
21	M	(E) G5 PUMP	20 A 1		1,200		1,656	2,500		1	30 A	(E) G4 HTR JWR	P	22	
23	P	(E) G5 BATT CHGR	20 A 1		1,200			2,500		1	30 A	(E) G4 HTR JWR	P	24	
25	P	(E) G5 HTR JWH	30 A 1	1,800						1	20 A	SPARE		26	
27	P	(E) G5 HTR JWH	30 A 1		1,800					1	20 A	SPARE		28	
29	P	(E) G5 HTR GEN SPACE	20 A 2			1,200			1,200	1	20 A	(E) G6 PUMP	M	30	
31					1,200		1,200			1	20 A	(E) G6 BATT CHGR	P	32	
33		SPARE	20 A 1					1,800		1	30 A	(E) G6 HTR JWR	P	34	
35		SPARE	35 A 2						1,800	1	30 A	(E) G6 HTR JWH	P	36	
37															
39		SPACE	- -					1,200		2	20 A	(E) G6 HTR GEN SPACE	P	38	
41		SPACE	- -							- -		SPACE		40	
				3,000	3,000	2,400	6,512	10,000	8,220						42
TOTAL OA =				9,512 VOLT-AMPS											
TOTAL OB =				13,000 VOLT-AMPS											
TOTAL OC =				10,620 VOLT-AMPS											
TOTAL PANEL =				33.132 VA @ 208V, 3Ø =				92.0 AMPS							

LIFE SAFETY BRANCH													
(E) PANEL: 011-01-LLS-PNL-02 (PB)													
LOCATION: BUILDING 11				VOLTAGE/PHASE: 120/208V, 3Ø, 4W				FED FROM: 011-01-LEP-PNL-01					
FLOOR: LEVEL...				BUS AMPS: 400A				RATINGS: 10 KAIC					
MOUNTING: SURFACE				MAIN BREAKER: MLO									
CKT	TYPE	LOADS	BKR/POLE	VOLT-AMPS			VOLT-AMPS			BKR/POLE	LOADS	TYPE	CKT
				A	B	C	A	B	C				
1							1,000			1	20 A	(E) G2 BATT	P 2
3								200		1	20 A	(E) G2 TANK	P 4
5									1,000	1	20 A	(E) G2 HTR	P 6
7	SPARE		150A	3			1,656			1	20 A	(E) G2 PUMP	M 8
9								2,500		1	30 A	(E) G2 HTR JWR	P 10
11									2,500	1	30 A	(E) G2 HTR JWR	P 12
13	SPARE		20 A	1						1	20 A	SPARE	P 14
15	SPARE		20 A	1						1	20 A	SPARE	P 16
17	SPARE		20 A	1						1	20 A	SPARE	P 18
19	SPARE		20 A	1						1	20 A	SPARE	P 20
21	SPARE		20 A	1						1	30 A	SPARE	P 22
23	SPARE		30 A	1						1	30 A	SPARE	P 24
25							1,000			1	20 A	(E) G1 HTR	P 26
27	SPARE		40 A	3				1,000		1	20 A	(E) G1 BATT	P 28
29									200	1	20 A	(E) G1 TANK	P 30
31							1,656			1	20 A	(E) G1 PUMP	P 32
33	SPARE							2,500		1	30 A	(E) G1 HTR JWR	P 34
35	SPACE	-	-						2,500	1	30 A	(E) G1 HTR JWR	P 36
37	SPACE	-	-							1	20 A	SPACE	P 38
39	SPACE	-	-							1	20 A	SPACE	P 40
41	SPACE	-	-							1	20 A	SPACE	P 42
					0	0	0	5,312	6,200	6,200			
TOTAL OA =				5,312 VOLT-AMPS									
TOTAL OB =				6,200 VOLT-AMPS									
TOTAL OC =				6,200 VOLT-AMPS									
TOTAL PANEL =				17,712				VA @ 208V, 3Ø =		49.2 AMPS			

(E) PANEL: 011-01-LLS-PNL-02 (PB)														
LOCATION: BUILDING 11				VOLTAGE/PHASE: 120/208V, 3Ø, 4W				FED FROM: 011-01-LEP-PNL-01						
FLOOR: LEVEL _____				BUS AMPS: 400A				RATING: 10 KAIC						
MOUNTING: SURFACE				MAIN BREAKER: MLO										
CKT	TYPE	LOADS	BKR/POLE	VOLT-AMPS			VOLT-AMPS			BKR/POLE	LOADS	TYPE	CKT	
				A	B	C	A	B	C					
1							1,000			1	20 A	(E) G2 BATT	P 2	
3								200		1	20 A	(E) G2 TANK	P 4	
5									1,000	1	20 A	(E) G2 HTR	P 6	
7	SPARE		150A	3			1,656			1	20 A	(E) G2 PUMP	M 8	
9								2,500		1	30 A	(E) G2 HTR JWR	P 10	
11									2,500	1	30 A	(E) G2 HTR JWR	P 12	
13	P	(E) G3 HTR	20 A	1	1,000					1	20 A	SPARE	14	
15	P	(E) G3 BATT	20 A	1		1,000				1	20 A	SPARE	16	
17	P	(E) G3 TANK	20 A	1			200			1	20 A	SPARE	18	
19	M	(E) G3 PUMP	20 A	1	1,656					1	20 A	SPARE	20	
21	P	(E) G3 HTR JWR	30 A	1			2,500			1	30 A	SPARE	22	
23	P	(E) G3 HTR JWR	30 A	1			2,500			1	30 A	SPARE	24	
25								1,000		1	20 A	(E) G1 HTR	26	
27		SPARE	40 A	3					1,000	1	20 A	(E) G1 BATT	28	
29										200	1	20 A	(E) G1 TANK	30
31		SPARE	20 A	2				1,656		1	20 A	(E) G1 PUMP	32	
33									2,500	1	30 A	(E) G1 HTR JWR	34	
35	SPACE	-	-	-						2,500	1	30 A	(E) G1 HTR JWR	36
37	SPACE	-	-	-							1	20 A	SPACE	38
39	SPACE	-	-	-							1	20 A	SPACE	40
41	SPACE	-	-	-							1	20 A	SPACE	42
				2,656			3,500	2,700	5,312	6,200	6,200			
TOTAL OA =				7,968 VOLT-AMPS										
TOTAL OB =				9,700 VOLT-AMPS										
TOTAL OC =				8,900 VOLT-AMPS										
TOTAL PANEL =				26.568		VA @ 208V, 3Ø =		73.8 AMPS						

INC 2 MILESTONE 1 - STEP H & I

SCALE: NONE

INC 2 MILESTONE 1 - STEP K




RBB ARCHITECTS INC

Joseph A. Balbons, AIA
Sylvia Botero, AIA
Kevin S. Boots, AIA

10980 Wilshire Boulevard
Los Angeles, California
90024-3905

Telephone 310 473 3555
Facsimile 310 473 3555
www.rbbinc.com

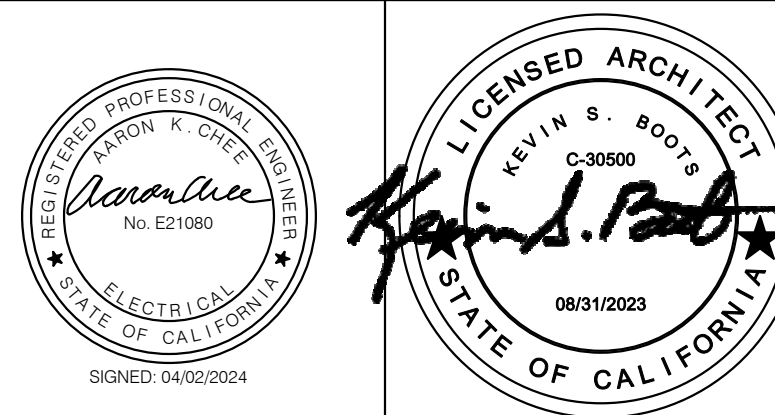

AGENCY APPROVALS

OSHPD # 1240005-19-01

CONSULTANT

P2S ENG

Long Beach // Irvine // Los Angeles
San Diego // San Jose // Seattle

p2sinc.com

ISSUE RECORD

04/09/2025	D	ADDENDUM D
03/14/2025	A	ADDENDUM A
01/31/2025	3	HCAI BACKCHECK 2
10/25/2024	2	HCAI BACKCHECK 1
06/13/2024	1	HCAI SUBMITTAL
04/18/2024	-	HCAI SUBMITTAL
DATE	△	DESCRIPTION

Harbor-UCLA
MEDICAL CENTER
HARBOR-UCLA MEDICAL CENTER
PHASE 2E INC 2 - GENERATOR BLDG.
RETROFIT

1000 West Carson Street, Torrance, CA 90509

MILESTONE: HCAI SUBMITTAL

MILESTONE DATE: 10/25/2024

RBB PROJECT: 1712105

SCALE:

DESCRIPTION
FINAL PANEL SCHEDULES

DU2-401.4

PANEL: 011-01-LEQ-PNL-01 EQUIPMENT BRANCH
LOCATION: ELECTRICAL SWITCHGEAR VOLTAGE/PHASE: 120/208 WYE,3PH,4W FED FROM: 011-01-LEP-PNL-01
FLOOR: LEVEL 01 BUS AMPS: 225 A RATING: 10 KAIC
MOUNTING: SURFACE MAIN BREAKER: MLO

CKT	TYPE	LOAD	BKRV/POLE	A	B	C	A	B	C	BKRV/POLE	LOAD	TYPE	CKT	
1	P	P MECH CONTROLS PANEL	20 A 1	600			60			1 20 A	P CONDENSATE PUMPS	P	2	
3	M	FC-1A	15 A 2		741			62		2 15 A	FC-2A	M	4	
5	--	--	--	--		741				62	--	--	6	
7	M	HP-1	35 A 2	2413			1976			2 35 A	HP-2	M	8	
9	--	--	--	--		2413		1976		--	--	--	10	
11	M	FC-1B	15 A 2			42				2 15 A	FC-2B	M	12	
13	--	--	--	--	42			62		--	--	--	14	
15	M	(E) EF-1	20 A 1		500			0		1 20 A	SPARE	--	16	
17	--	SPARE	20 A 1			0			0	1 20 A	SPARE	--	18	
19	--	SPARE	40 A 3	0			400			1 20 A	SWGR CONTROL LIGHTS	P	20	
21	--	--	--	--		0			1000	1 20 A	SWGR CONTROL HT	P	22	
23	--	--	--	--			0			500	1 20 A	SWGR-03 SECT 39 HT LITS	P	24
25	--	SPARE	20 A 2	0				1000		1 20 A	SWGR-03 SECT 37,38 HT LITS	P	26	
27	--	--	--	--		0			1000	1 20 A	SWGR-03 SECT 35, 36 HT LITS	P	28	
29	--	SPARE	20 A 1			0			1000	1 20 A	SWGR-02 SECT 23, 24 HT LITS	P	30	
31	--	SPARE	20 A 1	0				1000		1 20 A	SWGR-02 SECT 21, 22 HT LITS	P	32	
33	--	SPARE	20 A 1			0			400	1 20 A	SWGR - 02 SECT 29 HT LITS	P	34	
35	--	(E) SERV	20 A 1				1000			1000	1 20 A	SWGR-02 SECT 27, 28 HT LITS	P	36
37	R	R ELECTRICAL SWITCHGEAR	20 A 1	540				1000		1 20 A	SWGR-01 SEC 15, 16 HT LITS	--	38	
39	R	R EMERGENCY GENERATOR	1 20 A 1		540				1000	1 20 A	SWGR-01 SEC 13, 14 HT LITS	--	40	
41	R	R EMERGENCY GENERATOR	1 20 A 1			540				1000	1 20 A	SWGR-01 SEC 11, 12 HT LITS	--	42

LOAD TYPE KEY:				TOTAL A: 9093 VA				80 A			
N=NON CONTINUOUS				M=MECH EQUIP				R=RECEPTACLE			
P=POWER				R=RECEPTACLE				K=KITCHEN			
L=LIGHTING				TOTAL C: 5947 VA				50 A			
TOTAL B: 9532 VA				TOTAL A: 9093 VA				80 A			
TOTAL C: 5947 VA				TOTAL B: 9532 VA				50 A			
TOTAL A: 9093 VA				TOTAL C: 5947 VA				50 A			
TOTAL B: 9532 VA				TOTAL A: 9093 VA				80 A			
TOTAL C: 5947 VA				TOTAL B: 9532 VA				50 A			
TOTAL A: 9093 VA				TOTAL C: 5947 VA				50 A			
TOTAL											

ID	FROM	TO	PHASE CABLE SIZE	PHASE CABLE TYPE	GROUND CONDUCTOR SIZE	GROUND CONDUCTOR TYPE	NEW CONDUIT SIZE	NEW CONDUIT TYPE	VIA	CONTRACTOR SCOPE	REMARKS
C001	PULLBOX 'COM-MH23'	STUB UP IN GAP BUILDING BUILDING	-	-	-	-	4"	PVC	-	INC 1	
C002	PULLBOX 'COM-MH23'	PULLBOX 'COM-CS-13'	-	-	-	-	(2) 1"	PVC	COM-CS-12, COM-CS-12	INC 1	
C003	PULLBOX 'COM-MH23'	STUB OUT NEAR MVMH-N-19/20	-	-	-	-	(3) 2"	PVC	-	INC 1	
C003A	STUB OUT NEAR MVMH-N-19/20	GEN BUILDING	-	-	-	-	(3) 2"	PVC	-	INC 2	
C004	PULLBOX 'COM-CS-13'	STUB UP IN GAP BUILDING BUILDING	-	-	-	-	(1) 2"	PVC	-	INC 1	
C005	GEN BUILDING IDF ENCLOSURE	GEN BUILDING BACKBOARD	-	-	-	-	(1) 2"	PVC	-	INC 2	
D100	BATTERY RACK '011-01-DNB-BAT-01'	DISCONNECT '011-01-DNP-BDS-01'	2-2 AWG	0.6 KV, CU, THHN/THWN	1-8 AWG	THHN/THWN	1"	IMC		INC 2	
D101	DISCONNECT '011-01-DNP-BDS-01'	SPICE BOX	2-2 AWG	0.6 KV, CU, THHN/THWN	1-8 AWG	THHN/THWN	1"	IMC		INC 2	
D102	BATTERY CHARGER '011-01-DNP-BCH-01'	SPICE BOX	2-2 AWG	0.6 KV, CU, THHN/THWN	1-8 AWG	THHN/THWN	1"	IMC		INC 2	
D103	SPICE BOX	PANEL '011-01-DNP-PNL-01'	2-2 AWG	0.6 KV, CU, THHN/THWN	1-8 AWG	THHN/THWN	1"	IMC		INC 2	
D104	PANEL '011-01-DNP-PNL-01'	PANEL '011-01-DNP-PNL-02'	2-2 AWG	0.6 KV, CU, THHN/THWN	1-8 AWG	THHN/THWN	1"	IMC		INC 2	
D105	PANEL '011-01-DNP-PNL-01'	PANEL '011-01-DNP-PNL-03'	2-2 AWG	0.6 KV, CU, THHN/THWN	1-8 AWG	THHN/THWN	1"	IMC		INC 2	
D106	PANEL '011-01-DNP-PNL-01'	011-01-EMV-SGR-01 RELAYS, POWER METERS AND SWGR CIRCUIT BREAKERS 'OPEN'	4#12AWG,...	0.6 KV, CU, THHN/THWN	1#10AWG	THHN/THWN	1"	IMC		INC 2	
D107	PANEL '011-01-DNP-PNL-01'	011-01-EMV-SGR-01 CIRCUIT BREAKERS 'CLOSE'	2#6AWG	0.6 KV, CU, THHN/THWN	1#10AWG	THHN/THWN	1.25'	IMC		INC 2	
D108	PANEL '011-01-DNP-PNL-01'	SCADA CONTROL AND GEN CONTROL	6#12AWG,...	0.6 KV, CU, THHN/THWN	1#10AWG	THHN/THWN	1"	IMC		INC 2	
D200	BATTERY RACK '011-01-DNB-BAT-02'	DISCONNECT '011-01-DNP-BDS-02'	2-2 AWG	0.6 KV, CU, THHN/THWN	1-8 AWG	THHN/THWN	1"	IMC		INC 2	
D201	DISCONNECT '011-01-DNP-BDS-0'	SPICE BOX	2-2 AWG	0.6 KV, CU, THHN/THWN	1-8 AWG	THHN/THWN	1"	IMC		INC 2	
D202	BATTERY CHARGER '011-01-DNP-BCH-02'	SPICE BOX	2-2 AWG	0.6 KV, CU, THHN/THWN	1-8 AWG	THHN/THWN	1"	IMC		INC 2	
D203	SPICE BOX	PANEL '011-01-DNP-PNL-02'	2-2 AWG	0.6 KV, CU, THHN/THWN	1-8 AWG	THHN/THWN	1"	IMC		INC 2	
D204	PANEL '011-01-DNP-PNL-02'	PANEL '011-01-DNP-PNL-03'	2-2 AWG	0.6 KV, CU, THHN/THWN	1-8 AWG	THHN/THWN	1"	IMC		INC 2	
D205	PANEL '011-01-DNP-PNL-02'	011-01-EMV-SGR-02 (PART A) RELAYS, POWER METERS AND SWGR CIRCUIT BREAKERS 'OPEN'	4#12AWG,...	0.6 KV, CU, THHN/THWN	1#10AWG	THHN/THWN	1"	IMC		INC 2	
D206	PANEL '011-01-DNP-PNL-02'	011-01-EMV-SGR-02 (PART A) CIRCUIT BREAKERS 'CLOSE'	2#6AWG	0.6 KV, CU, THHN/THWN	1#10AWG	THHN/THWN	1"	IMC		INC 2	
D207	PANEL '011-01-DNP-PNL-02'	011-01-EMV-SGR-02 (PART B) RELAYS, POWER METERS AND SWGR CIRCUIT BREAKERS 'OPEN'	4#12AWG,...	0.6 KV, CU, THHN/THWN	1#10AWG	THHN/THWN	1"	IMC		INC 2	
D208	PANEL '011-01-DNP-PNL-02'	011-01-EMV-SGR-02 (PART B) SWGR CIRCUIT BREAKERS 'CLOSE'	2#6AWG	0.6 KV, CU, THHN/THWN	1#10AWG	THHN/THWN	1"	IMC		INC 2	
D301	PANEL '011-01-DNP-PNL-03'	011-01-EMV-SGR-03 RELAYS, POWER METERS AND SWGR CIRCUIT BREAKERS 'OPEN'	4#12AWG,...	0.6 KV, CU, THHN/THWN	1#10AWG	THHN/THWN	1"	IMC		INC 2	
D302	PANEL '011-01-DNP-PNL-03'	011-01-EMV-SGR-03 SWGR CIRCUIT BREAKERS 'CLOSE'	2#6AWG	0.6 KV, CU, THHN/THWN	1#10AWG	THHN/THWN	1"	IMC		INC 2	
D303	PANEL '011-01-DNP-PNL-03'	SCADA CONTROL AND GEN CONTROL	6#12AWG,...	0.6 KV, CU, THHN/THWN	1#10AWG	THHN/THWN	1.25'	IMC		INC 2	
F001	FACP IN GAP BUILDING	STUB OUT NEAR MVMH-N-19/20	-	-	-	-	(2) 2"	PVC	FAL-CS-11	INC 1	
F001A	STUB OUT NEAR MVMH-N-19/20	(E) FIRE ALARM TERMINAL CABINET IN GENERATOR BUILDING	-	-	-	-	(2) 2"	PVC	-	INC 2	
S001	EXISTING CONDUITS INSTALLED BY PHASE 1A, INC 3 DUCTBANK PROJECT	PULLBOX 'SPB-CS-11'	-	-	-	-	(4) 2"	PVC	-	INC 1	CONNECT (2) CONDUITS FORM SPB-CS-09 AND (2) FROM SPB-CS-10
S001A	PULLBOX 'SPB-CS-11'	SCADA FIBER PATCH PANEL IN GAP SWITCHGEAR BUILDING	-	-	-	-	(4) 2"	PVC	-	INC 1	SEE DU2-403.2 FOR CABLE REQUIREMENTS
S001B	(4) FIBER PATCH PANELS: (2) SCADA, GEN CONTROL, AND ATS METER FIBER PATCH PANELS IN GAP...	STUB OUT NEAR MVMH-N-19/20	-	-	-	-	(4) 2"	PVC/IMC	SPB-CS-12	INC 1	
S001C	STUB OUT NEAR MVMH-N-19/20	(4) FIBER PATCH PANELS: (2) SCADA, GEN CONTROL, AND ATS METER FIBER PATCH PANELS IN...	-	-	-	-	(4) 2"	PVC/IMC	-	INC 2	
S001D	(4) FIBER PATCH PANELS: (2) SCADA, GEN CONTROL, AND ATS METER FIBER PATCH PANELS IN GAP...	(4) FIBER PATCH PANELS: (4) FIBER PATCH PANELS: (2) SCADA, GEN CONTROL, AND ATS METER...	-	-	-	-	-	-	-	INC 2	SEE DU2-403.2 FOR CABLE REQUIREMENTS
S001E	(4) FIBER PATCH PANELS: (2) SCADA, GEN CONTROL, AND ATS METER FIBER PATCH PANELS IN GEN...	GENERATOR BLDG SWGR SCADA AND GEN CONTROL SECTION	-	-	-	-	-	-	-	INC 2	SEE DU2-403.2 FOR CABLE REQUIREMENT INSTALL IN WIREWAY
G001	EXISTING CONDUITS FROM PULLBOX 'GEN-CS-03' INSTALLED BY PHASE 1A, INC 3 DUCTBANK...	PULLBOX 'GEN-CS-02'	-	-	-	-	(7) 2"	PVC	-	INC 1	SEE DU2-403.2 FOR CABLE REQUIREMENTS
G001A	PULLBOX 'GEN-CS-02'	ATS-GEN TERMINAL CABINET IN GAP BUILDING	-	-	-	-	(9) 2"	PVC	-	INC 1	SEE DU2-403.2 FOR CABLE REQUIREMENTS
G002	ATS-GEN TERMINAL CABINET IN GAP BUILDING	STUB OUT NEAR MVMH-N-19/20	-	-	-	-	(7) 2"	PVC/IMC	GEN-CS-01W	INC 1	
G002A	STUB OUT NEAR MVMH-N-19/20	ATS-GEN TERMINAL CABINET IN GENERATOR BUILDING	-	-	-	-	(7) 2"	PVC/IMC/RMC	-	INC 2	USE RMC OUTSIDE
G002B	ATS-GEN TERMINAL CABINET IN GENERATOR BUILDING	GENERATOR BLDG SWGR GEN CONTROL SECTION	156#12AWG	-	-	-	-	-	-	INC 2	INSTALL IN WIREWAY
G002C	ATS-GEN TERMINAL CABINET IN GAP BUILDING	ATS-GEN TERMINAL CABINET IN GENERATOR BUILDING	264#12 AWG	-	-	-	-	-	-	INC 2	(1) 2'C-36#12, (1) 2'C-48#12, (3) 2'C-60#12
G003	GENERATOR CONTROL CABINET IN EXISTING GENERATOR BUILDING	TRANSFER SWITCH #1 IN SUB 1	-	-	-	-	-	-	GEN-CS-01E, GEN-CS-02E	INC 2	SEE DU2-403.2 FOR CABLE REQUIREMENTS
G004	GENERATOR CONTROL CABINET IN EXISTING GENERATOR BUILDING	TRANSFER SWITCH #2 IN SUB 1	-	-	-	-	-	-	GEN-CS-01E, GEN-CS-02E	INC 2	SEE DU2-403.2 FOR CABLE REQUIREMENTS
G005	GENERATOR CONTROL CABINET IN EXISTING GENERATOR BUILDING	TRANSFER SWITCH #3 IN SUB 1	-	-	-	-	-	-	GEN-CS-01E, GEN-CS-02E	INC 2	SEE DU2-403.2 FOR CABLE REQUIREMENTS
G006	GENERATOR CONTROL CABINET IN EXISTING GENERATOR BUILDING	TRANSFER SWITCH #4 IN PCDC	-	-	-	-	-	-	GEN-CS-01E, GEN-CS-02E	INC 2	SEE DU2-403.2 FOR CABLE REQUIREMENTS
G007	GENERATOR CONTROL CABINET IN EXISTING GENERATOR BUILDING	TRANSFER SWITCH #5 IN PCDC	-	-	-	-	-	-	GEN-CS-01E, GEN-CS-02E	INC 2	SEE DU2-403.2 FOR CABLE REQUIREMENTS
G008	GENERATOR CONTROL CABINET IN EXISTING GENERATOR BUILDING	TRANSFER SWITCH #6 IN PCDC	-	-	-	-	-	-	GEN-CS-01E, GEN-CS-02E	INC 2	SEE DU2-403.2 FOR CABLE REQUIREMENTS
G009	PULLBOX 'GEN-CS-02'	STUB OUT INTO EMERGENCY RESPONSE HAZ MAT AREA	-	-	-	-	(2) 2"C	PVC	-	INC 1	
G010	ATS '011-01-LEP-ATS-01'	ATS-GEN TERMINAL CABINET IN GENERATOR BUILDING	12#12 AWG	-	-	-	2"	IMC	-	INC 2	
G011	GENERATOR BLDG SWGR GEN CONTROL SECTION	(E) CHILLER PLANT BMS/EMS CONTROL SYSTEM	20#14 AWG	-	-	-	2"	RMC		INC 2	INSTALL FLEX CONDUIT SEISMIC CONNECTION BETWEEN GENERATOR BUILDING AND OVER SHADE STRUCTURE
G012	GENERATOR BLDG SWGR GEN CONTROL SECTION	(E) CHILLER PLANT BMS/EMS CONTROL SYSTEM	-	6-PAIR MULTI-MODE FIBER OPTIC CABLE	-	-	1.5"	RMC		INC 2	INSTALL FLEX CONDUIT SEISMIC CONNECTION BETWEEN GENERATOR BUILDING AND OVER SHADE STRUCTURE
L001	DISCONNECT '010-01-LCR-BDS-01'	STUB OUT NEAR MVMH-N-19/20	-	-	-	-	(2) 2"	PVC/IMC	LVPB-LCR-01	INC 1	
L001A	STUB OUT NEAR MVMH-N-19/20	PANEL '011-01-LCR-PNL-01	-	-	-	-	(2) 2"	PVC/IMC	-	INC 2	
L001B	PANEL '011-01-LCR-PNL-01'	DISCONNECT '010-01-LCR-BDS-01'	4-6 AWG	0.6 KV, CU, THHN/THWN	6 AWG	THHN/THWN	-	-	LVPB-LCR-01	INC 1	
L002	DISCONNECT '010-01-LLS-BDS-01'	STUB OUT NEAR MVMH-N-19/20	-	-	-	-	(2) 2"	PVC/IMC	LVPB-LLS-01	INC 1	
L002A	STUB OUT NEAR MVMH-N-19/20	PANEL '011-01-LLS-PNL-01'	-	-	-	-	(2) 2"	PVC/IMC	-	INC 2	
L002B	PANEL '011-01-LLS-PNL-01'	DISCONNECT '010-01-LLS-BDS-01'	6-6 AWG	0.6 KV, CU, THHN/THWN	6 AWG	THHN/THWN	-	-	LVPB-LLS-01	INC 1	
L003	TRANSFORMER '010-01-NMV-TRX-01'	PANEL '010-01-LEQ-PNL-01'	4-4/0 AWG	0.6 KV, CU, THHN/THWN	4 AWG	THHN/THWN	2.5"	PVC		INC 1	
L100	TRANSFORMER '011-01-NMV-TRX-01'	DISCONNECT SWITCH ABOVE LVPB-E-04	(2) 4-250KCMIL	0.6 KV, CU, THHN/THWN	(2) #1/0AWG	THHN/THWN	(2) 3"	PVC/RMC	VIA LVPB-E-11 AND LVPB-E-04	INC 2	
L100A	TRANSFORMER '011-01-NMV-TRX-01'	DISCONNECT '011-01-LNP-BDS-01'	4-12 AWG	0.6 KV, CU, THHN/THWN	12 AWG	THHN/THWN	1"	PVC/RMC	LVPB-E-04		
L101	DISCONNECT '011-01-LNP-BDS-01'	TRANSFER SWITCH '011-01-LEP-ATS-01'	(2) 4-250KCMIL	0.6 KV, CU, THHN/THWN	(2) 2#AWG	THHN/THWN	(2) 3"	IMC		INC 2	
L102	JUNCTION BOX 'LVPB-E-02'	TRANSFER SWITCH '011-01-LEP-ATS-01'	(2) 4-250KCMIL	0.6 KV, CU, THHN/THWN	(2) 2#AWG	THHN/THWN	(2) 3"	IMC		INC 2	
L103	TRANSFER SWITCH '011-01-LEP-ATS-01'	TRANSFER SWITCH '011-01-LEP-ATS-02'	(2) 4-250KCMIL	0.6 KV, CU, THHN/THWN	(2) 2#AWG	THHN/THWN	(2) 3"	IMC		INC 2	
L104	GENERATOR QUICK CONNECT BOX '011-01-LEP-GQC-01'	TRANSFER SWITCH '011-01-LEP-ATS-02'	(2) 4-250KCMIL	0.6 KV, CU, THHN/THWN	(2) 2#AWG	THHN/THWN	(2) 3"	IMC		INC 2	
L105	TRANSFER SWITCH '011-01-LEP-ATS-02'	PANEL '011-01-LEP-PNL-01'	(2) 4-250KCMIL	0.6 KV, CU, THHN/THWN	(2) 2#AWG	THHN/THWN	(2) 3"	IMC		INC 2	
L106	EXISTING PS/LSA ENCLOSED CIRCUIT BREAKER	JUNCTION BOX 'LVPB-E-02'	4-500KCMIL	0.6 KV, CU, THHN/THWN	2#AWG	THHN/THWN	4"	IMC		INC 2	
L111	PANEL '011-01-LEP-PNL-01'	PANEL '011-01-LEQ-PNL-01'	4- 3/0 AWG	0.6 KV, CU, THHN/THWN	4 AWG	THHN/THWN	2"	IMC		INC 2	
L110	PANEL '011-01-LEP-PNL-01'	PANEL '011-01-LCR-PNL-01'	4-4/0 AWG	0.6 KV, CU, THHN/THWN	4 AWG	THHN/THWN	2.5"	IMC		INC 2	
L112	PANEL '011-01-LEP-PNL-01'	PANEL '011-01-LLS-PNL-01'	4-4/0 AWG	0.6 KV, CU, THHN/THWN	4 AWG	THHN/THWN	2.5"	IMC		INC 2	
L113	PANEL '011-01-LEP-PNL-01'	PANEL '011-01-LLS-PNL-02'	4-4/0 AWG	0.6 KV, CU, THHN/THWN	4 AWG	THHN/THWN	2.5"	IMC		INC 2	
L114	PANEL '011-01-LEP-PNL-01'	PANEL '011-01-LLS-PNL-03'	4-4/0 AWG	0.6 KV, CU, THHN/THWN	4 AWG	THHN/THWN	2.5"	IMC		INC 2	
L200	TRANSFORMER '011-01-EMV-TRX-01'	DISCONNECT '011-01-ENP-BDS-01'	(2) 4-250KCMIL	0.6 KV, CU, THHN/THWN	(2) #1/0AWG	THHN/THWN	(2) 3"	PVC/RMC	VIA LVPB-E-10 AND LVPB-E-01	INC 2	
L201	DISCONNECT '011-01-ENP-BDS-01'	J-BOX LVPB-E-02	(2) 4-250KCMIL	0.6 KV, CU, THHN/THWN	(2) 2#AWG	THHN/THWN	(2) 3"	IMC		INC 2	

GENERAL NOTES

1. TYPE MV CABLE SHALL BE INSTALLED, TERMINATED AND TESTED BY QUALIFIED PERSONS AND SHALL BE MARKED AS REQUIRED BY CEC 310.120.
2. SEE THE CONDUIT AND CABLE SCHEDULE FOR CONDUIT TYPES. CONDUIT INDOORS SHALL BE RGS FOR CONDUITS CONTAINING HIGH VOLTAGE CABLE OF 1000V OR GREATER. CONDUIT OUTSIDE SHALL BE RGS. CONDUIT CONTAINING VOLTAGES 600V OR LESS INSTALLED INDOORS AND ABOVE 9' CAN BE EMT.
3. SPLICING OF MV CABLES ARE TO BE MADE WITH 600A T-BODY WITH CAPACITIVE TEST POINT.




RBB ARCHITECTS INC

Joseph A. Balbona, AIA
Sylvia Botero, AIA
Kevin S. Boots, AIA

10980 Wilshire Boulevard
Los Angeles, California
90024-3905

Telephone 310 473 3555
Facsimile 310 473 3555
www.rbbinc.com

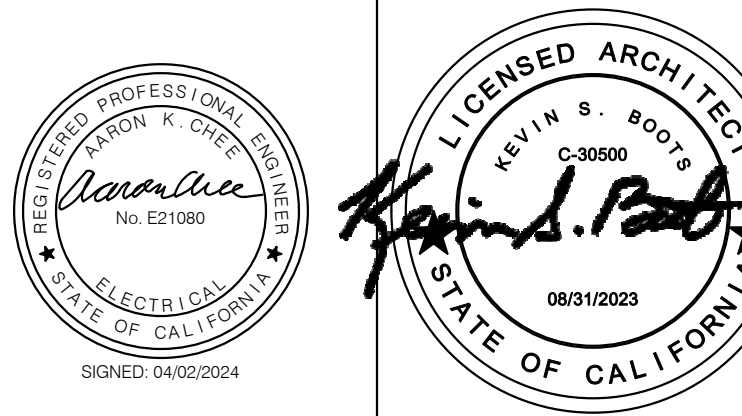

AGENCY APPROVALS

OSHPD # I240005-19-01

CONSULTANT



Long Beach // Irvine // Los Angeles
San Diego // San Jose // Seattle

p2sinc.com

ISSUE RECORD

DATE	DESCRIPTION
04/09/2025	D HC&I BACKCHECK D
04/01/2025	4 HC&I BACKCHECK 3
03/14/2025	A ADDENDUM A
03/13/2025	3 HC&I BACKCHECK 2
02/05/2024	2 HC&I BACKCHECK 1
06/13/2024	1 HC&I SUBMITTAL
04/18/2024	HC&I SUBMITTAL



**HARBOR-UCLA MEDICAL CENTER
PHASE 2E INC 2 - GENERATOR BLDG.
RETROFIT**

1000 West Carson Street, Torrance, CA 90509

MILESTONE:	HCAI SUBMITTAL
MILESTONE DATE:	10/25/2024

RBB PROJECT: 1712105

DESCRIPTION
CONDUIT AND CABLE
SCHEDULE

DU2-402.1



GENERAL NOTES

- ALL OUTAGES REQUIRE A MINIMUM 4 WEEK NOTICE AND AGREEMENT WITH THE OWNER ON TIMING OF THE OUTAGE. MOPS WILL NEED TO BE SUBMITTED AND APPROVED. OUTAGE DURATIONS SHALL BE MINIMIZED SUCH AS ADDING 600A T-BODY TO NEW CABLES BEFORE CUTTING INTO EXISTING 12KV CABLES.
- FOR OVER 1000V SYSTEMS, PROVIDE INSPECTIONS AND TEST REPORT TO HCAI/OSHPD PRIOR TO ENERGIZATION.
- A PERMANENT, SINGLE-LINE DIAGRAM OF THE SWITCHGEAR SHALL BE PROVIDED IN A READILY VISIBLE LOCATION WITHIN THE SAME ROOM OR ENCLOSED AREA WITH THE SWITCHGEAR, AND THIS DIAGRAM SHALL CLEARLY IDENTIFY INTERLOCKS, ISOLATION MEANS, AND ALL POSSIBLE SOURCES OF VOLTAGE TO THE INSTALLATION UNDER NORMAL OR EMERGENCY CONDITIONS. THE MARKING ON THE SWITCHGEAR SHALL CROSS-REFERENCE THE DIAGRAM.
- LENGTHS USED ON THESE SINGLE LINE DIAGRAMS ARE ONLY TO BE USED FOR VOLTAGE DROP CALCULATIONS.
- PHASE VOLTAGE ROTATION SHALL BE RECORDED BEFORE THE POWER IS SHUT OFF. CONFIRM THE ROTATION ON THE SUPPLY END AND THE LOAD END OF THE CABLE THAT IS TO BE CUT AND/OR REPLACED. AFTER THE CUT OVER AND BEFORE DOWN STREAM LOADS ARE ALLOWED TO COME ON PERFORM PHASE ROTATION AND PHASE TO PHASE TESTING AT THE NEW SUPPLY AND LOAD END OF THE NEW CABLE. RECORD THE RESULTS AND PROVIDE IN OUTAGE REPORT.
- IF THE OUTAGE FOR THE LOADS IS REQUIRED TO BE LONGER THAN 2.5 HOURS PROVIDE TEMPORARY GENERATORS FOR THE LOADS.
- OUTAGES ARE TO BE BETWEEN 11PM AND 6AM. GENERATORS ARE ALWAYS REQUIRED FOR ANY OUTAGE TO THE IT/SHOPS AND THE CHILLER PLANT (500KVA TRANSFORMER).

MOVING 120/208 VOLT LOADS BETWEEN PANELS SHALL BE DONE ONE AT A TIME TO MINIMIZE THE LOSS OF FUNCTION. IF THE GENERATORS START FINISH PUTTING THE ONE LOAD IN PROGRESS ON THE NEW PANEL OR PUT IT BACK ON THE ORIGINAL PANEL OF WHAT IS QUICKER.

NOTES

- INSTALL NEW BREAKERS IN (E) PANEL PC. SEE DRAWING DU2-401.2 FOR TYPE OF BREAKERS AND LOCATIONS.
- AFTER NEW BREAKERS ARE ADDED TO (E) PANEL PC TEMPORARY MOVE INDIVIDUAL LOADS FROM PANEL LSA TO PANEL PC. NOTE PANEL LSA TO BE REMOVED AND CONDUITS LEAVING THE TOP WILL NEED TO BE REWORKED. SEE PLAN DRAWING DU2-604.
- IN A 10 MINUTE OUTAGE TURN OFF (E) 400A BREAKER AND CUT SUPPLY CABLES TO PANEL LSA AT THE TOP OF PANEL PB. PULL THEM OUT INTO PANEL PB AND CUT THEM SHORTER IF NEEDED. ADD HEAT SHRINK CAPS RATED 1000 VOLTS. IF MORE THEN 10 MINUTES OUTAGE IS REQUIRED FOR THE HEAT SHRINK TAPE CAP IN PLACE AND TURN ON POWER FOR AT LEAST 1 HOUR AND WITH NO ALARMS HAVE ANOTHER 10 MINUTE OUTAGE TO COMPLETE. NOTE THAT IF ANY GENERATORS START UP SAFE OFF THE WORK IMMEDIATELY AND TURN THE POWER BACK ON FOR KEEPING THE GENERATOR SYSTEMS GOING.
- AFTER ALL LOADS ON PANEL LSA ARE MOVED TO PANEL PC AND POWER SUPPLY TO LSA IS REMOVED DEMO PANEL LSA.
- NEW MANHOLE INSTALLED BY INC. 1 CONTRACTOR.
- EXISTING MANHOLE.
- INSTALL NEW PANEL 011-01-LLS-PNL-01 IN LOCATION OF OLD LSA PANEL.
- CAP T-BODIES TO PROTECT FUTURE CONNECTIONS.
- NEW CABLES TERMINATED IN AN INSULATED TAP CONNECTOR WITH INSULATED COVER OVER SOCKET TO TORQUE THE LUG.
- NEW 3/4" INCH CONDUIT WITH 2-#12 AWG AND 1-#12 GROUND FOR GEN START SIGNAL.
- NEW 2-#6 AWG AND 1-#10 GND IN NEW 0.75" CONDUIT FOR EMERGENCY LIGHTING INVERTER.
- ATS UNIT TO HAVE SPEC 28 3600 OPTIONS AND OPTIONS NOTED ON DRAWINGS DU2-403.5.

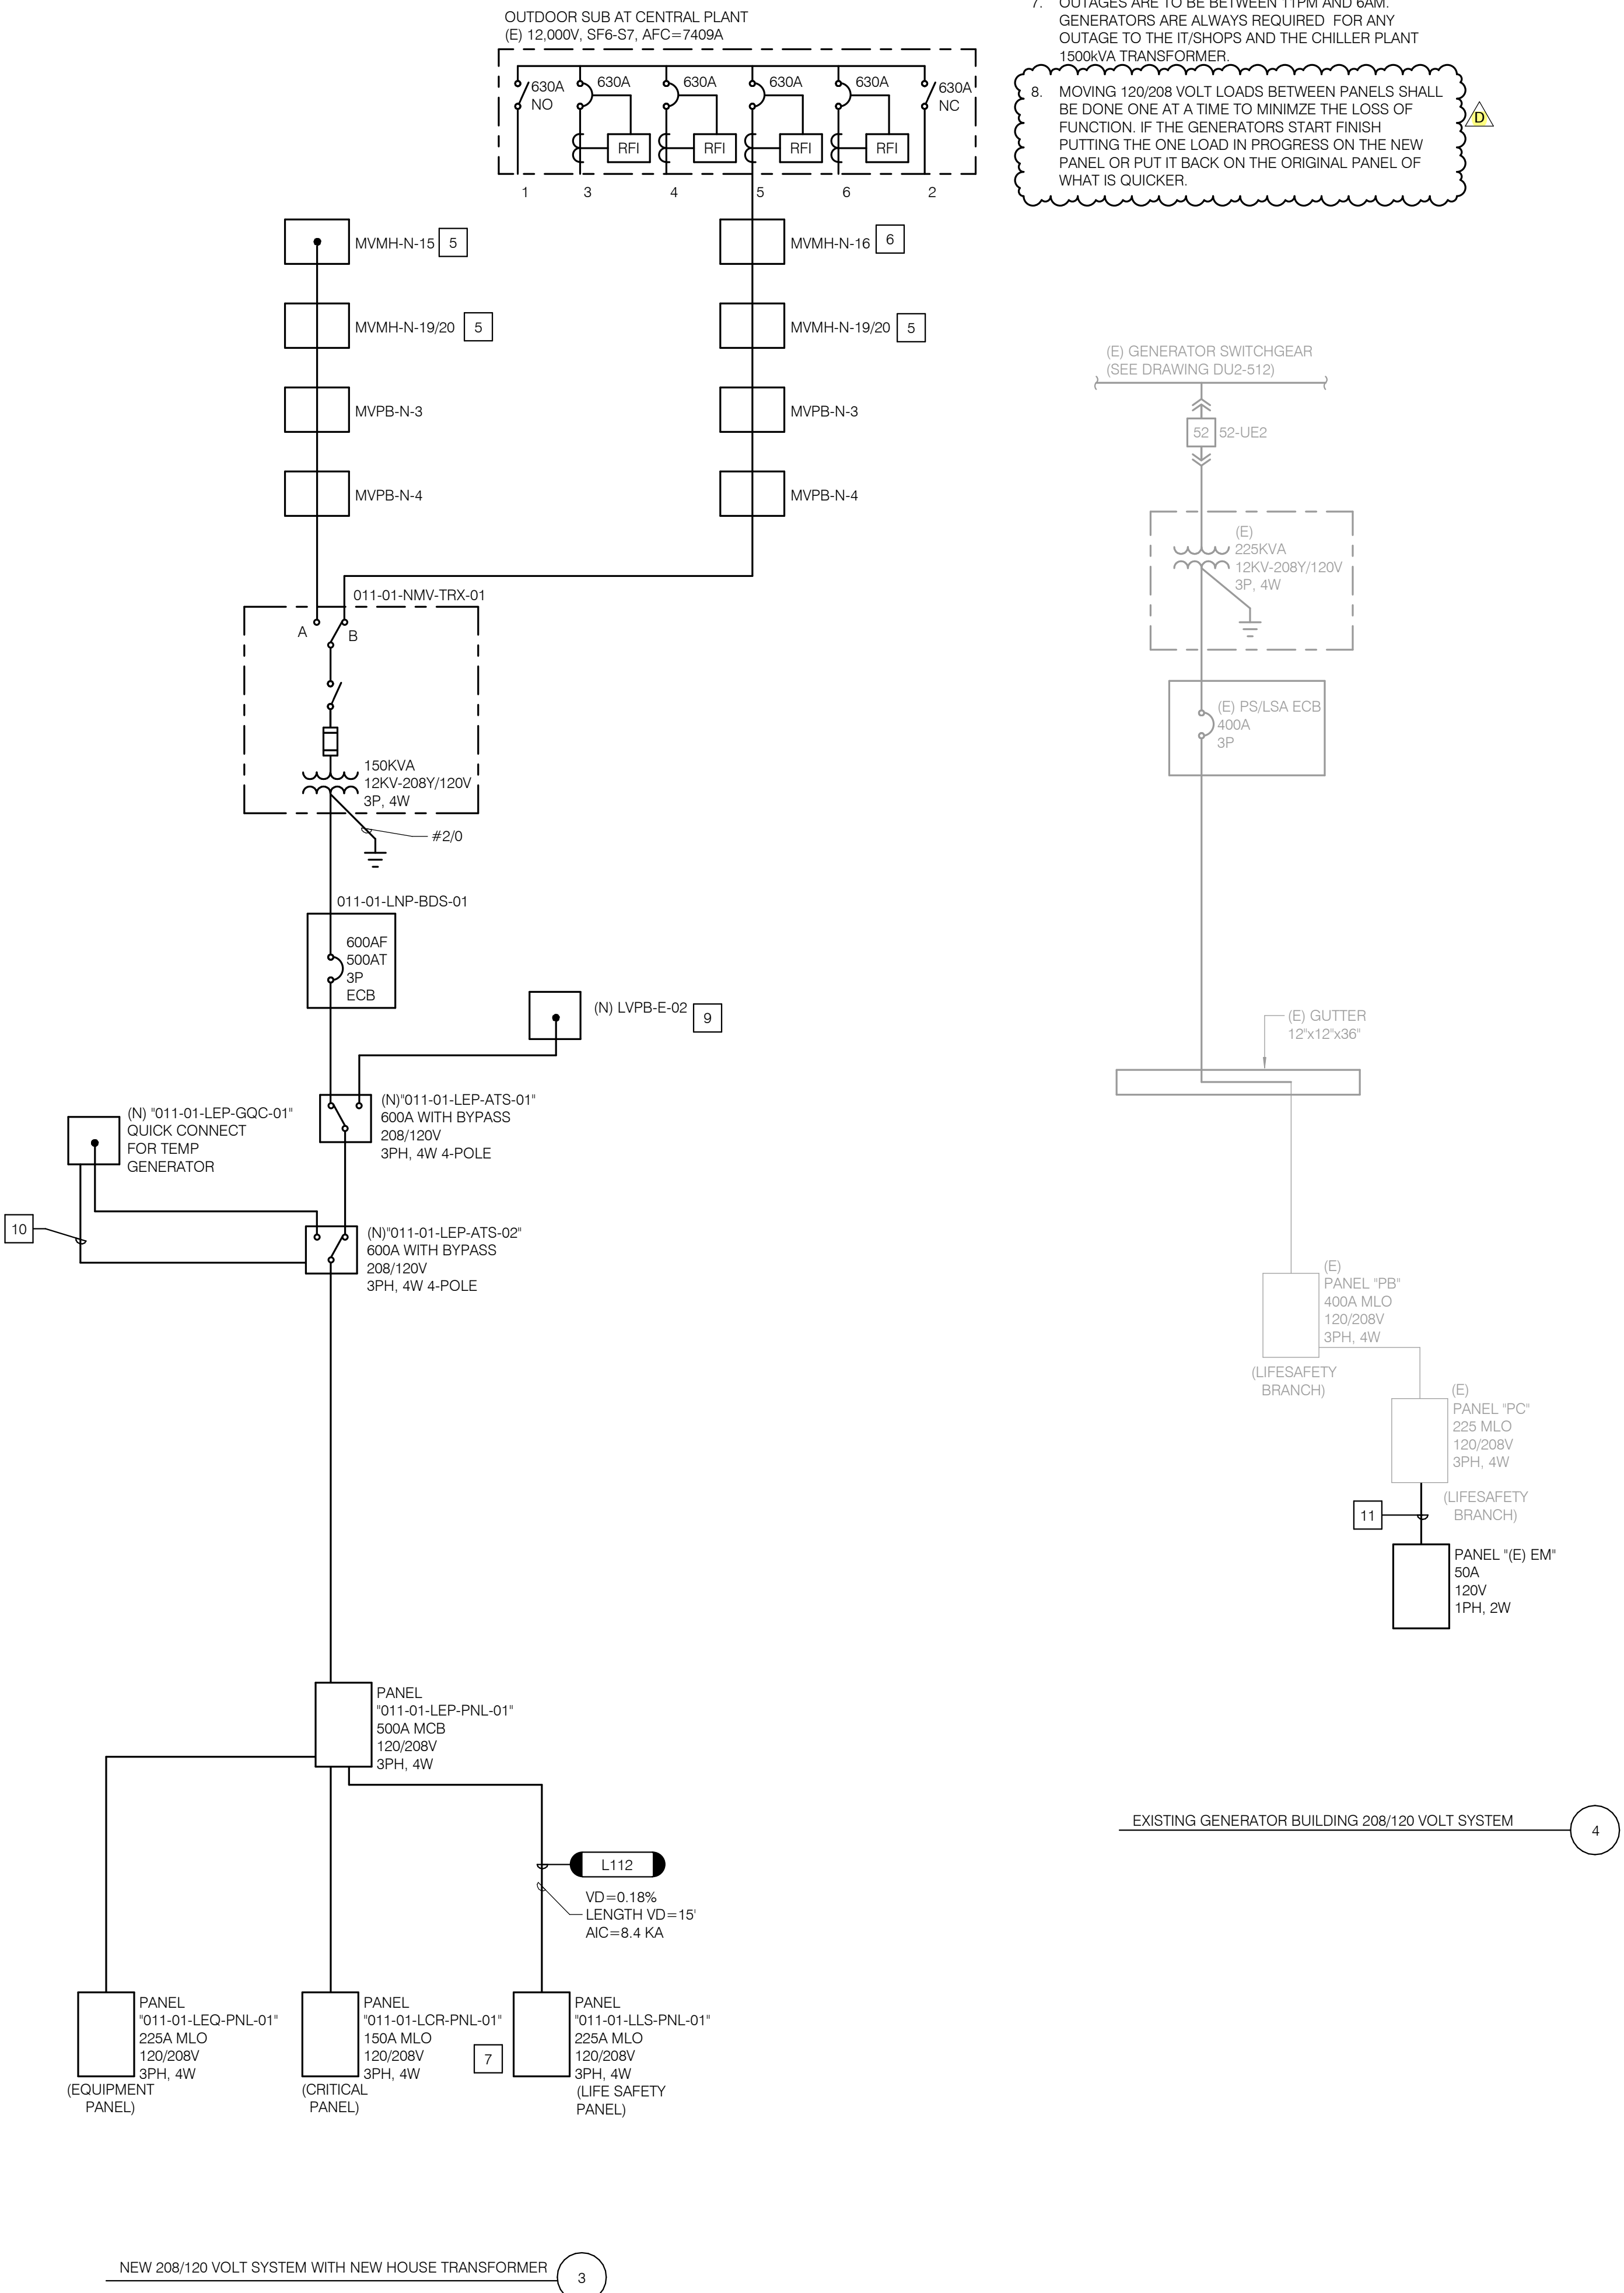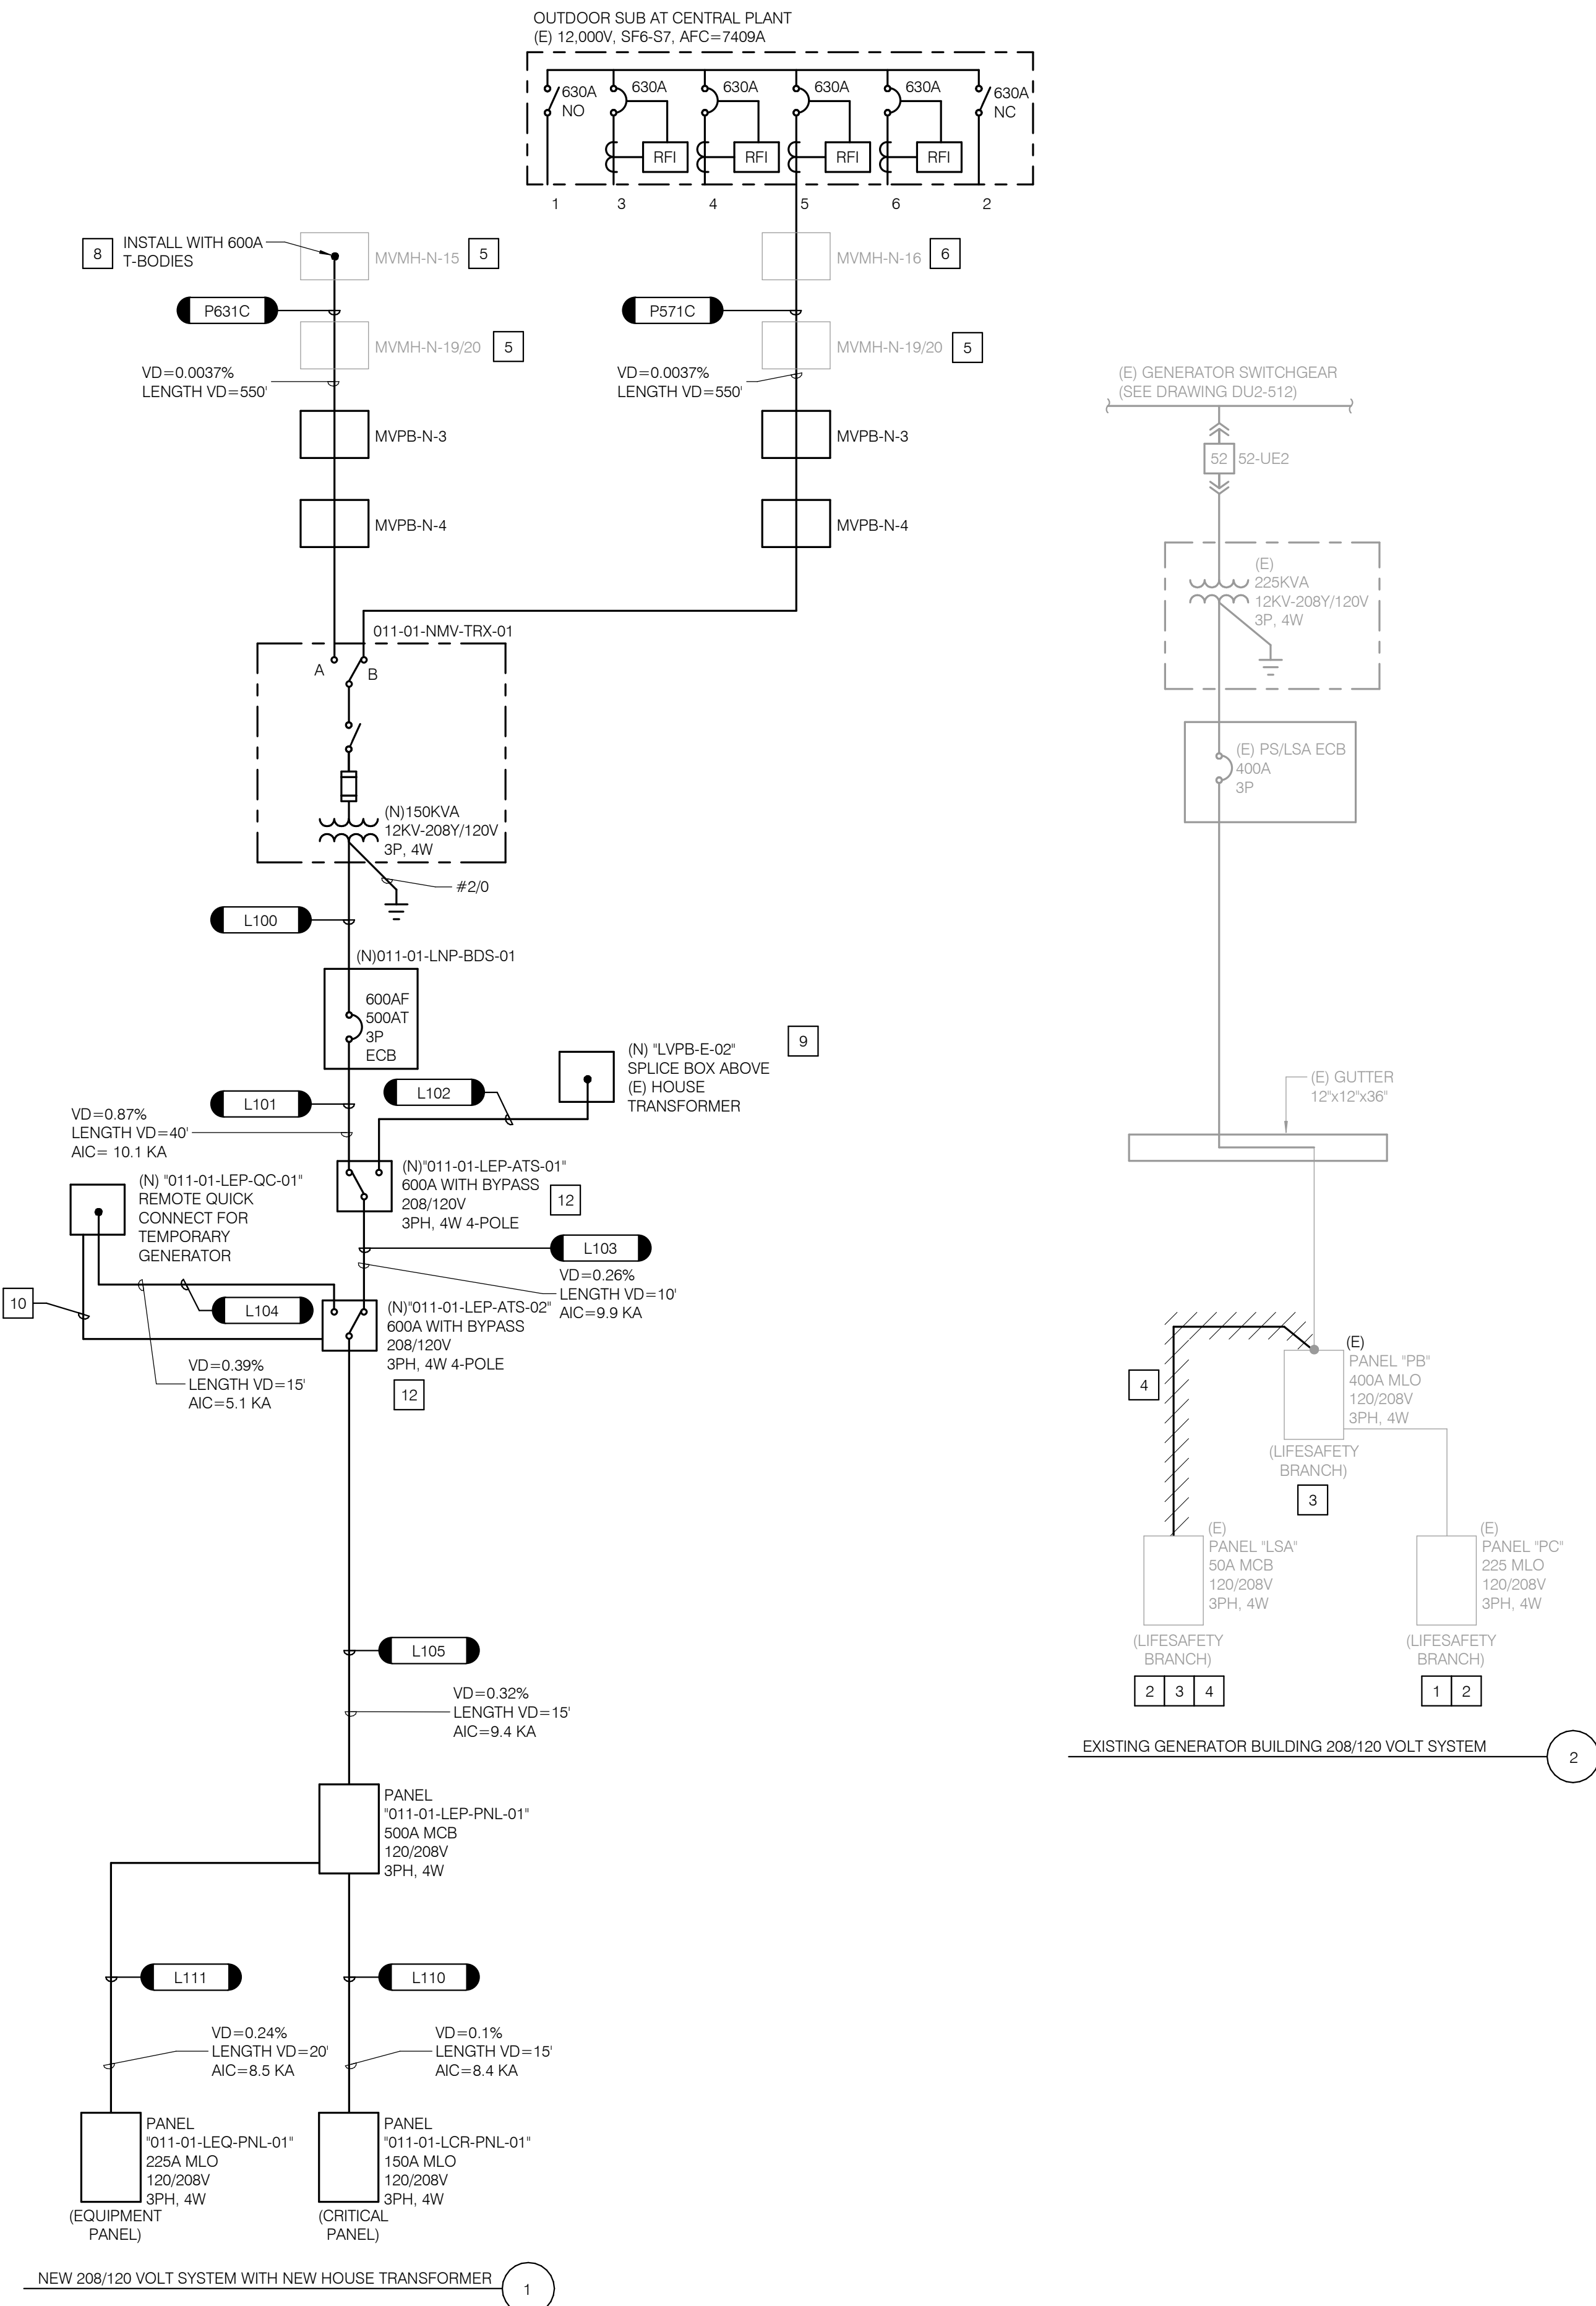

(MILESTONE 1)



RBB ARCHITECTS INC

Joseph A. Balbons, AIA
Sylvia Botero, AIA
Kevin S. Boots, AIA

10980 Wilshire Boulevard
Los Angeles, California
90024-3905

Telephone 310 473 3555
Facsimile 310 473 3555
www.rbbinc.com



AGENCY APPROVALS

OSHPD # 1240005-19-01

CONSULTANT

P2S ENG

Long Beach // Irvine // Los Angeles
San Diego // San Jose // Seattle

p2sinc.com

ISSUE RECORD

DATE	DESCRIPTION
04/09/2025	D ADDENDUM D
04/01/2025	4 HCAI BACKCHECK 3
03/14/2025	A ADDENDUM A
01/31/2025	3 HCAI BACKCHECK 2
10/25/2024	2 HCAI BACKCHECK 1
06/13/2024	1 HCAI SUBMITTAL
04/18/2024	HCAI SUBMITTAL

Harbor-UCLA
MEDICAL CENTER
HARBOR-UCLA MEDICAL CENTER
PHASE 2E INC 2 - GENERATOR BLDG.
RETROFIT

1000 West Carson Street, Torrance, CA 90509

MILESTONE: HCAI SUBMITTAL

MILESTONE DATE: 10/25/2024

RBB PROJECT: 1712105 SCALE: 12" = 1'-0"

DESCRIPTION
LOW VOLTAGE - SINGLE LINE
DIAGRAM



DU2-511

GENERAL NOTES

- ALL OUTAGES REQUIRE A MINIMUM 4 WEEK NOTICE AND AGREEMENT WITH THE OWNER ON TIMING OF THE OUTAGE. MOPS WILL NEED TO BE SUBMITTED AND APPROVED. OUTAGE DURATIONS SHALL BE MINIMIZED SUCH AS ADDING 600A T-BODY TO NEW CABLES BEFORE CUTTING INTO EXISTING 12KV CABLES.
- FOLLOW KEYNOTES IN ORDER.
- PHASE VOLTAGE ROTATION SHALL BE RECORDED BEFORE THE POWER IS SHUT OFF. CONFIRM THE ROTATION ON THE SUPPLY END AND THE LOAD END OF THE CABLE THAT IS TO BE CUT AND/OR REPLACED. AFTER THE CUT OVER AND BEFORE DOWN STREAM LOADS ARE ALLOWED TO COME ON PERFORM PHASE ROTATION AND PHASE TO PHASE TESTING AT THE NEW SUPPLY AND LOAD END OF THE NEW CABLE. RECORD THE RESULTS AND PROVIDE IN OUTAGE REPORT.
- IF THE OUTAGE FOR THE LOADS IS REQUIRED TO BE LONGER THAN 2.5 HOURS PROVIDE TEMPORARY GENERATORS FOR THE LOADS.
- OUTAGES ARE TO BE BETWEEN 11PM AND 6AM. GENERATORS ARE ALWAYS REQUIRED FOR ANY OUTAGE TO THE IT SHOPS AND THE CHILLER PLANT
- MOVING 120/208 VOLT LOADS BETWEEN PANELS SHALL BE DONE ONE AT A TIME TO MINIMIZE THE LOSS OF FUNCTION. IF THE GENERATORS START FINISH PUTTING THE ONE LOAD IN PROGRESS ON THE NEW PANEL OR PUT IT BACK ON THE ORIGINAL PANEL OF WHAT IS QUICKER.

NOTES

- NEW CABLES TERMINATED IN AN INSULATED TAP CONNECTOR WITH INSULATED COVER OVER SOCKET TO TORQUE THE LUG.
- CONDUIT AND CABLE FOR GEN START SIGNALS.
- CONNECT A TEMPORARY 208/120V, 4W, 3 PHASE, 1500VA GENERATOR TO ATS 011-01-LEP-ATS-02. ATS 011-01-LEP-ATS-2 WILL SEND A SIGNAL TO THE TEMPORARY GENERATOR WHEN TO TURN ON AND OFF.
- MOVE INDIVIDUAL LOADS FROM PANEL PB AND PC TO PANEL 011-01-LLS-PNL-01. LOADS TO MOVE ARE SHOWN ON NEW PANEL ON DRAWING DU2-401.2.
- MOVE INDIVIDUAL LOADS FROM PANEL PB AND PC TO PANEL 011-01-LCR-PNL-01. LOADS TO MOVE ARE SHOWN ON NEW PANEL ON DRAWING DU2-401.2.
- MOVE INDIVIDUAL LOADS FROM PANEL PB AND PC TO PANEL 011-01-LEG-PNL-01. LOADS TO MOVE ARE SHOWN ON NEW PANEL ON DRAWING DU2-401.2.
- ENSURE GENERATORS 1 TO 4 ARE AVAILABLE TO RUN. TURN OFF 150A BREAKER IN PANEL PB THAT FEEDS PANEL PC AND REMOVE SUPPLY CABLES FROM THIS BREAKER TO PANEL PC. INSTALL NEW CONDUIT AND CABLE FROM PANEL 011-01-LEP-PNL-01 TO PANEL PC. AFTER CONNECTED, TURN ON FEEDER BREAKER IN PANEL 011-01-LEP-PNL-01 TO RE-POWER PANEL PC. NOTE GENERATORS 5 AND 6 DO NOT HAVE ACCESSORY POWER DURING THIS TRANSITION.
- MOVE INDIVIDUAL GENERATOR #4 208/120 VOLT CIRCUIT LOADS FROM PANEL PB TO PANEL PC. SEE DRAWING DU2-401.2 FOR THE CIRCUITS TO MOVE TO PANEL PC.
- TEMPORARILY MOVE INDIVIDUAL GENERATOR #3 208/120 VOLT LOADS FROM PANEL PB TO PANEL PC. SEE DRAWING DU2-401.2 FOR THE CIRCUITS TO MOVE TO PANEL PC.
- ENSURE GENERATORS 3 AND 4 ARE AVAILABLE TO RUN AFTER INDIVIDUAL GENERATOR #3 AND #4 LOADS ARE MOVED FROM PANEL PB TO PANEL PC. TURN OFF THE GENERATOR SWITCHGEAR BREAKER UE-2 WHICH DE-ENERGIZES THE EXISTING HOUSE POWER TRANSFORMER. ECB 400A BREAKER ENCLOSURE, AND PANEL PB. REMOVE PANEL SUPPLY CABLES FROM ECB 400A TO PANEL PB. INSTALL NEW CABLE FROM PANEL 011-01-LEP-PNL-01 TO PANEL PB USING NEW AND EXISTING CONDUIT AND GUTTER. SEE DRAWING DU2-604 DETAIL 1. AFTER CONNECTED, TURN ON FEEDER BREAKER IN PANEL 011-01-LEP-PNL-01 TO RE-POWER PANEL PB. NOTE GENERATORS 1 AND 2 DO NOT HAVE ACCESSORY POWER DURING THIS TRANSITION.
- WITH THE GENERATOR SWITCHGEAR BREAKER UE-2 OFF, ECB 400A BREAKER ENCLOSURE STILL DE-ENERGIZED, AND POWER CABLE REMOVED FROM ECB TO PANEL PB REMOVE CONDUIT ABOVE ECB AND CONNECT TO TERMINAL BOX ABOVE ECB. INSTALL CABLE FROM ECB TO TERMINAL BOX AND CONNECT.
- NOTE THAT UE-2 BREAKER BACKUP BY THE GENERATOR SYSTEM. TURN ON THE GENERATOR SWITCHGEAR BREAKER UE-2 WHICH ENERGIZES THE EXISTING HOUSE POWER TRANSFORMER AND TO ECB 400A BREAKER. THE NEW AND EXISTING 208/120 VOLT PANELS ARE NOW WITH GENERATOR BACKUP POWER VIA ATS 011-01-LEP-ATS-01.
- REMOVE TEMPORARY GENERATOR AFTER EXISTING 400A ECB IS CONNECTED TO ATS 011-01-LEP-ATS-01 AND 12KV BREAKER UE-2 IS TURNED ON.
- AFTER PANEL PB IS SUPPLIED BY PANEL 011-01-LEP-PNL-01 MOVE BACK THE TEMPORARILY MOVED INDIVIDUAL GENERATOR #3 208/120 VOLT LOADS THAT ARE NOW ON PANEL PC BACK TO PANEL PB. SEE DRAWING DU2-401.2 FOR THE CIRCUITS TO MOVE BACK TO PANEL PC.
- RENAME PANEL PB AND PC TO LATEST REQUIREMENTS THAT NOTE THEY ARE NOW ONLY LIFE SAFETY LOADS.
- NEW 2-#16 AWG AND 1-#10 AWG GND IN NEW 0.75" CONDUIT FOR EMERGENCY LIGHTING INVERTER.

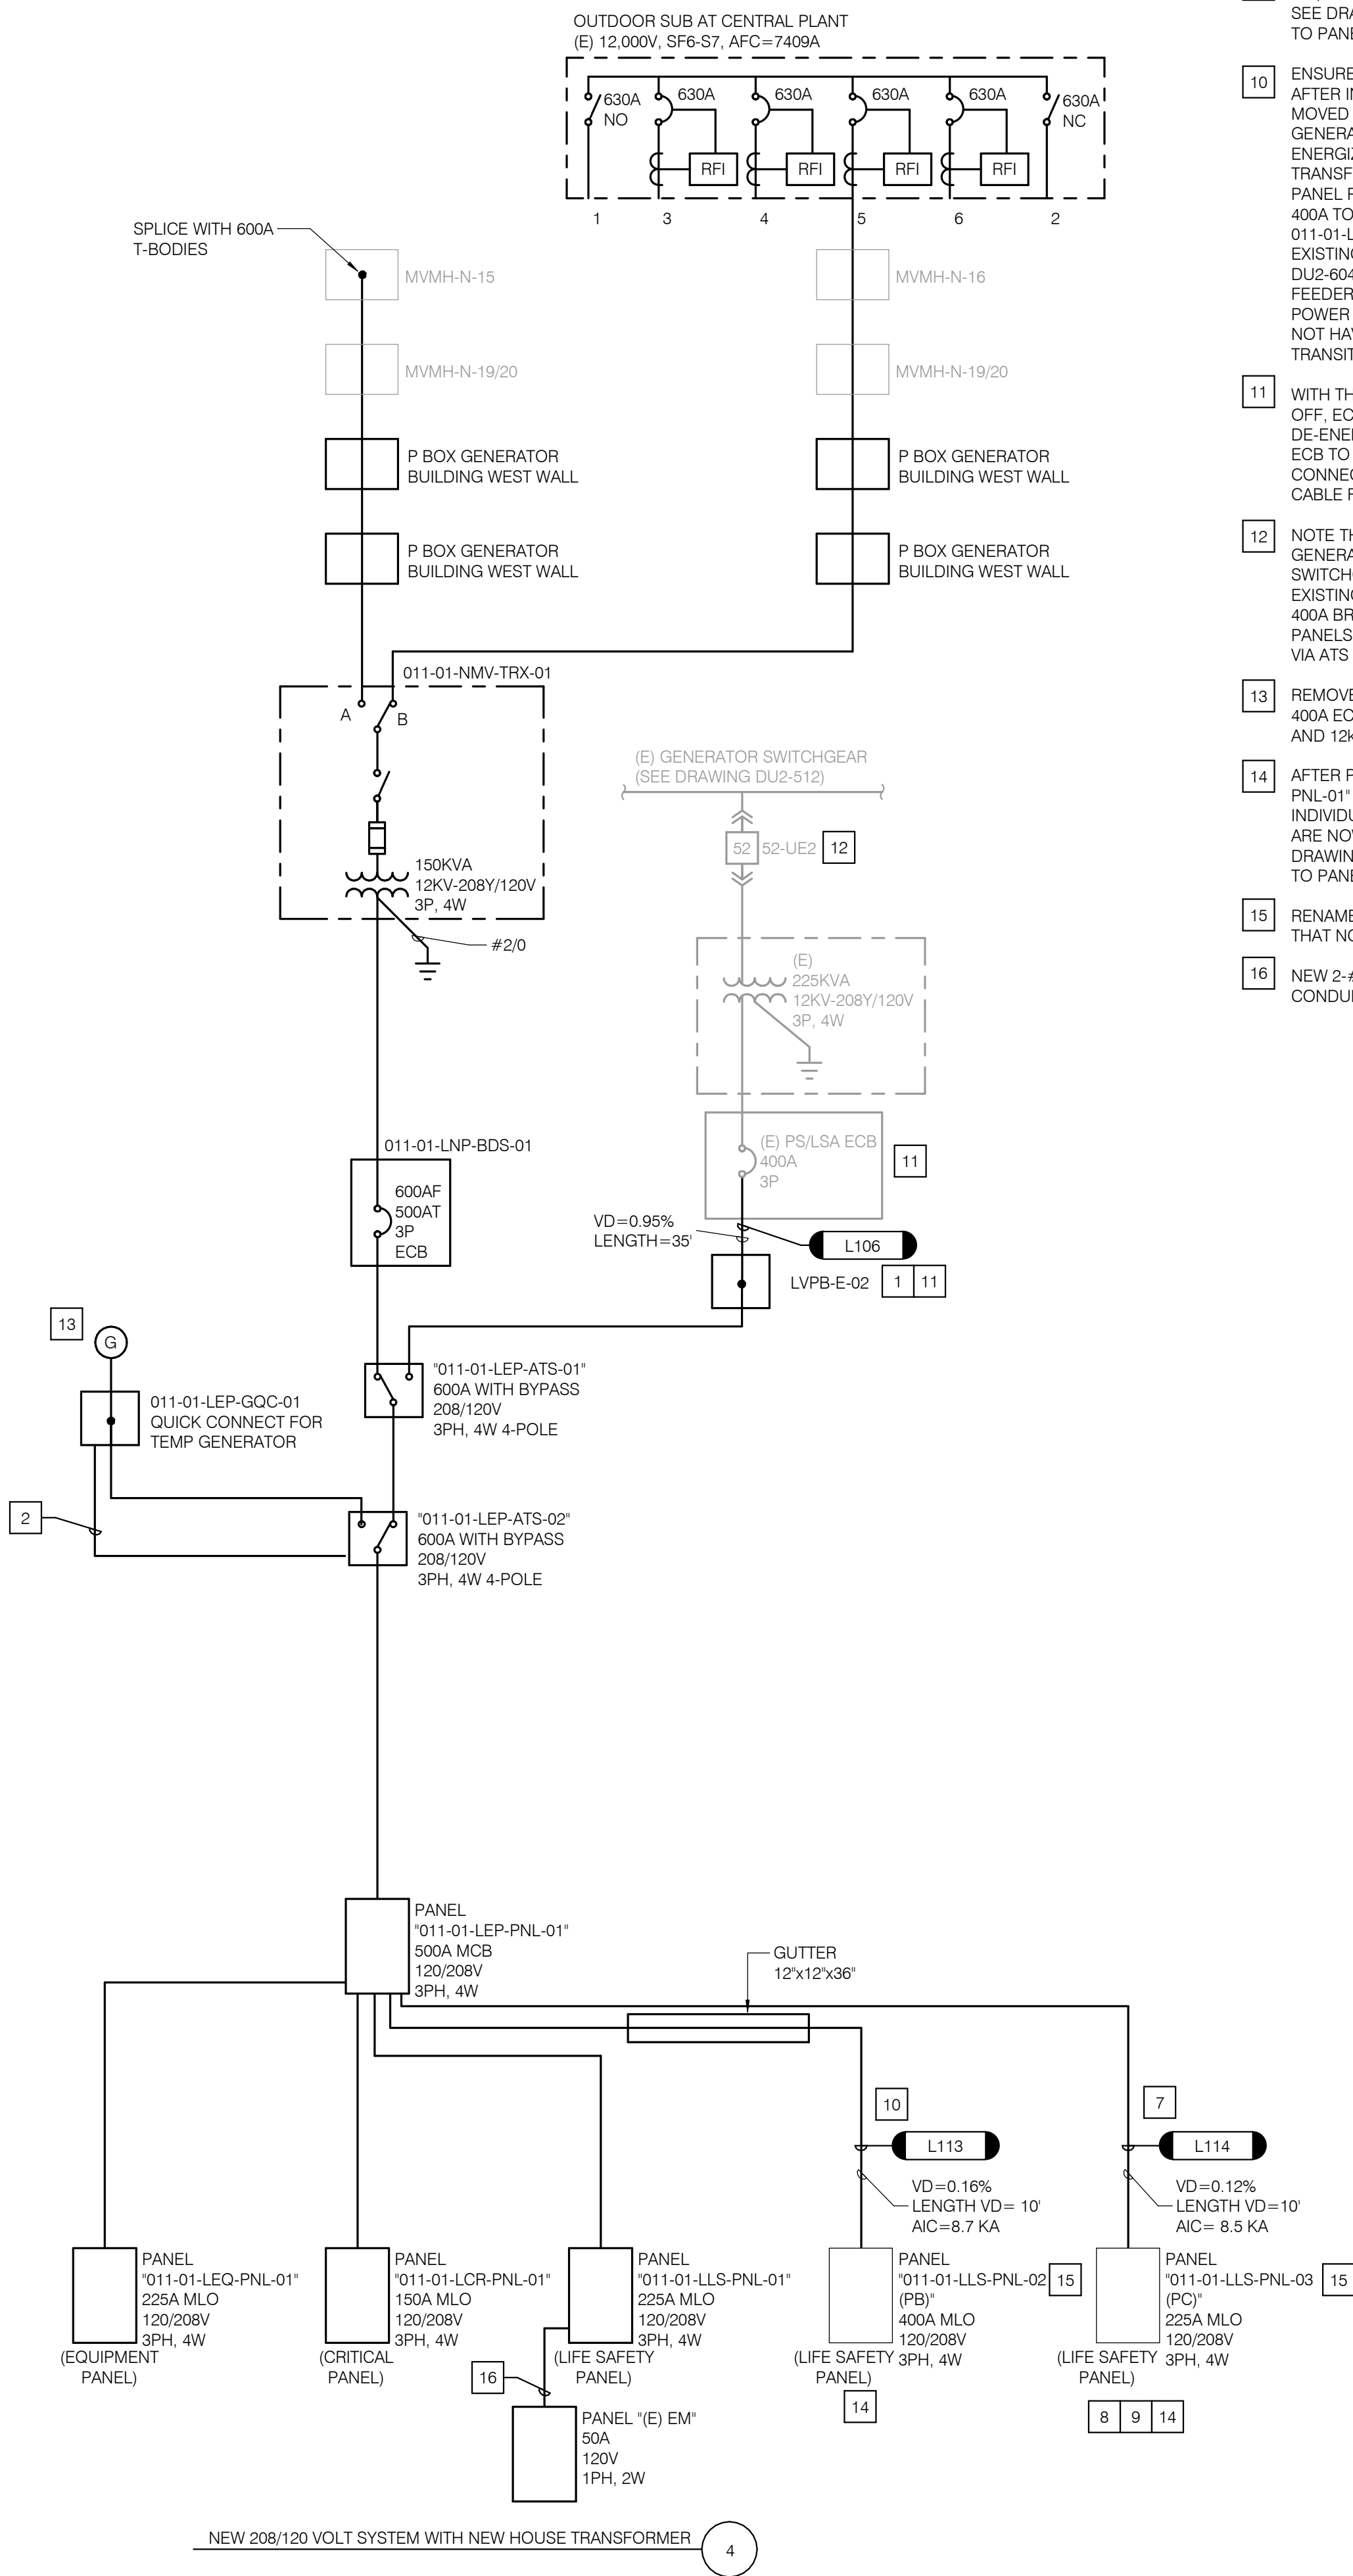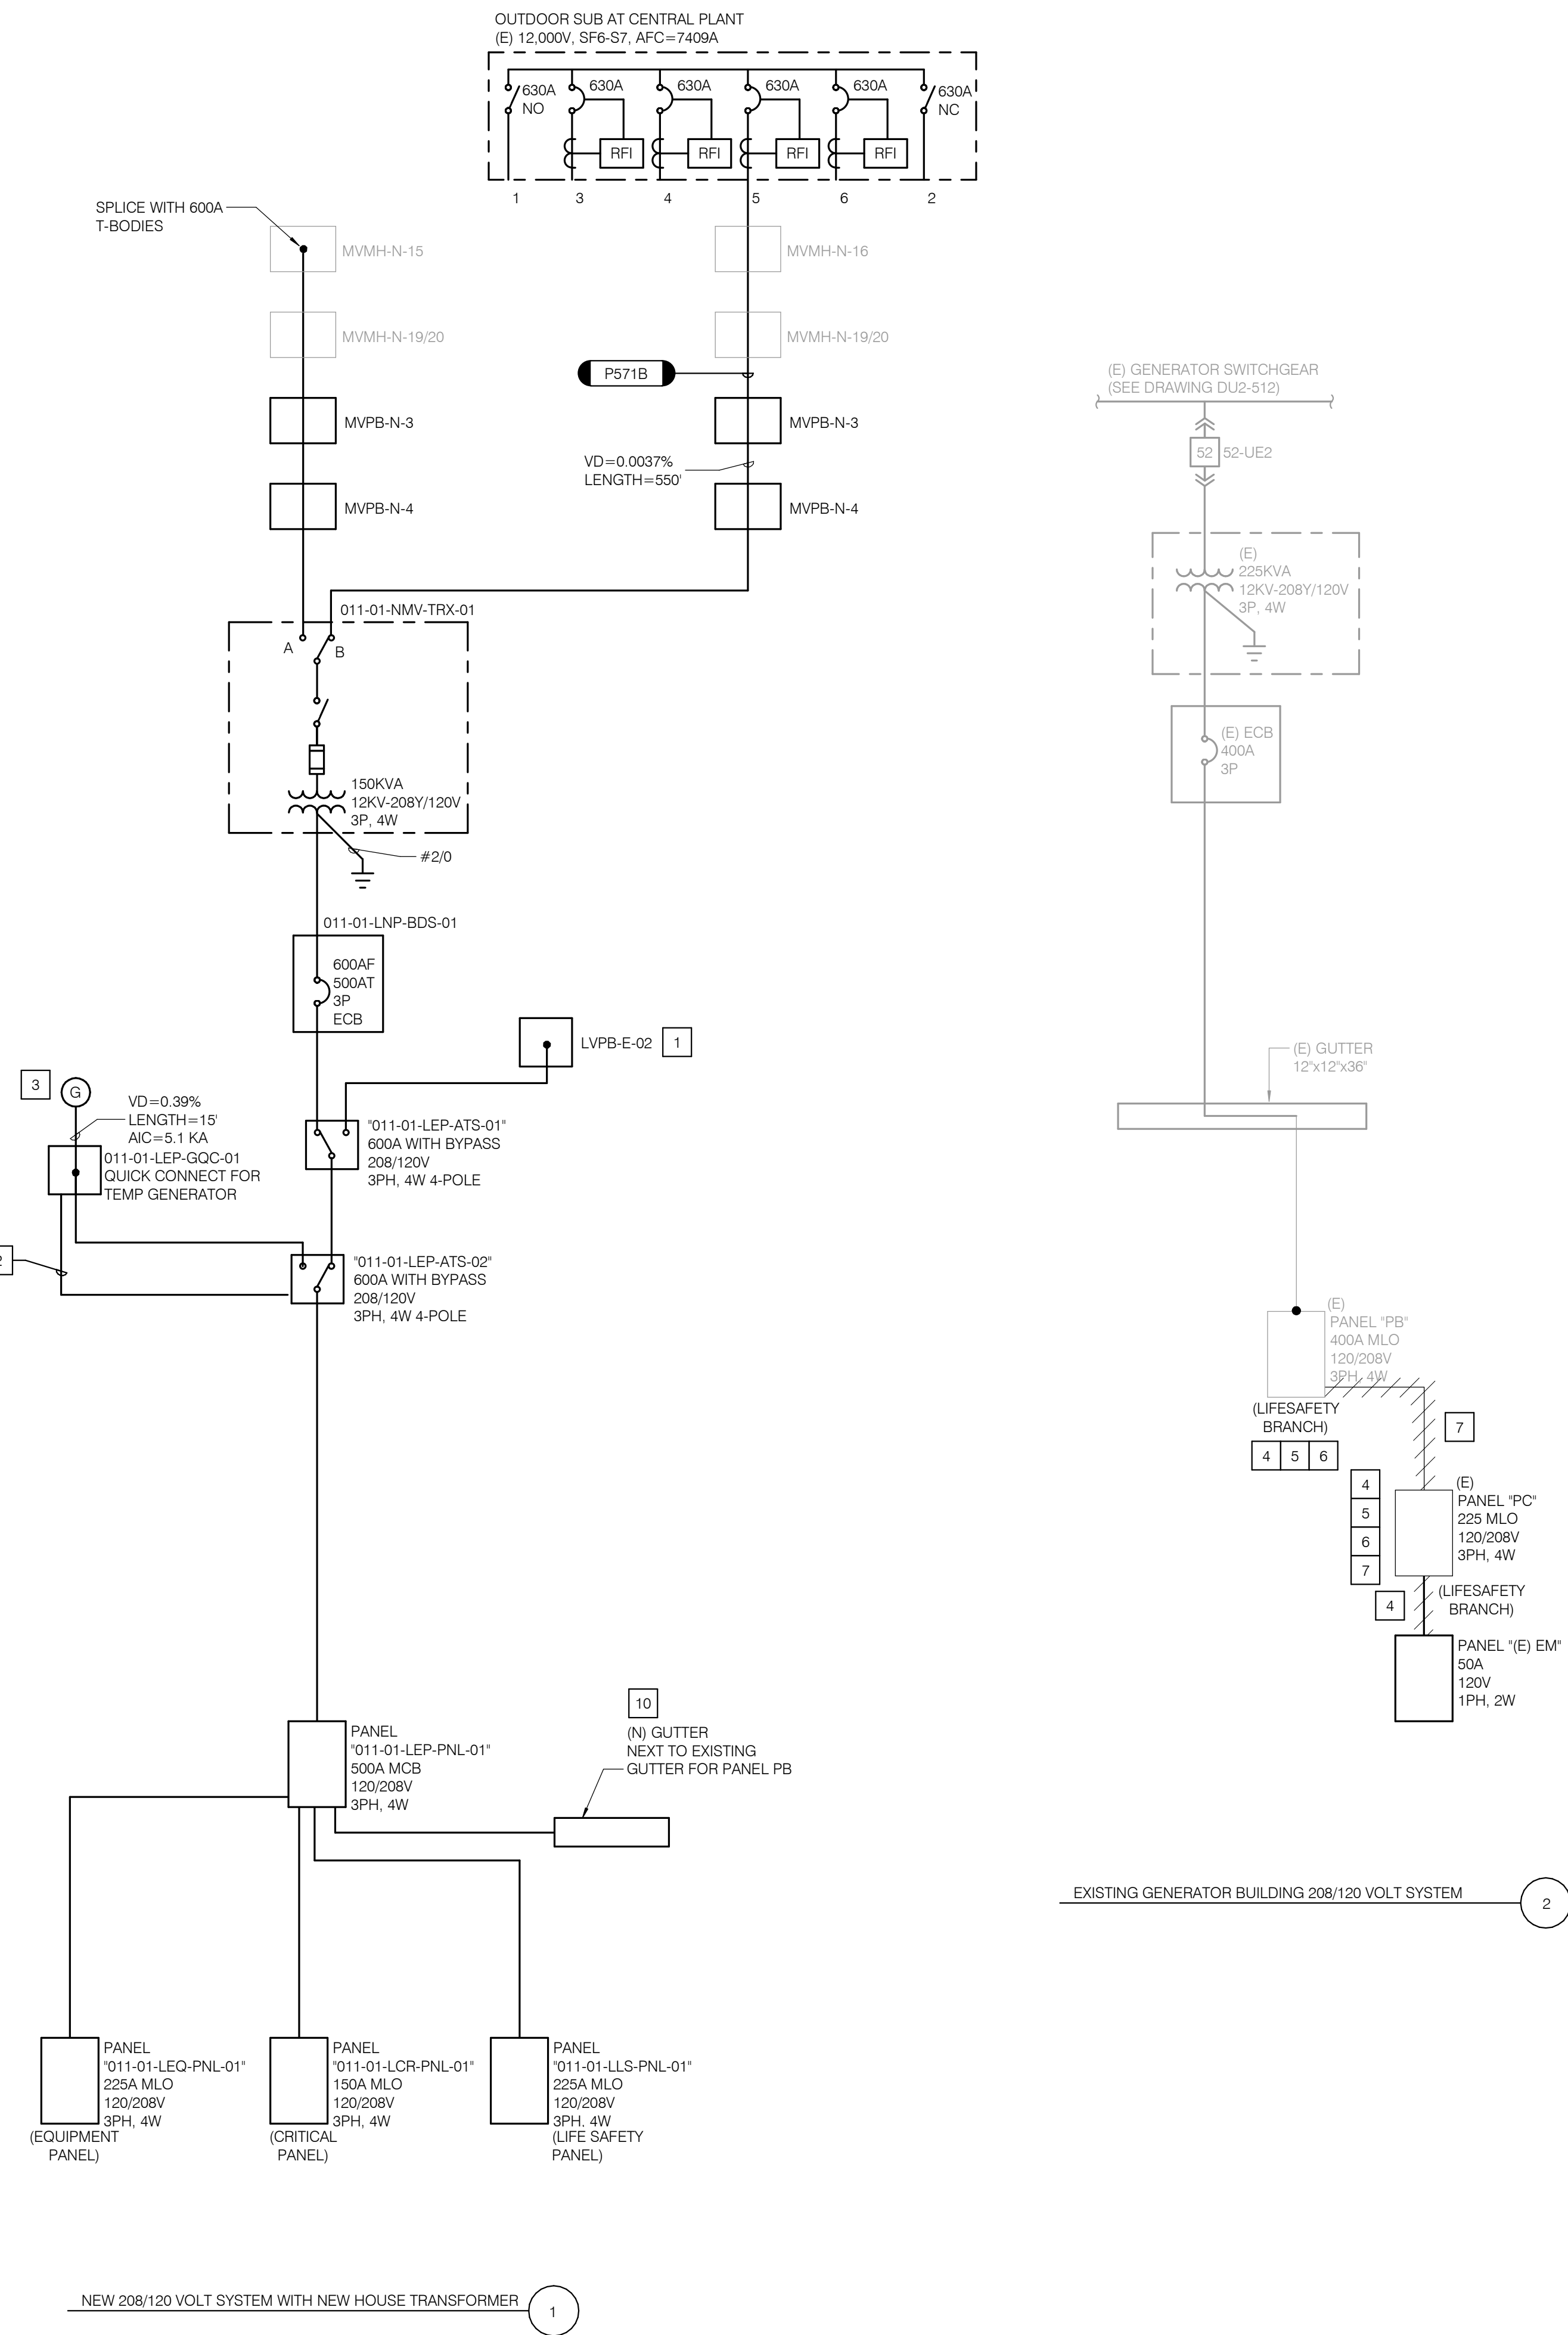

(MILESTONE 1)



RBB ARCHITECTS INC

Joseph A. Balbons, AIA
Sylvia Botero, AIA
Kevin S. Boots, AIA

10980 Wilshire Boulevard
Los Angeles, California
90024-3905

Telephone 310 473 3555
Facsimile 310 473 3555
www.rbbinc.com



AGENCY APPROVALS

OSHPD # 1240005-19-01

CONSULTANT




Long Beach // Irvine // Los Angeles
San Diego // San Jose // Seattle

p2sinc.com

ISSUE RECORD

DATE	DESCRIPTION
04/09/2025	D - ADDENDUM D
04/01/2025	4 - HCAI BACKCHECK 3
03/14/2025	A - ADDENDUM A
01/31/2025	3 - HCAI BACKCHECK 2
10/25/2024	2 - HCAI BACKCHECK 1
06/13/2024	1 - HCAI SUBMITTAL
04/18/2024	1 - HCAI SUBMITTAL

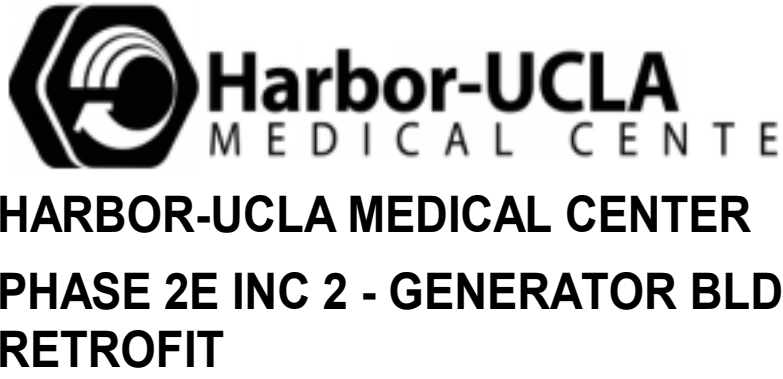


MILESTONE: HCAI SUBMITTAL

MILESTONE DATE: 10/25/2024


RBB PROJECT: 1712105 SCALE: 12" = 1'-0"

DESCRIPTION
LOW VOLTAGE CUT OVERS -
SINGLE-LINE DIAGRAM


DU2-513

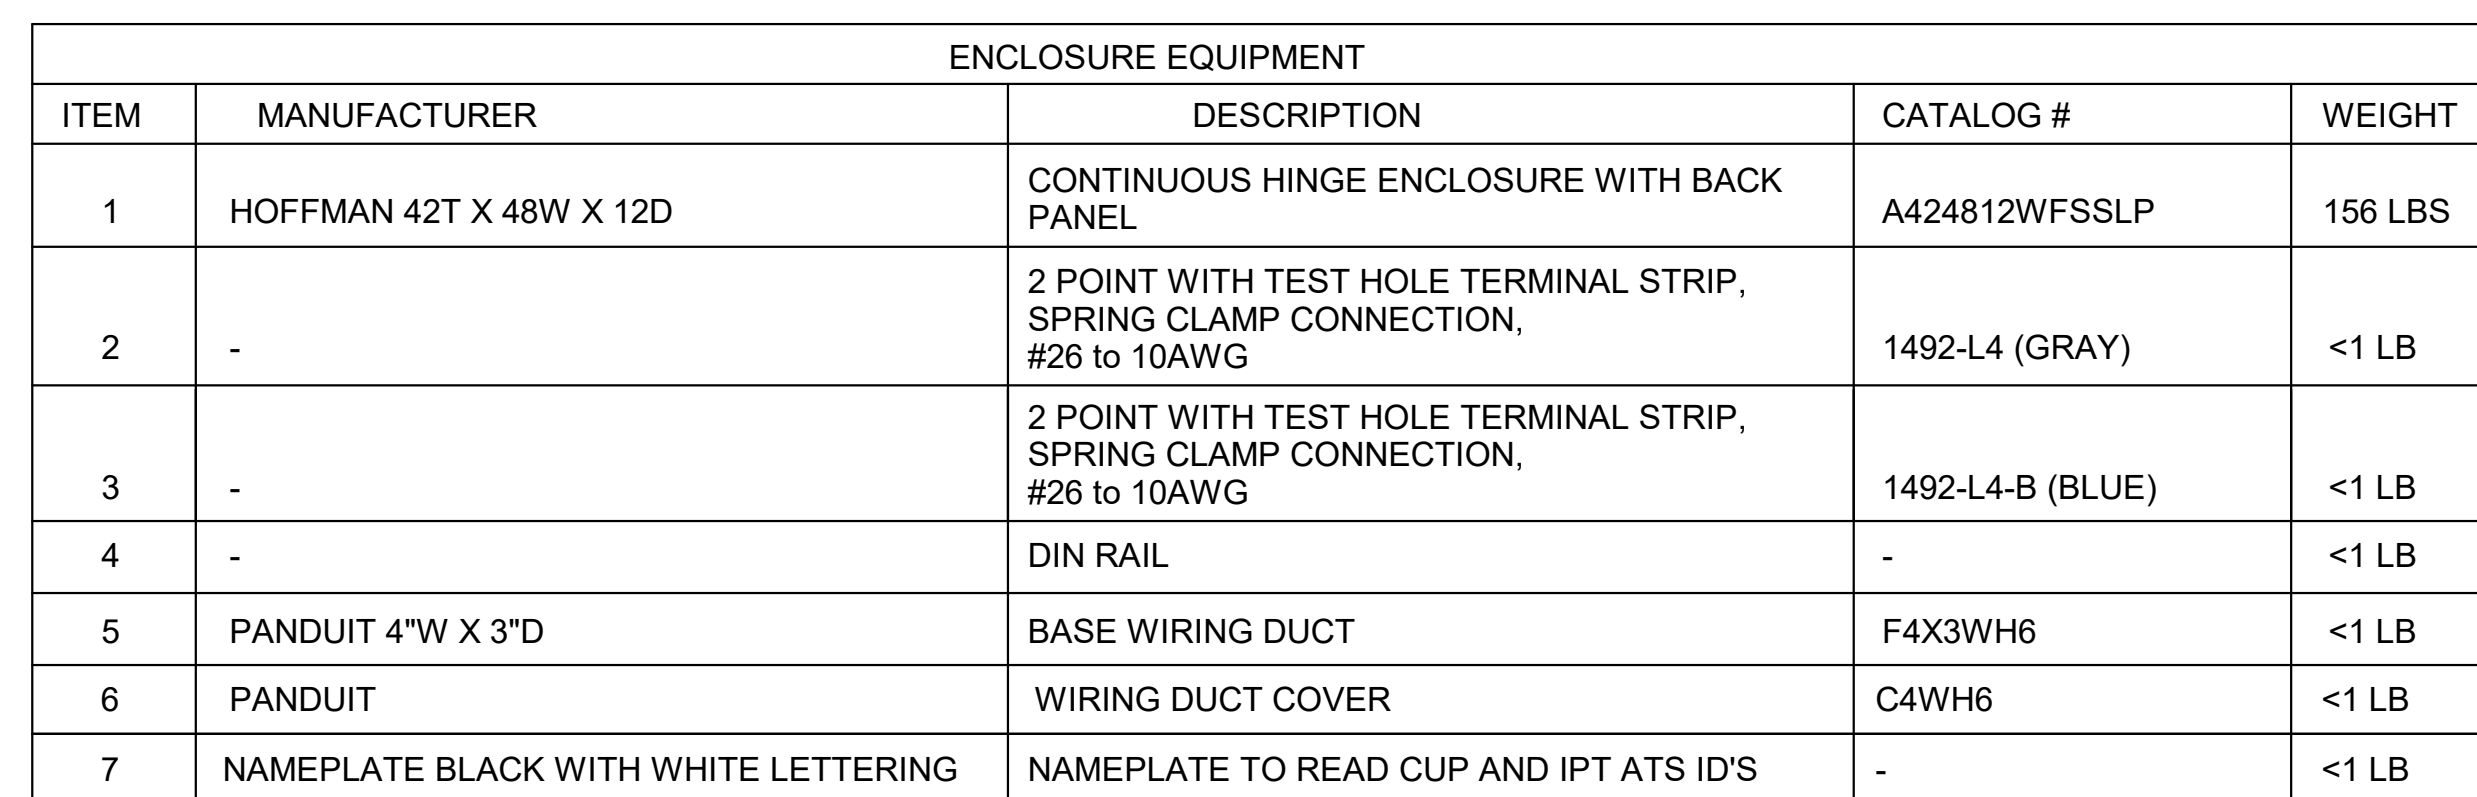


SCALE: NONE

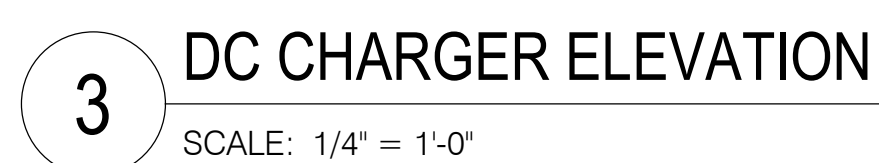


- DU2-604


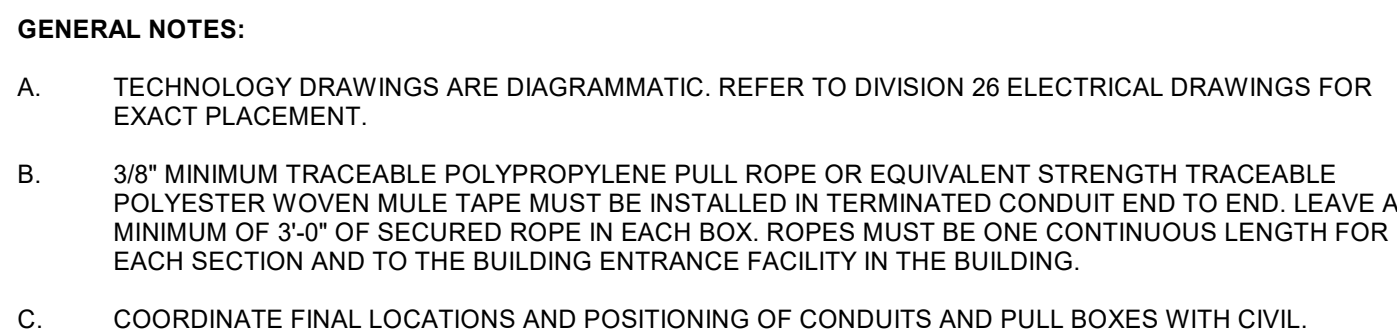


2

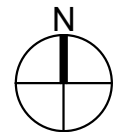

1

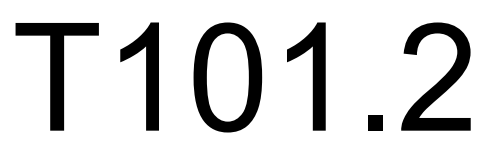

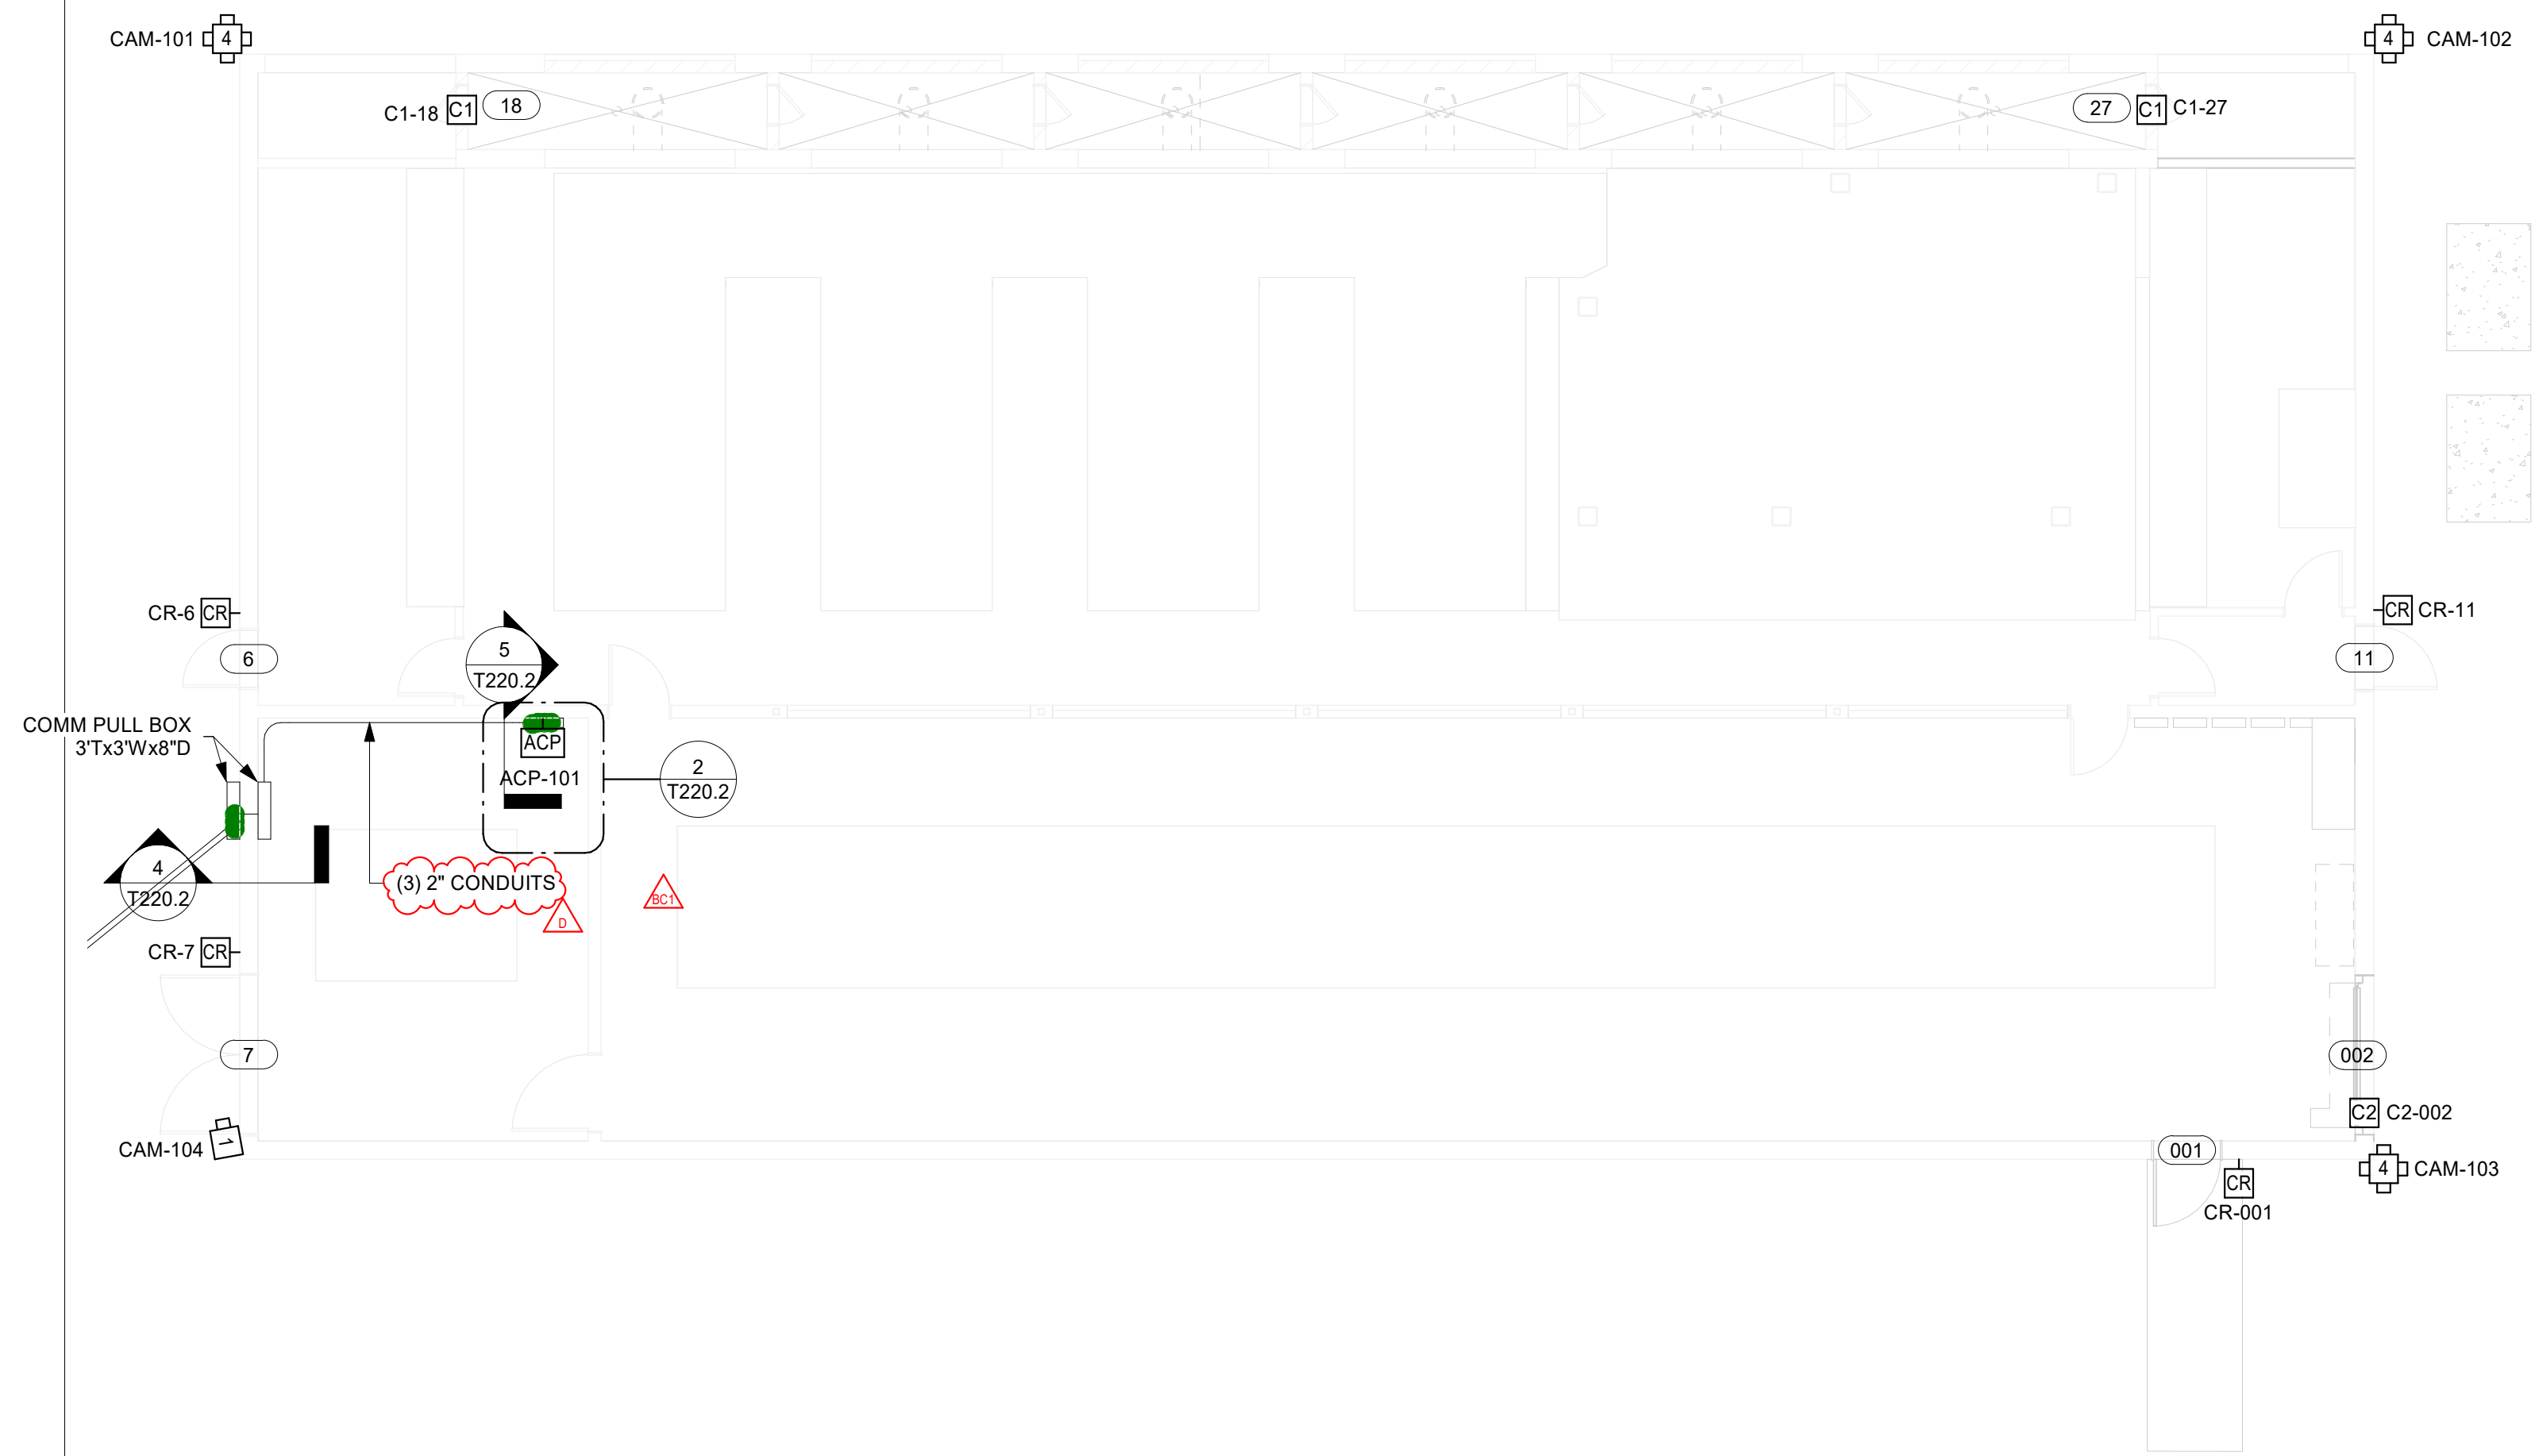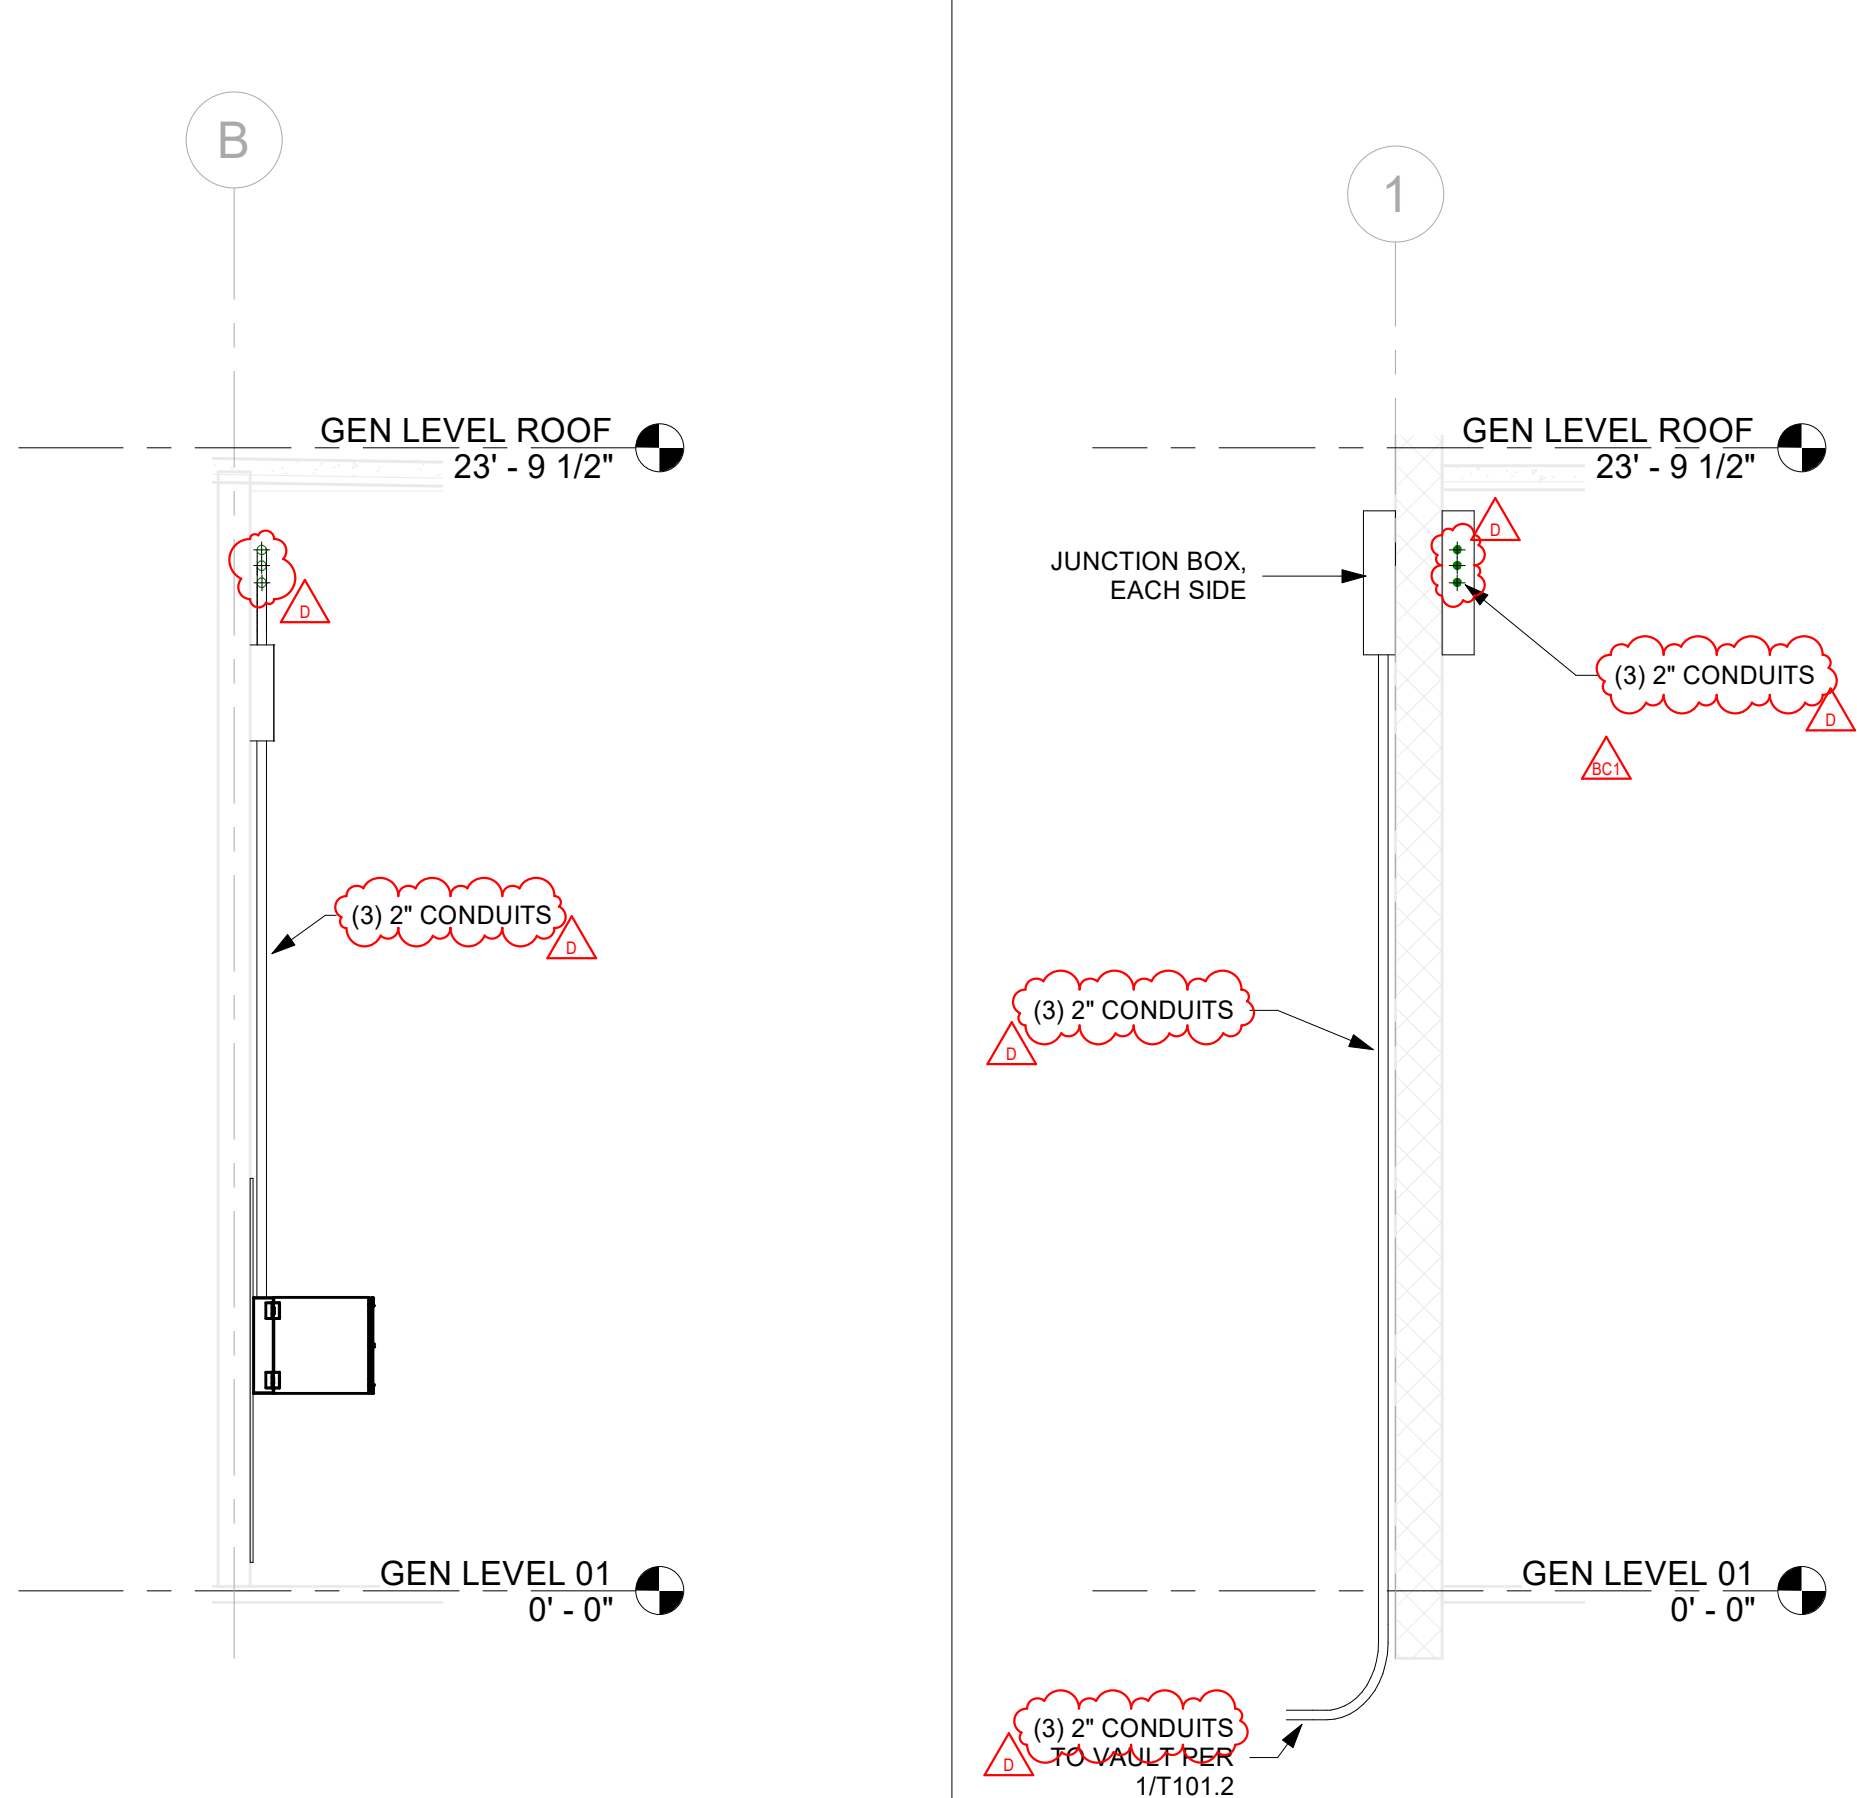

- GENERAL NOTES:**
- ALL CABLING SHALL BE WITHIN EMT CONDUIT. NO CABLING SHALL BE EXPOSED. CONDUIT PATHWAYS MAY BE COMBINED WHILE MAINTAINING 40% MAX FILL RATIO. PROVIDE JUNCTION BOXES FOR EVERY 180 DEGREES OF BENDS AND EVERY 100FT OF CONDUIT. CONDUIT BEND RADIUS AND JUNCTION BOX SIZES SHALL BE BASED ON CABLING MAX BEND RADIUS.
 - CONDUITS TO DEVICE LOCATIONS ARE NOT PERMITTED TO BE WITHIN SLAB. CONDUITS SHALL BE ANCHORED TO WALLS AND INSTALLED PER 517670.
 - INSTALL NEW WALL MOUNTED IDF ENCLOSURE AND ACCESS CONTROL PANEL AS SPECIFIED. ROUTE CONDUITS FROM DEVICES TO APPLICABLE HEAD END EQUIPMENT.
 - INSTALL NEW PATCH PANEL WITHIN IDF ENCLOSURE FOR NEW HORIZONTAL CABLING TERMINATIONS.
 - IDF ENCLOSURE SHALL BE INSTALLED PER 1/7671. ENCLOSURE MAX WEIGHT DEFINED IN OPM-0196.
- SHEET NOTES:**
- INSTALL APC SMART UPS SMT1500RM2U CERTIFIED UNDER OSP-0179. UPS WEIGHT 58.42 LBS.

SECTION - CONDUIT TO IDF ENCLOSURE

1/4" = 1'-0"

5

SECTION - CONDUIT ENTRY


1/4" = 1'-0"

4

TECHNOLOGY GENERATOR BLDG. (E) FIRST FLOOR PLAN

1/8" = 1'-0"


1

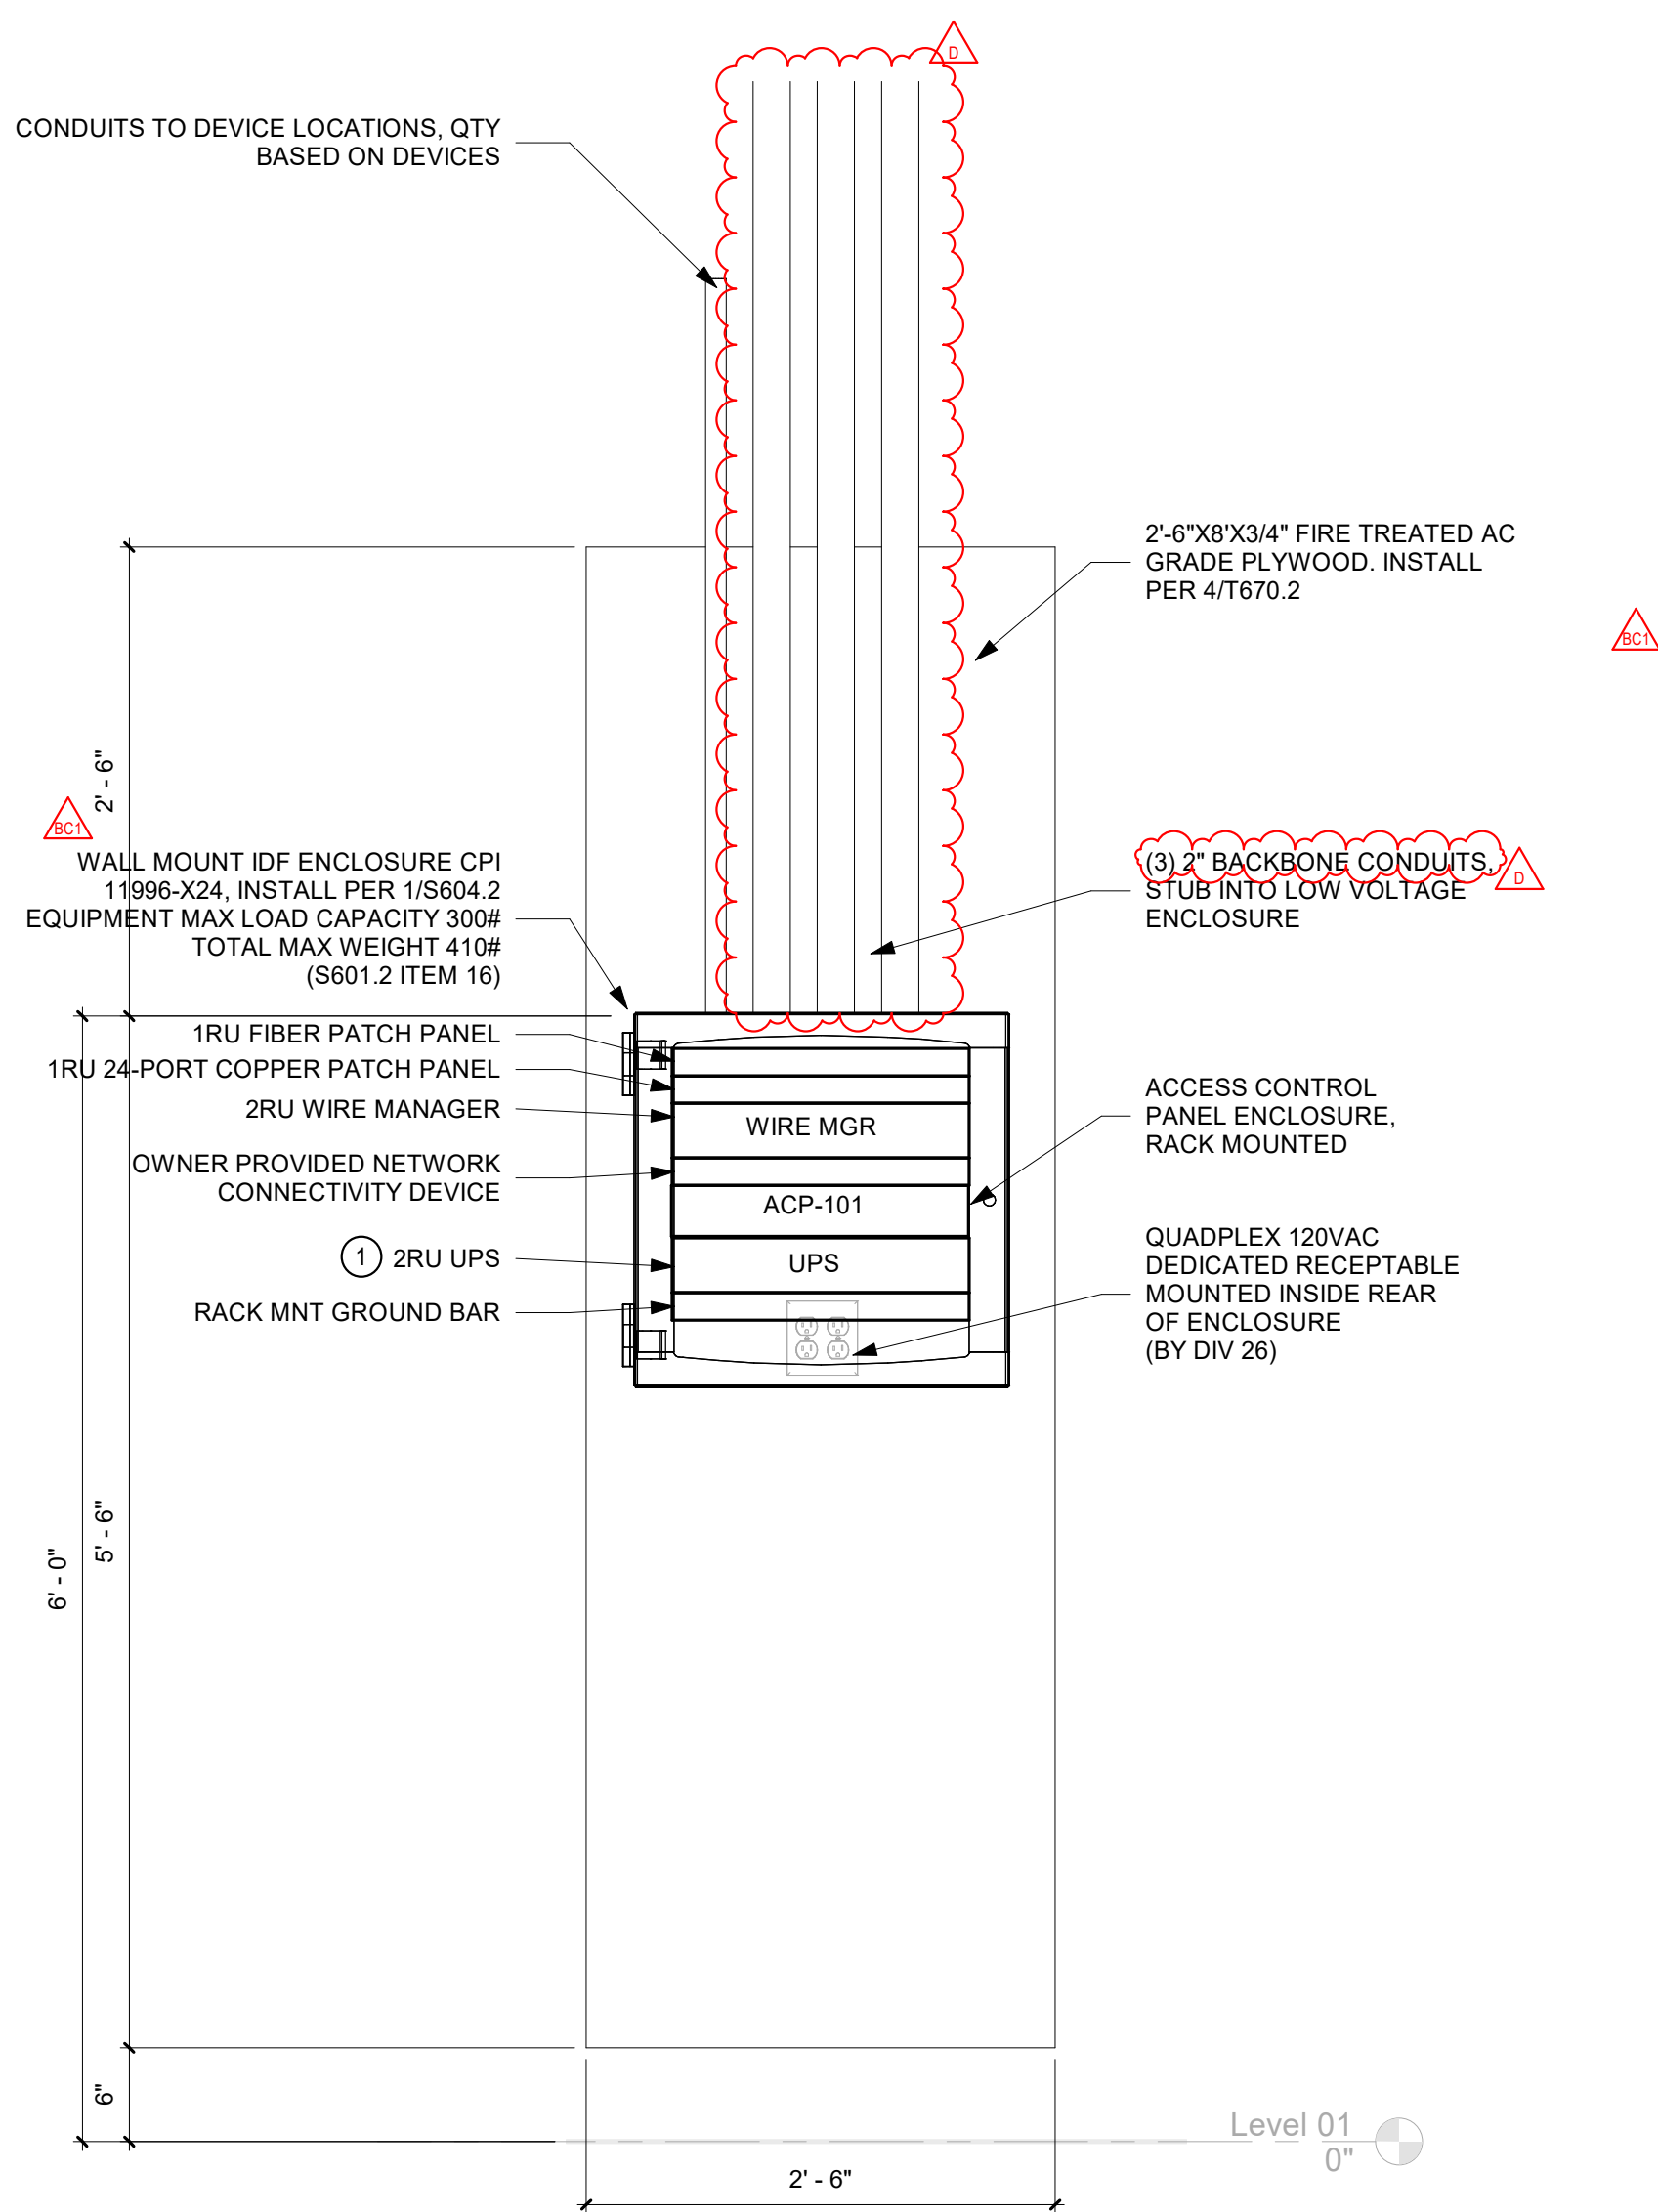

WALL ELEVATION

1" = 1'-0"


3

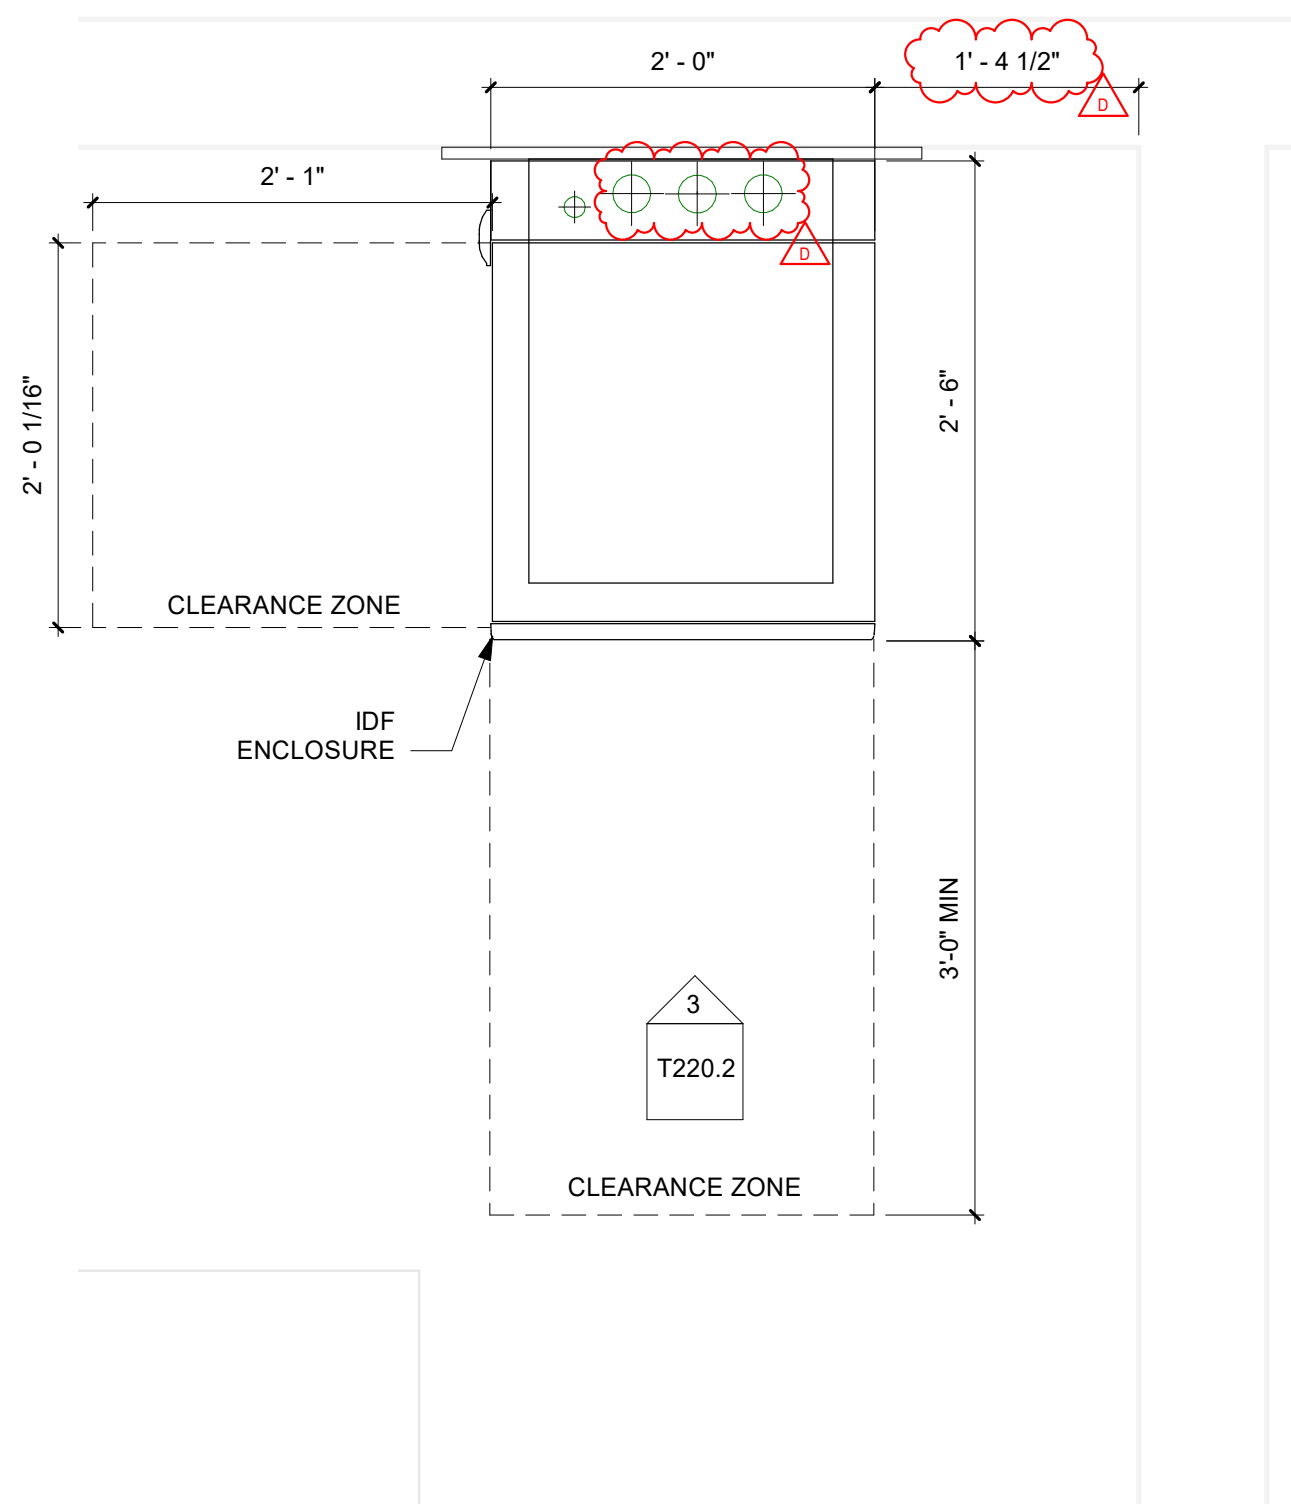

GENERATOR BLDG. ENLARGED PLAN

1" = 1'-0"

2

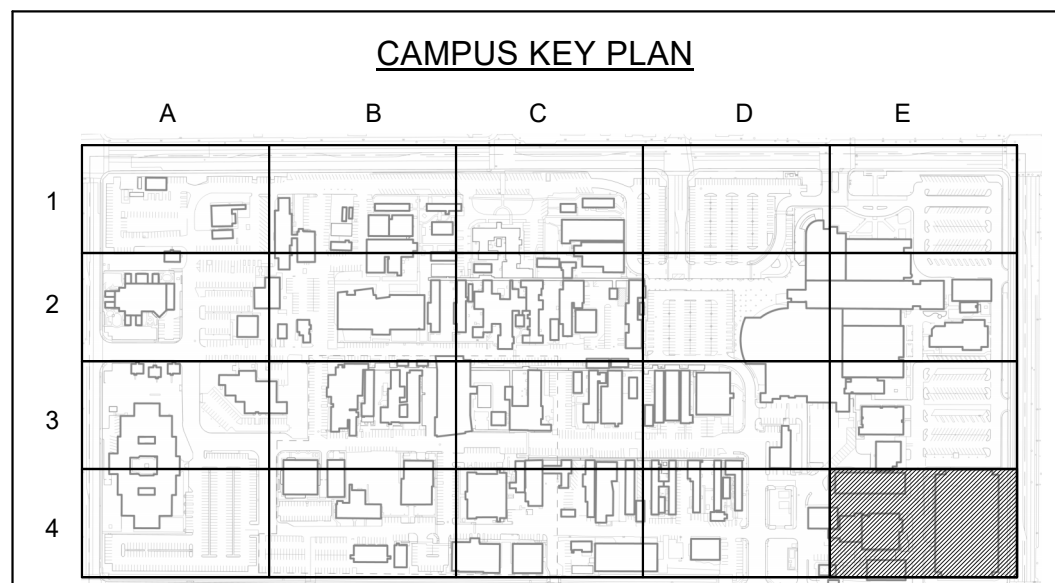

RBB ARCHITECTS INC

Joseph A. Balbons, AIA
Sylvia Botero, AIA
Kevin S. Boots, AIA

10980 Wilshire Boulevard
Los Angeles, California
90024-3905

Telephone 310 473 3555
Facsimile 310 473 3555
www.rbbinc.com



AGENCY APPROVALS

HCAI# I240005-19-02

CONSULTANT



895 DOVE ST. 3RD FLOOR
NEWPORT BEACH, CA 92660
949.324.3547
© 2025

ISSUE RECORD

DATE	DESCRIPTION
04/09/2025	D ADDENDUM D
10/25/2024	BC1 HCAI BACKCHECK 1
06/13/2024	HCAI SUBMITTAL
04/18/2024	HCAI SUBMITTAL

Harbor-UCLA
MEDICAL CENTER
HARBOR-UCLA MEDICAL CENTER
PHASE 2E INC 2 - GENERATOR BLDG. RETROFIT

1000 West Carson Street, Torrance, CA 90509

MILESTONE: HCAI SUBMITTAL
MILESTONE DATE: 10/25/2024
RBB PROJECT: 1712076 SCALE: As indicated

DESCRIPTION
TECHNOLOGY GENERATOR
BLDG. FIRST FLOOR PLAN

T220.2

SECTION 00 03 00
FORM OF BID TO BE USED BY BIDDERS

The undersigned proposes to furnish all materials, labor, and equipment required for the construction to complete the Harbor-UCLA Medical Center Replacement Program Generator Building Retrofit Project Component, in accordance with Drawings and Specifications 7962, including addenda thereto, if any, adopted by the Board of Supervisors, and on file in the office of the Board of Supervisors, as follows:

1. INCREMENT 1 LUMP SUM BID:

The lump sum bid for the work, including Best Management Practices (BMP) and Construction and Demolition Debris Recycling, and Mandatory Jobs Coordinator requirements complete according to the Drawings and Specifications **for Increment 1**, will be:

(\$ _____) (_____)
 Lump sum bid in figures Lump sum bid in words

LUMP SUM BID BREAKDOWN FOR INCREMENT 1:

	Item	Value in Dollars
Division 0	PROCUREMENT & CONTRACTING REQUIREMENTS	\$
	00 72 00 General Conditions	\$
Division 1	GENERAL REQUIREMENTS	\$
	01 50 00 – Temporary Facilities and Controls (Including Temp. Generators and Infrastructure for Shutdowns)	\$
	01 73 00 – Execution (Related to Unforeseen Conditions)	\$
Division 2	EXISTING CONDITIONS	\$
	02 41 00 – Demolition and Deconstruction	\$
	02 82 00 – Hazardous Material Abatement	\$
Division 3	CONCRETE	\$
Division 4	MASONRY	\$
Division 5	METALS	\$
Division 6	Wood and Plastic Products	\$
Division 7	THERMAL AND MOISTURE PROTECTION	\$
Division 8	OPENINGS	\$
Division 9	FINISHES	\$
Division 10	SPECIALTIES	\$
Division 22	PLUMBING	\$
Division 23	HEATING, VENTILATING & AIR CONDITIONING (HVAC)	\$
Division 26	ELECTRICAL	\$
Division 27	COMMUNICATIONS	\$
Division 28	ELECTRONIC SAFETY AND SECURITY	\$
Division 31	EARTHWORK	\$
Division 32	EXTERIOR IMPROVEMENTS	\$
Division 33	UTILITIES	\$
Any Other Divisions	Other Division Not Included in the Above	\$

LUMP SUM BID BREAKDOWN TOTAL: \$ _____

LUMP SUM BID BREAKDOWN IN WORDS: \$ _____

2. INCREMENT 2 LUMP SUM BID:

The lump sum bid for the work, including Best Management Practices (BMP) and Construction and Demolition Debris Recycling, and Mandatory Jobs Coordinator requirements complete according to the Drawings and Specifications **for Increment 2**, will be:

(\$ _____) (_____)
Lump sum bid in figures Lump sum bid in words

LUMP SUM BID BREAKDOWN FOR INCREMENT 2:

	Item	Value in Dollars
Division 0	PROCUREMENT & CONTRACTING REQUIREMENTS	\$
	00 72 00 General Conditions	\$
Division 1	GENERAL REQUIREMENTS	\$
	01 50 00 – Temporary Facilities and Controls (Including Temp. Generators and Infrastructure for Shutdowns)	\$
	01 73 00 – Execution (Related to Unforeseen Conditions)	\$
Division 2	EXISTING CONDITIONS	\$
	02 41 00 – Demolition and Deconstruction	\$
	02 82 00 – Hazardous Material Abatement	\$
Division 3	CONCRETE	\$
Division 4	MASONRY	\$
Division 5	METALS	\$
Division 6	Wood and Plastic Products	\$
Division 7	THERMAL AND MOISTURE PROTECTION	\$
Division 8	OPENINGS	\$
Division 9	FINISHES	\$
Division 10	SPECIALTIES	\$
Division 22	PLUMBING	\$
Division 23	HEATING, VENTILATING & AIR CONDITIONING (HVAC)	\$
Division 26	ELECTRICAL	\$
Division 27	COMMUNICATIONS	\$
Division 28	ELECTRONIC SAFETY AND SECURITY	\$
Division 31	EARTHWORK	\$
Division 32	EXTERIOR IMPROVEMENTS	\$
Division 33	UTILITIES	\$
Any Other Divisions	Other Division Not Included in the Above Divisions	\$

LUMP SUM BID BREAKDOWN TOTAL: \$ _____

LUMP SUM BID BREAKDOWN IN WORDS: \$ _____

3. EXTENDED OVERHEAD DAILY RATE:

The daily rate for the sum of the Contractor's field office and home office overhead applicable to this project, for each day of compensable delay will be:

(\$ _____) (_____)
Daily rate in figures Daily rate in words

Extended Overhead Daily Rate X 30 days: \$ _____

4. TOTAL LUMP SUM BID PRICE

The lowest bid price shall be determined by adding the following items: Increment 1 Lump Sum Bid in Words + Increment 2 Lump Sum Bid in Words + Extended Overhead Daily Rate x 30 days + Additive Alternate in Words = Total Lump Sum Bid. The lowest Total Lump Sum Bid Price will be used to determine award.

(\$ _____) (\$ _____)
Total Lump Sum Bid Price in figures Total Lump Sum Bid Price in words

Preference as stated in Section 00 01 00, 1.30, will be applied to the Total Lump Sum Bid, if applicable, to determine the final total bid amount.

5. ADDITIVE ALTERNATE :

ADDITIVE ALTERNATE NO. 1: Extend the standard one (1) year warranty Period, as noted in General Conditions Section 00 07 00-38, to three (3) years from the date of Substantial Completion of the project.

The amount to be added to the Lump Sum Proposal for inclusion of Alternate 1, Three (3) Year Warranty, will be as follows:

(\$ _____) (_____)
In Figures In Words

6. The General Contractor shall provide a comprehensive list of all exclusions as part of their bid submission. Any scope, material, or service not explicitly listed as an exclusion shall be deemed included in the Contractor's bid and fully accounted for in the contract price. Failure to identify exclusions shall not be grounds for change orders or additional compensation. The County reserves the right to review, clarify, and reject any exclusions that are deemed unreasonable or inconsistent with the project requirements.

7. COUNTY PROGRAM PREFERENCE:

The Local Small Business Enterprise Program Preference is provided by the County for purposes of bid evaluation only, as specified in Article 1.30 of Section 00 01 00. If Bidder is a qualifying Local Small Business Enterprise, check "yes" in the box below. Section 00 04 38 Request for County Program Preference Consideration must be submitted at the time of bid with a copy of the certification letter issued by the County of Los Angeles Department of Consumer and Business Affairs. If non-qualifying, check "no" in the appropriate box.

LSBE Yes ☐ No ☐

8. RECEIPT OF NOTICE TO BIDDERS:

The Bidder hereby certifies and declares that it has received, reviewed, and incorporated the following Notices to Bidders into its Bid:

1. Notice to Bidders A, dated March 24, 2025
2. Notice to Bidders B, dated March 25, 2025
3. Notice to Bidders C, dated April 3, 2025.
4. Notice to Bidders D, dated April 16, 2025.

NOTE: Any alteration or addition to the Form of Bid may invalidate same. All blank spaces shall be filled out completely. Line out nonapplicable blanks. An incomplete form may invalidate bid. The County reserves the right to waive any informalities or to reject any or all bids or to accept any alternatives when called for.

I (We) certify that on _____, 20____, License No. _____, license classification(s) _____, was issued to me (us), in the name of _____, by the Contractors' State License Board, pursuant to California Statutes of 1929, as amended, and that said license has not been revoked.

Firm Ownership Information

Check where applicable:

1. ☐ Minority-Owned
 ☐ Woman-Owned
 ☐ Disadvantaged-Owned
 ☐ Disabled Veteran-Owned
 ☐ LGBTQQ-Owned

2. ☐ An individual
 ☐ A corporation. Name
 state or territory of
 Incorporation

☐ A copartnership

☐ A joint venture

Race/Ethnic Composition

For statistical purposes only.

- ☐ Black/African American
☐ Hispanic/Latino
☐ Asian or Pacific Islander
☐ Native Americans
☐ Subcontinent Asian
☐ White

If a copartnership or joint venture, list names of individuals comprising same below

Date signed _____, 20____

Respectfully submitted,

Place _____

City and State

Firm Name (if applicable)

Bidder's address, E-mail address, and telephone:

Number and Street

Signature and Print Name

City and State

Zip Code

Title and E-mail Address

Telephone

Signature and Print Name

Fax

Title and E-mail Address