


Attachment E

**As-Built Drainage and Grading Limits,
Revision No. 1**

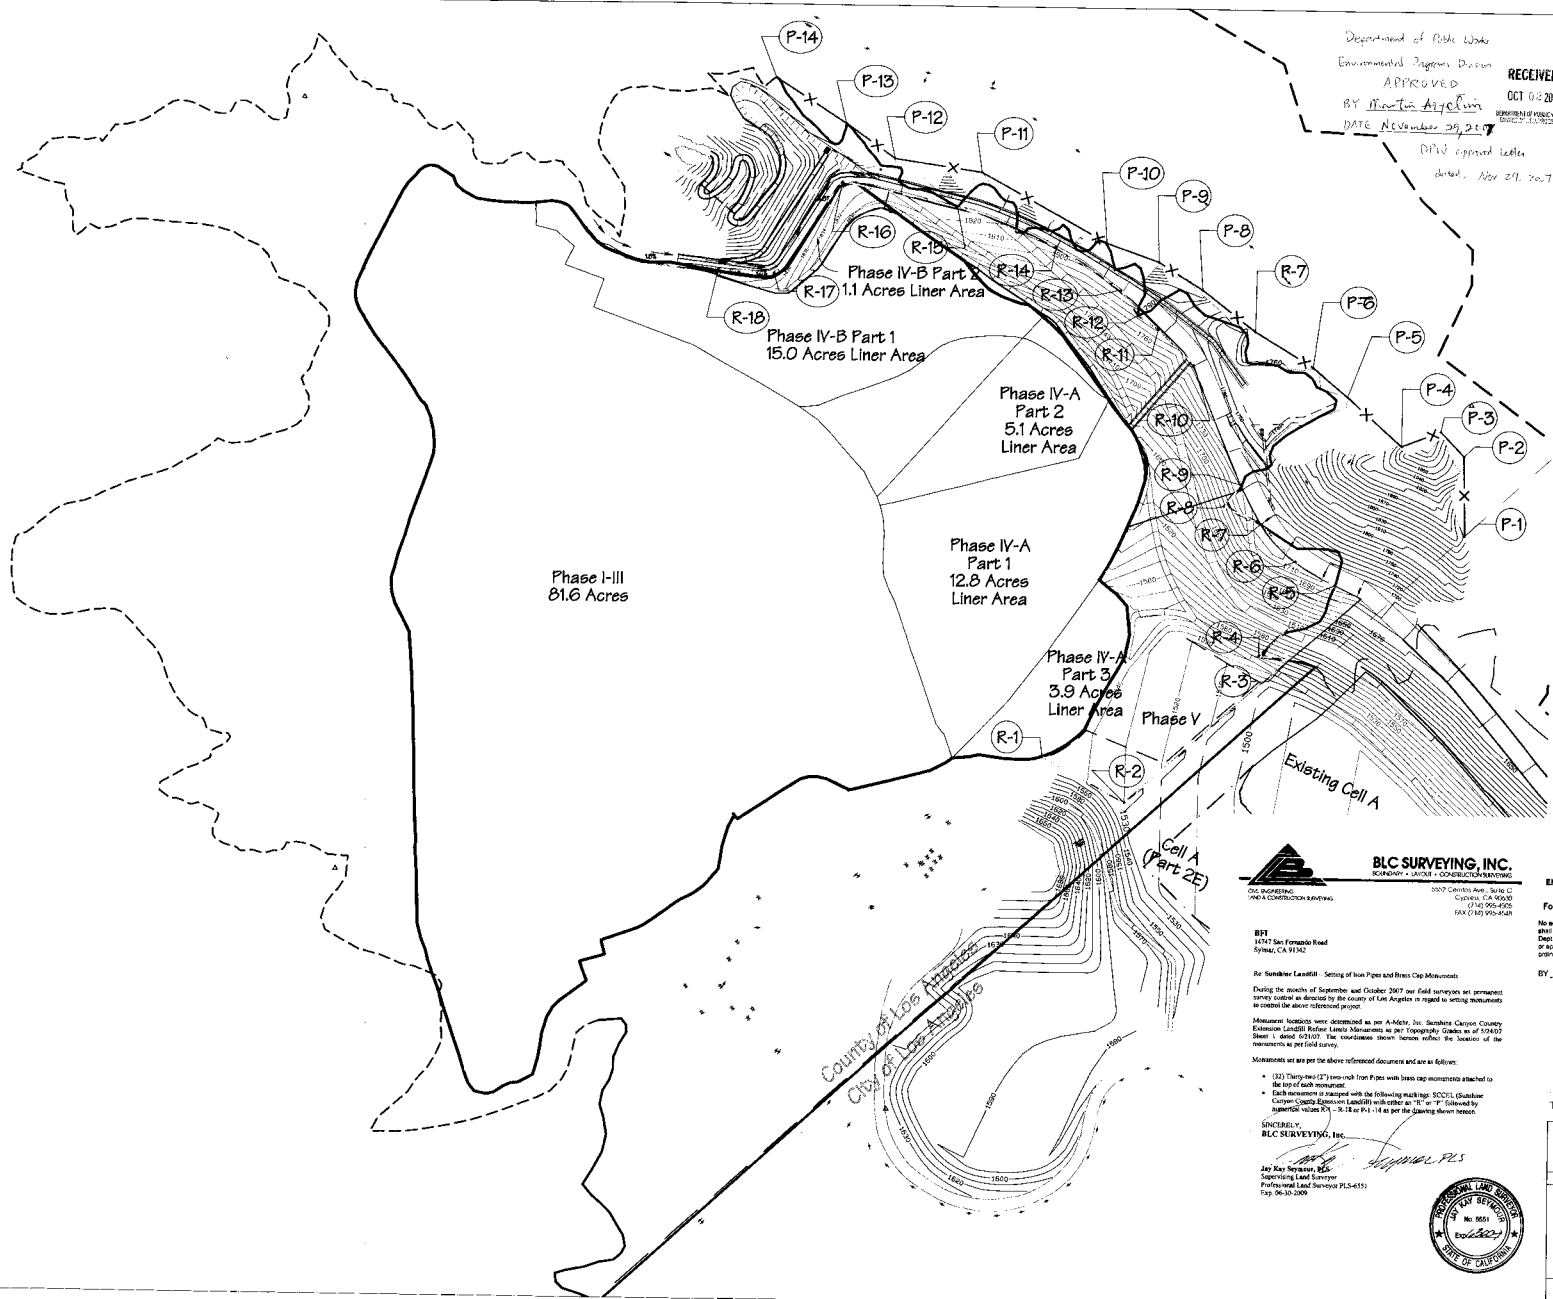

Department of Public Works
Environmental Programs Division
APPROVED
BY *Mark Aigelinger*
DATE November 29, 2007
DPIJ approved letter
dated, Nov 29, 2007

Refuse Limits Surveying Monument
As-Built Information

Name	Northing	Easting
R-1	4232379.910400	4131810.472530
R-2	4232227.344120	4132094.577700
R-3	4232717.914990	4132650.770300
R-4	4232732.244870	4132546.262220
R-5	4232975.516580	4132804.633050
R-6	4233054.638150	4132668.478470
R-7	4233180.078000	4132549.405530
R-8	4233237.326790	4132419.727070
R-9	4233309.556950	4132481.982030
R-10	4233714.904110	4132312.003610
R-11	4233834.751770	4132198.926550
R-12	4233882.203470	4132119.160550
R-13	4233968.303760	4132059.721250
R-14	4234112.077400	4131837.139310
R-15	4234247.709430	4131496.210280
R-16	4234324.942880	4131103.201510
R-17	4234011.123720	4130873.774070
R-18	4234051.527650	4130682.851020

Grading Limits Surveying Monument
As-Built Information

Name	Northing	Easting
P-1	4233147.079870	4133244.432300
P-2	4233417.573650	4133239.262730
P-3	4233500.413170	4133158.755300
P-4	4233448.775940	4133025.593300
P-5	4233611.954070	4133136.642870
P-6	4233711.090200	4132719.658660
P-7	4233830.467110	4132520.363970
P-8	4233971.677930	4132338.850960
P-9	4234065.712670	4132187.647680
P-10	4234127.327160	4132009.279260
P-11	4234361.737120	4131580.544230
P-12	4234404.931670	4131282.315370
P-13	4234522.005130	4131114.056150
P-14	4234674.975690	4130873.534980

- Legend:
- Property Boundary
 - Existing Topography
 - Existing Limits
 - Proposed Limits of Grading
 - Proposed Refuse Limits
 - Old permitted Limits of Grading
 - Old permitted Limits of Refuse Limits

BLC SURVEYING, INC.
BOLTON • LAYTON • CONSTRUCTION SERVICES
3007 Centeno Ave., Suite C
Covina, CA 91703
(714) 900-4925
FAX (714) 900-4928

COUNTY OF LOS ANGELES
DEPT. OF PUBLIC WORKS
ENVIRONMENTAL PROGRAMS DIVISION
APPROVED
FOR *Phase V, Section 10/20/07*
No additions or alterations of the subject facts shall be made without the written permission of the Dept. of Public Works. This document does not constitute or approve the construction of any improvement or other.
BY *Mark Aigelinger* DATE *11-29-2007*



Notes:
The Area between existing liners and proposed refuse limits is 19.5 Acres.

A-MEHR, INC.		FILENAME
22026-APP-Cover-Draw-Layout-Hills-California-050513-0403-2006-1007		JTD Figures
Gunnite Canyon County Extension Landfill		DRAWN
As-Built		RM
Drainage and Grading Limits		CHECKED
Revision Number 1		AM
Topography Grades as of 1/24/07		DATE
		10/2/07
		FIGURE
		1

