COUNTY OF LOS ANGELES
DEPARTMENT OF PUBLIC WORKS
BUILDING AND SAFETY / LAND DEVELOPMENT

EAST LA
4801 3RD ST
LOS ANGELES CA 90022
PHONE: (323) 881-7030 EXT:

0600

BUILDING PERMIT
RESIDENTIAL ADD
BL 0600 1101270009

LEGAL ID:
TR: 6213 LT: 352 BL: .001

ASSESSOR INFORMATION NUMBER:
5226-030-027

TENANT:

OWNER: TEL. NO:
STILLWATER PROPERTY GROUP LLC (323) 212-4343-
1164 MILLER AVE
LOS ANGELES, CA

APPLICANT: TEL. NO:
SAME AS OWNER -

CONTRACTOR: TEL. NO:
SAME AS OWNER -
LIC. NO

ARCHITECT OR ENGINEER: TEL. NO:
-
LIC. NO:

MAP NO: SEWER MAP BOOK: PAGE: FIRE ZONE: CMP:
0 3 00

NO. OF FAMILIES: DWELLING UNITS: APT/COND: STAT CLASS:
NO 21

AIR QUALITY:	SCHOOL WITHIN 1000 FEET	HAZARDOUS MATERIALS
NO	NO	NO

	SQ. FT	NO. OF STORIES	CONST TYPE	NEW OCCUP GROUP
STRUCTURE:	135	1	VN	R-1
GARAGE:				
OTHER:				

EXIST BLDG USE: USE ZONE: R-2
EXIST OCC GRP:

BLDGS. NOW ON LOT: VALUATION:
8,000

FEES PAID

FEE DESCRIPTION:	QUANTITY:	UOM:	AMOUNT:
AA BLDG PERMIT ISSUANCE			26.60
AB STATE GREEN BLDG FEE	8000.00	VAL	1.00
AC STRONG MOTION RESID	8000.00	VAL	0.80
B1 PLANCHECK W/ENERGY	8000.00	VAL	164.60
B2 PERMIT W/ENERGY	8000.00	VAL	193.70
	TOTAL FEES		386.70

REPORT ID: DPR261 ROUTE TO: BS0600

BUILDING ADDRESS:
1164 MILLER AV
LOSA CA 900631212
NEAREST CROSS STREET:
THOMAS PAGE: 635 GRID: E4 LOCALITY: LOS ANGELES

ISSUED ON: PROCESSED BY:
01/27/11 LC

FINAL DATE FINAL BY: CODE:
8-17-11 R. Medina

DESCRIPTION OF WORK
ENCLOSE COVERED PATIO TO MAKE DINING ROOM ADDITION. REPLACE FOUNDATION AND SLAB AT ADDITION. ADD POWDER ROOM.

SPECIAL CONDITIONS:

APPROVALS	DATE	INSPECTOR SIGNATURE
LOCATION AND SETBACKS		
SOILS ENGINEER APPROVAL		
FOUNDATION/TRENCH FORMS	3-3-11	R Mo
SLAB/UNDER FLOOR		
RAISED FLOOR FRAMING		
UNDERFLOOR INSULATION		
1ST LEVEL FLOOR SHEATH		
2ND LEVEL FLOOR SHEATH		
ROOF SHEATHING		
FIRE DEPT. FRAME INSPECT		
BLDG DEPT. FRAME INSPECT		
SHEAR PANELS		
INSULATION/~~WEATHER STRIP~~	5-5-11	RM
INTERIOR ~~LATH~~/DRYWALL	5-17-11	RM
EXTERIOR LATH	5-17-11	RM
LOT DRAINAGE		
SMOKE DETECTION DEVICES		
FIRE DEPARTMENT APPROVAL		

OWNER-BUILDER DECLARATION

I hereby affirm under penalty of perjury that I am exempt from the Contractors' State License Law for the reason(s) indicated below by the checkmark(s) I have placed next to the applicable item(s) (Section 7031.5, Business and Professions Code): Any city or county that requires a permit to construct, alter, improve, demolish, or repair any structure, prior to its issuance, also requires the applicant for the permit to file a signed statement that he or she is licensed pursuant to the provisions of the Contractors' State License Law (Chapter 9 (commencing with Section 7000) of Division 3 of the Business and Professions Code) or that he or she is exempt from licensure and the basis for the alleged exemption. Any violation of Section 7031.5 by any applicant for a permit subjects the applicant to a civil penalty of not more than five hundred dollars ($500).):

(_) I, as owner of the property, or my employees with wages as their sole compensation, will do (✓) all of or (_) portions of the work, and the structure is not intended or offered for sale (Section 7044, Business and Professions Code: The Contractors' State License Law does not apply to an owner of property who, through employees' or personal effort, builds or improves the property, provided that the improvements are not intended or offered for sale. If, however, the building or improvement is sold within one year of completion, the Owner-Builder will have the burden of proving that it was not built or improved for the purpose of sale.).

(_) I, as owner of the property, am exclusively contracting with licensed Contractors to construct the project (Section 7044, Business and Professions Code: The Contractors' State License Law does not apply to an owner of property who builds or improves thereon, and who contracts for the projects with a licensed Contractor pursuant to the Contractors' State License Law).

(_) I am exempt from licensure under the Contractors' State License Law for the following reason:

_____

By my signature below I acknowledge that, except for my personal residence in which I must have resided for at least one year prior to completion of the improvements covered by this permit, I cannot legally sell a structure that I have built as an owner-builder if it has not been constructed in its entirety by licensed contractors. I understand that a copy of the applicable law, Section 7044 of the Business and Professions Code, is available upon request when this application is submitted or at the following Web site: http://www.leginfo.ca.gov/calaw.html.

Date: _____

Signature of Property Owner or Authorized Agent

_____

LICENSED CONTRACTOR'S DECLARATION

I hereby affirm under penalty of perjury that I am licensed under provisions of Chapter 9 (commencing with Section 7000) of Division 3 of the Business and Professions Code, and my license is in full force and effect.

License Class _____ License No._____

Date _____ Contractor Signature_____

WORKERS' COMPENSATION DECLARATION

WARNING: FAILURE TO SECURE WORKERS' COMPENSATION COVERAGE IS UNLAWFUL, AND SHALL SUBJECT AN EMPLOYER TO CRIMINAL PENALTIES AND CIVIL FINES UP TO ONE HUNDRED THOUSAND DOLLARS ($100,000), IN ADDITION TO THE COST OF COMPENSATION, DAMAGES AS PROVIDED FOR IN SECTION 3706 OF THE LABOR CODE, INTEREST, AND ATTORNEY'S FEES.

I hereby affirm under penalty of perjury one of the following declarations:

____I have and will maintain a certificate of consent to self-insure for workers' compensation, issued by the Director of Industrial Relations as provided for by Section 3700 of the Labor Code, for the performance of the work for which this permit is issued.

Policy No. _____

____ I have and will maintain workers' compensation insurance, as required by Section 3700 of the Labor Code, for the performance of the work for which this permit is issued. My workers' compensation insurance carrier and policy number are:

_____ _____ _____

Carrier Policy Number Expiration Date

_____ _____

Name of Agent Phone Number

___ I certify that, in the performance of the work for which this permit is issued, I shall not employ any person in any manner so as to become subject to the workers' compensation laws of California, and agree that, if I should become subject to the workers' compensation provisions of Section 3700 of the Labor Code, I shall forthwith comply with those provisions

_____ _____

Signature of Applicant Date

LOBBYIST ORDINANCE CERTIFICATION
Complete this section for permits in Unincorporated Los Angeles County only

This is to certify that I, as permit applicant, am familiar with the requirements of Los Angeles County Code Chapter 2.160 et seq., (relating to the Los Angeles County Lobbyist Ordinance) and that all persons acting on behalf of myself complied and will continue to comply therewith through the application process.

_____ _____

Applicant (Print Name) Applicant Signature

_____ _____

Company Name Date

JOB ADDRESS
LOCALITY

HAZARDOUS MATERIAL DECLARATION

Will the applicant or future building occupant handle a hazardous material or a mixture containing a hazardous material equal to or greater than the amount specified on the hazardous materials information guide?

Yes ☐ No ☐

Will the intended use of the building by the applicant or future building occupant require a permit for construction or modification from the South Coast Air Quality Management District (SCAQMD)? See permitting checklist for guidelines.

Yes ☐ No ☐

I have read the hazardous materials information guide and the SCAQMD permitting checklist, I understand my requirements under the Los Angeles County Code Title 2, Chapter 220 Sections 220.100 through 220.140 concerning hazardous material reporting and for obtaining a permit from the SCAQMD.

ASBESTOS NOTIFICATION

☐ Notification letter sent to AQMD and/or EPA

☐ I declare that notification of asbestos removal is not applicable to addressed project.

DECLARATION REGARDING CONSTRUCTION LENDING AGENCY

I hereby affirm under penalty of perjury that there is a Construction lending agency for the performance of the work for which this permit is issued (Section 3097, Civil Code).

Lender's Name

_____

Lender's Address

_____

By my signature below, I certify to each of the following:
I am the property owner or authorized to act on the property owner's behalf.
I have read this application and the information I have provided is correct.
I agree to comply with all applicable city and county ordinances and state laws relating to building construction.
I authorize representatives of this county to enter the above-identified property for inspection purposes.

Signature of Property Owner or Authorized Agent

_____

Date _____

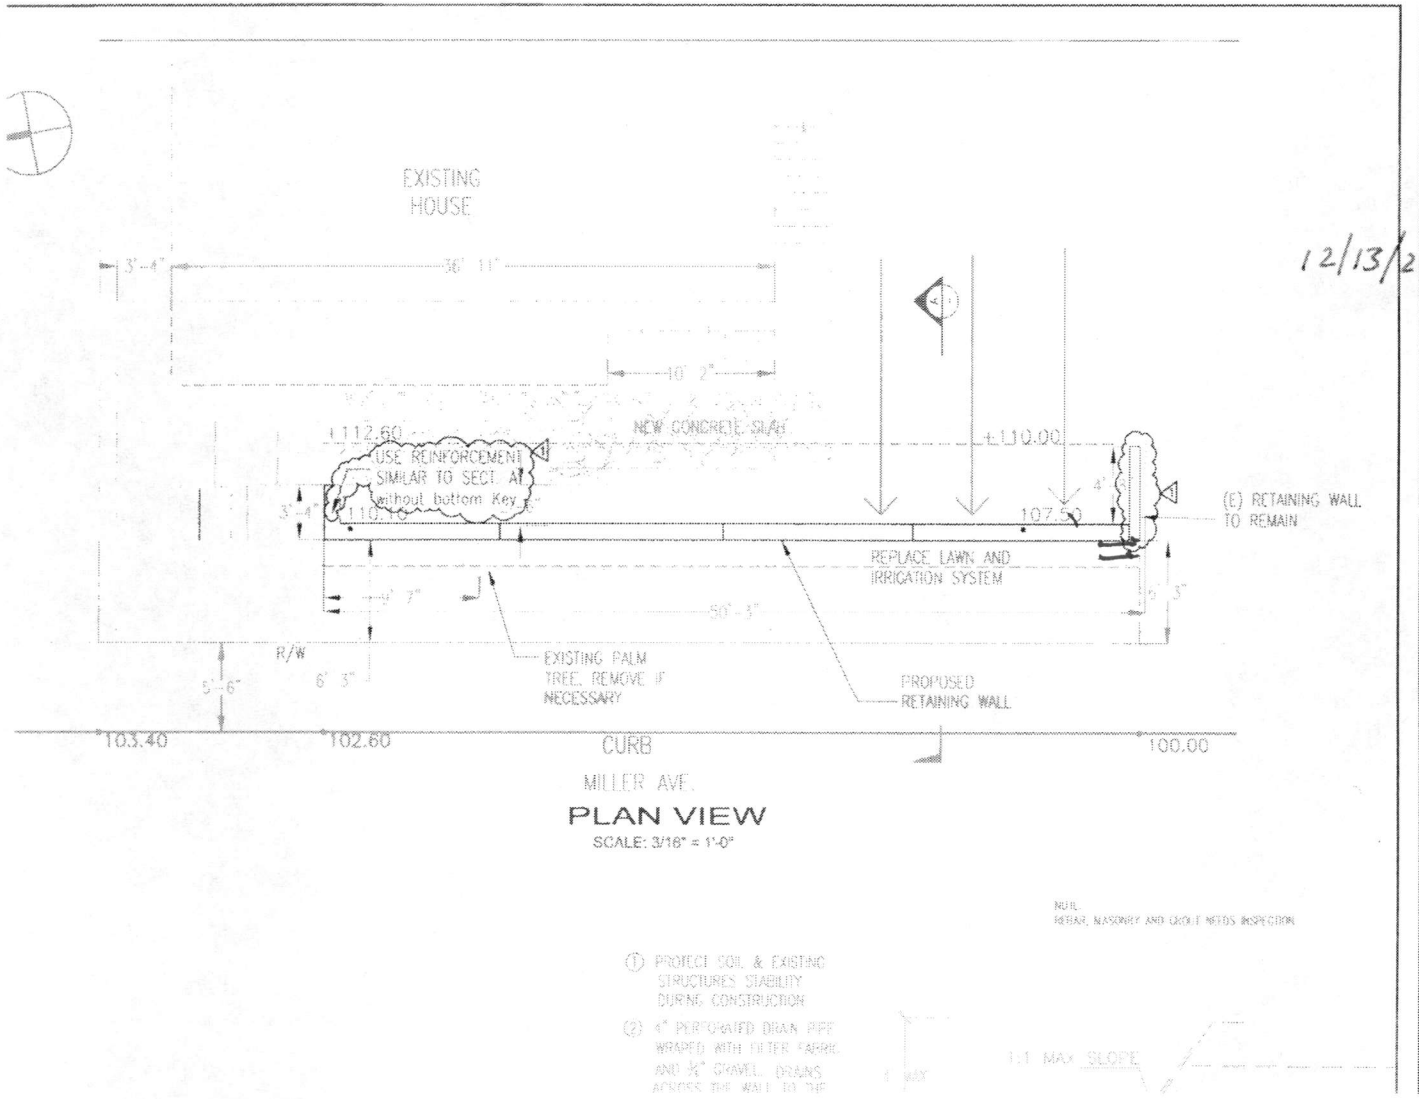

PLAN VIEW

SCALE: 3/16" = 1'-0"

NOTE
REBAR, MASONRY AND GROUT NEEDS INSPECTION

① PROTECT SOIL & EXISTING STRUCTURES STABILITY DURING CONSTRUCTION

② 4" PERFORATED DRAIN PIPE WRAPED WITH FILTER FABRIC AND ¾" GRAVEL. DRAINS ACROSS THE WALL TO THE

1 WAY

1:1 MAX SLOPE

12/13/2010

REGISTERED PROFESSIONAL ENGINEER
WILLIAM A. AGUIRRE
C 65478
EXP. 9-30-11
CIVIL
STATE OF CALIFORNIA

William Arturo Aguirre P.E.
Civil Engineer
BUILDING & CITY
ARCHITECTURE AND ENGINEERING CONSULTANTS LLC
13139 Loire Valley Drive
Rancho Cucamonga, CA 91739
fax: (909) 899-0816
cell: (951) 204-1013
waguirre@arch-eng-consultants.com
www.arch-eng-consultants.com

RETAINING WALL
JAMES FIGUEROA RESIDENCE

1164 MILLER AVE.
LOS ANGELES, CA 90063
323 867 5313