DEPARTMENT OF COUNTY ENGINEER
DIVISION OF BUILDING AND SAFETY
COUNTY OF LOS ANGELES
WILLIAM J. FOX, COUNTY ENGINEER

SEWER—SEWAGE DISPOSAL PERMIT APPLICATION

1

FOR APPLICANT TO FILL IN

BUILDING ADDRESS 5215-17 E Beverly
LOCALITY E Los Angeles
NEAREST CROSS ST. Atlantic
OWNER Wilmore Coast Co.
MAIL ADDRESS 5215-17 E Beverly
CITY E L Angeles TEL.NO. An 11211
CONTRACTOR Mike Vuksich
ADDRESS 807 So Downey Rd
CITY Los Angeles TEL.NO. An 7604
REGISTRATION NO. 1 ☐ STATE ☑ COUNTY
LEGAL DESCRIPTION LOT NO. West 25' of 90
BLOCK – TRACT 10665
SIZE OF LOT 50 x 100' NO. OF BLDGS. NOW ON LOT 1
USE OF BUILDINGS Real Estate Office

NO.	DESCRIPTION OF WORK	FEE		
1	HOUSE SEWER CONNECTING TO PUBLIC SEWER	@ $ 3.50	3	50
	HOUSE SEWER CONNECTING TO PRIVATE DISPOSAL SYSTEM	1.00		
	CONNECT ADDITIONAL BLDG. OR WORK TO HOUSE SEWER	1.00		
	ALTER OR REPAIR EXISTING SEWER OR DISPOSAL SYSTEM	1.00		
	DISCONNECT AND ABANDON SEWER AND/OR DISPOSAL SYSTEM	1.00		
	SEPTIC TANK, SEEPAGE PIT OR PITS AND/OR DRAINFIELD	2.00		
	CESSPOOL—DRYWELL SPECIAL CONDITIONS ONLY	2.00		

OWNERS AUTHORIZATION			
	PERMIT $	1	00
	TOTAL FEE	4	50

I HAVE THIS DATE CONTRACTED WITH THE HEREIN NAMED CONTRACTOR TO CONNECT THE ABOVE DESCRIBED EXISTING DWELLING TO THE PUBLIC SEWER

SIGNED THIS ..... DAY OF Sept 21 1953

OWNER OR OWNERS AGENT Mike Vuksich

ADDRESS 807 S. Downey Rd

I HEREBY ACKNOWLEDGE THAT I HAVE READ THIS APPLICATION AND STATE THAT THE ABOVE IS CORRECT AND AGREE TO COMPLY WITH ALL COUNTY ORDINANCES AND STATE LAWS REGULATING PLUMBING AND SEWERS.

I HEREBY CERTIFY THAT I AM PROPERLY REGISTERED AND/OR LICENSED AS REQUIRED BY LOS ANGELES COUNTY AND STATE OF CALIFORNIA OR THAT I AM THE LEGAL OWNER OF THE ABOVE DESCRIBED RESIDENTIAL PROPERTY.

SIGNATURE OF PERMITTEE Mike Vuksich

BUILDING ADDRESS 5215-17 E Beverly
LOCALITY E.L.A.
NEAREST CROSS ST. Atlantic

DISTRICT NO.	SERIAL NO.	PERMIT NO.
6	A —	15980 S
RECEIVED BY	Ready for Inspection	DATE ISSUED
CARUSO	CALL	9-23-53

USE ZONE	OCCUPANCY	MAP BK	MAP PG
C-3	Real Estate Office	L	95

CO. IMP. NO. 1081 11-A
JOB NO. —
TRUNK PERMIT NO. —
ROAD PERMIT NO.
STATE ENCROACHMENT PERMIT NO.
INDUSTRIAL WASTE APPROVAL

CHARGES
CONNECTION CHARGE FEE
REIMBURSEMENT FEE

RECEIPT NO.	DATE	BY

EXCEPTION RECORDED

NO.	DATE	BY

CONNECTION DATA

STATION 8+31.0 DEPTH 6'
MANHOLE REFERENCE 53.00' S of UPPER ~~LOWER~~
TYPE OF CONNECTION ~~Y.~~ ~~CURB~~ P.L. LENGTH FROM M.L. TO P.L. 10'

APPROVALS	INSPECTOR'S SIGNATURE	DATE
NEW HOUSE SEWER	Earhart	9-24-53
CONNECT ADDITIONAL BUILDING OR WORK		
SEPTIC TANK, SEEP. PIT(S) AND/OR DRAINFIELD		
CESSPOOL ☐ DRYWELL ☐		
ALTER, REPAIR, SEWER OR SEWAGE DISPOSAL SYSTEM		
DISCONNECT PLUG AND ABANDON HOUSE SEWER		
BACKFILL SEPTIC TANKS ☐ SEEP.PIT(S) ☐ CESSPOOLS ☐		

76A642D 663 1/53

FOR DEPARTMENT USE

REQUIRED INFORMATION

1. INDICATE ALL BUILDINGS ON PROPERTY.
2. INDICATE AND DIMENSION SEWAGE DISPOSAL SYSTEM WITH TIE DISTANCES TO BUILDINGS AND PROPERTY LINES.
3. INDICATE SIZE OF SEPTIC TANK—DEPTH OF SEEPAGE PIT(S)—SIZE OF CESSPOOL(S)
4. INDICATE NORTH DIRECTION ON PLOT.
5. INDICATE BOTH STREETS IF CORNER.

PL — PL

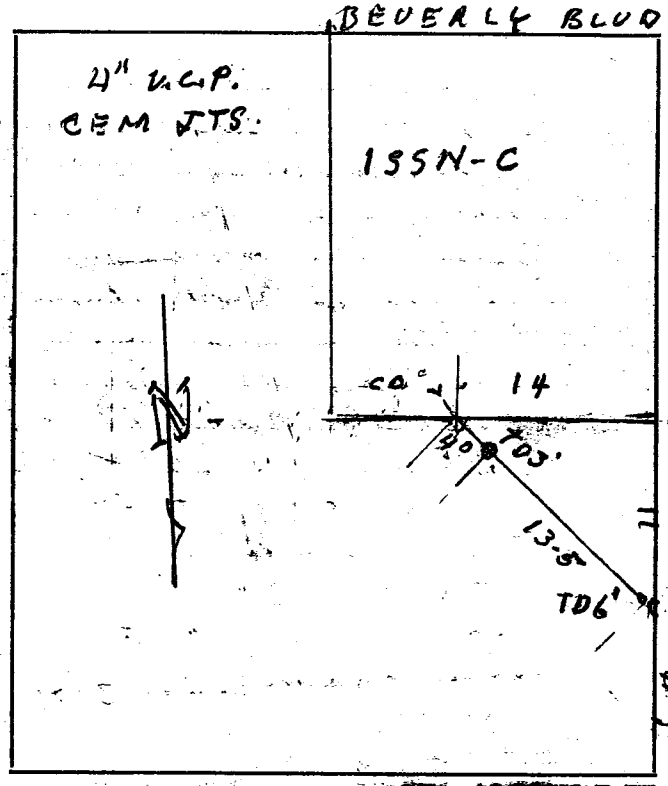

LEGAL DESCRIPTION

FIELD NOTES