1215 GARFIELD

COUNTY OF LOS ANGELES
DEPARTMENT OF PUBLIC WORKS
BUILDING AND SAFETY / LAND DEVELOPMENT

EAST LA
4801 3RD ST
LOS ANGELES CA 90022
PHONE: (323) 881-7030 EXT:

0600

BUILDING PERMIT
ALTERATION/REPAIR
BL 0600 1201310037

LEGAL ID:
TR: 8649 LT: 428 BL: .001

ASSESSOR INFORMATION NUMBER:
6351-017-041

TENANT:

OWNER: TEL. NO:
MATOSIAN SAMSON (310) 693-6174-
8224 CALIFORNIA AV
WHIT 906022823

APPLICANT: TEL. NO:
HERNANDEZ, EFREN (626) 401-3345-
254 STANTON ST
PASADENA CA 91103

CONTRACTOR: TEL. NO:
VALLEY GREEN CONSTRUCTION (626) 797-4325-
254 STANTON STREET LIC. NO
PASADENA, CA 91103 844306 A B *

ARCHITECT OR ENGINEER: TEL. NO:
LIC. NO:

MAP NO: SEWER MAP BOOK: PAGE: FIRE ZONE: CMP:
XX 3 00

NO. OF FAMILIES: DWELLING UNITS: APT/COND: STAT CLASS:
0 YES 21

AIR QUALITY: SCHOOL WITHIN 1000 FEET: HAZARDOUS MATERIALS:
NO NO NO

	SQ. FT	NO. OF STORIES	CONST TYPE
STRUCTURE:			V-B

EXIST BLDG USE: RESID USE ZONE: XX
EXIST OCC GRP:

BLDGS. NOW ON LOT: 2
VALUATION: 3,000

FEES PAID

FEE DESCRIPTION:	QUANTITY:	UOM:	AMOUNT:
AA BLDG PERMIT ISSUANCE			27.40
AB STATE GREEN BLDG FEE	3000.00	VAL	1.00
AC STRONG MOTION RESID	3000.00	VAL	0.50
D1 PLANCHECK W/O EN-HC	3000.00	VAL	83.30
D2 PERMIT W/O EN-HC	3000.00	VAL	98.00
	TOTAL FEES		210.20

* ADDITIONAL DATA ON FILE

REPORT ID: DPR261 ROUTE TO: BS0600

BUILDING ADDRESS:
1215 GARFIELD AV
LOSA CA 900225464
NEAREST CROSS STREET: OLYMPIC
THOMAS PAGE: 676 GRID: B2 LOCALITY: LOS ANGELES

ISSUED ON: 01/31/12 PROCESSED BY: SH

FINAL DATE: 2/8/12 FINAL BY: S. Gen CODE:

DESCRIPTION OF WORK
REPLACE DAMAGED POSTS IN GARAGE

SPECIAL CONDITIONS:

APPROVALS	DATE	INSPECTOR SIGNATURE
LOCATION AND SETBACKS		
SOILS ENGINEER APPROVAL		
FOUNDATION/TRENCH FORMS		
SLAB/UNDER FLOOR		
RAISED FLOOR FRAMING		
UNDERFLOOR INSULATION		
FLOOR SHEATHING		
ROOF SHEATHING		
SHEAR PANELS		
FRAME INSPECTION POST	2.3.2012	
FIRE SPRINKLER HANGERS		
INSULATION/WEATHER STRIP		
INTERIOR LATH/DRYWALL		
EXTERIOR LATH		
RATED FLOOR/CEIL ASSEM.		
RATED WALL ASSEMBLIES		
RATED SHAFTS/OPENINGS		
T-BAR CEILINGS		
LOT DRAINAGE		

L.A. Cadena

OWNER-BUILDER DECLARATION

I hereby affirm under penalty of perjury that I am exempt from the Contractors' State License Law for the reason(s) indicated below by the checkmark(s) I have placed next to the applicable item(s) (Section 7031.5, Business and Professions Code): Any city or county that requires a permit to construct, alter, improve, demolish, or repair any structure, prior to its issuance, also requires the applicant for the permit to file a signed statement that he or she is licensed pursuant to the provisions of the Contractors' State License Law (Chapter 9 (commencing with Section 7000) of Division 3 of the Business and Professions Code) or that he or she is exempt from licensure and the basis for the alleged exemption. Any violation of Section 7031.5 by any applicant for a permit subjects the applicant to a civil penalty of not more than five hundred dollars ($500).):

(_) I, as owner of the property, or my employees with wages as their sole compensation, will do (✓) all of or (_) portions of the work, and the structure is not intended or offered for sale (Section 7044, Business and Professions Code: The Contractors' State License Law does not apply to an owner of property who, through employees' or personal effort, builds or improves the property, provided that the improvements are not intended or offered for sale. If, however, the building or improvement is sold within one year of completion, the Owner-Builder will have the burden of proving that it was not built or improved for the purpose of sale.).

(_) I, as owner of the property, am exclusively contracting with licensed Contractors to construct the project (Section 7044, Business and Professions Code: The Contractors' State License Law does not apply to an owner of property who builds or improves thereon, and who contracts for the projects with a licensed Contractor pursuant to the Contractors' State License Law).

(_) I am exempt from licensure under the Contractors' State License Law for the following reason:

_____

By my signature below I acknowledge that, except for my personal residence in which I must have resided for at least one year prior to completion of the improvements covered by this permit, I cannot legally sell a structure that I have built as an owner-builder if it has not been constructed in its entirety by licensed contractors. I understand that a copy of the applicable law, Section 7044 of the Business and Professions Code, is available upon request when this application is submitted or at the following Web site: http://www.leginfo.ca.gov/calaw.html.

Date: _____

Signature of Property Owner or Authorized Agent

_____

LICENSED CONTRACTOR'S DECLARATION

I hereby affirm under penalty of perjury that I am licensed under provisions of Chapter 9 (commencing with Section 7000) of Division 3 of the Business and Professions Code, and my license is in full force and effect.

License Class A License No. 844306

Date 1/31/12 Contractor Signature _____

WORKERS' COMPENSATION DECLARATION

WARNING: FAILURE TO SECURE WORKERS' COMPENSATION COVERAGE IS UNLAWFUL, AND SHALL SUBJECT AN EMPLOYER TO CRIMINAL PENALTIES AND CIVIL FINES UP TO ONE HUNDRED THOUSAND DOLLARS ($100,000), IN ADDITION TO THE COST OF COMPENSATION, DAMAGES AS PROVIDED FOR IN SECTION 3706 OF THE LABOR CODE, INTEREST, AND ATTORNEY'S FEES.

I hereby affirm under penalty of perjury one of the following declarations:

✓ I have and will maintain a certificate of consent to self-insure for workers' compensation, issued by the Director of Industrial Relations as provided for by Section 3700 of the Labor Code, for the performance of the work for which this permit is issued.

Policy No. 1918219

✓ I have and will maintain workers' compensation insurance, as required by Section 3700 of the Labor Code, for the performance of the work for which this permit is issued. My workers' compensation insurance carrier and policy number are:

State Fund — Carrier; 1918219 — Policy Number; 02/03/12 — Expiration Date

Denies Kolyn — Name of Agent; _____ — Phone Number

___ I certify that, in the performance of the work for which this permit is issued, I shall not employ any person in any manner so as to become subject to the workers' compensation laws of California, and agree that, if I should become subject to the workers' compensation provisions of Section 3700 of the Labor Code, I shall forthwith comply with those provisions

_____ Signature of Applicant — 1/31/12 Date

LOBBYIST ORDINANCE CERTIFICATION

Complete this section for permits in Unincorporated Los Angeles County only

This is to certify that I, as permit applicant, am familiar with the requirements of Los Angeles County Code Chapter 2.160 et seq., (relating to the Los Angeles County Lobbyist Ordinance) and that all persons acting on behalf of myself complied and will continue to comply therewith through the application process.

Ernest Hende — Applicant (Print Name); _____ — Applicant Signature

Valley Green — Company Name; 1/31/12 — Date

JOB ADDRESS

LOCALITY

HAZARDOUS MATERIAL DECLARATION

Will the applicant or future building occupant handle a hazardous material or a mixture containing a hazardous material equal to or greater than the amount specified on the hazardous materials information guide?

Yes ☐ No ☒

Will the intended use of the building by the applicant or future building occupant require a permit for construction or modification from the South Coast Air Quality Management District (SCAQMD)? See permitting checklist for guidelines.

Yes ☐ No ☒

I have read the hazardous materials information guide and the SCAQMD permitting checklist, I understand my requirements under the Los Angeles County Code Title 2, Chapter 220 Sections 220.100 through 220.140 concerning hazardous material reporting and for obtaining a permit from the SCAQMD.

ASBESTOS NOTIFICATION

☐ Notification letter sent to AQMD and/or EPA

☒ I declare that notification of asbestos removal is not applicable to addressed project.

DECLARATION REGARDING CONSTRUCTION LENDING AGENCY

I hereby affirm under penalty of perjury that there is a Construction lending agency for the performance of the work for which this permit is issued (Section 3097, Civil Code).

Lender's Name

_____

Lender's Address

_____

By my signature below, I certify to each of the following:

I am the property owner or authorized to act on the property owner's behalf.

I have read this application and the information I have provided is correct.

I agree to comply with all applicable city and county ordinances and state laws relating to building construction.

I authorize representatives of this county to enter the above-identified property for inspection purposes.

Signature of Property Owner or Authorized Agent

_____

Date 1/31/12

REVISION OF NORTH BUILDING 1ST LEVEL PLAN

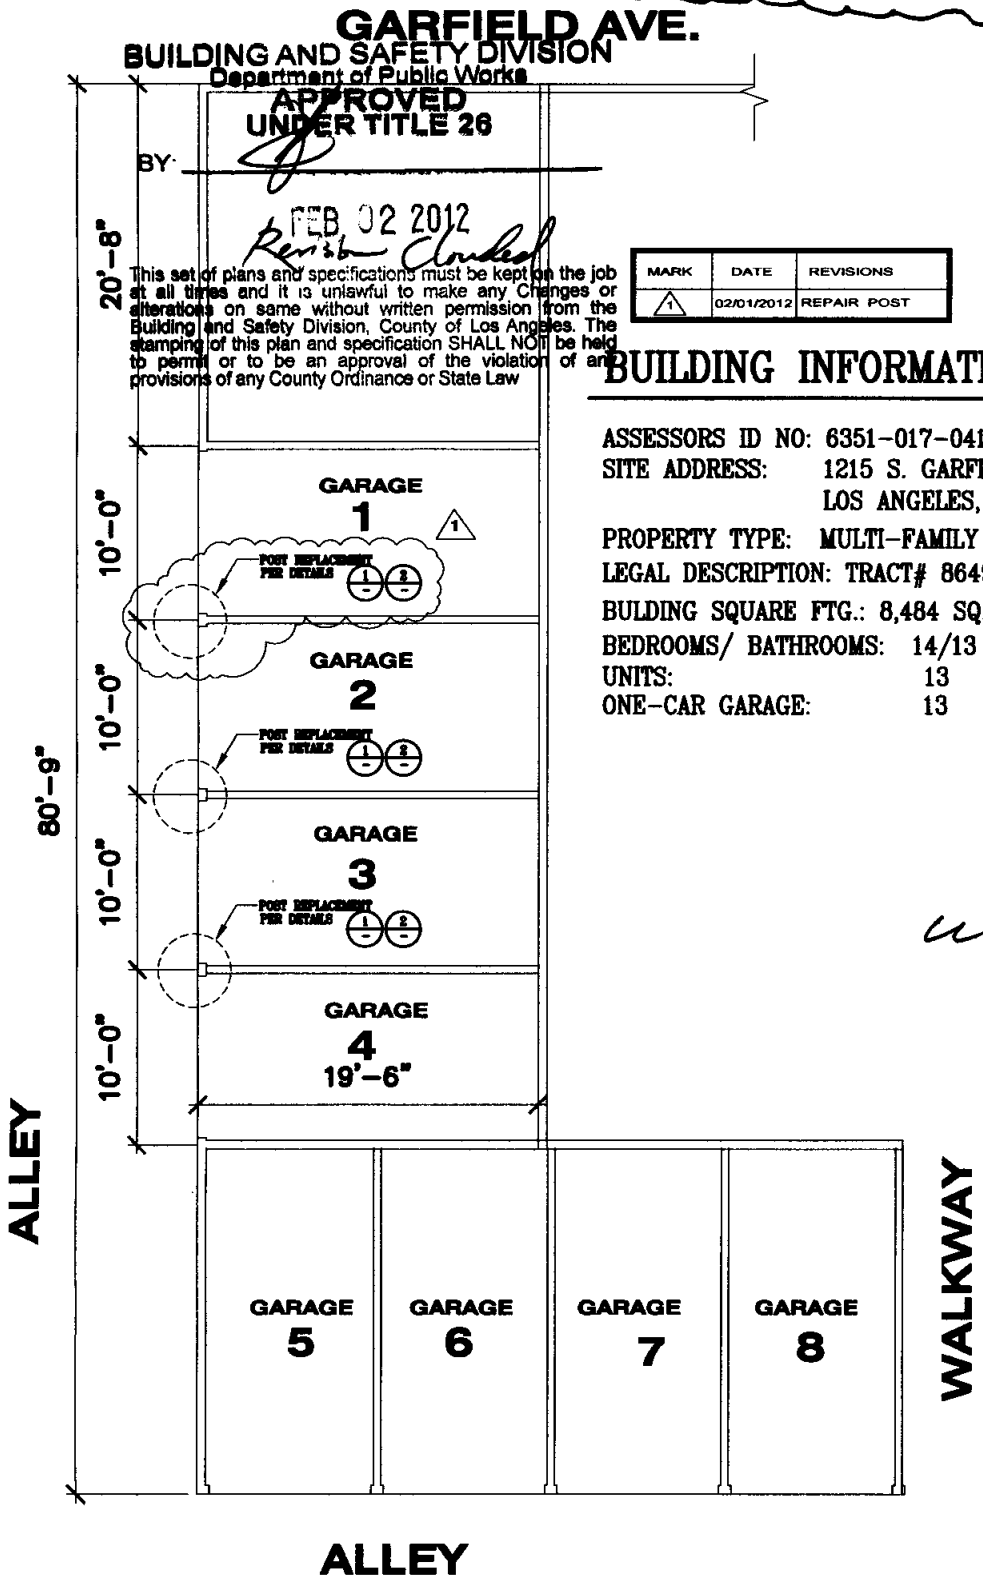

BUILDING AND SAFETY DIVISION
Department of Public Works
APPROVED UNDER TITLE 26
BY:
FEB 02 2012

This set of plans and specifications must be kept on the job at all times and it is unlawful to make any changes or alterations on same without written permission from the Building and Safety Division, County of Los Angeles. The stamping of this plan and specification SHALL NOT be held to permit or to be an approval of the violation of any provisions of any County Ordinance or State Law

MARK	DATE	REVISIONS
1	02/01/2012	REPAIR POST

BUILDING INFORMATION:

ASSESSORS ID NO: 6351-017-041
SITE ADDRESS: 1215 S. GARFIELD AVE.
LOS ANGELES, CA 90022
PROPERTY TYPE: MULTI-FAMILY RESIDENTIAL
LEGAL DESCRIPTION: TRACT# 8649 LOTS 428,429 AND LOT 430
BULDING SQUARE FTG.: 8,484 SQ. FT.
BEDROOMS/ BATHROOMS: 14/13
UNITS: 13
ONE-CAR GARAGE: 13

REGISTERED PROFESSIONAL ENGINEER
MANUEL A. ESPINO
No. C055528
EXP. 12/31/12
CIVIL
STATE OF CALIFORNIA

(N) 1 NORTH BUILDING 1ST LEVEL PLAN

SCALE: 3/32" = 1'-0"

1215 S. GARFIELD