CE808 12-68
76A 642D

APPLICATION FOR PERMIT

COUNTY OF LOS ANGELES
DEPARTMENT OF COUNTY ENGINEER
BUILDING AND SAFETY DIVISION
JOHN A. LAMBIE, COUNTY ENGINEER
COLEMAN W. JENKINS, SUP'T. OF BUILDING

SEWER–SEWAGE DISPOSAL

8 1

BUILDING ADDRESS 22913 Alexandria Torrance
LOCALITY County – CARSON
NEAREST CROSS ST. Normandie & Vermont
OWNER Mr. Mrs. Alfred Perez
MAIL ADDRESS 22913 Alexandria
CITY Torrance TEL. NO. None

DISTRICT NO.	GROUP	MAP BK	MAP PG	PROCESSED BY
12	I	W	12	Ervin L

FOR APPLICANT TO FILL IN

LEGAL DESCRIPTION LOT NO. LEGAL ATTACHED
BLOCK TRACT
SIZE OF LOT NO. OF BLDGS. NOW ON LOT
USE OF BUILDINGS
CONTRACTOR Owner
ADDRESS
CITY TEL. NO.
STATE LICENSE NO. LIC CLASS

NO.	DESCRIPTION OF WORK	FEE		
1	HOUSE SEWER CONNECTING TO PUBLIC SEWER	@ $5.00	7	00
	SEPTIC TANK, SEEPAGE PIT OR PITS AND/OR DRAINFIELD	@ $10.00		
	HOUSE SEWER CONNECTING TO PRIVATE DISPOSAL SYSTEM	@ $3.00		
	CONNECT ADDITIONAL BLDG. OR WORK TO HOUSE SEWER	@ $3.00		
	OVERFLOW SEEPAGE PIT, DRAINFIELD EXTN., CESSPOOL, DRYWELL, MANHOLE	@ $5.00		
	ALTER, REPAIR OR ABANDON HOUSE SEWER OR DISPOSAL SYSTEM	@ $3.00	3	00
		PERMIT $	3	00
		TOTAL FEE	13	00

OWNER'S AUTHORIZATION

I HAVE AT THIS DATE A CONTRACT WITH THE HEREIN NAMED CONTRACTOR TO CONNECT THE ABOVE DESCRIBED EXISTING DWELLING TO THE PUBLIC SEWER.

SIGNED THIS _____ DAY OF _____ 19___

OWNER OR OWNERS AGENT _____

ADDRESS _____

I HEREBY ACKNOWLEDGE THAT I HAVE READ THIS APPLICATION AND STATE THAT THE ABOVE IS CORRECT AND AGREE TO COMPLY WITH ALL COUNTY ORDINANCES AND STATE LAWS REGULATING PLUMBING AND SEWERS.

I HEREBY CERTIFY THAT I AM PROPERLY REGISTERED AND/OR LICENSED AS REQUIRED BY LOS ANGLES COUNTY AND STATE OF CALIFORNIA OR THAT I AM THE LEGAL OWNER OF, AND INTEND TO RESIDE IN, THE ABOVE DESCRIBED RESIDENTIAL PROPERTY.

SIGNATURE OF PERMITTEE Jennie Perez

CONNECTION DATA

STATION 5+50.0 DEPTH 6'
MANHOLE REFERENCE 75' S of
TYPE OF CONNECTION Y. CURB (P.L.) UPPER (LOWER)
LENGTH FROM M.L. TO P.L. 10.5
CO. IMP. NO. 2350 P.C. NO. JOB NO.
TRUNK PERMIT NO. ROAD PERMIT NO.

AFFIDAVIT	WAIVER	EASEMENT	RECORD. INSTR. NO.	DATE

HWY. OR ST. WIDENING
STATE ENCROACHMENT PERMIT NO.
INDUSTRIAL WASTE APPROVAL

CHARGES

CONNECTION CHARGE FEE
REIMBURSEMENT FEE

APPROVALS

	DATE	INSPECTOR'S SIGNATURE
NEW HOUSE SEWER	23 Apr 71	V. A. Doyle
CONNECT ADDITIONAL BUILDING OR WORK		
SEPTIC TANK, SEEP. PIT(S) AND/OR DRAINFIELD	23 Apr 71	V. A. Doyle
CESSPOOL ☐ DRYWELL ☐		
ALTER, REPAIR, SEWER OR SEWAGE DISPOSAL SYSTEM		
DISCONNECT, PLUG AND ABANDON HOUSE SEWER		
BACKFILL SEPTIC TANKS ☑ SEEP. PITS ☑ CESSPOOLS ☐	23 Apr 71	V. A. Doyle

INSPECTOR COPY

VALIDATION
CK. M. O. (CASH)

JACK R. ALLEN
SUPERVISING MECHANICAL ENGINEER

AC091671 APR 1910 A 13.00

E. Ervin

FOR DEPARTMENT USE

REQUIRED INFORMATION

1. INDICATE ALL BUILDINGS ON PROPERTY.
2. INDICATE AND DIMENSION SEWAGE DISPOSAL SYSTEM WITH TIE DISTANCES TO BUILDINGS AND PROPERTY LINES.
3. INDICATE SIZE OF SEPTIC TANK – DEPTH OF SEEPAGE PIT(S) – SIZE OF CESSPOOL(S).
4. INDICATE NORTH DIRECTION ON PLOT.
5. INDICATE BOTH STREETS IF CORNER.

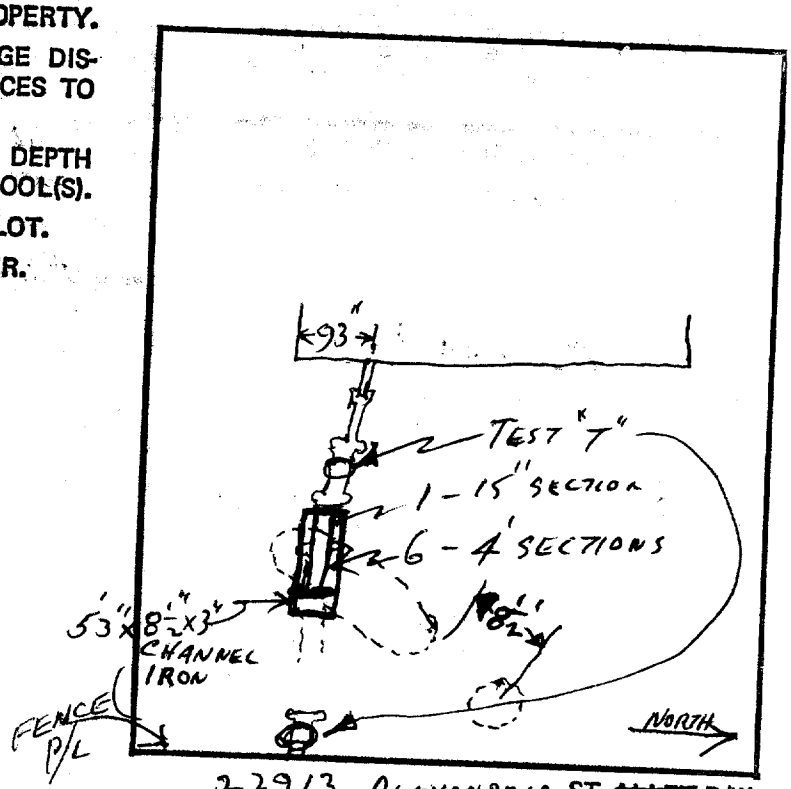

22913 ALEXANDRIA ST. ~~ALLEY~~ R/W

FIELD NOTES SEEPAGE PIT & SEPTIC REASONABLY FILLED WITH DIRT MUDDIED BY FILL-IN WATER, WHICH WAS POURED IN TO AID SETTLING.

SEWER PIPE BED WAS BOTH TOO FULL OF DIRT PACKED UP TO ABOUT 1/2 PIPE'S DIAMETER & TOO SOGGY FROM WATER ODZING & OVERFLOWING OUT OF SEPTIC TANK TO ALLOW A WATER TEST.

CHANNEL IRON RESTS ON BROKEN-AWAY WALLS OF SEPTIC TANK. THERE IS AN INCH OR SO CLEARANCE BETWEEN MAIN BODY OF PIPE & CHANNEL. I ADVISED MR. PEREZ TO FILL THE CHANNEL & THE REMAINDER OF THE SEPTIC TANK WITH SAND. HE TOLD ME THAT HE HAD HELPED A COUPLE OF HIS NEIGHBORS USE THIS TECHNIQUE OF A CHANNEL IRON ACROSS THE BROKEN-AWAY WALLS OF THE SEPTIC TANK. V. G. ROSE 23 APR 91

Joint Tenancy Grant Deed

THIS FORM FURNISHED BY TITLE INSURANCE AND TRUST COMPANY

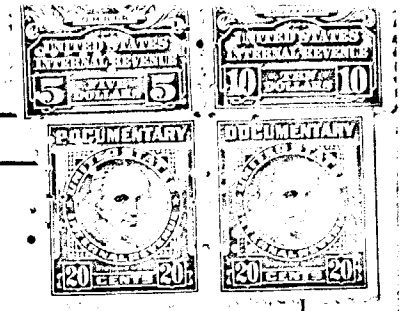

FOR A VALUABLE CONSIDERATION, receipt of which is hereby acknowledged,

C. B. BAGNALL, a married man as his separate property

hereby GRANT(S) to

ALFRED PEREZ and JENNIE PEREZ, husband and wife , AS JOINT TENANTS,

the real property in the county of Los Angeles state of California, described as:

The South 40 feet of the north 440 feet of the West 125.67 feet of the East 150.67 feet of Lot A of Tract 3020, in the county of Los Angeles as per map recorded in book 31 page 19 of Maps.

EXCEPT the Westerly 2 feet of the above described property for pipe lines and incidental purposes as reserved by J.E.Pettijohn,Adelaide E.Pettijohn husband and wife and Roy F.Wolfgram & Alice M.Wolfgram husband and wife in deed recorded May 22, 1957.

ALSO EXCEPTING and reserving therefrom all oil,gas,asphaltum and other hydrocarbon substances and minerals below a depth of 300 feet , but without right of entry upon the surface by deed recorded May 22,1957 book 54569 page 68 O.R.