DEPARTMENT OF COUNTY ENGINEER
DIVISION OF BUILDING AND SAFETY
COUNTY OF LOS ANGELES
WILLIAM J. FOX, COUNTY ENGINEER

SEWER—SEWAGE DISPOSAL PERMIT APPLICATION

1

FOR APPLICANT TO FILL IN

BUILDING ADDRESS 18226 E Kirkwall Rd.
LOCALITY west Covina
NEAREST CROSS ST. Gladstone
OWNER Orangeglen Homes
MAIL ADDRESS —
CITY — TEL.NO.
CONTRACTOR O A Roberts
ADDRESS 1435 E Arrand
CITY Pomona TEL.NO. 22647
REGISTRATION NO. STATE COUNTY
LEGAL DESCRIPTION LOT NO. 144 B1
BLOCK TRACT 19225
SIZE OF LOT NO. OF BLDGS. NOW ON LOT
USE OF BUILDINGS

NO.	DESCRIPTION OF WORK	FEE		
	HOUSE SEWER CONNECTING TO PUBLIC SEWER	@ $ 3.50		
	HOUSE SEWER CONNECTING TO PRIVATE DISPOSAL SYSTEM	1.00		
	CONNECT ADDITIONAL BLDG. OR WORK TO HOUSE SEWER	1.00		
	ALTER OR REPAIR EXISTING SEWER OR DISPOSAL SYSTEM	1.00		
	DISCONNECT AND ABANDON SEWER AND/OR DISPOSAL SYSTEM	1.00		
	SEPTIC TANK, SEEPAGE PIT OR PITS AND/OR DRAINFIELD	2.00		
	CESSPOOL—DRYWELL SPECIAL CONDITIONS ONLY	2.00		

OWNERS AUTHORIZATION				
	PERMIT	$	1	00
	TOTAL FEE			

I HAVE THIS DATE CONTRACTED WITH THE HEREIN NAMED CONTRACTOR TO CONNECT THE ABOVE DESCRIBED EXISTING DWELLING TO THE PUBLIC SEWER

SIGNED THIS ..... DAY OF ..... 19....

OWNER OR OWNERS AGENT .....

ADDRESS .....

I HEREBY ACKNOWLEDGE THAT I HAVE READ THIS APPLICATION AND STATE THAT THE ABOVE IS CORRECT AND AGREE TO COMPLY WITH ALL COUNTY ORDINANCES AND STATE LAWS REGULATING PLUMBING AND SEWERS.

I HEREBY CERTIFY THAT I AM PROPERLY REGISTERED AND/OR LICENSED AS REQUIRED BY LOS ANGELES COUNTY AND STATE OF CALIFORNIA OR THAT I AM THE LEGAL OWNER OF THE ABOVE DESCRIBED RESIDENTIAL PROPERTY.

SIGNATURE OF PERMITTEE O A Roberts

BUILDING ADDRESS 18226 E Kirkwall
LOCALITY Azusa
NEAREST CROSS ST.

DISTRICT NO.	SERIAL NO.	PERMIT NO.
105.D	A	108714 S-33
RECEIVED BY G. McWhitter	Ready for Inspection	DATE ISSUED 10-1-53
USE ZONE	OCCUPANCY	MAP BK PG

CO. IMP. NO.
JOB NO.
TRUNK PERMIT NO.
ROAD PERMIT NO.
STATE ENCROACHMENT PERMIT NO.
INDUSTRIAL WASTE APPROVAL

CHARGES

CONNECTION CHARGE FEE
REIMBURSEMENT FEE

RECEIPT NO.	DATE	BY

EXCEPTION RECORDED

NO.	DATE	BY

CONNECTION DATA

STATION DEPTH
MANHOLE REFERENCE UPPER LOWER
TYPE OF CONNECTION LENGTH FROM
Y. CURB P.L. M.L. TO P.L.

APPROVALS	INSPECTOR'S SIGNATURE	DATE
NEW HOUSE SEWER		
CONNECT ADDITIONAL BUILDING OR WORK		
SEPTIC TANK, SEEP. PIT(S) AND/OR DRAINFIELD		
CESSPOOL ☐ DRYWELL ☐		
ALTER, REPAIR, SEWER OR SEWAGE DISPOSAL SYSTEM		
DISCONNECT PLUG AND ABANDON HOUSE SEWER		
BACKFILL SEPTIC TANKS ☐ SEEP.PIT(S) ☐ CESSPOOLS ☐		

T6A642D 663 1/53

FOR DEPARTMENT USE

REQUIRED INFORMATION

1. INDICATE ALL BUILDINGS ON PROPERTY.
2. INDICATE AND DIMENSION SEWAGE DISPOSAL SYSTEM WITH TIE DISTANCES TO BUILDINGS AND PROPERTY LINES.
3. INDICATE SIZE OF SEPTIC TANK—DEPTH OF SEEPAGE PIT(S)—SIZE OF CESSPOOL(S)
4. INDICATE NORTH DIRECTION ON PLOT.
5. INDICATE BOTH STREETS IF CORNER.

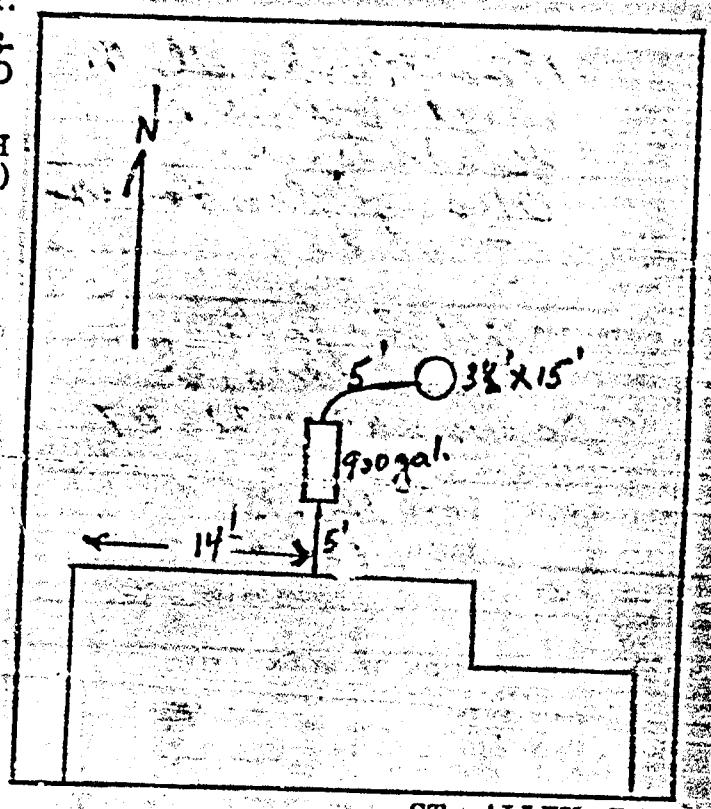

LEGAL DESCRIPTION

FIELD NOTES