COUNTY OF LOS ANGELES
DEPARTMENT OF PUBLIC WORKS

DRAINAGE DISTRICT IMPROVEMENT NO. 26
HARRIS AVENUE LATERAL

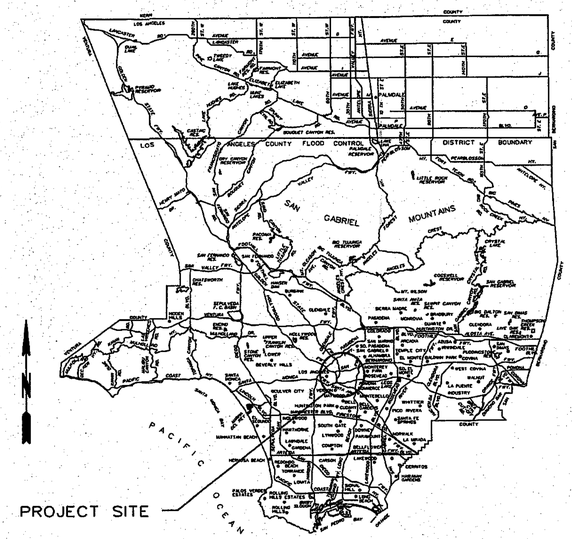

Thomas Bros. Pg. 635-D4, E4

LOCATION MAP

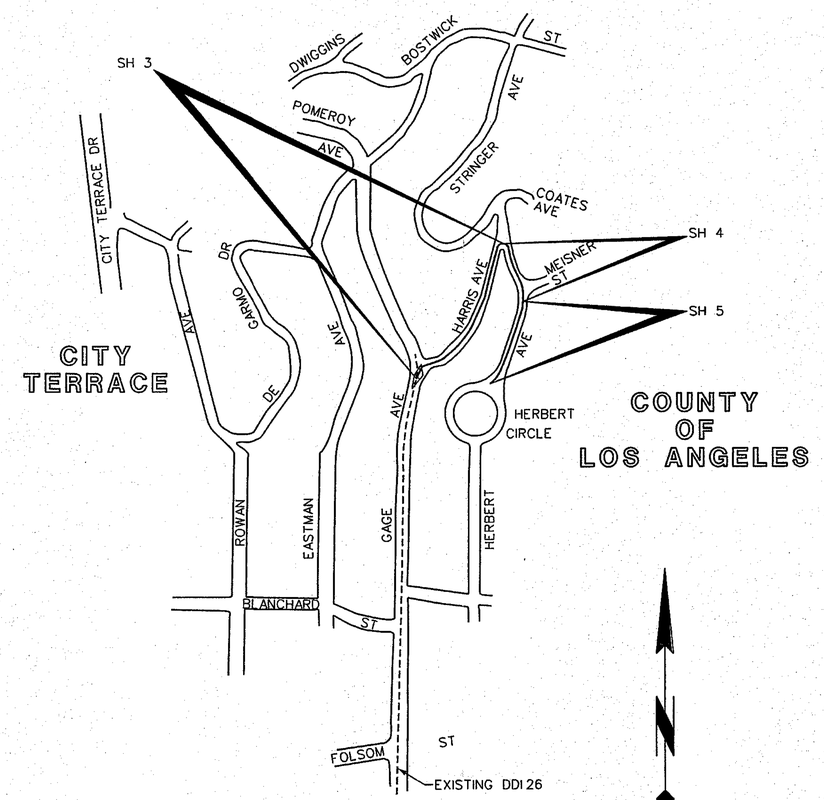

GENERAL PLAN
NOT TO SCALE

INDEX TO PROJECT PLANS

SH. NO.	DESCRIPTION
1.	TITLE SHEET
2.	GENERAL NOTES AND REFERENCES
3.	PLAN AND PROFILE - STA 1+00 TO STA 7+01.89
4.	PLAN AND PROFILE - STA 0+97.76 TO STA 4+50
5.	PLAN AND PROFILE - STA 4+50 TO STA 7+32
6.	LOGS OF BORINGS

UTILITIES

GAS.....THE GAS COMPANY
ELECTRIC.....SOUTHERN CALIFORNIA EDISON
WATER.....CALIFORNIA WATER SERVICE COMPANY
SANITARY SEWER.....LACDPW

REFERENCES

DRAWINGS: 118-FD3.4
SURVEY NOTES: PWFB 1323 pages 2065, 2796-2799, 2811-2817

PERMANENT RESURFACING SCHEDULE		
SYMBOL	EXISTING PAVEMENT	RESURFACING PAVEMENT
	4" AC and 10" CMB	5" AC and 10" CMB

NOTE:

1. THE PERMANENT RESURFACING PLAN SHOWN TO THE RIGHT IS SCHEMATIC. PAVEMENT THICKNESSES SHOWN APPLY ONLY WITHIN THE LIMITS OF EXCAVATION. THE CONTRACTOR IS RESPONSIBLE FOR DAMAGE TO PAVEMENT OUTSIDE OFTHE LIMITS OF EXCAVATION.

PD050861

■ AS BUILT DRAWINGS

DRAINAGE DISTRICT IMPROVEMENT NO. 26

CADD PROJECT FILE NAME RDC0011687.dgn
CHECKED A. LOPEZ
DESIGNED T. NGUYEN
DRAFTER T. NGUYEN

TWO DAYS BEFORE YOU DIG
CALL USA TOLL FREE
1-800-227-2600

APPROVED: GAIL FARBER DIRECTOR OF PUBLIC WORKS
BY Patrick J. Mitchell — DEPUTY DIRECTOR — DATE 9-07-2010
RECOMMENDED BY — ASSISTANT DEPUTY DIRECTOR — DATE 8-26-10
SUBMITTED BY — DATE 8-26-10

DATE	MK	DESCRIPTION

REVISIONS

REGISTERED PROFESSIONAL ENGINEER A. LOPEZ NO. C75249 EXP. 12/31/11 CIVIL STATE OF CALIFORNIA
PROJECT ENGINEER — DATE 8/26/10

COUNTY OF LOS ANGELES DEPARTMENT OF PUBLIC WORKS

DRAINAGE DISTRICT IMPROVEMENT NO. 26
HARRIS AVENUE LATERAL

TITLE SHEET

RDC0011687 | PCA X2101572 | DWG 118-D16.1 | SHEET 1 OF 6