COUNTY OF LOS ANGELES
DEPARTMENT OF PUBLIC WORKS
HARRIS AVENUE, ET AL.

HARRIS AVENUE - GAGE AVENUE TO HERBERT AVENUE
COATES AVENUE - STRINGER AVENUE TO BOSTWICK STREET
HERBERT AVENUE - COATES AVENUE TO HERBERT CIRCLE
HERBERT CIRCLE- HERBERT AVENUE TO HERBERT CIRCLE
BONNIE BEACH PLACE- SNOW DRIVE TO 365' S/O SNOW DRIVE
TOTAL LENGTH 0.64 MILE

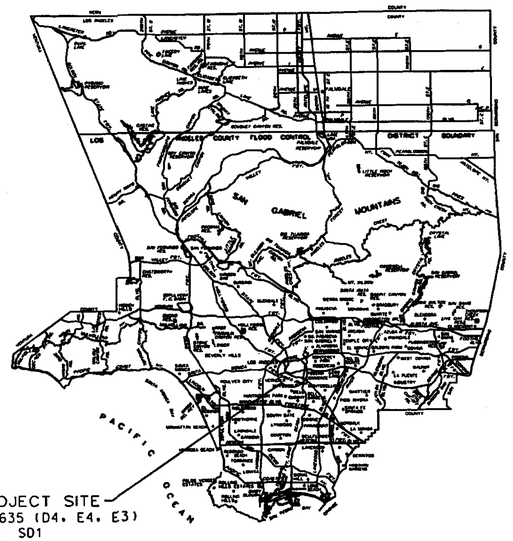

PROJECT SITE
TG 635 (D4, E4, E3)
MD4 SD1
RD 142
LOCATION MAP

INDEX

SHEET	1	TITLE SHEET
SHEET	2	NOTES AND REFERENCES
SHEET	3	TYPICAL SECTIONS
SHEET	4-13	PLAN AND PROFILE SHEET
SHEET	14	STAIRWAY DETAILS
SHEET	15	STAIRWAY, CURB & WALL DETAILS
SHEET	16	WALL DETAILS
PLAN	DR	DRAINAGE PLAN
■ SHEET	17	AS BUILT DETAILS

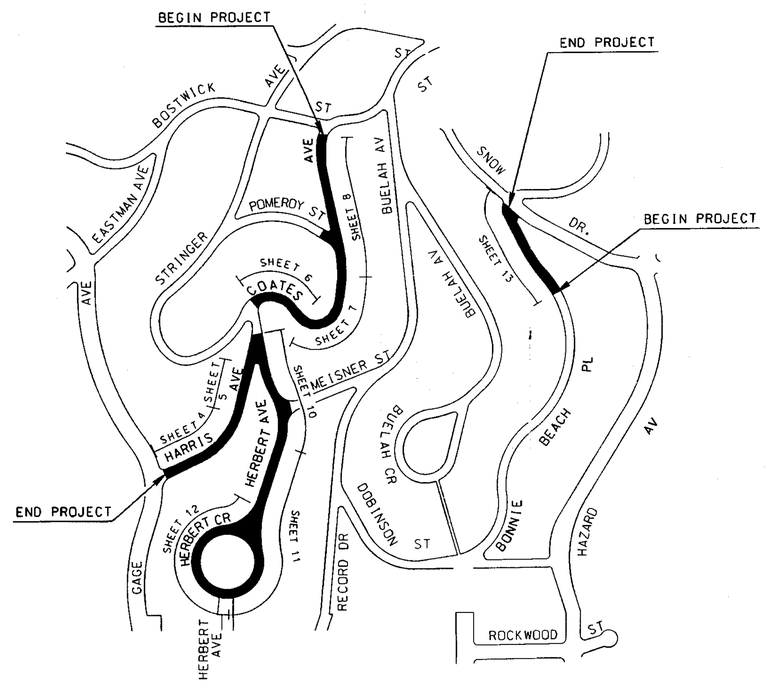

KEY MAP
NO SCALE

■ AS BUILT DRAWINGS

PH075574

TWO DAYS BEFORE YOU DIG CALL U.S.A. TOLL FREE 1·800·227·2600	APPROVED GAIL FARBER DIRECTOR OF PUBLIC WORKS BY Patrick V. O'Chelli 9-27-2010 DEPUTY DIRECTOR DATE RECOMMENDED BY 8-26-10 ASSISTANT DEPUTY DIRECTOR DATE SUBMITTED BY Craig Cline 8-26-10 HIGHWAY DESIGN SECTION I DATE	8-15-12 ■ AS BUILT REVISIONS DATE DESCRIPTION REVISIONS	REGISTERED PROFESSIONAL ENGINEER R. SIAGIAN NO. C67961 EXP. 06/30/11 CIVIL STATE OF CALIFORNIA 8/26/10 PROJECT ENGINEER DATE

COUNTY OF LOS ANGELES DEPARTMENT OF PUBLIC WORKS

HARRIS AVENUE, ET AL.

TITLE SHEET

PROJECT ID NO. RDC0011687
T.G. 635 - E3, D4 & E4

■ 17

JOB X2101572 | DWG PH075574 | SHEET 1 OF ~~16~~

CADD DRAWING NUMBER RDC0011687_HARRIS.DGN
DESIGNER RS
DRAFTER RS, BF