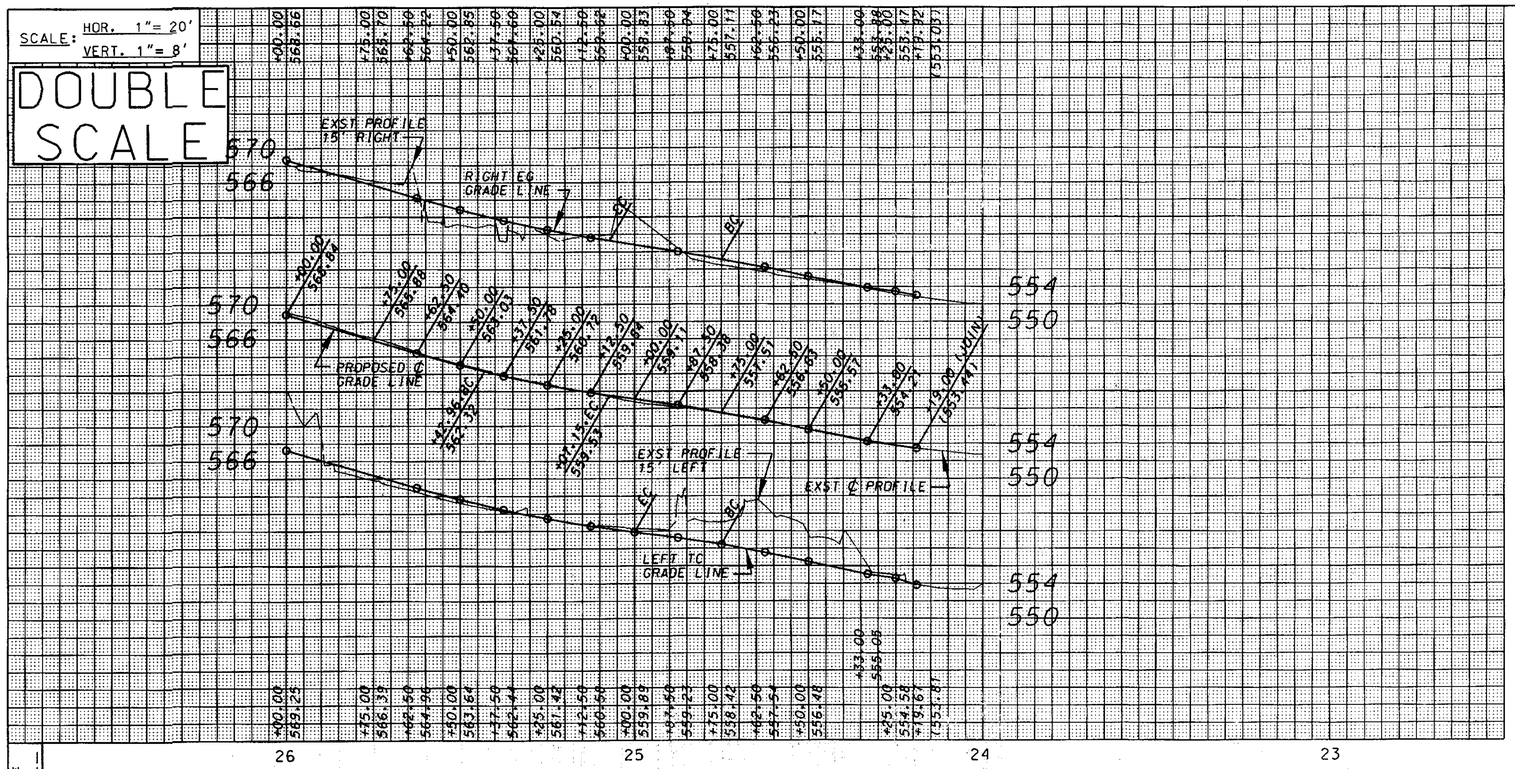

DRIVEWAY ELEVATION TABLE			
COATES AVENUE (RIGHT SIDE)			
STATION	OFFSET (FT)	ELEVATION (FT)	DESCRIPTION
32+73	8	601.66	GRADE BREAK
	10	601.87	GRADE BREAK
	15	601.81	JOIN
COATES AVENUE (LEFT SIDE)			
STATION	OFFSET (FT)	ELEVATION (FT)	DESCRIPTION
24+95.50	10.30	559.16	GRADE BREAK
	20.50	560.75	GRADE BREAK
	25	560.02	JOIN
HARRIS AVENUE (LEFT SIDE)			
STATION	OFFSET (FT)	ELEVATION (FT)	DESCRIPTION
225+23	22	480.20	GRADE BREAK
	28	482.22	JOIN

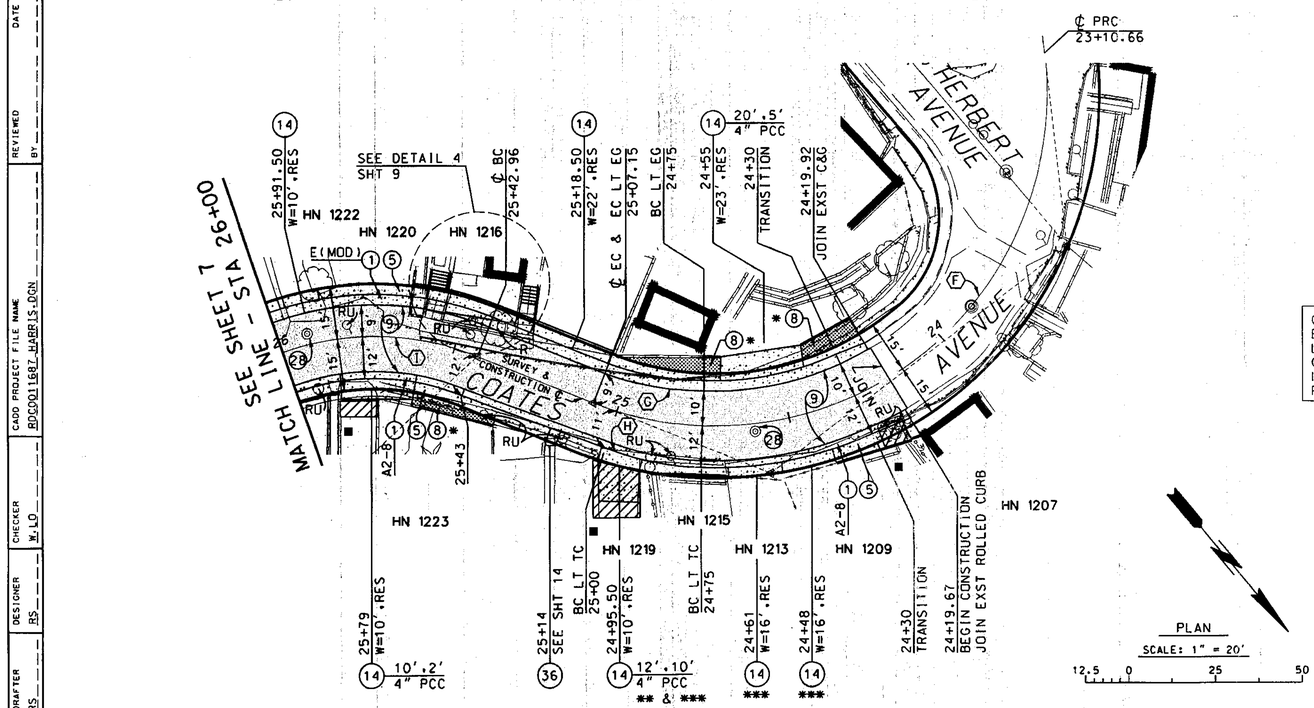

CONTROL 140 RIVERA 1980
EL=557.232
L & DPW TAG IN DRIVEWAY OF HN 1213 ON COATES AVENUE ± 105' EAST OF CENTERLINE INTERSECTION WITH HARRIS AVENUE
PUBLIC WORKS LEVEL BOOK 1323 PAGE 2801

CURVE DATA				
CURVE	CENTRAL ANGLE	RADIUS	LENGTH	TANGENT
(F)	118°34'58"	94.94'	196.49'	159.85'
(G)	19°24'29"	85.49'	28.96'	14.62'
(H)	19°24'29"	82.98'	28.11'	14.19'
(I)	129°06'20"	79.34'	178.78'	166.73'

* SEE PARKWAY DETAIL 1 ON SHEET 3

** SEE TABLE ON SHEET 6 FOR DRIVEWAY GRADE BREAKS

*** SEE DRIVEWAY DETAIL C ON SHEET 15

PH075579

DATE	MK	DESCRIPTION
8-15-12	■	AS BUILT REVISIONS

REVISIONS

REGISTERED PROFESSIONAL ENGINEER R. SIAGIAN NO. C67961 EXP. 06/30/11 CIVIL STATE OF CALIFORNIA

PROJECT ENGINEER 8/26/10 DATE

COUNTY OF LOS ANGELES DEPARTMENT OF PUBLIC WORKS

HARRIS AVENUE, ET AL.

COATES AVENUE
STRINGER AVE TO BOSTWICK ST
PLAN & PROFILE
PROJECT ID NO. RDC0011687
T.G. 635 - E4

RDC0011687 | JOB X2101572 | DWG PH075579 | SHEET 6 OF ~~16~~ ■ 17

DRAFTER RS | DESIGNER RS | CHECKER W.LO | CADD PROJECT FILE NAME RDC0011687_HARRIS.DGN | REVIEWED BY | DATE

AS BUILT DRAWINGS