SCALE: HOR. 1"= 20'
VERT. 1"= 8'

DOUBLE SCALE

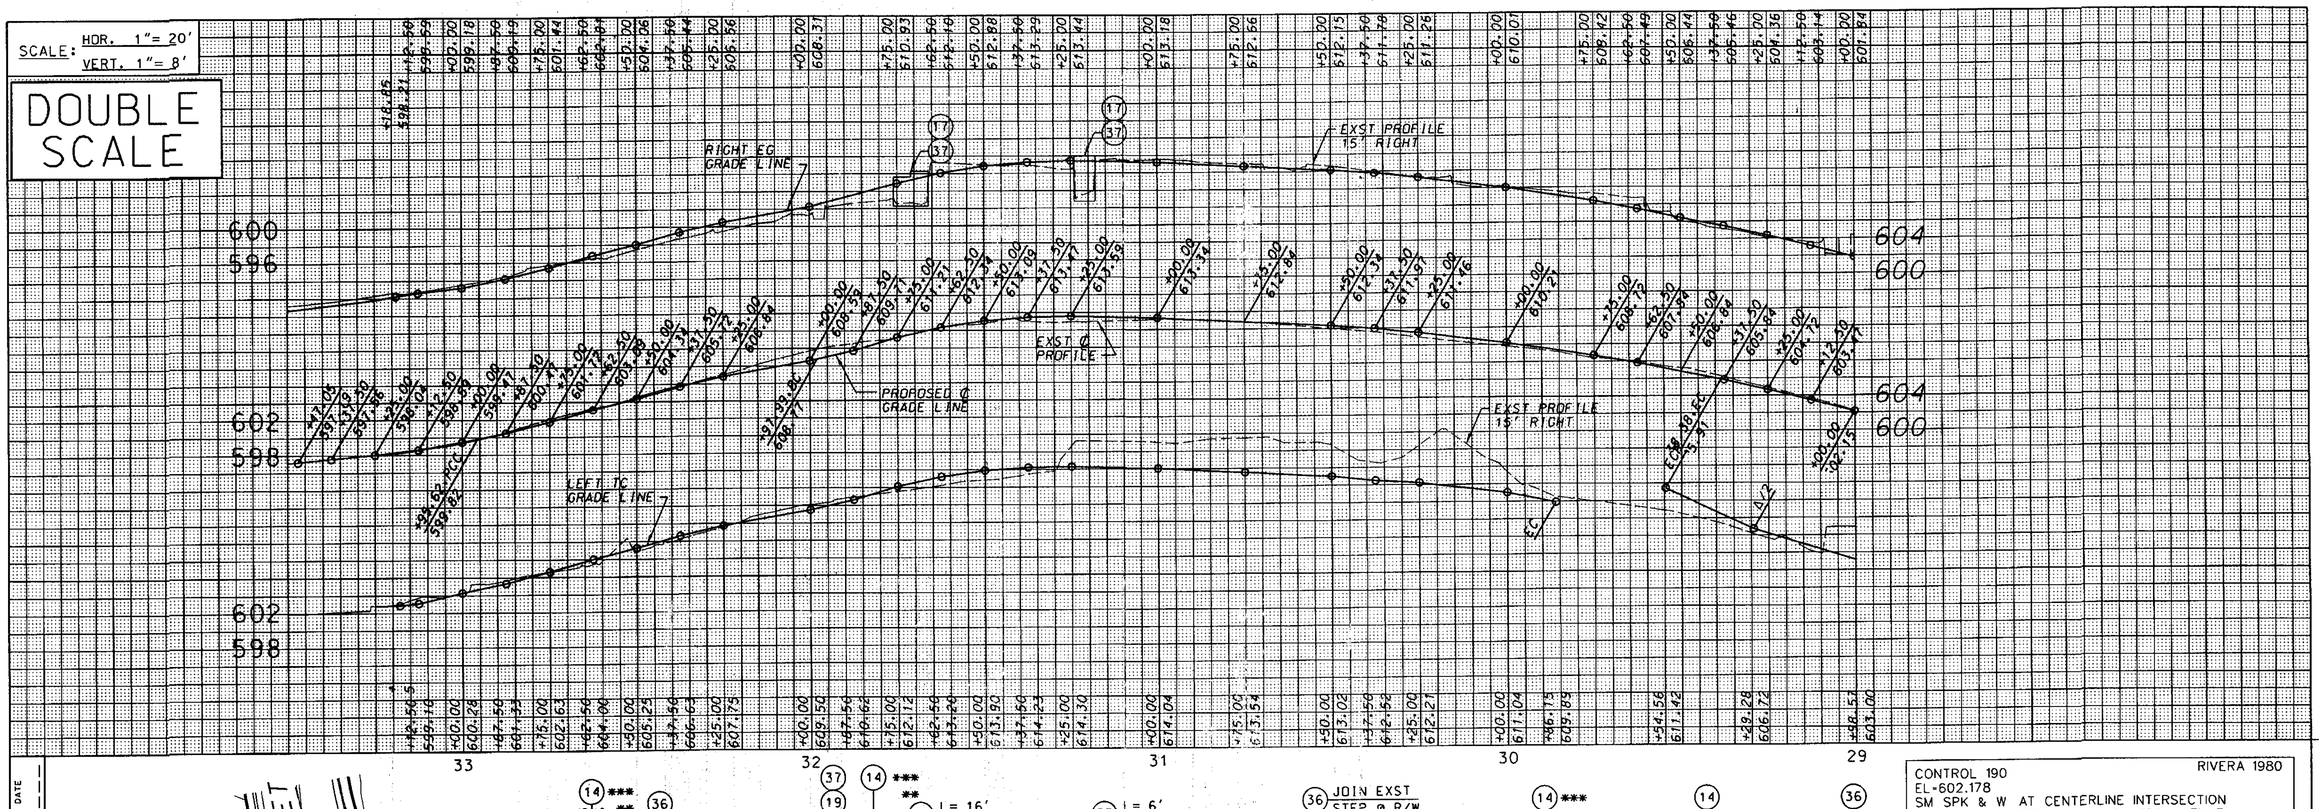

CONTROL 190 RIVERA 1980
EL-602.178
SM SPK & W AT CENTERLINE INTERSECTION
OF POMEROY STREET AND COATES AVENUE
PUBLIC WORKS FIELD BOOK 1323 PAGE 2063
PUBLIC WORKS LEVEL BOOK 1323 PAGE 2805

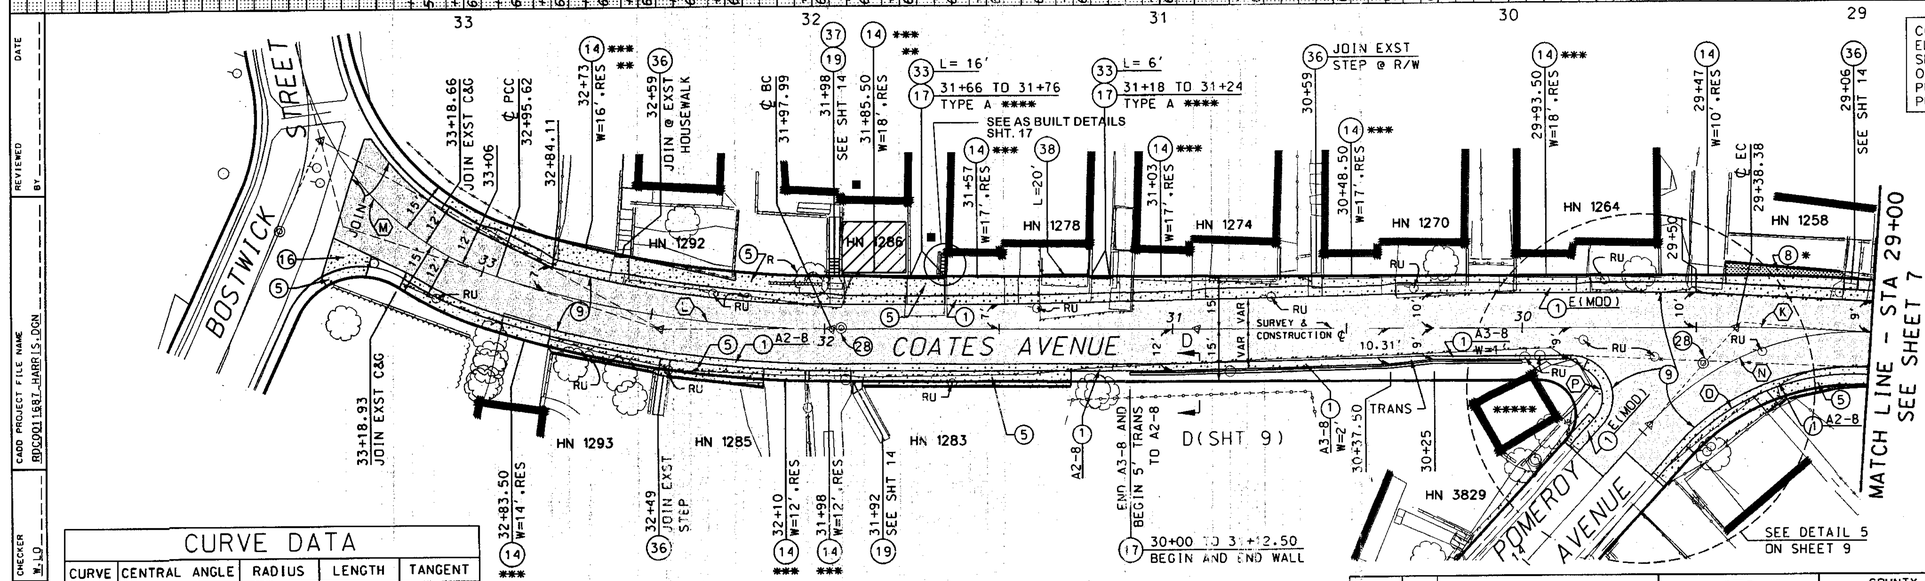

PH075581

* SEE PARKWAY DETAIL 1, SHT 3

** SEE TABLE ON SHEET 6 FOR DRIVEWAY GRADE BREAKS

*** SEE DRIVEWAY DETAIL C ON SHEET 15 AND CONTINUES FROM STA 30+94.50 TO 31+94.50

**** SEE DETAIL 2 ON SHEET 7

***** PROTECT EXST STRUCTURE

CURVE DATA

CURVE	CENTRAL ANGLE	RADIUS	LENGTH	TANGENT
K	4°34'00"	509.37'	40.60'	88.92'
L	17°57'51"	311.39'	97.63'	49.22'
M	57°22'18"	84.42'	84.53'	46.19'
N	52°32'49"	79.89'	73.27'	39.44'
O	52°27'30"	67.00'	61.34'	33.01'
P	132°00'59"	12.00'	27.65'	26.96'

PLAN
SCALE: 1" = 20'
12.5 0 25 50

DATE	MK	DESCRIPTION
8-15-12	■	AS BUILT REVISIONS
11/1/10	RS	REDESIGNED WALL AT STA 30+00 TO 31+12.50 FROM BLOCK WALL TO SLOUCH WALL

REVISIONS

REGISTERED PROFESSIONAL ENGINEER R. SIAGIAN NO. C67961 EXP. 06/30/11 CIVIL STATE OF CALIFORNIA

PROJECT ENGINEER 8/26/10 DATE

COUNTY OF LOS ANGELES DEPARTMENT OF PUBLIC WORKS

HARRIS AVENUE, ET AL.

COATES AVENUE
STRINGER AVE TO BOSTWICK ST
PLAN & PROFILE
PROJECT ID NO. RDC0011687
T.G. 635 - E3-4 ■ 17

RDC0011687 | JOB X2101572 | DWG PH075581 | SHEET 8 OF ~~16~~

AS BUILT DRAWINGS

DRAFTER R.S. | DESIGNER R.S. | CHECKER W.LO | CADD PROJECT FILE NAME RDC0011687_HARRIS.DGN | REVIEWED BY | DATE