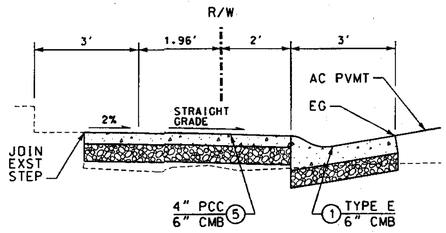

HOUSEWALK DETAIL
STA 226+57.50 RIGHT
HARRIS AVENUE
NO SCALE

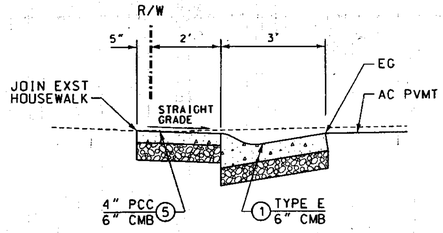

HOUSEWALK DETAIL
STA 225+97 LEFT
HARRIS AVENUE

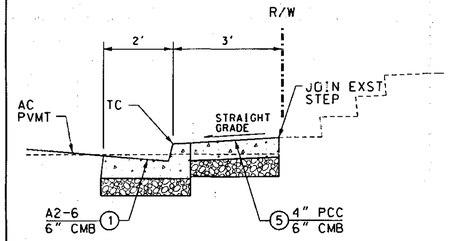

HOUSEWALK DETAIL
STA 225+67 RIGHT
HARRIS AVENUE

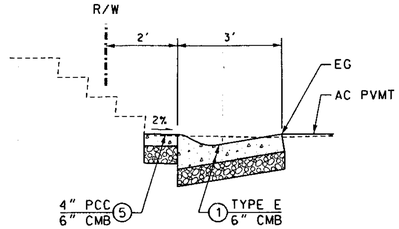

HOUSEWALK DETAIL
STA 225+49 LEFT
HARRIS AVENUE

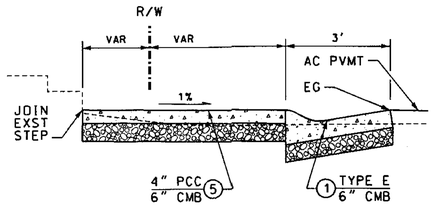

HOUSEWALK DETAIL
STA 225+04 LEFT
HARRIS AVENUE

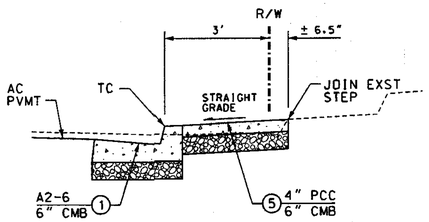

HOUSEWALK DETAIL
STA 224+85 RIGHT
HARRIS AVENUE

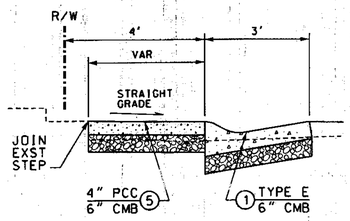

HOUSEWALK DETAIL
STA 224+83 LEFT
HARRIS AVENUE

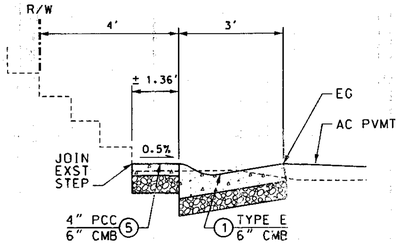

HOUSEWALK DETAIL
STA 224+15 LEFT
HARRIS AVENUE

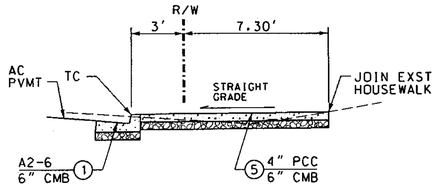

HOUSEWALK DETAIL
STA 223+27 RIGHT
HARRIS AVENUE

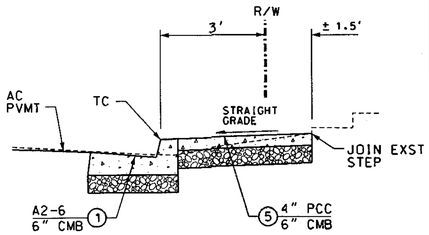

HOUSEWALK DETAIL
STA 222+76 RIGHT
HARRIS AVENUE

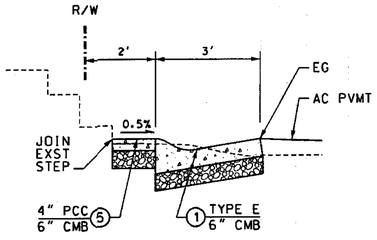

HOUSEWALK DETAIL
STA 222+49 LEFT
HARRIS AVENUE

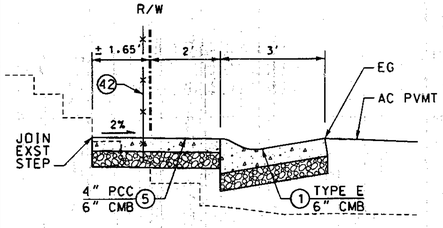

HOUSEWALK DETAIL
STA 221+89 LEFT
HARRIS AVENUE

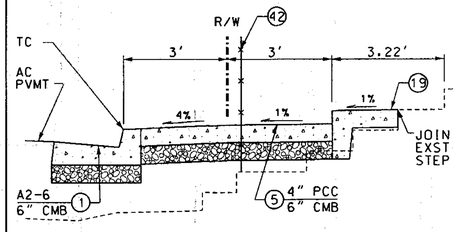

HOUSEWALK & STEP DETAIL
STA 221+62 RIGHT
HARRIS AVENUE

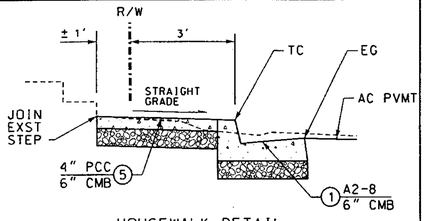

HOUSEWALK DETAIL
STA 25+14 LEFT
COATES AVE

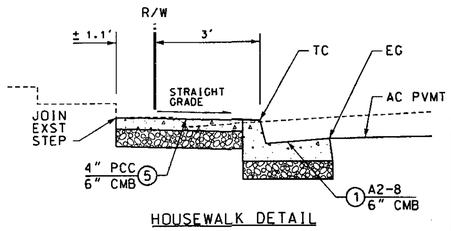

HOUSEWALK DETAIL
STA 26+54 LEFT
COATES AVE

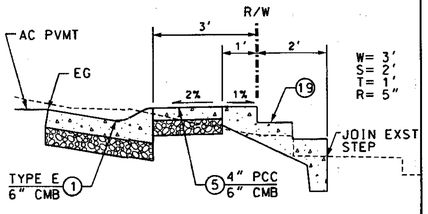

HOUSEWALK DETAIL
STA 28+16 RIGHT
COATES AVE

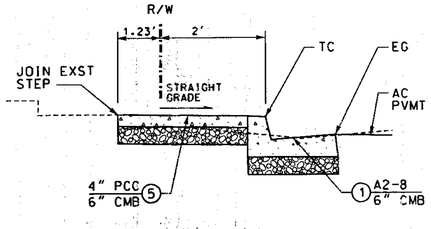

HOUSEWALK DETAIL
STA 28+34 LEFT
COATES AVE

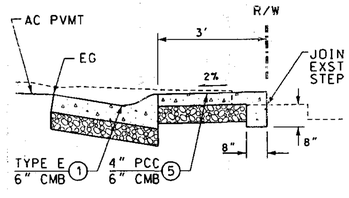

HOUSEWALK DETAIL
STA 29+06 LEFT
COATES AVE

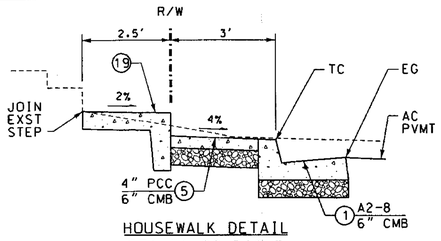

HOUSEWALK DETAIL
STA 31+92 RIGHT
COATES AVE

PH075583

DATE	MK	DESCRIPTION
8-15-12	■	AS BUILT REVISIONS

REVISIONS

REGISTERED PROFESSIONAL ENGINEER
R. SIAGIAN
NO. C67961
EXP. 06/30/11
CIVIL
STATE OF CALIFORNIA

PROJECT ENGINEER 8/26/10 DATE

COUNTY OF LOS ANGELES DEPARTMENT OF PUBLIC WORKS

HARRIS AVENUE, ET AL.

HARRIS AVENUE AND COATES AVENUE

STAIRWAY DETAILS

PROJECT ID NO. RDC0011687

T.G. 635 - E3, D4 & E4

■ 17

RDC0011687 | JOB X2101572 | DWG PH075583 | SHEET 14 OF ~~16~~

AS BUILT DRAWINGS

REVIEWED BY
CADD PROJECT FILE NAME RDC0011687_HARRIS.DGN
CHECKER W. LO
DESIGNER RS
DRAFTER RS