COLIMA ROAD - FULLERTON ROAD TO LAKE CANYON DRIVE
AZUSA AVENUE - 315' S/O COLIMA ROAD TO TOMICH ROAD
NOGALES STREET - LABIN COURT TO PATHFINDER ROAD
TOTAL LENGTH 3.96 MILES

INDEX

SHEET 1	KEY MAP
SHEET 2	NOTES AND REFERENCES
SHEET 3-5	TYPICAL SECTIONS AND DETAILS
PLAN SP	SIGNING AND STRIPING PLANS
PLAN TS	TRAFFIC SIGNAL PLANS
PLAN TC	TRAFFIC CONTROL PLANS

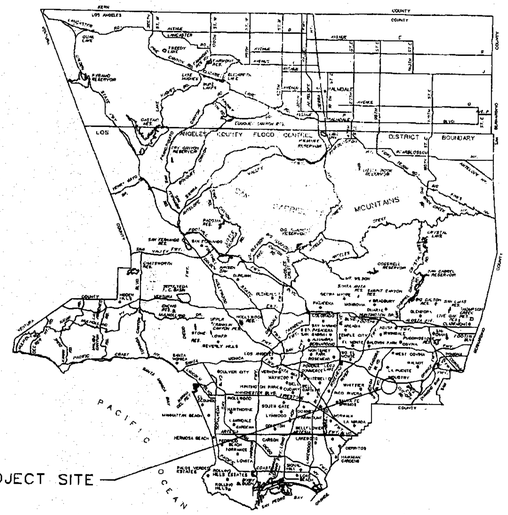

T. G. 678 G4,J-J4, J5, F5
679 A5-E5, E4-F4, B4-5
C5-6
R. D. 417

LOCATION MAP
NO SCALE

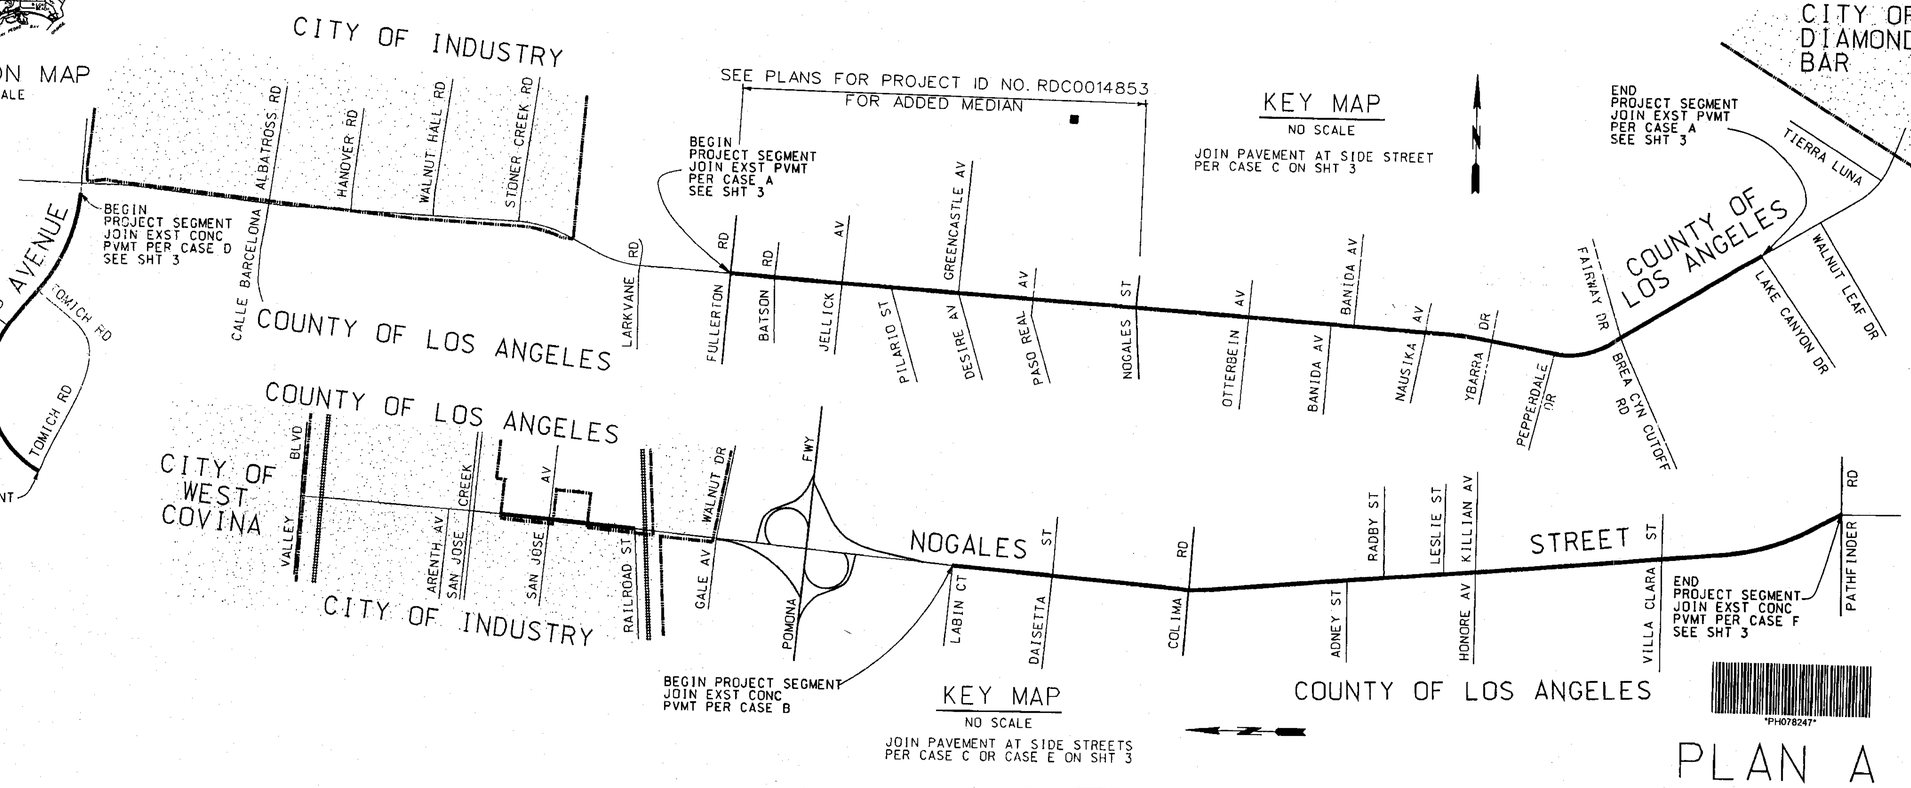

KEY MAP
NO SCALE
JOIN PAVEMENT AT SIDE STREET PER CASE C ON SHT 3

KEY MAP
NO SCALE
JOIN PAVEMENT AT SIDE STREETS PER CASE C OR CASE E ON SHT 3

PLAN A

"AS BUILT DRAWINGS"

DATE	MK	DESCRIPTION
12-12-13	■	"AS BUILT"

REVISIONS

REGISTERED PROFESSIONAL ENGINEER SUNG H. KIM NO. C 46694 EXP. 06/30/09 CIVIL STATE OF CALIFORNIA
PROJECT ENGINEER 5/14/09 DATE

COUNTY OF LOS ANGELES DEPARTMENT OF PUBLIC WORKS

COLIMA ROAD, ET AL.
KEY MAP
PROJECT ID NO. RDC0015211
PREVENTIVE MAINENANCE PROJECT

PCA X2401665 | DWG PH078247 | SHEET 1 OF 5

PLAN RD

DRAFTER A. THOMAS | DESIGNER A. THOMAS | CHECKER SUNG KIM | CADD PROJECT FILE NAME RDC0015211.DGN | REVIEWED BY | DATE 5-14-09

PROPOSED FOR CONSTRUCTION: DATE | ADVERTISED: DATE | AS BUILT: DATE