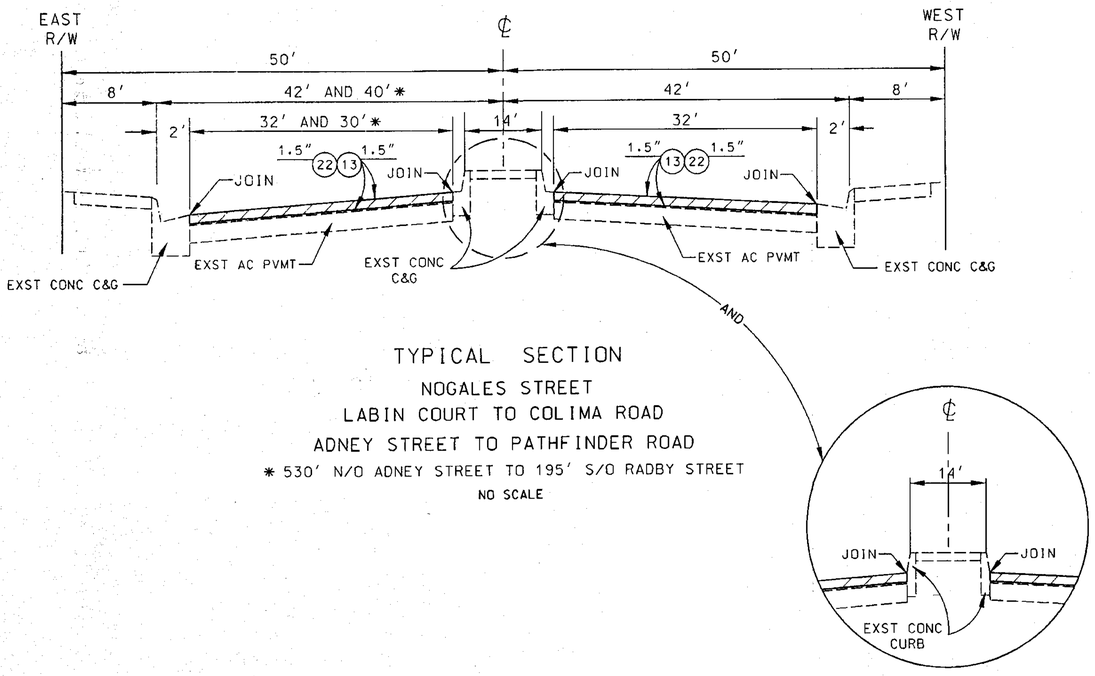

TYPICAL SECTION
NOGALES STREET
LABIN COURT TO COLIMA ROAD
ADNEY STREET TO PATHFINDER ROAD
✱ 530′ N/O ADNEY STREET TO 195′ S/O RADBY STREET
NO SCALE

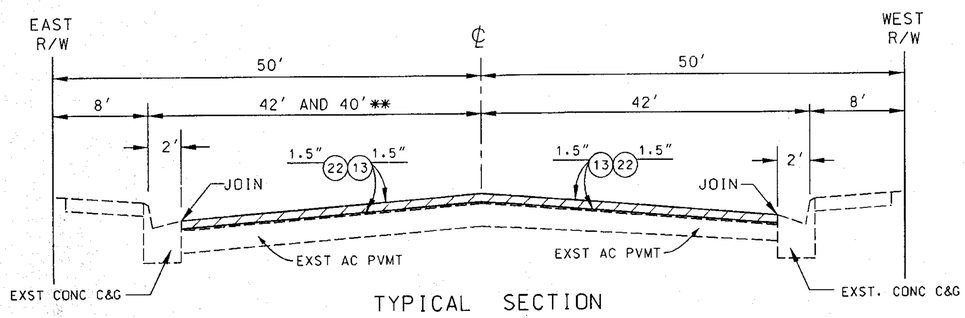

TYPICAL SECTION
NOGALES STREET
COLIMA ROAD TO ADNEY STREET
✱✱ 530′ N/O ADNEY STREET TO ADNEY STREET
NO SCALE

"PH078250"

PLAN A

DATE	MK	DESCRIPTION

REVISIONS

REGISTERED PROFESSIONAL ENGINEER — SUNG H. KIM — NO. C 46694 — EXP. 06/30/09 — CIVIL — STATE OF CALIFORNIA

PROJECT ENGINEER — DATE 5/14/09

COUNTY OF LOS ANGELES DEPARTMENT OF PUBLIC WORKS

COLIMA ROAD, ET AL.
NOGALES STREET
TYPICAL SECTIONS
PROJECT ID NO. RDC0015211

PCA X2401665 | DWG PH078250 | SHEET 4 OF 5

"AS BUILT DRAWINGS"

DRAFTER A.T./J.G. | DESIGNER A.T./J.G. | CHECKER SUNG KIM | CADD PROJECT FILE NAME RDC0015211.DGN | REVIEWED BY | DATE 5-14-09

DATE: $DATE$ TIME: $TIME$ FILE: $FILE$