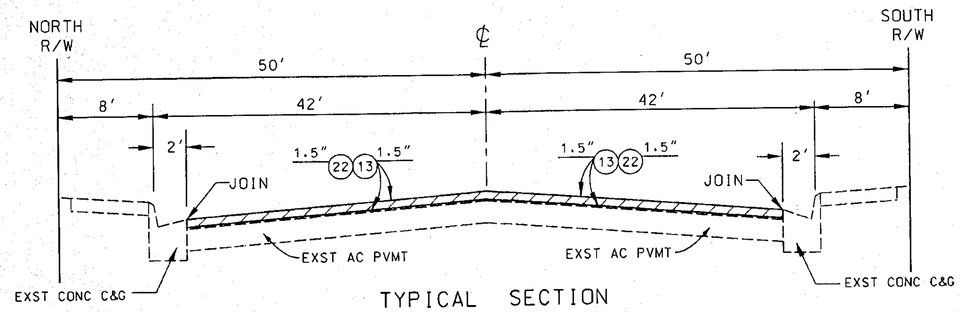

TYPICAL SECTION
COLIMA ROAD
FULLERTON ROAD TO 340' W/O PASO REAL AVENUE
PASO REAL AVENUE TO LAKE CANYON DRIVE
NO SCALE

SEE PLANS FOR PROJECT ID NO. RDC0014853
FOR ADDED MEDIAN ■

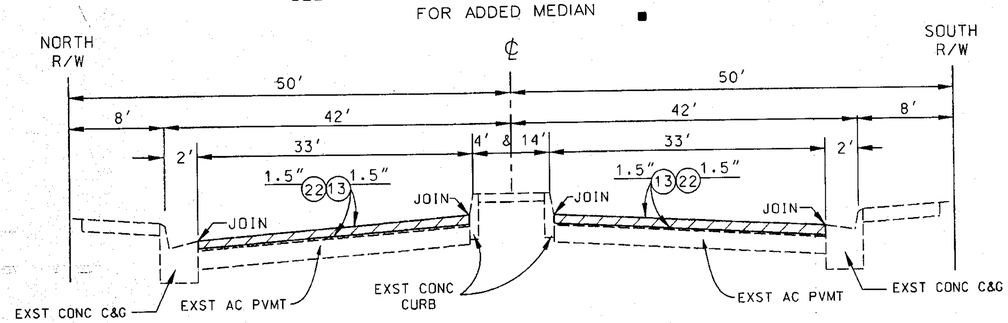

TYPICAL SECTION
COLIMA ROAD
340' W/O PASO REAL AVENUE TO PASO REAL AVENUE
NO SCALE

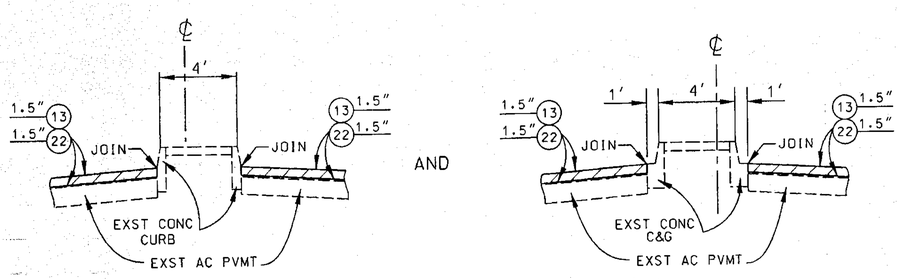

TYPICAL MEDIAN TURN POCKET SECTION
NO SCALE

PH078251

PLAN A

12-12-13	■	"AS BUILT"
DATE	MK	DESCRIPTION
REVISIONS		

REGISTERED PROFESSIONAL ENGINEER SUNG H. KIM NO. C 46694 Exp. 06/30/09 CIVIL STATE OF CALIFORNIA
PROJECT ENGINEER 5/19/09 DATE

COUNTY OF LOS ANGELES DEPARTMENT OF PUBLIC WORKS

COLIMA ROAD, ET AL.
COLIMA ROAD
TYPICAL SECTIONS
PROJECT ID NO. RDC0015211

PCA X2401665 | DWG PH078251 | SHEET 5 OF 5

"AS BUILT DRAWINGS"

DRAFTER A.T./J.G. | DESIGNER A.T./J.G. | CHECKER SUNG KIM | CADD PROJECT FILE NAME RDC0015211.DGN | REVIEWED BY | DATE 5-14-09

DATE: $DATE$ TIME: $TIME$ FILE: $FILEL$