COUNTY OF LOS ANGELES
DEPARTMENT OF PUBLIC WORKS
ENCINAL CANYON ROAD – LECHUSA RD TO 7900′ NORTH OF AVENIDA DE ENCINAL, ET AL.

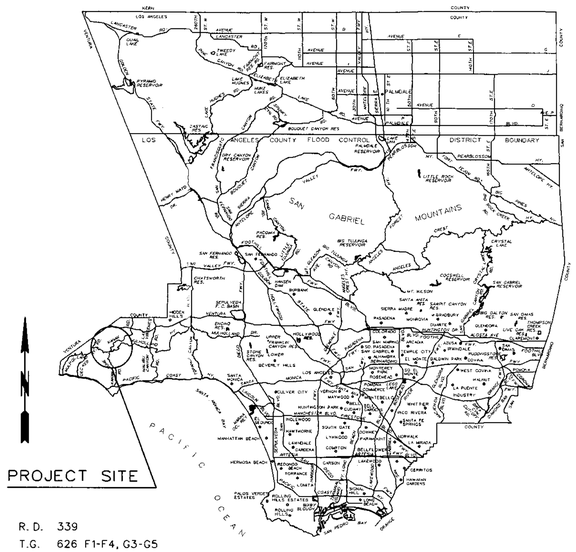

R. D. 339
T.G. 626 F1-F4, G3-G5

LOCATION MAP

INDEX

SHEET 1	KEY MAP
SHEET 2	NOTES AND REFERENCES
SHEET 3	TYPICAL SECTION AND DETAILS
PLAN SP	SIGNING AND STRIPING PLANS

LIMITS:

ENCINAL CANYON RD – LECHUSA RD TO 7900′ N/O AVENIDA DE ENCINAL
LECHUSA RD – DECKER CANYON RD TO ENCINAL CANYON RD
TOTAL LENGTH OF PROJECT = 2.91 MILES

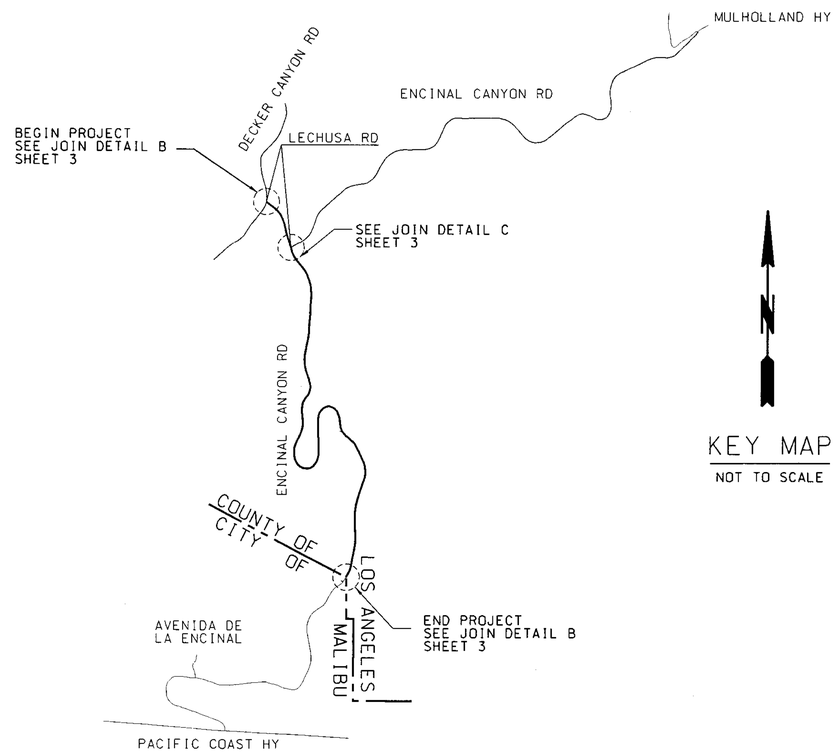

KEY MAP
NOT TO SCALE

PH078486

"AS BUILT DRAWINGS"

PROPOSED FOR CONSTRUCTION: DATE | ADVERTISED: DATE | AS BUILT: DATE

CADD PROJECT FILE NAME RDC0015253.DGN
CHECKER V. LLANA
DESIGNER E. MAGUINO
DRAFTER E. MAGUINO

TWO DAYS BEFORE YOU DIG
CALL USA TOLL FREE
1-800-227-2600

APPROVED GAIL FARBER DIRECTOR OF PUBLIC WORKS
BY Patrick J. Chelli, DEPUTY DIRECTOR — DATE 8-24-2009

RECOMMENDED
BY for ASSISTANT DEPUTY DIRECTOR — DATE 8-24-2009

SUBMITTED
BY Craig Cline, HIGHWAY SECTION I — DATE 8-18-09

DATE		DESCRIPTION
01/13/11	■	As-Built Revision

REVISIONS

REGISTERED PROFESSIONAL ENGINEER — V. LLANA, NO. C63954, EXP. 09/30/10, CIVIL, STATE OF CALIFORNIA
PROJECT ENGINEER — DATE 8/18/09

COUNTY OF LOS ANGELES DEPARTMENT OF PUBLIC WORKS

ENCINAL CANYON RD
TITLE SHEET
PROJECT ID NO. RDC0015253
PREVENTIVE MAINTENANCE PROJECT

PCA X2301717 | DWG PH078486 | SHEET 1 OF 3

DATE: $DATE$ TIME: $TIME$ FILE: $FILEL$