# COUNTY OF LOS ANGELES
# DEPARTMENT OF PUBLIC WORKS
## LAS FLORES CANYON ROAD, ET AL.

TOTAL LENGTH 18.2 MILES

### INDEX OF SHEETS


| | |
|---|---|
| SHEET NO. 1 | TITLE SHEET |
| SHEET NO. 2 | CONSTRUCTION NOTES AND REFERENCES |
| SHEET NO. 3 | TYPICAL SECTIONS AND DETAILS |
| SHEET NO. 4 | DETAILS |
| PLAN SP | STRIPING PLAN |
| PLAN TC | TRAFFIC CONTROL PLAN |


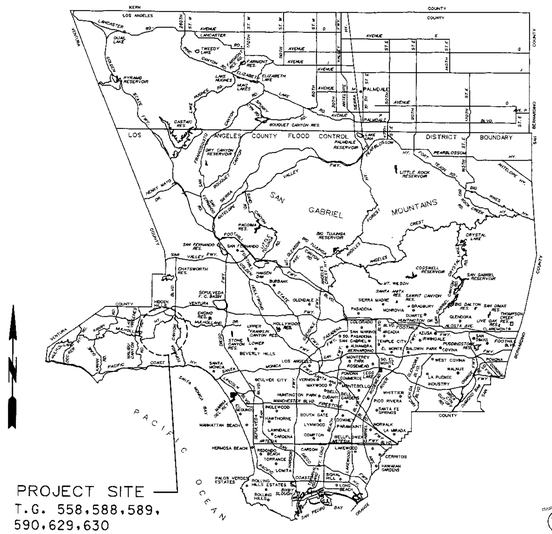


PROJECT SITE
T.G. 558,588,589,
590,629,630
(SEE KEY MAPS)
R.D. 336 & 339

LOCATION MAP




T.G. 589 E7 - 629 J2
629 J3 - 630 A1
590 B7 - 630 A1




T.G. 589 F1 - 590 A6

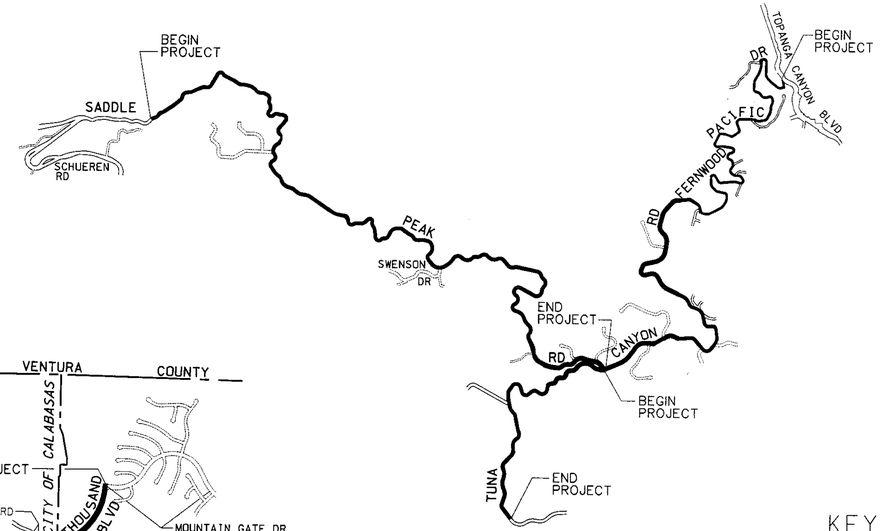


T.G. 558 A7 - 588 B3

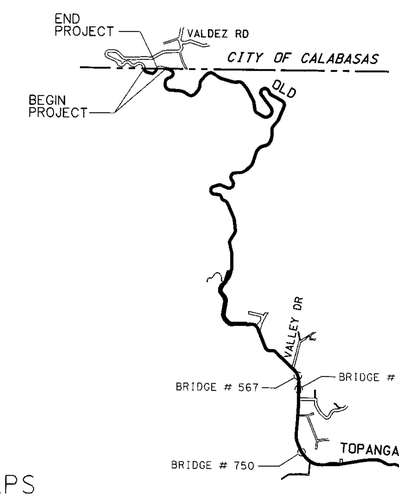


T.G. 629 E2 - E5
629 E3 - F5

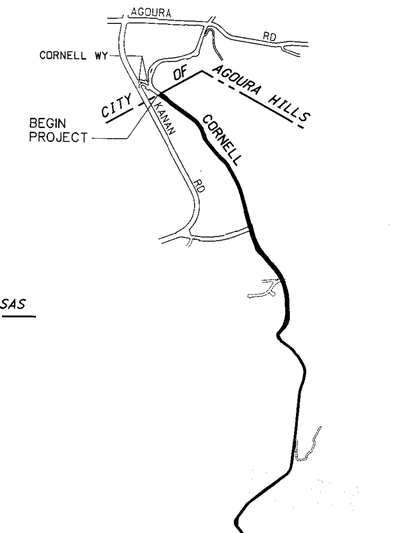


T.G. 558 J3 - J4

KEY MAPS
NO SCALE

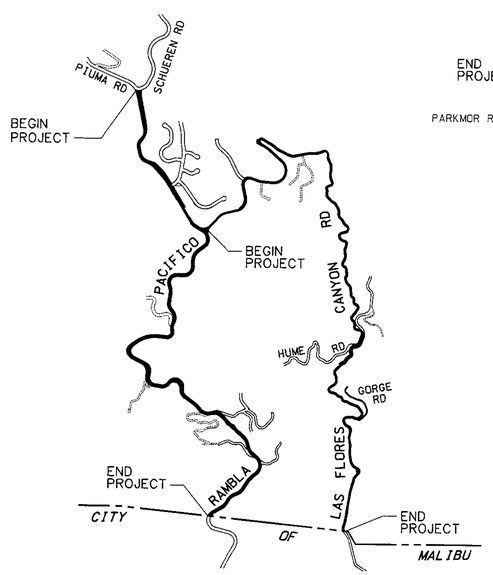SOLID LINE INDICATES SEGMENT EXTENTS

LAS FLORES CANYON ROAD - 4,050 FEET N/O PACIFIC COAST HWY TO RAMBLA PACIFICO
FERNWOOD PACIFIC DRIVE - TUNA CANYON ROAD TO TOPANGA CANYON BLVD
OLD TOPANGA CANYON ROAD - TOPANGA CANYON BLVD TO CITY OF CALABASAS BOUNDARY
OLD TOPANGA CANYON ROAD - CITY OF CALABASAS BOUNDARY TO 2,723 FEET S/O VALDEZ RD
RAMBLA PACIFICO - 2,600 FEET N/O SUMACRIDGE DR TO PIUMA RD
SADDLE PEAK ROAD - 1,400 FEET E/O SCHUEREN ROAD TO TUNA CANYON ROAD
TUNA CANYON ROAD - 5,420 FEET S/O SADDLE PEAK ROAD TO FERNWOOD PACIFIC DR
CORNELL ROAD - MULHOLLAND HWY TO 900 FEET S/O CORNELL WAY
THOUSAND OAKS BLVD - 1,547 FEET W/O MOUNTAIN GATE DRIVE TO MOUNTAIN GATE DRIVE

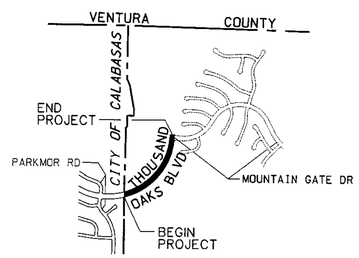*PH078529*

| | | | |
|---|---|---|---|
| DRAFTER J. DIFRANCESCO | DESIGNER J. DIFRANCESCO | CHECKER W. LO | CADD PROJECT FILE NAME RDC0014946-PLAN-RD.DGN |

TWO DAYS BEFORE YOU DIG
CALL USA TOLL FREE
1-800-227-2600

APPROVED: GAIL FARBER DIRECTOR OF PUBLIC WORKS
BY Patricia V. Schiller DEPUTY DIRECTOR — DATE 10.26.2009

RECOMMENDED
BY ASSISTANT DEPUTY DIRECTOR — DATE 10/22/09

SUBMITTED
BY Craig Cline HIGHWAY DESIGN SECTION I — DATE 10/22/09

| DATE | MK | DESCRIPTION |
|---|---|---|
| | | |

REVISIONS

REGISTERED PROFESSIONAL ENGINEER — B. BONNETT — NO. C 69726 — EXP. 06/30/10 — CIVIL — STATE OF CALIFORNIA

PROJECT ENGINEER — DATE 30 Sep 2009

COUNTY OF LOS ANGELES DEPARTMENT OF PUBLIC WORKS

LAS FLORES CANYON ROAD, ET AL.

TITLE SHEET

PROJECT ID NO. RDC0014946

PREVENTIVE MAINTENANCE PROJECT

| PCAX2301491 | DWG PH078529 | SHEET 1 OF 4 |
|---|---|---|

PROPOSED FOR CONSTRUCTION: ____ ADVERTISED: ____ AS BUILT: ____

AS BUILT DRAWINGS

PLAN RD