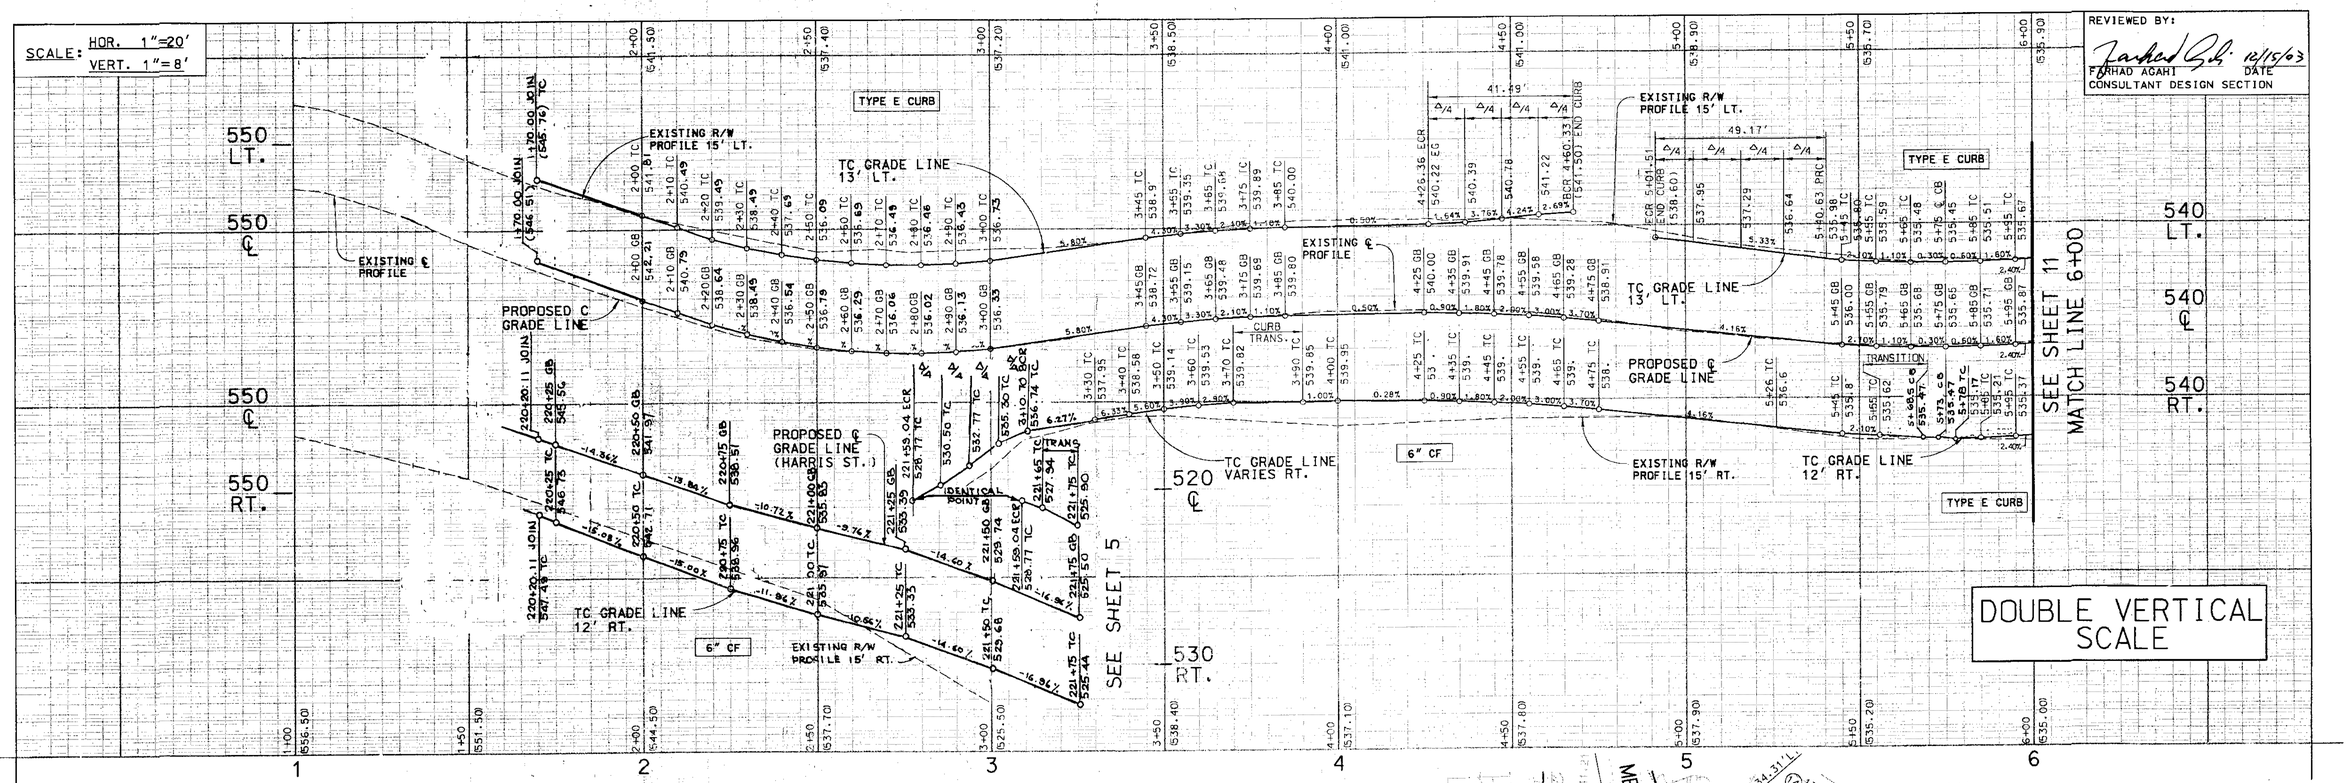

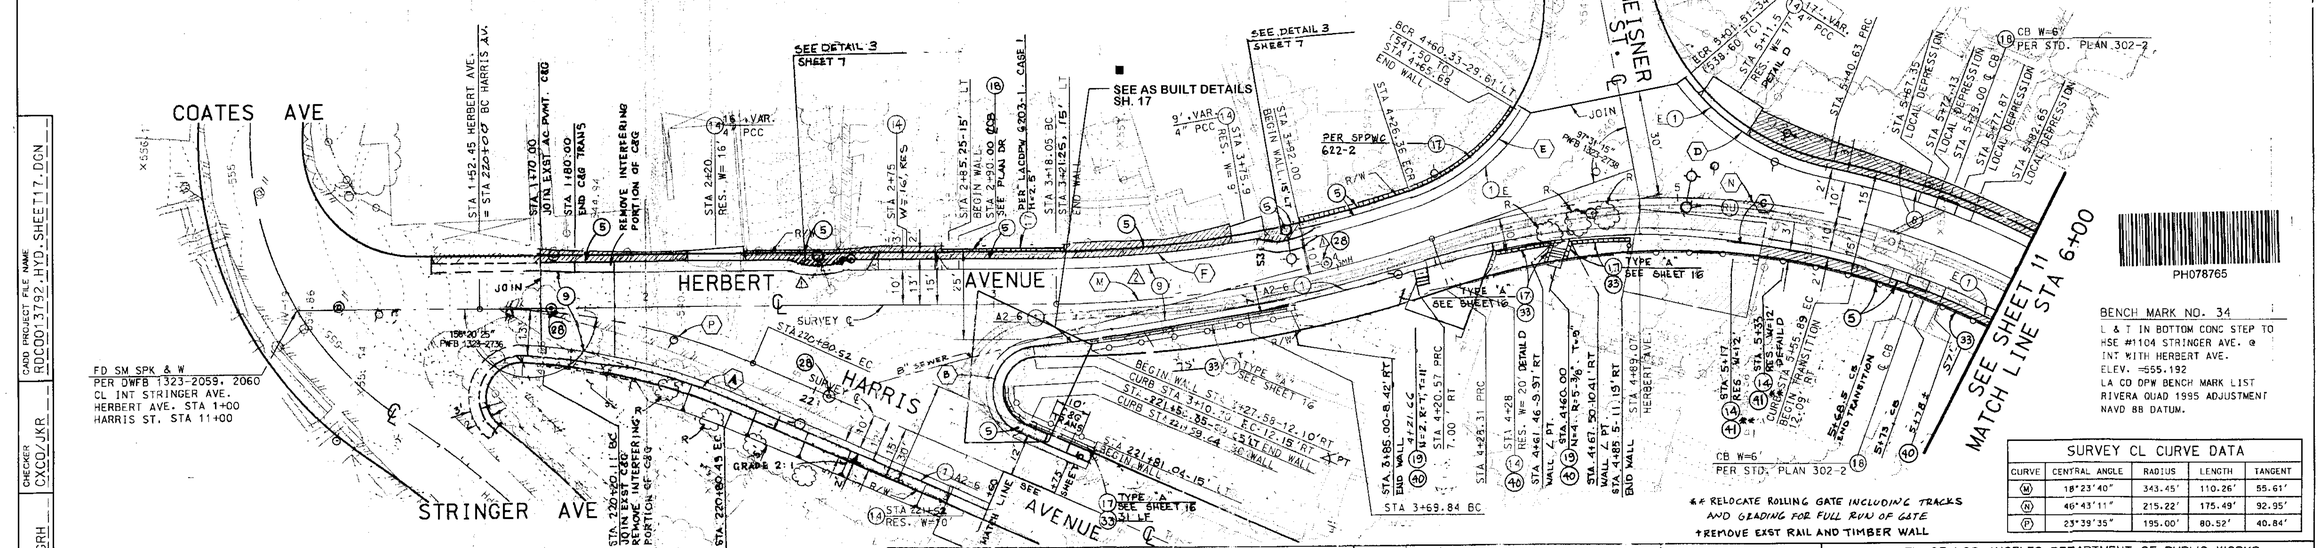

SURVEY CL CURVE DATA				
CURVE	CENTRAL ANGLE	RADIUS	LENGTH	TANGENT
(M)	18°23'40"	343.45'	110.26'	55.61'
(N)	46°43'11"	215.22'	175.49'	92.95'
(P)	23°39'35"	195.00'	80.52'	40.84'

CURB CURVE DATA				
CURVE	CENTRAL ANGLE	RADIUS	LENGTH	TANGENT
(A)	17°45'05"	183.00'	56.70'	28.58'
(B)	147°41'51"	13.00'	33.51'	44.89'
(C)	33°45'18"	220.00'	129.51'	66.75'
(D)	42°02'38"	67.00'	49.17'	25.75"
(E)	40°39'51"	58.46'	41.49'	21.66"
(F)	18°04'04"	330.45'	104.21'	52.54"

CURB CURVE DATA CONT.				
CURVE	CENTRAL ANGLE	RADIUS	LENGTH	TANGENT
(H)	29°43'26"	203.22'	105.43'	53.93'

PLAN
SCALE: 1" = 20'

DRAFTER AAP/MMST | DESIGNER MXR/JGRH | CHECKER CXCO/JKR | CADD PROJECT FILE NAME RDC0013792.HYD.SHEET17.DGN

DAVID EVANS AND ASSOCIATES INC.
800 North Haven Avenue, Suite 300
Ontario California 91764
Phone: 909.481.5750

TWO DAYS BEFORE YOU DIG
CALL USA TOLL FREE
1-800-227-2600

DATE	MK	DESCRIPTION
8-15-12	■	AS BUILT REVISIONS
8-26-10	M.O.	GENERAL PLAN REVISIONS
6-29-10	M.O.	GENERAL PLAN REVISIONS
10/20/05	4	~~ADDED (11)~~ REVISED TOTAL NO. OF SHEETS
3/25/2004	1	REVISED CURB & GUTTER AROUND PP

REVISIONS

REGISTERED PROFESSIONAL ENGINEER JEFFREY K. RUPP NO. 42868 EXP. 3/31/2004 CIVIL STATE OF CALIFORNIA
PROJECT ENGINEER 12-12-03 DATE

COUNTY OF LOS ANGELES DEPARTMENT OF PUBLIC WORKS

HARRIS AVENUE, ET AL.

HERBERT AVENUE
FROM COATES AVENUE TO STATION 6+00

PROJECT ID NO. RDC00 11687

PCA | DWG PH078765 | SHEET 10 OF ~~16~~ 17

AS BUILT DRAWINGS