SCALE: HOR. 1"= 20'
VERT. 1"= 8'

DOUBLE SCALE

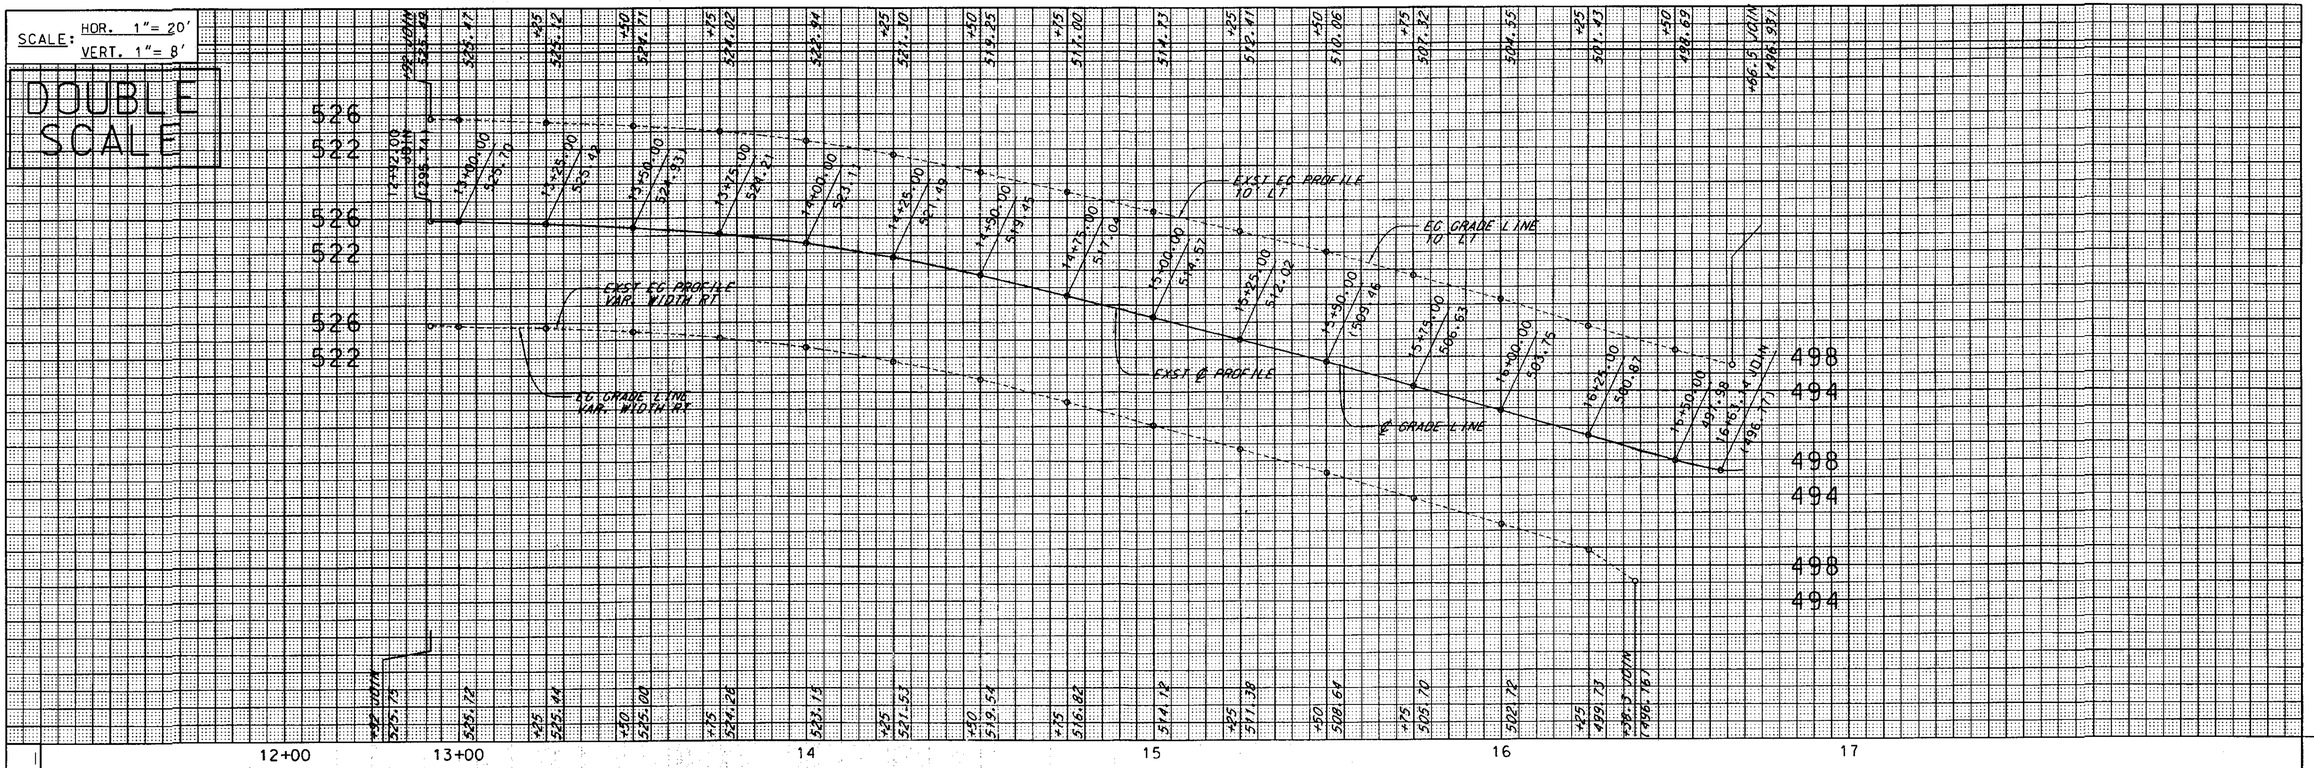

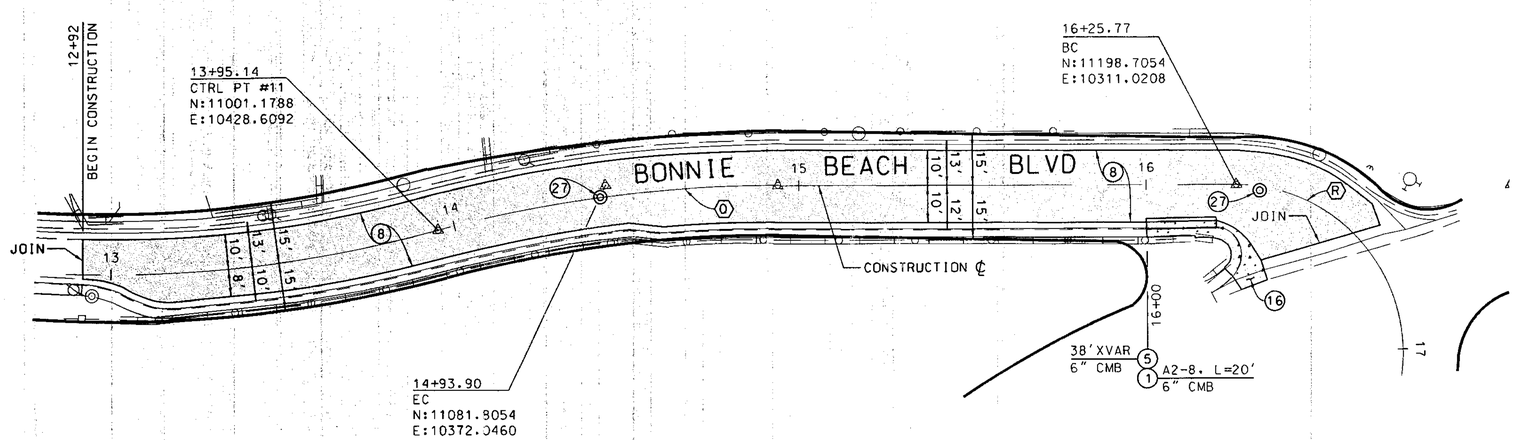

BM-CY9882 RIVERA 1980
EL=434.76
FD L& SPK @ S/W CORNER, 12" CONCRETE WALL
46' S/O ℄ CITY TERRACE DR. 29' E/O ℄ PROD.
HERBERT AVE PER PG-24

CURVE DATA				
CURVE	CENTRAL ANGLE	RADIUS	LENGTH	TANGENT
0	14°58'16"	378.00'	98.77'	49.67'
R	117°34'15"	48.00'	98.44'	79.11'

PLAN
SCALE: 1" = 20'
12.5 0 25 50

DATE	MK	DESCRIPTION
8-15-12	■	AS BUILT REVISIONS

REVISIONS

REGISTERED PROFESSIONAL ENGINEER R. SIAGIAN C67961 EXP. 06/30/11 CIVIL STATE OF CALIFORNIA

8/26/10
PROJECT ENGINEER DATE

COUNTY OF LOS ANGELES DEPARTMENT OF PUBLIC WORKS

HARRIS AVENUE, ET AL.

BONNIE BEACH PLACE

STATION 12+92 TO 16+63

PROJECT ID NO. RDC0011687

T.G. 635 - E4

■ 17

RDC0011687	JOB X2101572	DWG PH078770	SHEET 13 OF ~~16~~

PH078770

AS BUILT DRAWINGS

DRAFTER	DESIGNER	CHECKER	CADD PROJECT FILE NAME	REVIEWED BY	DATE
B. FUNG	R. SIAGIAN	W. LO	RDC0011687_HARRIS.DGN		