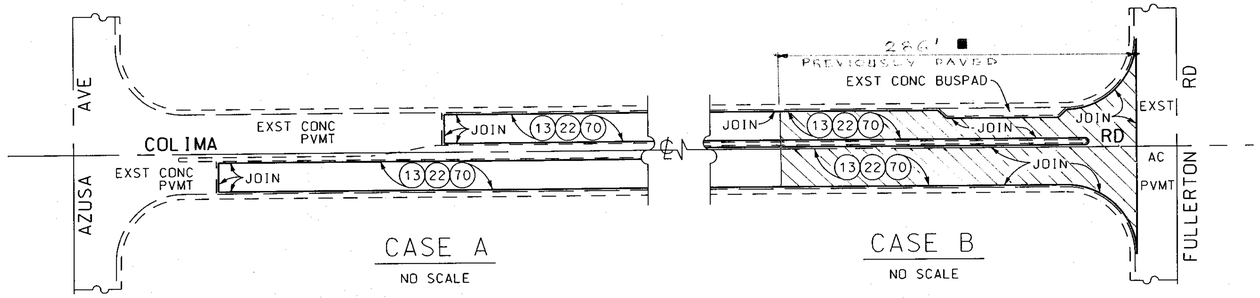

CASE A
NO SCALE

CASE B
NO SCALE

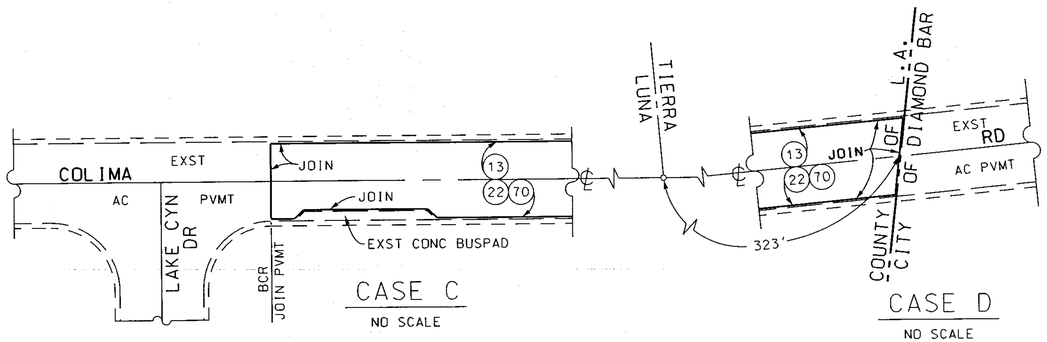

CASE C
NO SCALE

CASE D
NO SCALE

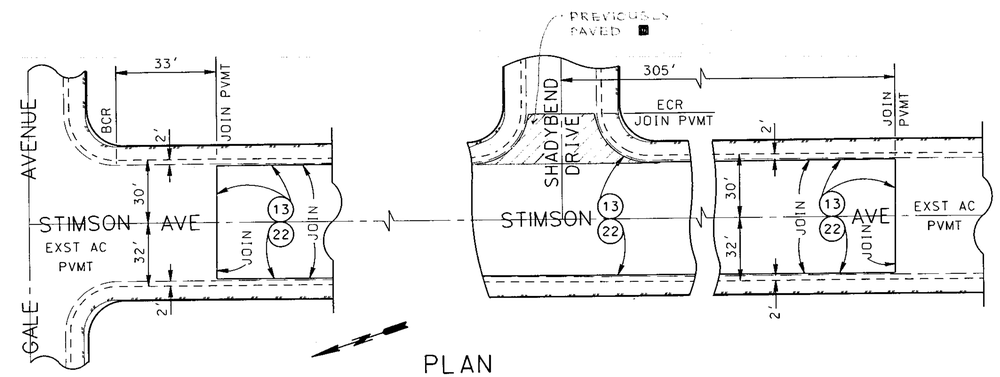

PLAN
STIMSON AVENUE
NO SCALE

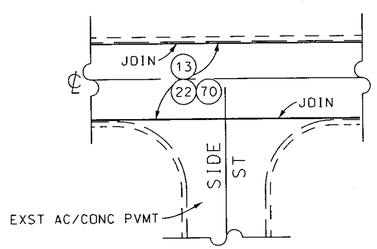

CASE E
NO SCALE

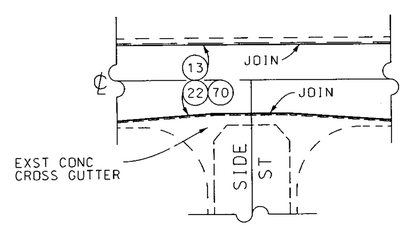

CASE F
NO SCALE

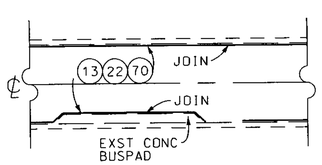

CASE G
PVMT JOIN AT BUSPAD
NO SCALE

PH078889

DATE	MK	DESCRIPTION
04-02-13	■	"AS BUILT"

REVISIONS

REGISTERED PROFESSIONAL ENGINEER — SUNG H. KIM — NO. C 46694 — EXP. 6-30-11 — CIVIL — STATE OF CALIFORNIA

PROJECT ENGINEER — DATE 8/16/10

COUNTY OF LOS ANGELES DEPARTMENT OF PUBLIC WORKS

COLIMA ROAD, ET AL PHASE 2

DETAILS

PROJECT ID NO. RDC0015339

PCA X2401846 | DWG PH078889 | SHEET 4 OF 4

"AS BUILT DRAWINGS"

PROPOSED FOR CONSTRUCTION: — DATE
ADVERTISED: — DATE
AS BUILT: — DATE

DRAFTER A. THOMAS | DESIGNER A. THOMAS | CHECKER SUNG KIM | CADD PROJECT FILE NAME RDC0015211_DGN | REVIEWED BY | DATE

DATE: $DATE$ TIME: $TIME$ FILE: $FILEL$