ESPL-5953(600)

COUNTY OF LOS ANGELES
DEPARTMENT OF PUBLIC WORKS

MULHOLLAND HIGHWAY, ET AL.

INDEX
PLAN A
PLAN B

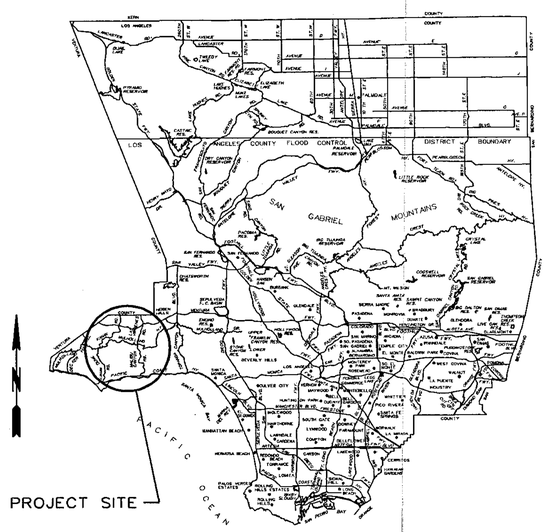

LOCATION MAP
NOT TO SCALE

AS-BUILT

PH079017

PROPOSED FOR CONSTRUCTION: DATE
ADVERTISED: DATE
AS BUILT: DATE

CADD PROJECT FILE NAME RDC0015194-PLAN-RD.DGN
CHECKER G. TSOI
DESIGNER J. GARCIA
DRAFTER J. GARCIA

TWO DAYS BEFORE YOU DIG
CALL USA TOLL FREE
1-800-227-2600

APPROVED CAL FARBER DIRECTOR OF PUBLIC WORKS
BY Patrick V. DeChellis 6-08-2009
DEPUTY DIRECTOR DATE

RECOMMENDED
BY [signature] 6/4/09
ASSISTANT DEPUTY DIRECTOR DATE

SUBMITTED
BY [signature] 6/4/09
HIGHWAY SECTION III DATE

DATE	MK	DESCRIPTION

REVISIONS

REGISTERED PROFESSIONAL ENGINEER
GILBERT TSOI
NO. 67747
EXP. 6/30/09
CIVIL
STATE OF CALIFORNIA

[signature] 6/4/09
PROJECT ENGINEER DATE

COUNTY OF LOS ANGELES DEPARTMENT OF PUBLIC WORKS

MULHOLLAND HIGHWAY, ET AL.

TITLE SHEET

PROJECT ID NO. RDC0015194

PREVENTIVE MAINTENANCE PROJECT

PCA	DWG	SHEET OF

PLAN RD

DATE: 05/14/2009 TIME: 10:28:21 AM FILE: C:\MyFiles\Gilbert\Mulholland Hwy\RDC0015194-PLAN A.dgn