REVIEWED BY

2/10/10

LACDPW DESIGN DIVISION DATE

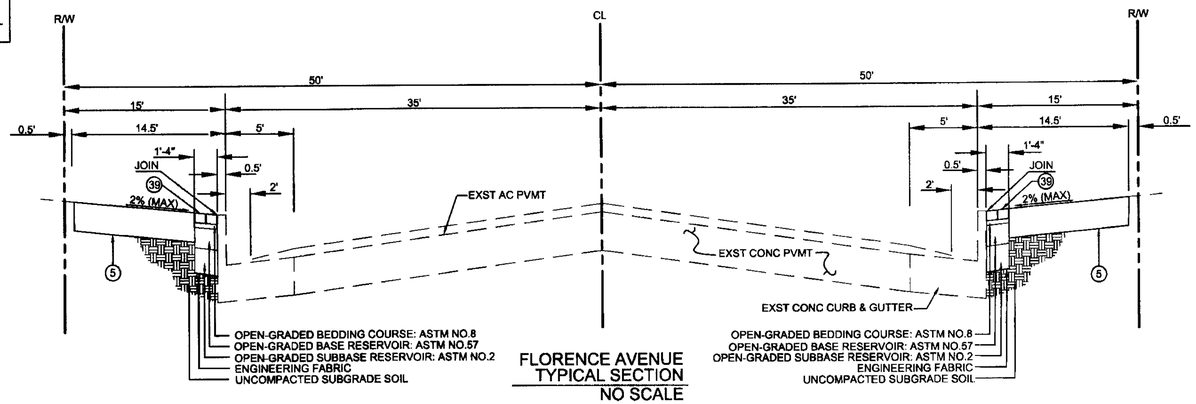

FLORENCE AVENUE
TYPICAL SECTION
NO SCALE

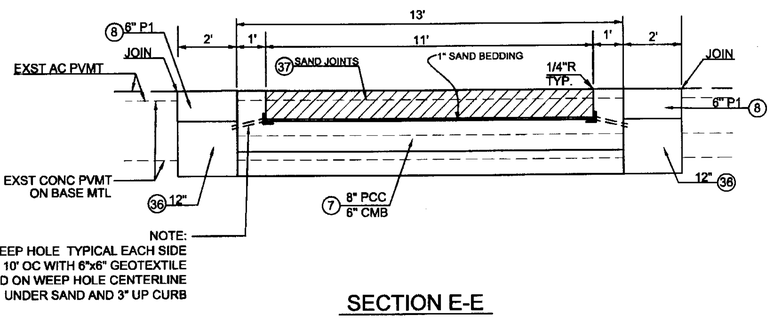

SECTION E-E

TYPICAL TRANSVERSE DECORATIVE CROSSWALK
NO SCALE

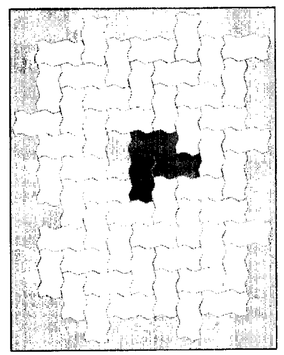

NOTE:

3 1/8" SERPENTINE CONCRETE PAVE ADA COMPLIANT.
INTEGRAL COLORS PER THE SPECIFICATION.
PAVERS TO BE LAYED AT 45°, WITH THE CROSSWALK DIRECTION.
PAVERS TO BE LAYED IN A PLANE, FLUSH WITH SURROUNDING SURFACES.
PROVIDE FINISHED EDGE BLOCK AT CONCRETE CONTAINMENT EDGE.

TYPICAL PAVER HERRINGBONE PATTERN
NO SCALE

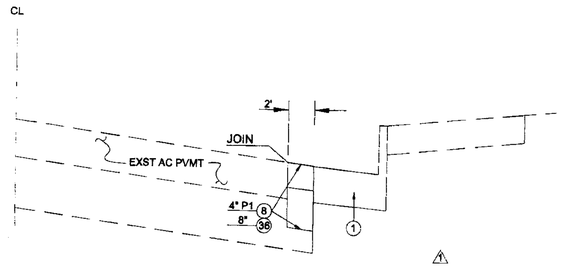

TYPICAL CURB AND GUTTER CONSTRUCTION DETAIL
NO SCALE

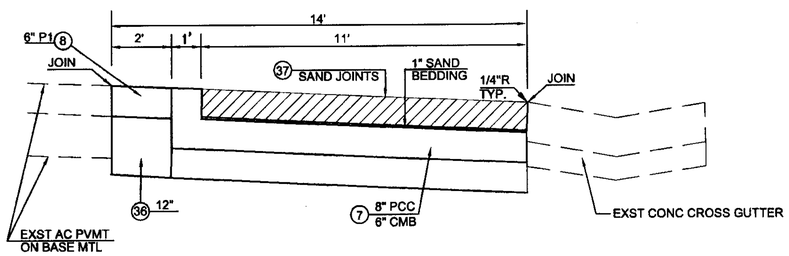

SECTION F-F

TYPICAL LONGITUDINAL DECORATIVE CROSSWALK
NO SCALE

AS-BUILT

PH079205

ASHBA 7876
ENGINEERS LIMITED
POST OFFICE BOX 90633
LONG BEACH
CALIFORNIA 90809
(562) 989-9154

DATE	MK	DESCRIPTION
6/17/10	1	ADDED DETAIL

REVISIONS

REGISTERED PROFESSIONAL ENGINEER BARBARA J ASHBA No. 31417 Expires 12-31-10 CIVIL STATE OF CALIFORNIA

PROJECT ENGINEER DATE 2-10-10

COUNTY OF LOS ANGELES DEPARTMENT OF PUBLIC WORKS

FLORENCE AVENUE STREETSCAPE IMPROVEMENTS, PHASE 2

TYPICAL SECTIONS

PROJECT ID NO. RDC0015121

PROJ ID. RDC0015121 | PCA X2101559 | SHEET 2 OF 17

PLAN RD

DRAFTER AN | DESIGNER BA | CHECKER BA | CADD PROJECT FILE NAME 7876-PH2-2-SECTIONS.DWG | REVIEWED BY | DATE

P:\7000-OFFICE\05007876FLR\CAV\WORKING\PHASE 2 ———\7876-PH2-2-SECTIONS.DWG Plot date: 2/10/2010 8:51 AM Plotted by: Robert Mendoza