REVIEWED BY

LACDPW DESIGN DIVISION — DATE 3/11/10

CURB RETURN ELEVATIONS					
CURB #	BCR	1/4 Δ	1/2 Δ	3/4 Δ	ECR
Ⓐ	(156.60TC) (155.99FL)	156.58TC 155.98FL	156.57TC 155.97FL	156.54TC 155.94FL	(156.52TC) (155.92FL)
Ⓑ	(156.51TC) (155.87FL)	156.48TC 155.81FL	156.42TC 155.75FL	156.28TC 155.61FL	(156.21TC) (155.47FL)

PH079216

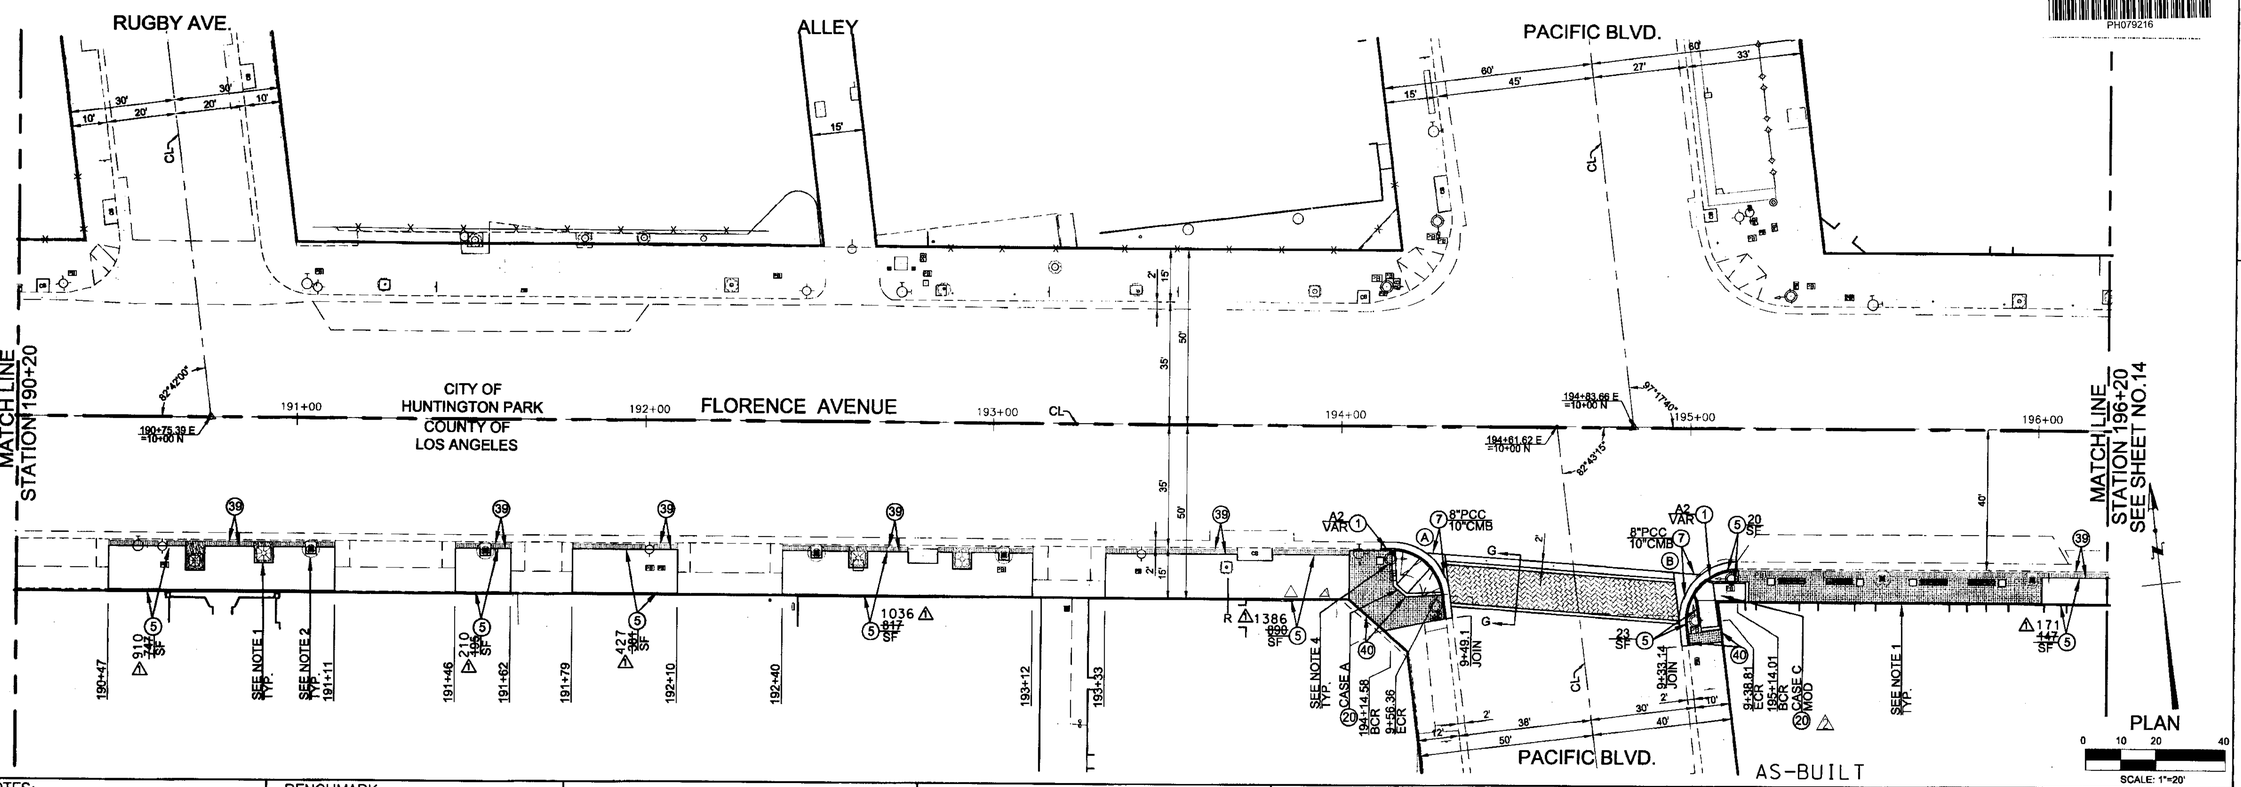

NOTES:
1. SEE PLAN LS FOR LANDSCAPING IMPROVEMENTS.
2. SEE PLAN EE FOR PEDESTRAIN LIGHTING IMPROVEMENTS.
3. SEE PLAN GS FOR SIGN IMPROVEMENTS.
4. SEE PLAN TS FOR TRAFFIC SIGNAL IMPROVEMENTS.
5. SEE PLAN SE FOR STRUCTURAL IMPROVEMENTS FOR GATEWAY SIGNS.
6. PROTECT IN PLACE ALL APPURTENANT DRAINAGE STRUCTURE.
7. SEE SHEET 2 FOR SECTION E-E AND F-F.
8. SEE SHEET 5 FOR SECTION G-G AND H-H.

BENCHMARK
VERT. DATUM=NAVD.88
SO. GATE 2000ADJ.
PT #6 PWLB 1021-6778
FD SQ BR DISK MON @ CL
INT FLORENCE AVE & RUGBY AVE
EL=157.74

ASHBA 7876
ENGINEERS LIMITED
POST OFFICE BOX 90853
LONG BEACH
CALIFORNIA 90809
(562) 989-9184

CURVE DATA						
CURB	RADIUS (FT)	CENTRAL ANGLE DEG.	MIN.	SEC.	LENGTH (FT)	TANGENT (FT)
Ⓐ	15	82	43	15	21.66	13.21
Ⓑ	15	97	16	45	25.47	17.04
Ⓒ						
Ⓓ						

CURVE DATA						
CURB	RADIUS (FT)	CENTRAL ANGLE DEG.	MIN.	SEC.	LENGTH (FT)	TANGENT (FT)
Ⓔ						
Ⓕ						
Ⓖ						
Ⓗ						

FLORENCE AVENUE STREET IMPROVEMENTS - STATION 190+20 TO 196+20

DATE	MK	DESCRIPTION
01/06/2014	2	CURB RAMP MODIFIED BY RMD AFTER CONTRACT COMPLETED PER DWG NO. PH083206
04/02/13	1	AS-BUILT

REVISIONS

REGISTERED PROFESSIONAL ENGINEER — BARBARA J. ASHBA — No. 31417 — Expires 12-31-10 — CIVIL — STATE OF CALIFORNIA

PROJECT ENGINEER — DATE

COUNTY OF LOS ANGELES DEPARTMENT OF PUBLIC WORKS

FLORENCE AVENUE STREETSCAPE IMPROVEMENTS, PHASE 2
CONSTRUCTION PLAN
PROJECT ID NO. RDC0015121

PROJ ID. RDC0015121 | PCA X2101559 | SHEET 13 OF 17

PLAN RD

CADD PROJECT FILE NAME 7876-PH2-12-25 ST IMPRVMENT.DWG
REVIEWED BY — DATE
CHECKER BA
DESIGNER BA
DRAFTER AN

P:\7000-OFFICE\0600\7876FLR\NCA\WORKING\PHASE 2 ——— \7876-PH2-12-25 ST IMPRVMENT.DWG Plot date: 3/10/2010 9:34 AM Plotted by: Al Nozaki