REVIEWED BY
LACDPW DESIGN DIVISION DATE 3/11/10

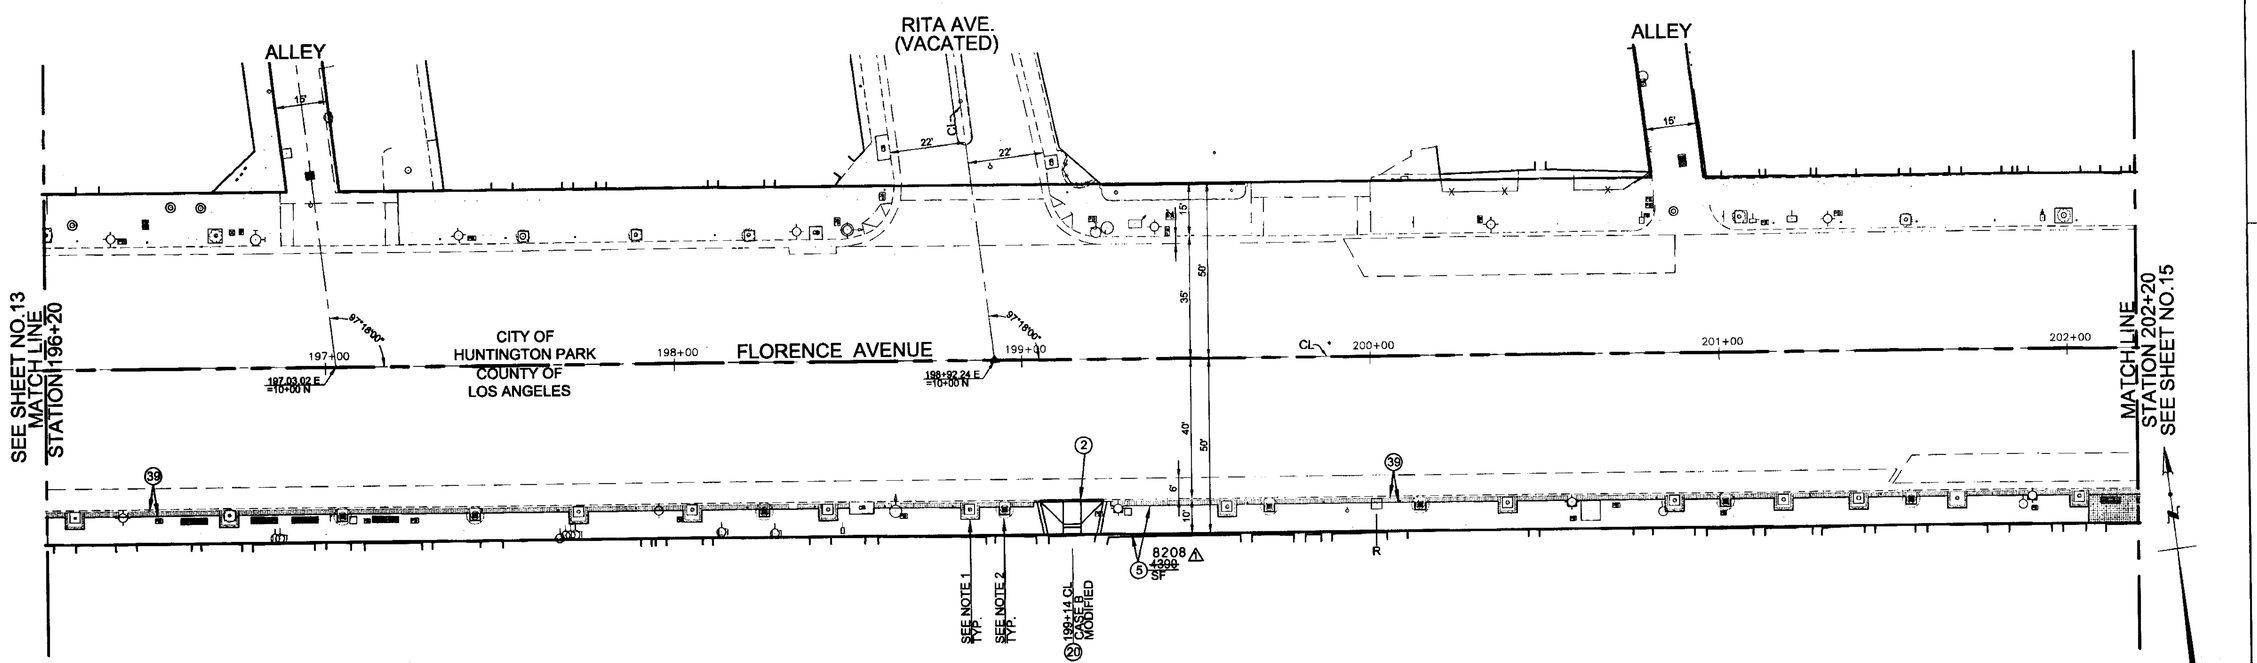

PH079217

AS-BUILT

NOTES:
1. SEE PLAN LS FOR LANDSCAPING IMPROVEMENTS.
2. SEE PLAN EE FOR PEDESTRAIN LIGHTING IMPROVEMENTS.
3. SEE PLAN GS FOR SIGN IMPROVEMENTS.
4. SEE PLAN TS FOR TRAFFIC SIGNAL IMPROVEMENTS.
5. SEE PLAN SE FOR STRUCTURAL IMPROVEMENTS FOR GATEWAY SIGNS.
6. PROTECT IN PLACE ALL APPURTENANT DRAINAGE STRUCTURE.
7. SEE SHEET 2 FOR SECTION E-E AND F-F.
8. SEE SHEET 5 FOR SECTION G-G AND H-H.

BENCHMARK
VERT. DATUM=NAVD.88
SO. GATE 2000ADJ.
PT #97 PWLB 1021-6778
FD BT SPK & DPW W APPARENT INT
FLORENCE AVE &
RITA AVE
EL=156.49

ASHBA 7876
ENGINEERS LIMITED
POST OFFICE BOX 80533
LONG BEACH
CALIFORNIA 90809
(562) 989-9154

CURVE DATA

CURB	RADIUS (FT)	CENTRAL ANGLE DEG.	MIN.	SEC.	LENGTH (FT)	TANGENT (FT)
A						
B						
C						
D						

CURVE DATA

CURB	RADIUS (FT)	CENTRAL ANGLE DEG.	MIN.	SEC.	LENGTH (FT)	TANGENT (FT)
E						
F						
G						
H						

FLORENCE AVENUE STREET IMPROVEMENTS - STATION 196+20 TO 202+20

DATE	MK	DESCRIPTION
04/02/13	1	AS-BUILT

REVISIONS

REGISTERED PROFESSIONAL ENGINEER
BARBARA J. ASHBA
No. 31417
Expires 12-31-10
3/10/14
CIVIL
STATE OF CALIFORNIA

PROJECT ENGINEER DATE

COUNTY OF LOS ANGELES DEPARTMENT OF PUBLIC WORKS

FLORENCE AVENUE STREETSCAPE IMPROVEMENTS, PHASE 2
CONSTRUCTION PLAN
PROJECT ID NO. RDC0015121

PROJ ID. RDC0015121 | PCA X2101559 | SHEET 14 OF 17

PLAN RD

CADD PROJECT FILE NAME 7876-PH2-12-25 ST IMPRVMENT.DWG
REVIEWED BY
DATE
CHECKER BA
DESIGNER BA
DRAFTER AN

P:\7000-OFFICE\0800\7876\FLRNCAV\WORKING\PHASE 2 ——— \7876-PH2-12-25 ST IMPRVMENT.DWG Plot date: 3/10/2010 9:35 AM Plotted by: Al Nozaki