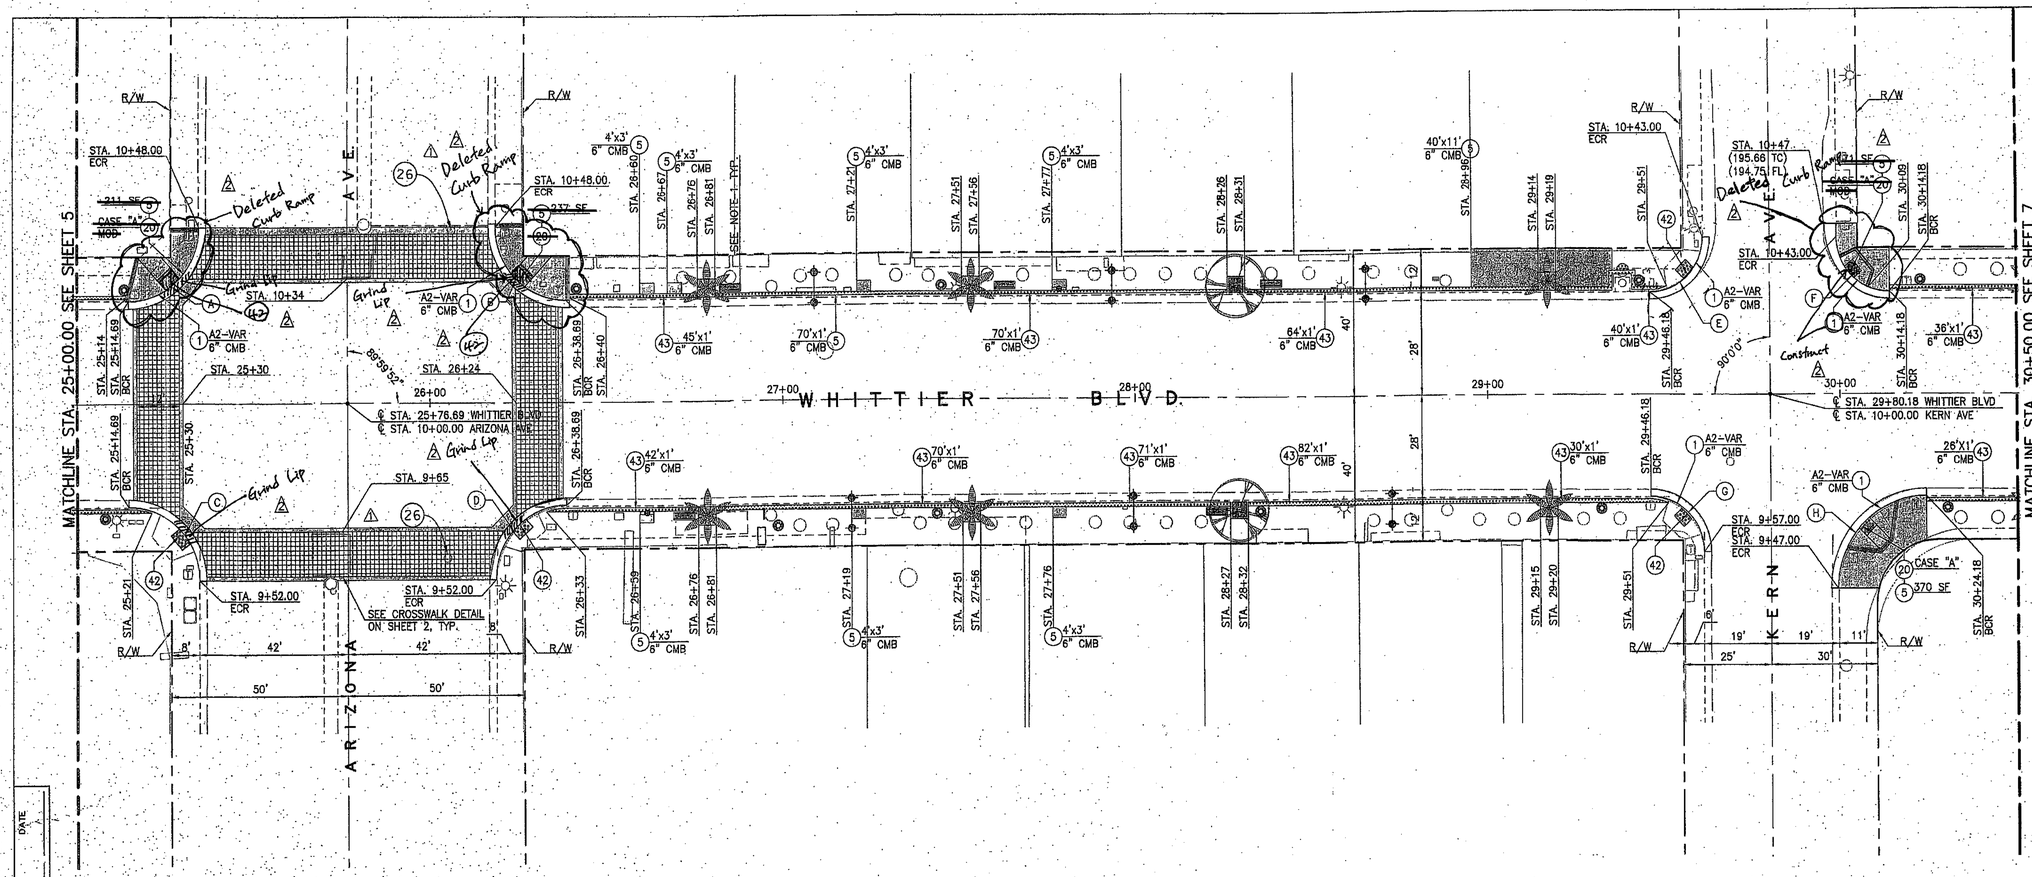

CURB RETURN ELEVATIONS					
	BCR	1/4 Δ	1/2 Δ	3/4 Δ	ECR
A	(196.58 TC) (195.94 FL)	196.67 TC 196.00 FL	196.80 TC 196.13 FL	196.78 TC 196.11 FL	(196.82 TC) (196.09 FL)
B	(197.00 TC) (196.33 FL)	197.08 TC 196.41 FL	197.17 TC 196.50 FL	197.13 TC 196.46 FL	(197.15 TC) (196.41 FL)
C	(196.28 TC) (195.61 FL)	196.30 TC 195.63 FL	196.32 TC 195.65 FL	196.18 TC 195.51 FL	(196.03 TC) (195.36 FL)
D	(196.43 TC) (195.77 FL)	196.47 TC 195.80 FL	196.50 TC 195.83 FL	196.39 TC 195.72 FL	(196.24 TC) (195.58 FL)
E	(195.77 TC) (195.14 FL)	(195.74 TC) 195.18 FL	(195.25 TC) 195.25 FL	(195.88 TC) 195.24 FL	(195.92 TC) (195.23 FL)
F	(195.54 TC) (194.90 FL)	195.68 TC 195.01 FL	195.79 TC 195.12 FL	195.71 TC 195.04 FL	(195.54 TC) (194.90 FL)
G	(195.35 TC) (194.68 FL)	(195.33 TC) 194.66 FL	(194.65 TC) 194.65 FL	(195.19 TC) 195.54 FL	(195.10 TC) (194.44 FL)
H	(195.20 TC) (194.57 FL)	195.17 TC 194.50 FL	195.13 TC 194.46 FL	194.97 TC 194.30 FL	(194.70 TC) (194.12 FL)

CURVE DATA TABLE				
CURVE NO.	LENGTH	RADIUS	DELTA	TANGENT
A	31.42'	20.00'	89°59'52"	20.00
B	31.42'	20.00'	90°00'08"	20.00
C	31.42'	20.00'	90°00'08"	20.00
D	31.42'	20.00'	89°59'52"	20.00
E	23.56'	15.00'	90°00'05"	15.00
F	23.56'	15.00'	90°00'00"	15.00
G	23.56'	15.00'	89°37'00"	14.90
H	39.27'	25.00'	90°00'00"	25.00

PLAN
SCALE: 1" = 20'-0"
0 10' 20' 40'
GRAPHIC SCALE

PH079242

NOTES:

1. SEE PLAN LS FOR LANDSCAPE IMPROVEMENTS

AS BUILT

REVIEWED BY:

LACDPW DESIGN DIVISION — DATE 3/16/10

BENCHMARKS

BM Y11957 PWFB 1223-6082 L&T NEAR CB @ 5' S/O ECR SW COR. OF WHITTIER BL. & ARIZONA AVE. RIVERA 2005 NAVD.88

SURVEYOR'S NOTES:

1. THE BEARING OF N75°37'00"W ALONG THE CENTERLINE OF L&T NEAR MC @ SW COR. OF WHITTIER BLVD. AS PER MAP OF TRACT 4074, M.B. 44-26 WAS TAKEN AS THE BASIS OF BEARINGS FOR THIS SURVEY.
2. ELEVATIONS SHOWN HEREON ARE RELATIVE TO THE COUNTY DATUM. ANY USER OF ELEVATIONS AND/OR COORDINATES SHOWN HEREON FOR THE CONTROL OF CONSTRUCTION, SHALL VERIFY AT LEAST 3 POINTS SHOWN HEREON, FOR MATHEMATICAL CONSISTENCY PRIOR TO SUCH USE.

kpff Consulting Engineers
6080 Center Dr. Suite 700
Los Angeles, California 90045
(310) 665-2800 Fax (310) 665-9075

TWO DAYS BEFORE YOU DIG
CALL USA TOLL FREE
1-800-227-2600

DATE	MK	DESCRIPTION
6/11/13	2	AS-BUILT
6/10/10	1	ADDED (26)

REVISIONS

REGISTERED PROFESSIONAL ENGINEER PATRICIA K. JOANE No. C56740 Exp. 9/30/10 CIVIL STATE OF CALIFORNIA

PROJECT ENGINEER — DATE 3-16-10

COUNTY OF LOS ANGELES DEPARTMENT OF PUBLIC WORKS

WHITTIER BOULEVARD REVITALIZATION PROJECT

PROJECT ID NO. RDC0015166

PCA X2101700 — DWG — SHEET 6 OF 11

PLAN-RD

DRAFTER NAME: JL — DESIGNER NAME: JB — CHECKER NAME: TJ — CADD PROJECT FILE NAME — REVIEWED BY — DATE

PROPOSED FOR CONSTRUCTION: — DATE — ADVERTISED: — DATE — AS BUILT: — DATE