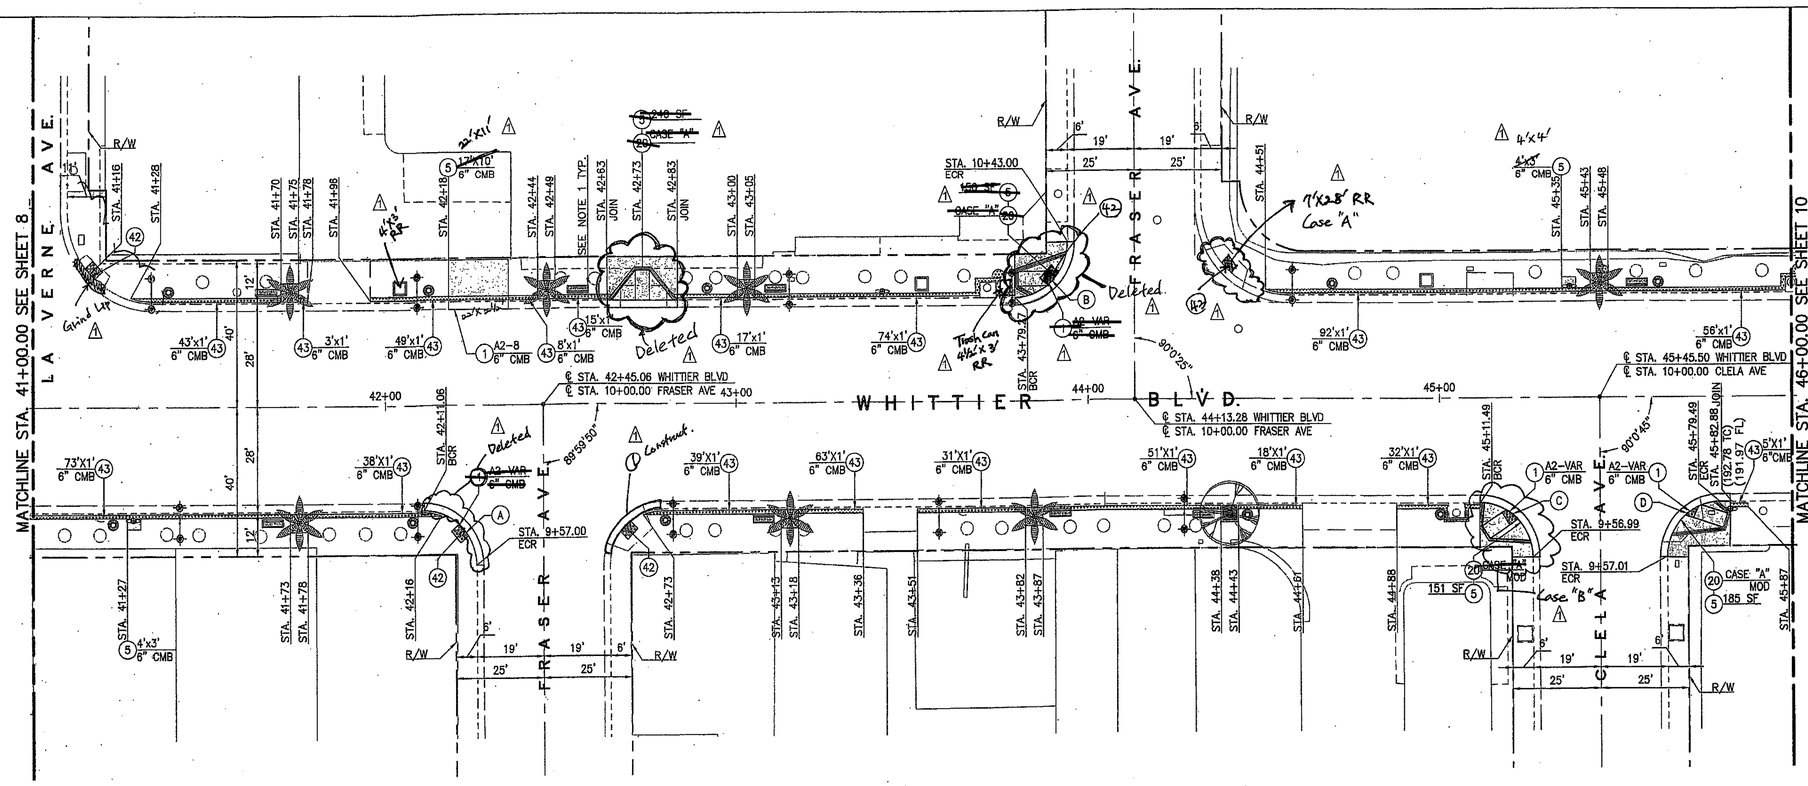

CURB RETURN ELEVATIONS					
	BCR	1/4 Δ	1/2 Δ	3/4 Δ	ECR
A	(193.29 TC) (192.66 FL)	(193.21 TC) 192.67 FL	(192.68 TC) 192.68 FL	(193.24 TC) 192.64 FL	(193.22 TC) (192.59 FL)
B	(193.31 TC) (192.65 FL)	193.53 TC 192.86 FL	193.71 TC 193.04 FL	193.84 TC 193.17 FL	(193.80 TC) (193.33 FL)
C	(192.86 TC) (192.17 FL)	192.94 TC 192.31 FL	192.97 TC 192.38 FL	192.90 TC 192.36 FL	(192.83 TC) (192.34 FL)
D	192.80 TC 192.09 FL	192.76 TC 192.13 FL	192.84 TC 192.24 FL	192.86 TC 192.32 FL	(192.91 TC) (192.38 FL)

CURVE DATA TABLE				
CURVE NO.	LENGTH	RADIUS	DELTA	TANGENT
A	23.56'	15.00'	90°0'10"	15.00
B	23.56'	15.00'	89°59'35"	15.00
C	23.57'	15.00'	90°0'45"	15.00
D	23.56'	15.00'	89°59'15"	15.00

PLAN
SCALE: 1" = 20'-0"
0 10' 20' 40'
GRAPHIC SCALE

PH079245

AS BUILT

NOTES:

1. SEE PLAN LS FOR LANDSCAPE IMPROVEMENTS

REVIEWED BY:

LACDPW DESIGN DIVISION — DATE 3/16/10

BENCHMARKS

BM Y11957 PWFB 1223-6082
L&T NEAR CB @ 5' S/O ECR
SW COR. OF WHITTIER BL. &
ARIZONA AVE.
RIVERA 2005 NAVD.88

SURVEYOR'S NOTES:

1. THE BEARING OF N75°37'00"W ALONG THE CENTERLINE OF L&T NEAR MC @ SW COR. OF WHITTIER BLVD. AS PER MAP OF TRACT 4074, M.B. 44-26 WAS TAKEN AS THE BASIS OF BEARINGS FOR THIS SURVEY.
2. ELEVATIONS SHOWN HEREON ARE RELATIVE TO THE COUNTY DATUM. ANY USER OF ELEVATIONS AND/OR COORDINATES SHOWN HEREON FOR THE CONTROL OF CONSTRUCTION, SHALL VERIFY AT LEAST 3 POINTS SHOWN HEREON, FOR MATHEMATICAL CONSISTENCY PRIOR TO SUCH USE.

kpff Consulting Engineers
6080 Center Dr. Suite 700
Los Angeles, California 90045
(310) 665-2800 Fax (310) 665-9075

TWO DAYS BEFORE YOU DIG
CALL USA TOLL FREE
1-800-227-2600

DATE	MK	DESCRIPTION
6/11/13	1	AS-BUILT

REVISIONS

REGISTERED PROFESSIONAL ENGINEER PATRICIA K. YOUNG No. C048740 Exp. 9/30/10 CIVIL STATE OF CALIFORNIA
PROJECT ENGINEER — DATE 3-16-10

COUNTY OF LOS ANGELES DEPARTMENT OF PUBLIC WORKS

WHITTIER BOULEVARD REVITALIZATION PROJECT

PROJECT ID NO. RDC0015166

PCA X2101700 — DWG — SHEET 9 OF 11

PLAN-RD

PROPOSED FOR CONSTRUCTION: DATE — ADVERTISED: DATE — AS BUILT: DATE

DRAFTER NAME: JL — DESIGNER NAME: JB — CHECKER NAME: TG — CADD PROJECT FILE NAME — REVIEWED BY — DATE