COUNTY OF LOS ANGELES
DEPARTMENT OF PUBLIC WORKS

COLORADO BL

ROSEMEAD BL TO MICHILLINDA AV
MEDIAN MODIFICATION

INDEX

SHEET 1	KEY MAP
SHEET 2	NOTES, REFERENCES, AND DETAILS
SHEET 3	PLAN SHEET AND TYPICAL SECTION
PLAN LS	LANDSCAPING PLANS

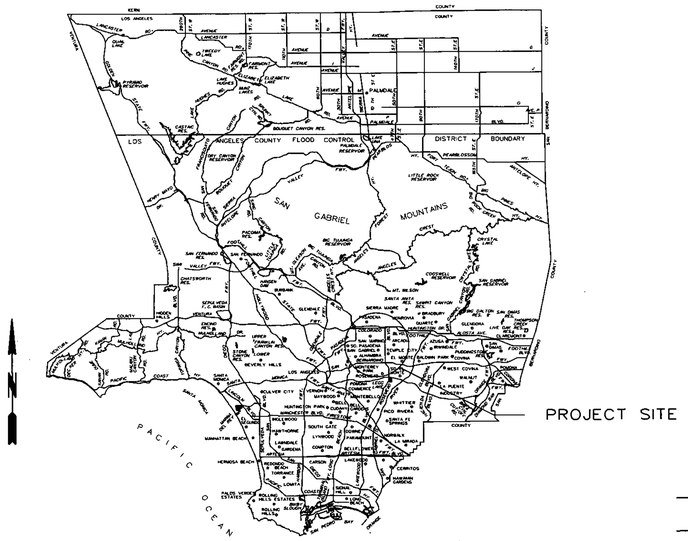

T.G. 566-H4
R.D. 519

LOCATION MAP

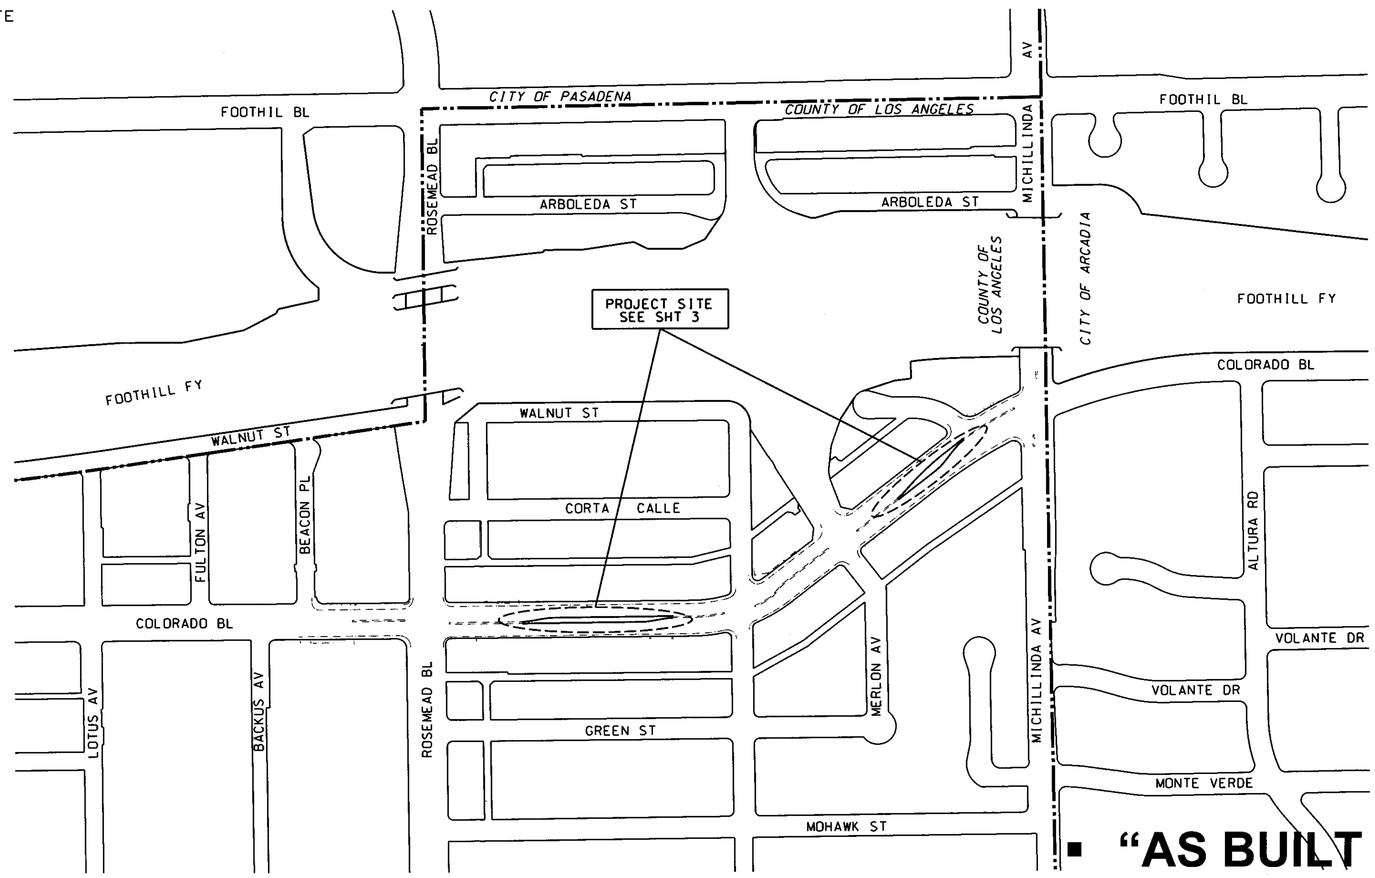

KEY MAP
NOT TO SCALE

PH079249

"AS BUILT DRAWINGS"

PROPOSED FOR CONSTRUCTION: DATE
ADVERTISED: DATE
AS BUILT: DATE

CADD PROJECT FILE NAME RDC0015182.DGN, SHT 1
CHECKER V. LLANA
DESIGNER EM
DRAFTER EM

TWO DAYS BEFORE YOU DIG
CALL USA TOLL FREE
1-800-227-2600

APPROVED CAL FARBER DIRECTOR OF PUBLIC WORKS
BY [signature] DEPUTY DIRECTOR 11-01-2010 DATE
RECOMMENDED
BY [signature] ASSISTANT DEPUTY DIRECTOR 11/1/10 DATE
SUBMITTED
BY Craig Cline HIGHWAY SECTION I 10-12-10 DATE

DATE	DESCRIPTION

REVISIONS

REGISTERED PROFESSIONAL ENGINEER
V. LLANA
NO. C63954
EXP. 09/30/12
CIVIL
STATE OF CALIFORNIA
PROJECT ENGINEER 11/1/10 DATE

COUNTY OF LOS ANGELES DEPARTMENT OF PUBLIC WORKS

COLORADO BL
ROSEMEAD BL TO MICHILLINDA AV
MEDIAN MODIFICATION
TITLE SHEET
PROJECT ID NO. RDC0015182

PCA X2501941 | DWG PH079249 | SHEET 1 OF 3

DATE, $DATE$ TIME, $TIME$ FILE, $FILE$