SCALE: HOR. 1"=20' / VERT. 1"=8'

DOUBLE VERTICAL SCALE

REVIEWED BY: FARHAD AGAHI 12/5/03 DATE
CONSULTANT DESIGN SECTION

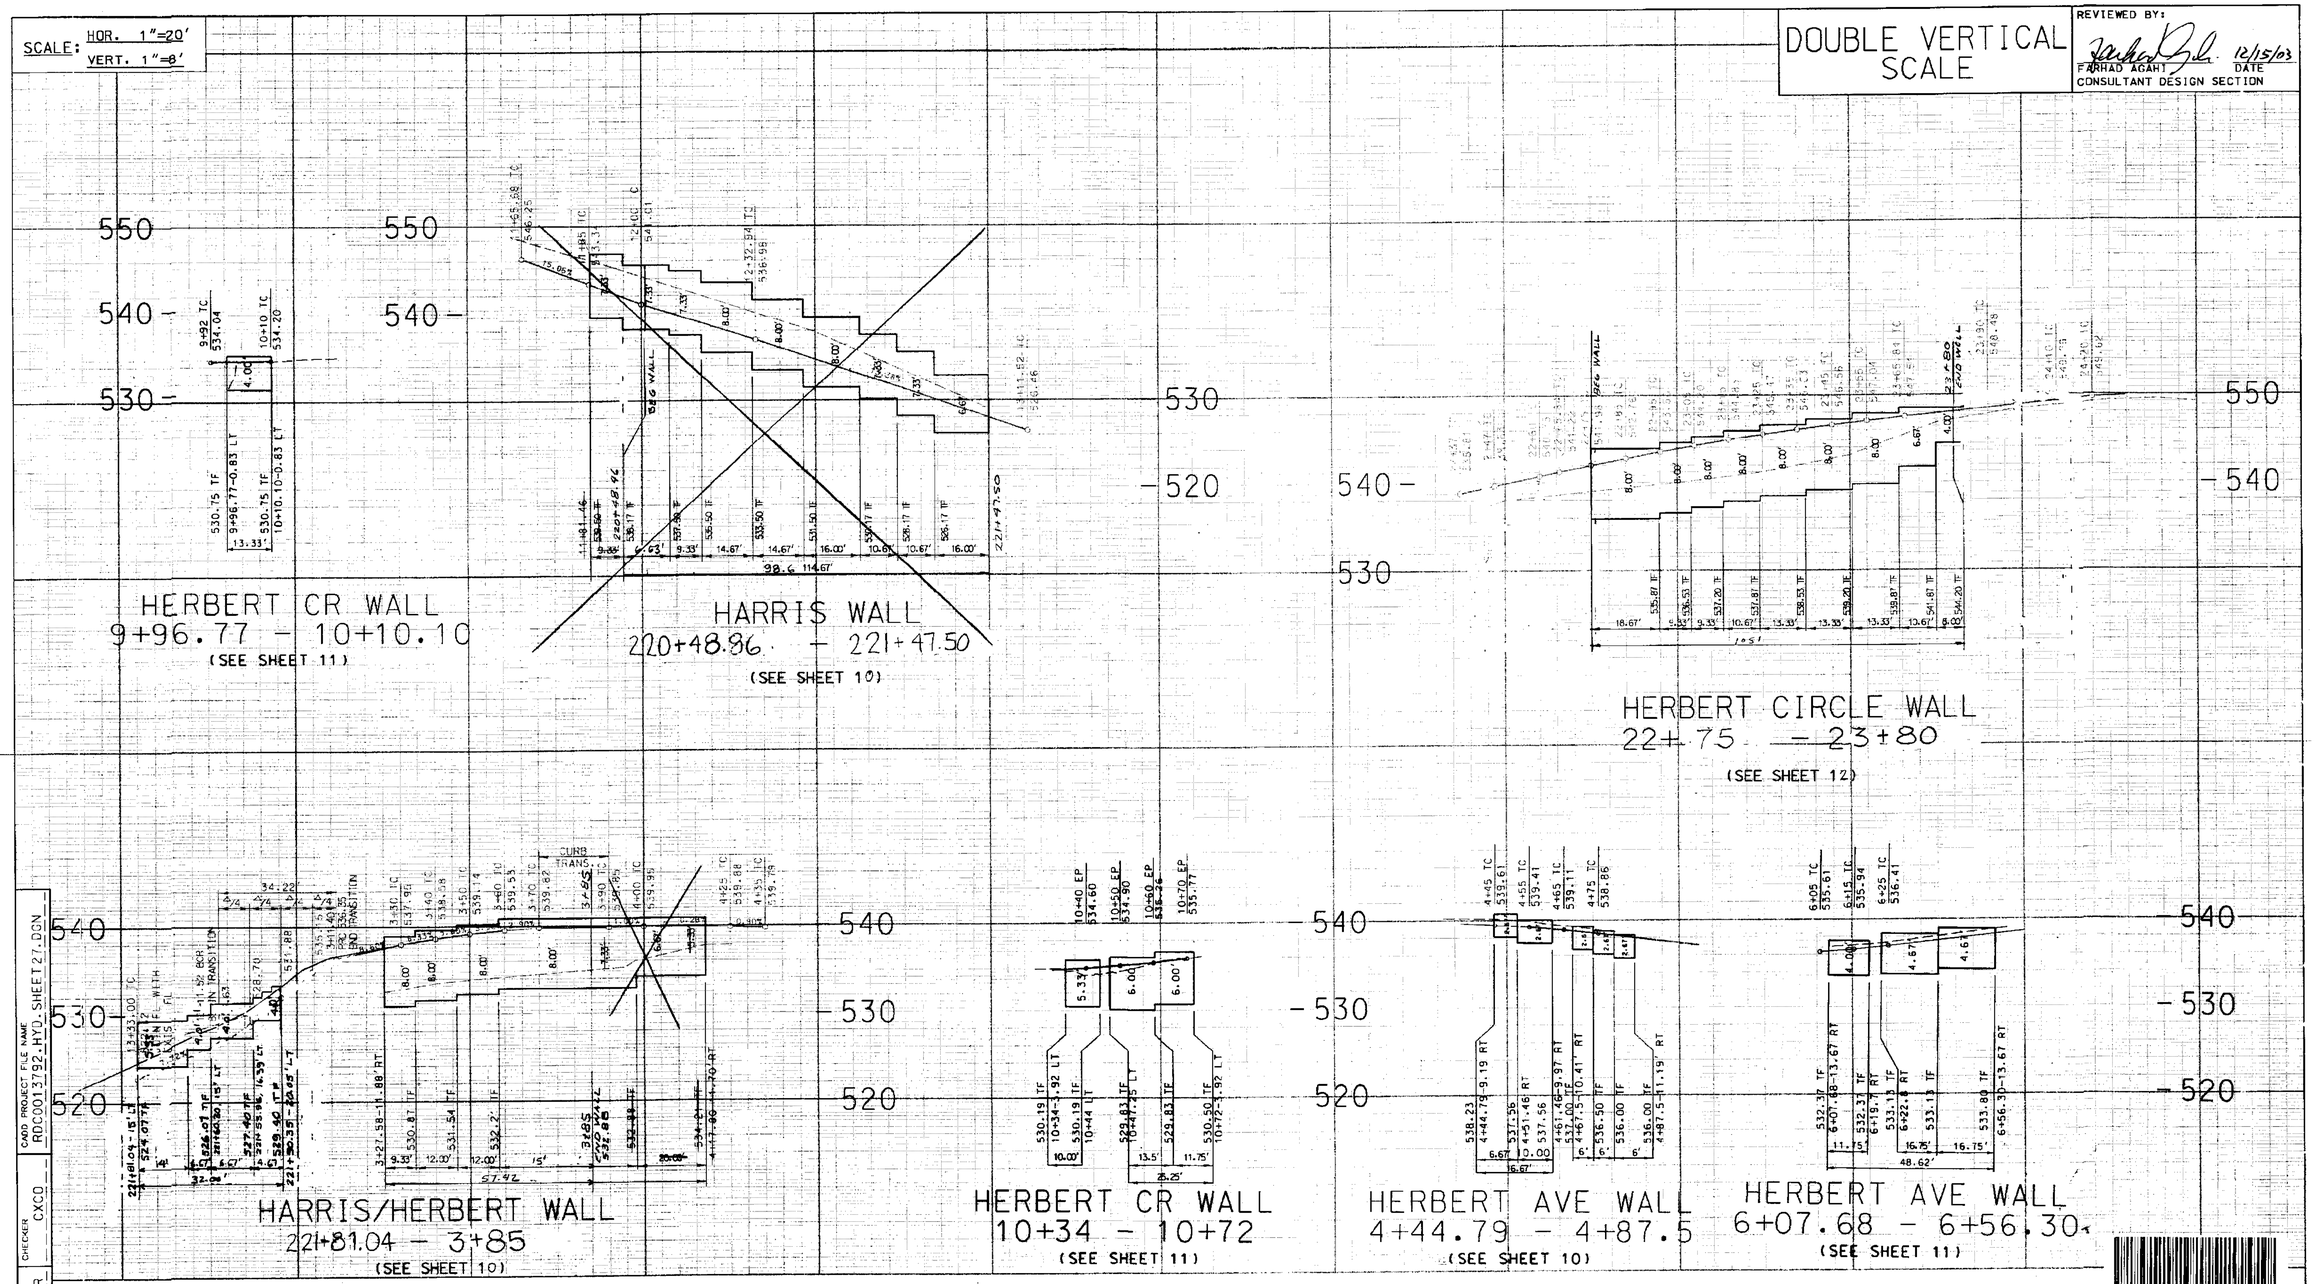

PH079398

CADD PROJECT FILE NAME RDC0013792_HYD_SHEET27.DGN
CHECKER CXCO
DESIGNER MKR/JGR
DRAFTER AAP

PLAN
SCALE: 1" = 20'

DAVID EVANS AND ASSOCIATES INC.
800 North Haven Avenue, Suite 300
Ontario California 91764
Phone: 909.481.5750

TWO DAYS BEFORE YOU DIG
CALL USA TOLL FREE
1-800-227-2600

DATE	MK	DESCRIPTION
8-15-12	■	AS BUILT REVISIONS
8-26-10	M.O.	GENERAL PLAN REVISIONS
6-23-10	M.O.	GENERAL PLAN REVISIONS
10-27-05	△	REVISED TOTAL NO. OF SHEETS

REVISIONS

REGISTERED PROFESSIONAL ENGINEER JEFFREY K. RUPP NO. 42868 EXP. 3/31/2004 CIVIL STATE OF CALIFORNIA
PROJECT ENGINEER 12-12-03 DATE

COUNTY OF LOS ANGELES DEPARTMENT OF PUBLIC WORKS

HARRIS AVENUE, ET AL.

WALL SECTIONS

PROJECT ID NO. RDC0013687 △

PCA | DWG PH079398 | SHEET 16 OF 16

AS BUILT DRAWINGS