SCALE: HOR. 1"= 20'
VERT. 1"= 4'

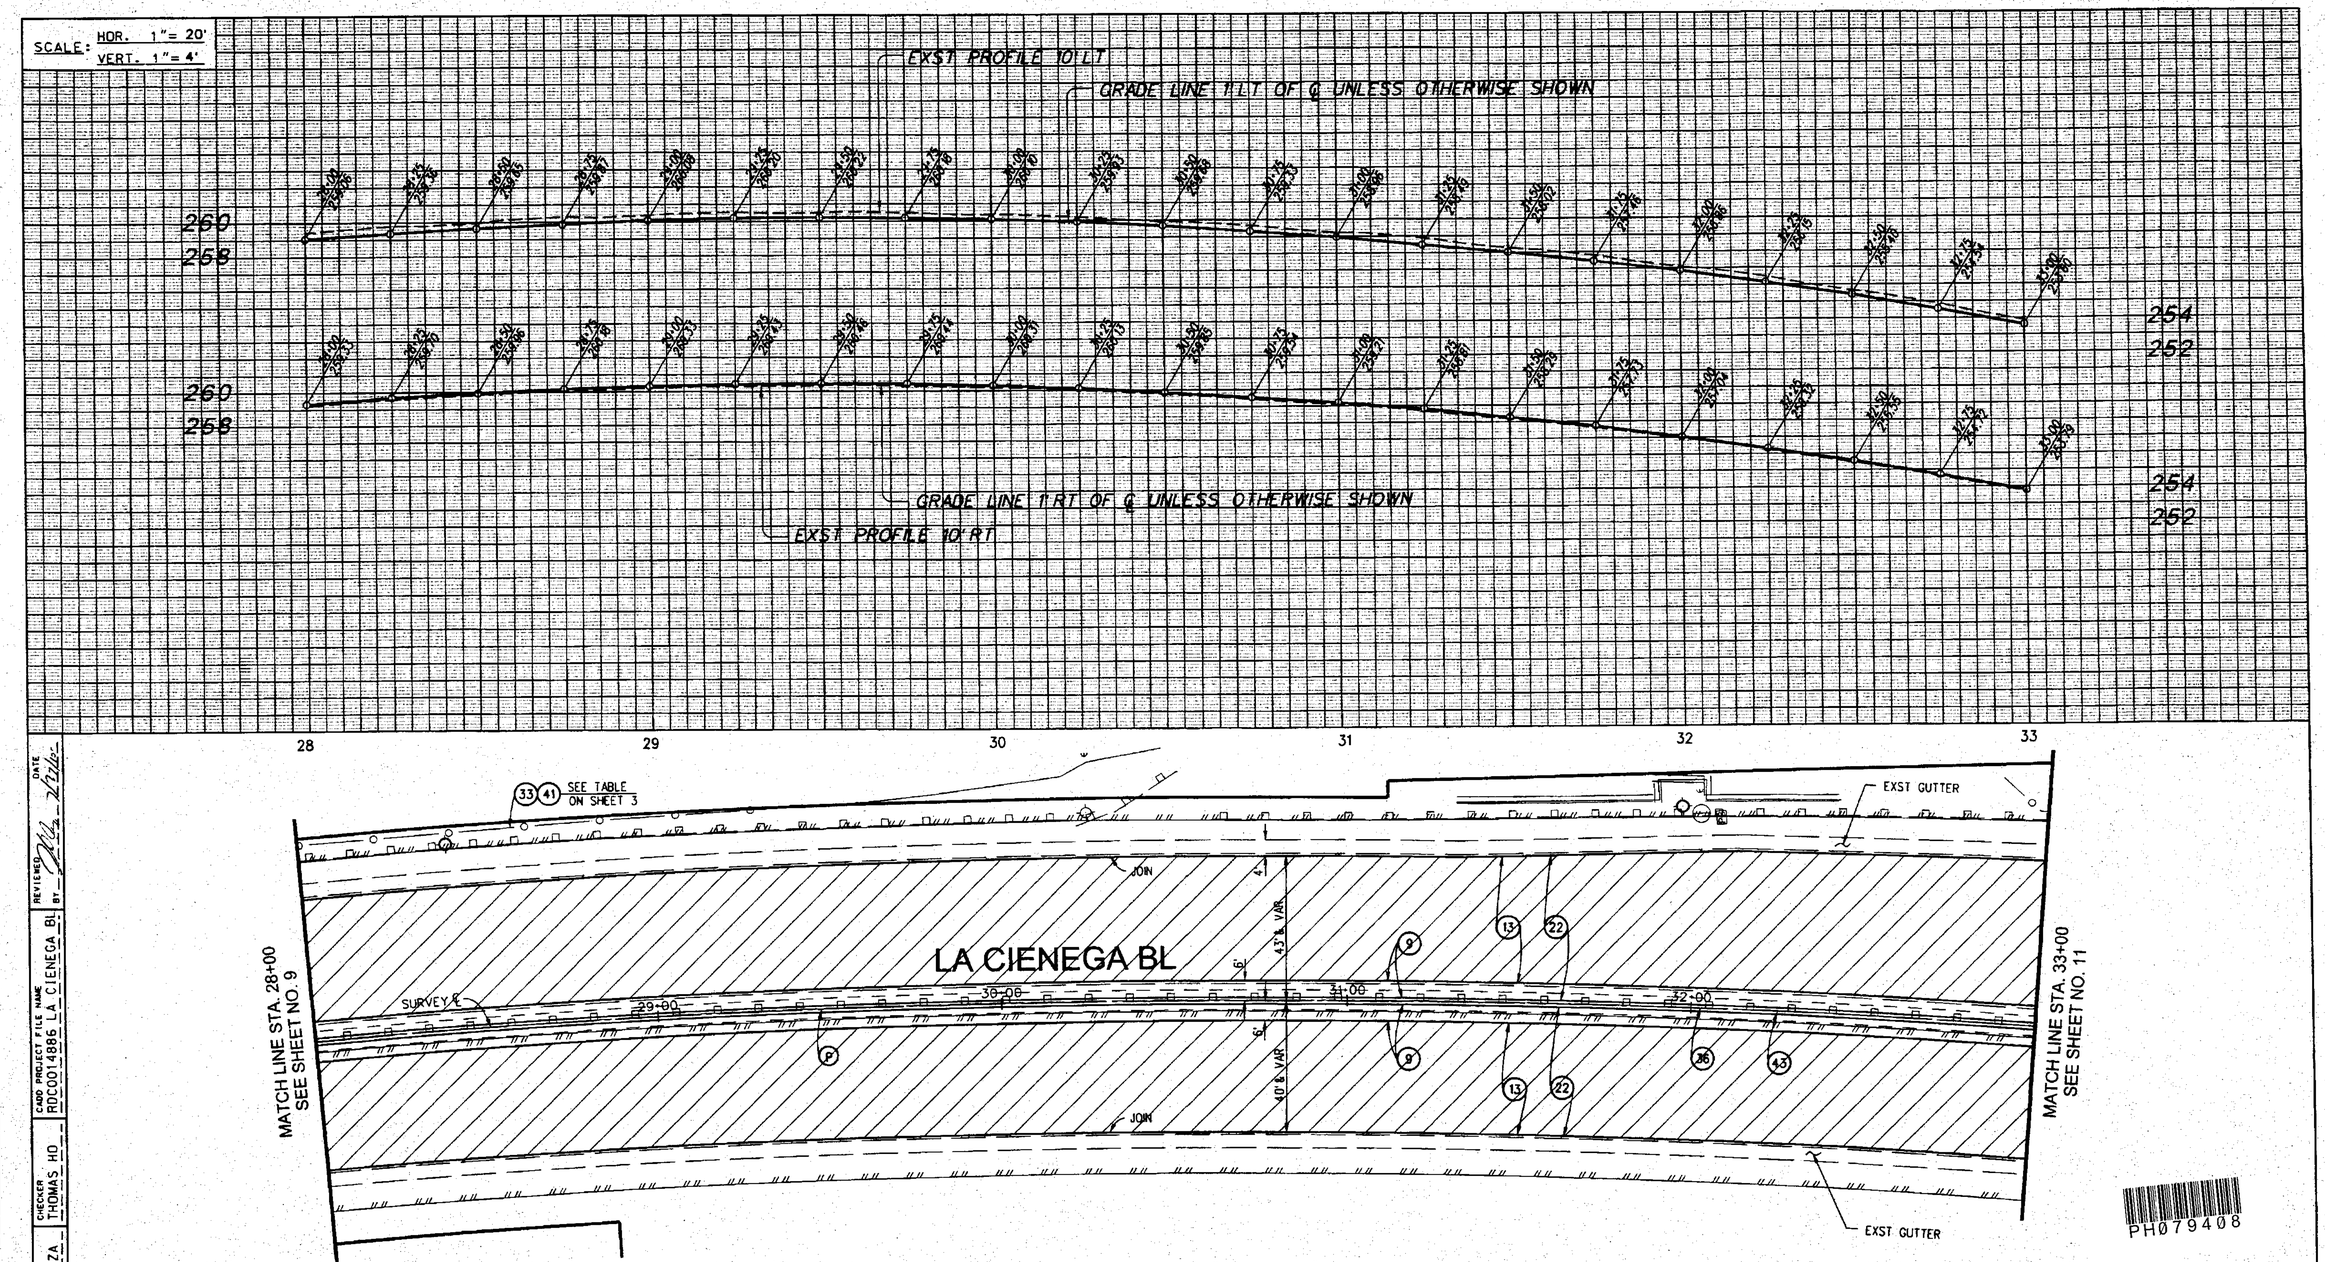

DRAFTER	DESIGNER	CHECKER	CADD PROJECT FILE NAME	REVIEWED BY	DATE
S. BARBOZA	S. BARBOZA	THOMAS HO	RDC0014886 LA CIENEGA BL		

PLAN
SCALE: 1" = 20'
10 0 25 50

BENCH MARK

BM Y5192
PWLB 1017 PAGE 840
EL 144.432 NAVD 88
CULVER 2005
WIRE SPK IN W CB OF 1.5M (5FT) N/o BCR @
NW COR 64TH ST. & LA CIENEGA BLVD.
(SERV RD. W)

CURVE DATA

CURVE	RADIUS FT.	CENTRAL ANGLE DEG.	MIN.	SEC.	LENGTH FT.	TANGENT FT.
(P)	3062.38	22	38	34	1210.22	613.11

DATE	BY	REVISIONS
1/10/11	SB	REVISED SHEET "10 OF 19" TO "10 OF 20"
1/10/11	SB	REVISED "PH078949" TO "PH079408"
2/2/11	SB	CORRECTED TYPO IN BENCH MARK BOX
DATE	BY	

REGISTERED PROFESSIONAL ENGINEER
THOMAS HO
No. C60649
Exp. 12/31/10
CIVIL
STATE OF CALIFORNIA
PROJECT ENGINEER DATE

COUNTY OF LOS ANGELES DEPARTMENT OF PUBLIC WORKS

LA CIENEGA BOULEVARD
STOCKER ST TO 1,680' S/o SLAUSON AVE
PLAN & PROFILE

PROJECT ID NO. RDC0014886

PCA X2201553	DWG PH079408	SHEET 10 OF 20

"AS BUILT DRAWINGS"