SCALE: HOR. 1"= 20'
VERT. 1"= 4'

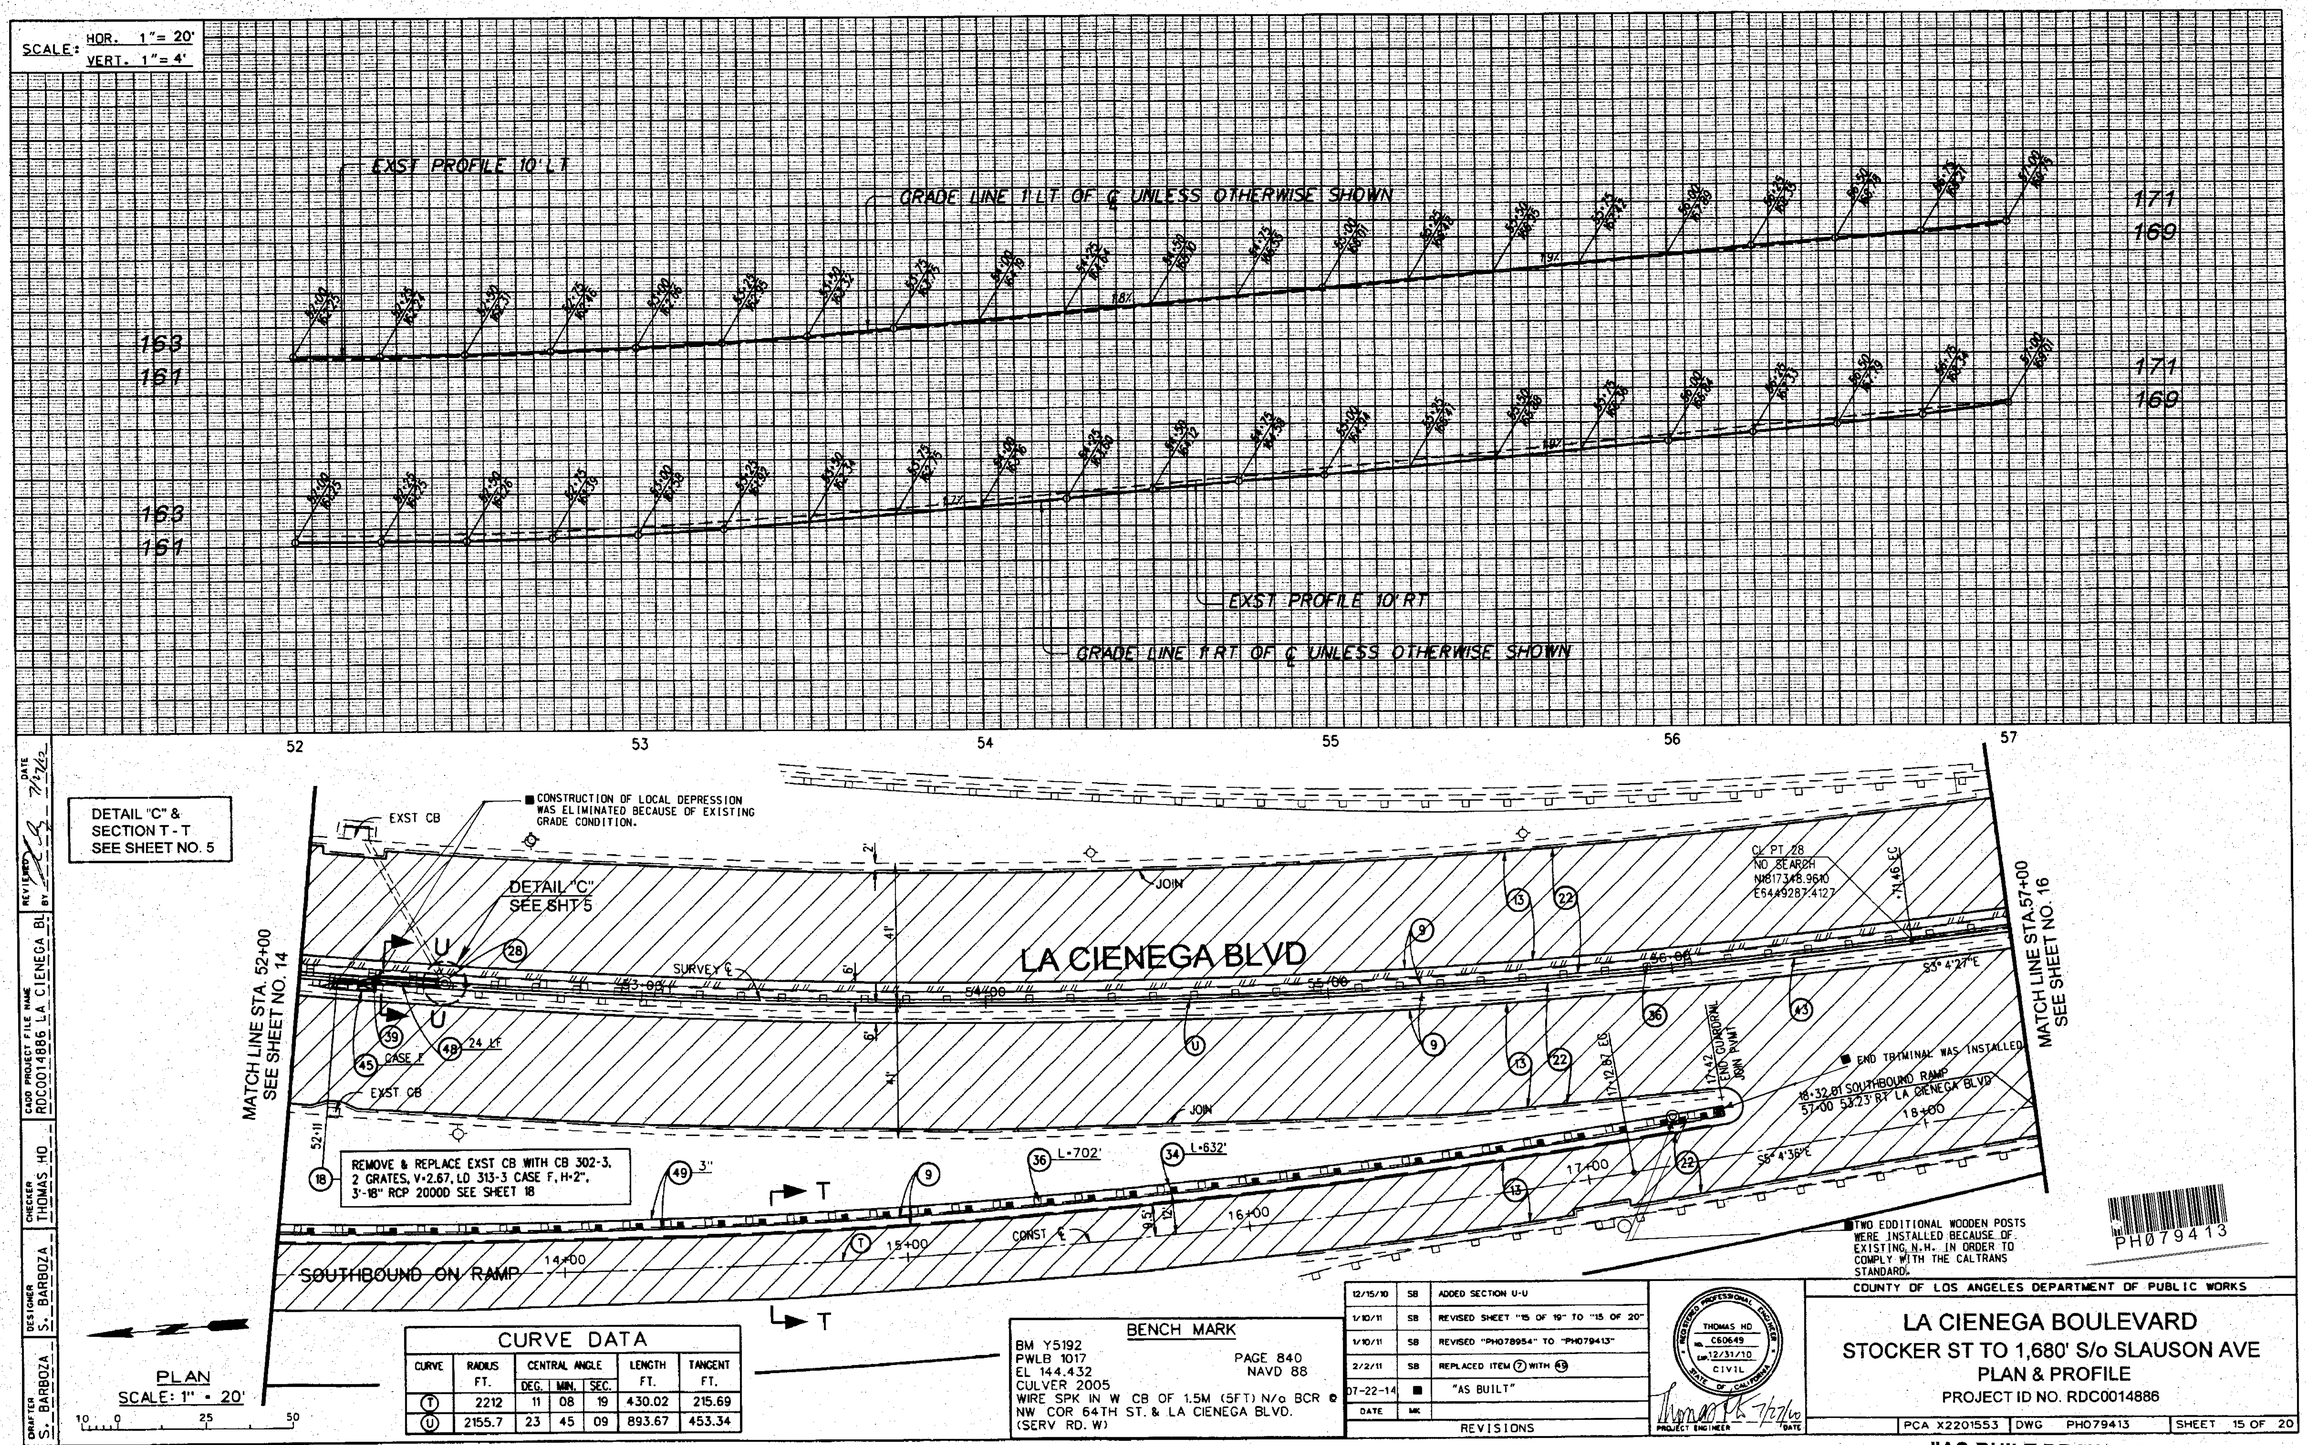

PLAN
SCALE: 1" = 20'

CURVE DATA						
CURVE	RADIUS FT.	CENTRAL ANGLE DEG.	MIN.	SEC.	LENGTH FT.	TANGENT FT.
T	2212	11	08	19	430.02	215.69
U	2155.7	23	45	09	893.67	453.34

BENCH MARK

BM Y5192
PWLB 1017 PAGE 840
EL 144.432 NAVD 88
CULVER 2005
WIRE SPK IN W CB OF 1.5M (5FT) N/o BCR ℄ NW COR 64TH ST. & LA CIENEGA BLVD. (SERV RD. W)

DATE	BY	REVISIONS
12/15/10	SB	ADDED SECTION U-U
1/10/11	SB	REVISED SHEET "15 OF 19" TO "15 OF 20"
1/10/11	SB	REVISED "PH078954" TO "PH079413"
2/2/11	SB	REPLACED ITEM 7 WITH 49
07-22-14	■	"AS BUILT"

REGISTERED PROFESSIONAL ENGINEER — THOMAS HO — No. C60649 — EXP. 12/31/10 — CIVIL — STATE OF CALIFORNIA
PROJECT ENGINEER — DATE 7/22/10

COUNTY OF LOS ANGELES DEPARTMENT OF PUBLIC WORKS

LA CIENEGA BOULEVARD
STOCKER ST TO 1,680' S/o SLAUSON AVE
PLAN & PROFILE
PROJECT ID NO. RDC0014886

PCA X2201553 | DWG PH079413 | SHEET 15 OF 20

"AS BUILT DRAWINGS'

DRAFTER S. BARBOZA | DESIGNER S. BARBOZA | CHECKER THOMAS HO | CADD PROJECT FILE NAME RDC0014886 LA CIENEGA BL | REVISED BY | DATE 7/22/10