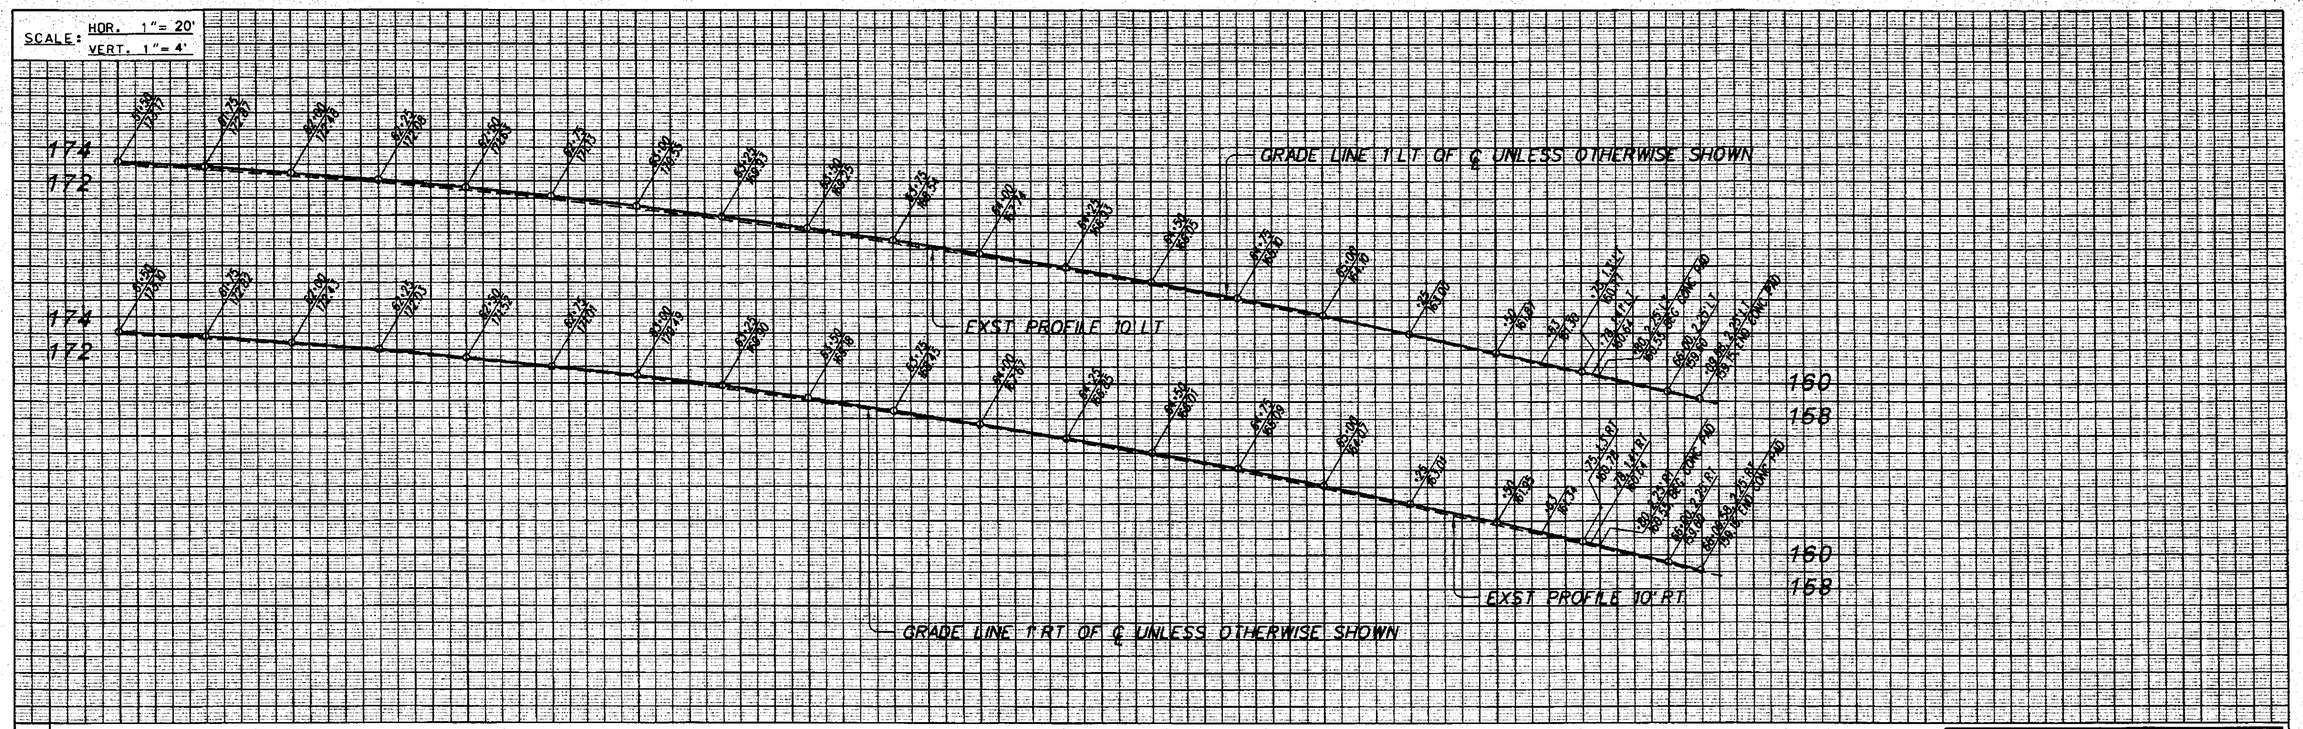

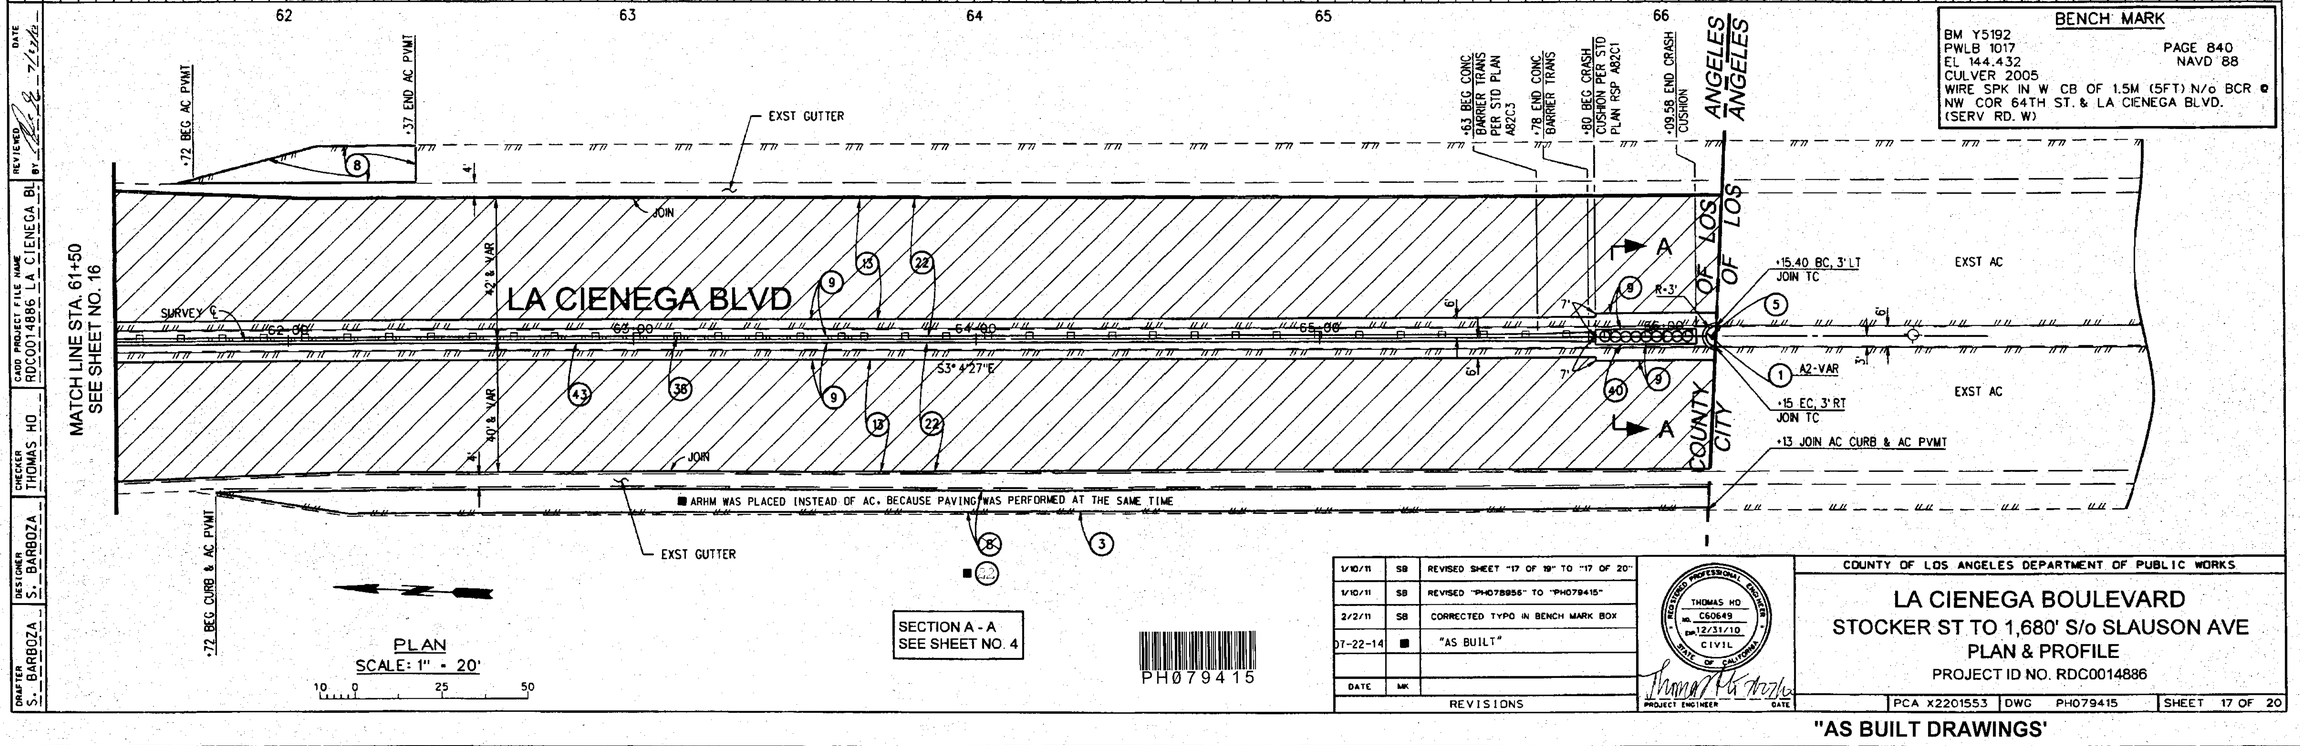

BENCH MARK

BM Y5192
PWLB 1017 PAGE 840
EL 144.432 NAVD 88
CULVER 2005
WIRE SPK IN W CB OF 1.5M (5FT) N/o BCR @ NW COR 64TH ST. & LA CIENEGA BLVD. (SERV RD. W)

DATE	MK	REVISIONS
1/10/11	SB	REVISED SHEET "17 OF 19" TO "17 OF 20"
1/10/11	SB	REVISED "PH078956" TO "PH079415"
2/2/11	SB	CORRECTED TYPO IN BENCH MARK BOX
07-22-14	■	"AS BUILT"

REGISTERED PROFESSIONAL ENGINEER — THOMAS HO — NO. C60649 — EXP. 12/31/10 — CIVIL — STATE OF CALIFORNIA

PROJECT ENGINEER — DATE

COUNTY OF LOS ANGELES DEPARTMENT OF PUBLIC WORKS

LA CIENEGA BOULEVARD
STOCKER ST TO 1,680' S/o SLAUSON AVE
PLAN & PROFILE

PROJECT ID NO. RDC0014886

PCA X2201553 | DWG PH079415 | SHEET 17 OF 20

DRAFTER S. BARBOZA | DESIGNER S. BARBOZA | CHECKER THOMAS HO | CADD PROJECT FILE NAME RDC0014886 LA CIENEGA BL | REVIEWED BY | DATE

"AS BUILT DRAWINGS"