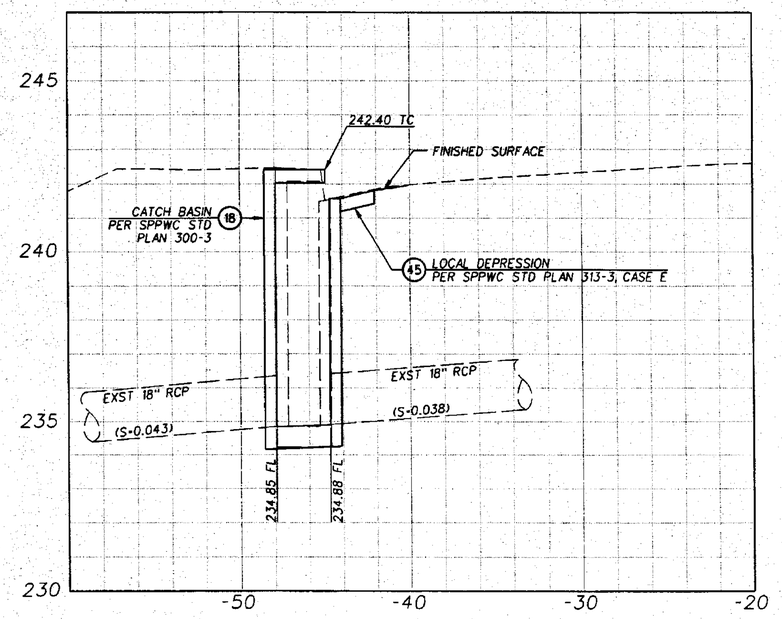

DRAINAGE PROFILE
STA 19+58
HOR 1"=4'
VER 1"=2'

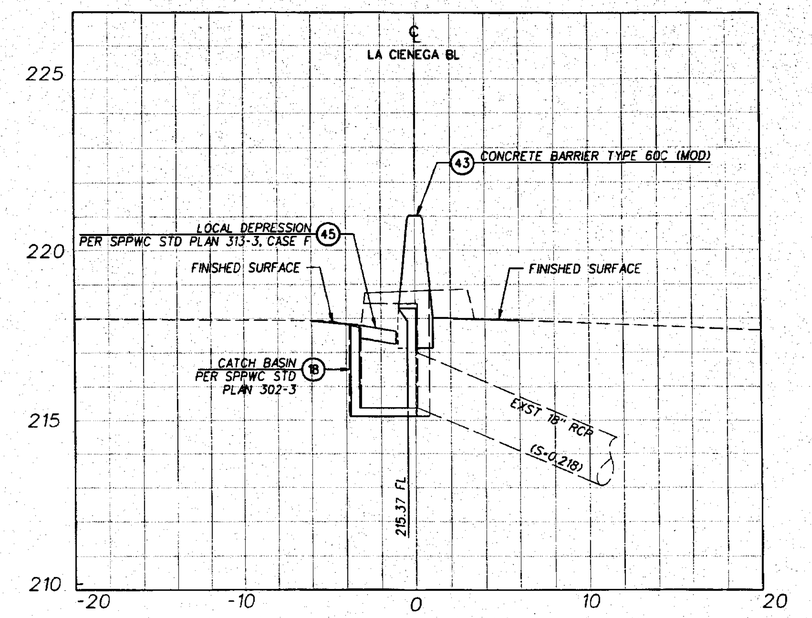

DRAINAGE PROFILE
STA 39+31
HOR 1"=4'
VER 1"=2'

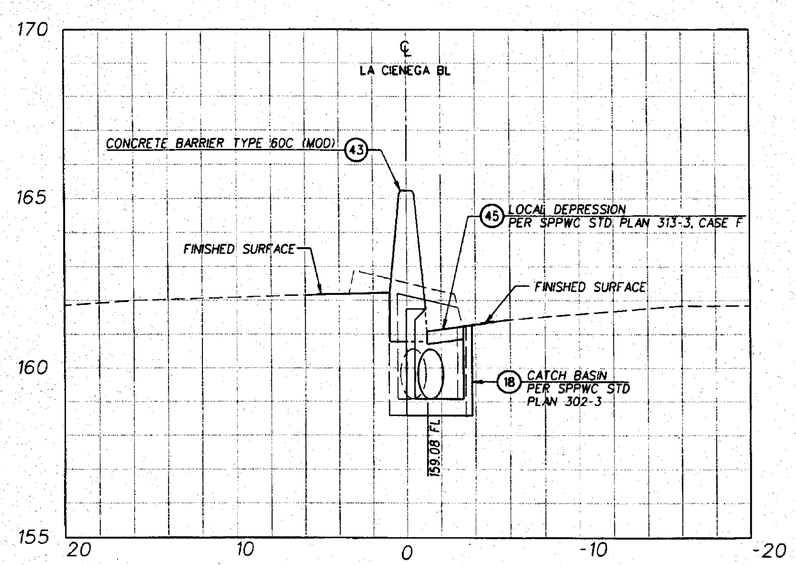

DRAINAGE PROFILE
STA 52+11
HOR 1"=4'
VER 1"=2'

PH079417

DATE	MK	DESCRIPTION
1/10/11	SB	REVISED SHEET "18 OF 19" TO "19 OF 20"
1/10/11	SB	REVISED "PH078957" TO "PH079417"

REVISIONS

REGISTERED PROFESSIONAL ENGINEER THOMAS HO NO. C60649 EXP. 12/31/10 CIVIL STATE OF CALIFORNIA

PROJECT ENGINEER 7/27/10 DATE

COUNTY OF LOS ANGELES DEPARTMENT OF PUBLIC WORKS

LA CIENEGA BOULEVARD
STOCKER ST TO 1,680' S/o SLAUSON AVE
DRAINAGE PROFILE
PROJECT ID NO. RDC0014886

PCA X2201553 | DWG PH079417 | SHEET 19 OF 20

"AS BUILT DRAWINGS"

DRAFTER S. BARBOZA | DESIGNER S. BARBOZA | CHECKER THOMAS HO | CADD PROJECT FILE NAME RDC0014886 LA CIENEGA BL | REVIEWED BY | DATE