COUNTY OF LOS ANGELES
DEPARTMENT OF PUBLIC WORKS

COYOTE CREEK ACCESS ROADS
AT
226TH ST

TOTAL LENGTH 0.07 MILES

INDEX

SHEET NO. 1	TITLE SHEET
SHEET NO. 2	NOTES AND REFERENCES
SHEET NO. 3	EAST SIDE TYPICAL SECTION
SHEET NO. 4	WEST SIDE TYPICAL SECTION
SHEET NO. 5	EAST ACCESS ROAD
SHEET NO. 6	WEST ACCESS ROAD

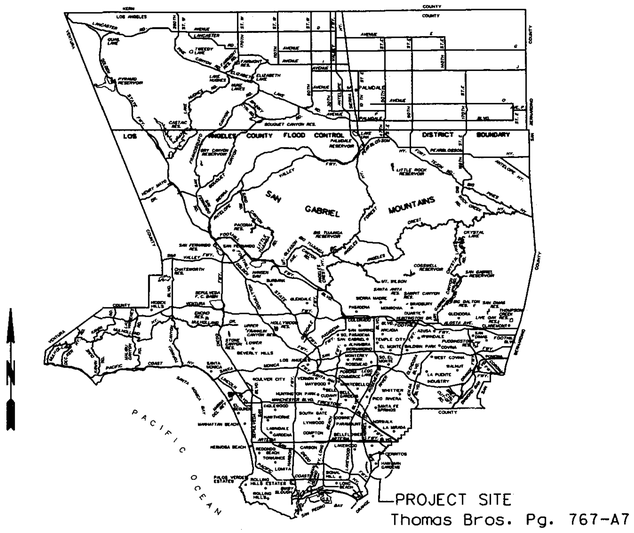

LOCATION MAP
NO SCALE

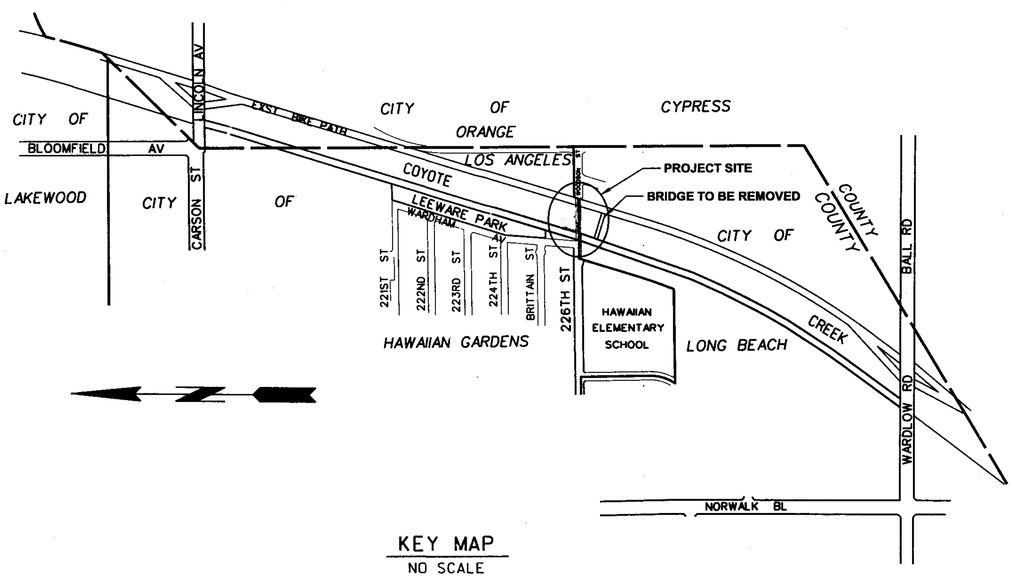

KEY MAP
NO SCALE

AS BUILT

Date: 2/15/2012 Corrections by: T.M.

Resident Engineer: Shadab Jimmy

NO CHANGES

PH079515

PLAN RD

DRAFTER	T. MOHAMED
DESIGNER	T. MOHAMED
CHECKER	B. FATHOLLAHI
CADD DRAWING NUMBER	RDC0015507

APPROVED BY Ismile H. Noorbaksh 5/17/11 CITY OF HAWAIIAN GARDENS CITY ENGINEER DATE

APPROVED BY [signature] 4/13/11 CITY OF LONG BEACH DATE

TWO DAYS BEFORE YOU DIG CALL USA TOLL FREE 1·800·227·2600

APPROVED GAIL FARBER, DIRECTOR OF PUBLIC WORKS BY Patrick V. DeChellis 5-04-2011 DEPUTY DIRECTOR DATE

RECOMMENDED BY [signature] 4-4-11 ASSISTANT DEPUTY DIRECTOR DATE

SUBMITTED BY Craig Cline 4-4-11 HIGHWAY DESIGN SECTION II DATE

DATE	MK	DESCRIPTION

REVISIONS

REGISTERED PROFESSIONAL ENGINEER TAREK MOHAMED No. C 74171 EXP. 6-30-11 CIVIL STATE OF CALIFORNIA

[signature] 4/4/11 PROJECT ENGINEER DATE

COUNTY OF LOS ANGELES DEPARTMENT OF PUBLIC WORKS

COYOTE CREEK ACCESS ROADS
AT
226TH ST
TITLE SHEET
PROJECT ID NO. RDC0015507

JOB X7402037 | DWG PH079515 | SHEET 1 OF 6