COUNTY OF LOS ANGELES
DEPARTMENT OF PUBLIC WORKS

CALIFORNIA BOULEVARD, ET AL.

TOTAL LENGTH = 2.11 MILES

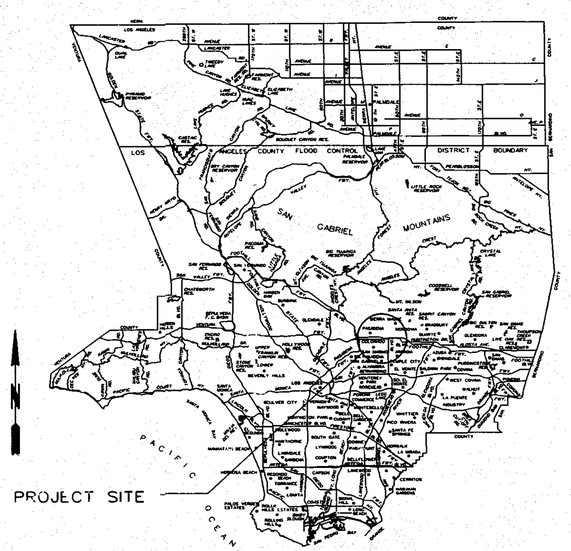

LOCATION MAP

INDEX OF SHEETS

SHEET NO. 1	TITLE SHEET
SHEET NO. 2	CONSTRUCTION NOTES AND REFERENCES
SHEET NO. 3-4	TYPICAL SECTIONS
SHEET NO. 5-6	CALIFORNIA BLVD - DETAILS
SHEET NO. 7	NEW YORK DR - PLAN
SHEET NO. 8-9	ALTADENA DR - PLAN
SHEET NO. 10-12	SAN GABRIEL BLVD - PLAN & PROFILE
SHEET NO. 13	SAN GABRIEL BLVD - DRAINAGE PLAN & PROFILE
2 1 ~~PLAN SL~~	~~STREET LIGHTING PLANS~~
PLAN SP	SIGNING AND STRIPING PLANS
PLAN TC	TRAFFIC CONTROL PLANS
PLAN TS	TRAFFIC SIGNAL PLANS

NOTES

1. SEE SHEET 5 & 6 FOR TYPICAL JOIN DETAILS AT SIDE STREETS FOR CALIFORNIA BLVD.

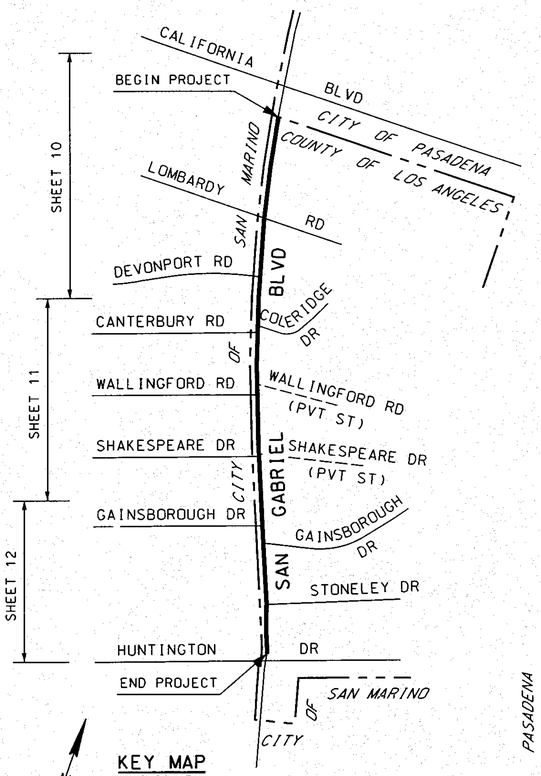

KEY MAP
NO SCALE
T. G. 566 F6-7
R. D. 519

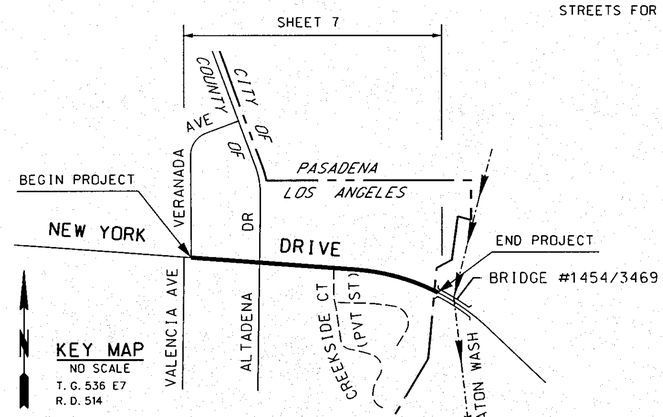

KEY MAP
NO SCALE
T. G. 536 E7
R. D. 514

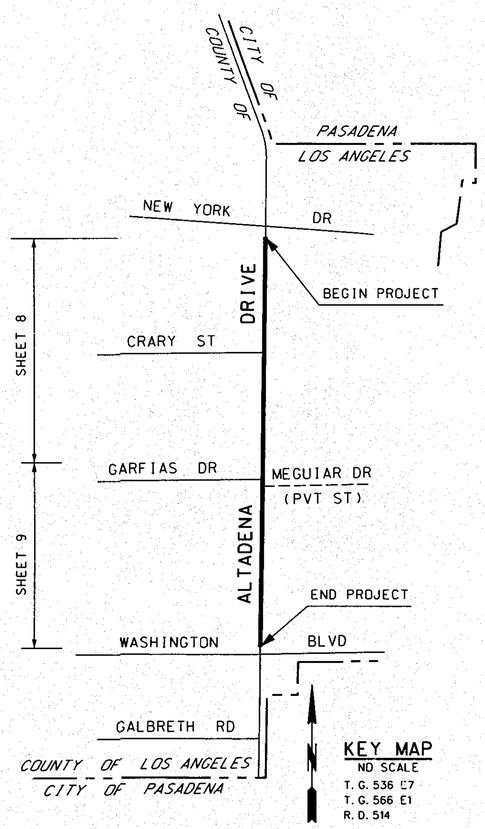

KEY MAP
NO SCALE
T. G. 536 E7
T. G. 566 E1
R. D. 514

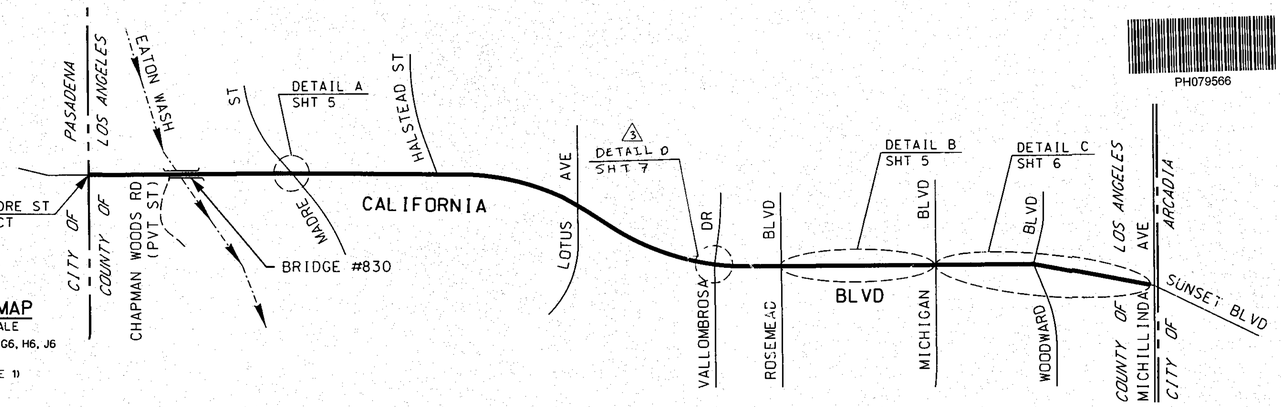

KEY MAP
NO SCALE
T. G. 566 G6, H6, J6
R. D. 519
(SEE NOTE 1)

AS BUILT

10/25/12	3	AS-BUILT
4/7/11	2	DELETED PLAN SL
3/2/11	1	ADDED PLAN SL
DATE	MK	DESCRIPTION

REVISIONS

TWO DAYS BEFORE YOU DIG
CALL USA TOLL FREE
1-800-227-2600

APPROVED GAIL FARBER DIRECTOR OF PUBLIC WORKS
BY Patrick J. McChillis (DEPUTY DIRECTOR) 1-19-2011 (DATE)

RECOMMENDED
BY (ASSISTANT DEPUTY DIRECTOR) 1/19/2011 (DATE)

SUBMITTED PFR
BY (HIGHWAY SECTION 3) 1/19/2011 (DATE)

APPROVED
BY (CITY OF PASADENA) 3-3-2011 (DATE)

REGISTERED PROFESSIONAL ENGINEER GILBERT TSOI C7747 CIVIL STATE OF CALIFORNIA
PROJECT ENGINEER 1/19/11 DATE

COUNTY OF LOS ANGELES DEPARTMENT OF PUBLIC WORKS

CALIFORNIA BOULEVARD, ET AL.

TITLE SHEET

PROJECT ID NO. RDC0012976

PCA X7500145 | DWG | SHEET 1 OF 13

PLAN RD

PROPOSED FOR CONSTRUCTION: DATE | ADVERTISED DATE | AS BUILT: DATE

CADD PROJECT FILE NAME RDC0012976-PLAN-RD.DGN
CHECKER G. TSOI
DESIGNER J. GARCIA
DRAFTER J. GARCIA

DATE: 01/19/2011 TIME: 7:45:39 AM FILE: C:\Myfiles\Jon1\PROJECTS\RDC0012976-CALIFORNIA Blvd Et Al\CAD\WORKING ON CAD\RDC0012976 PLAN RD.dgn