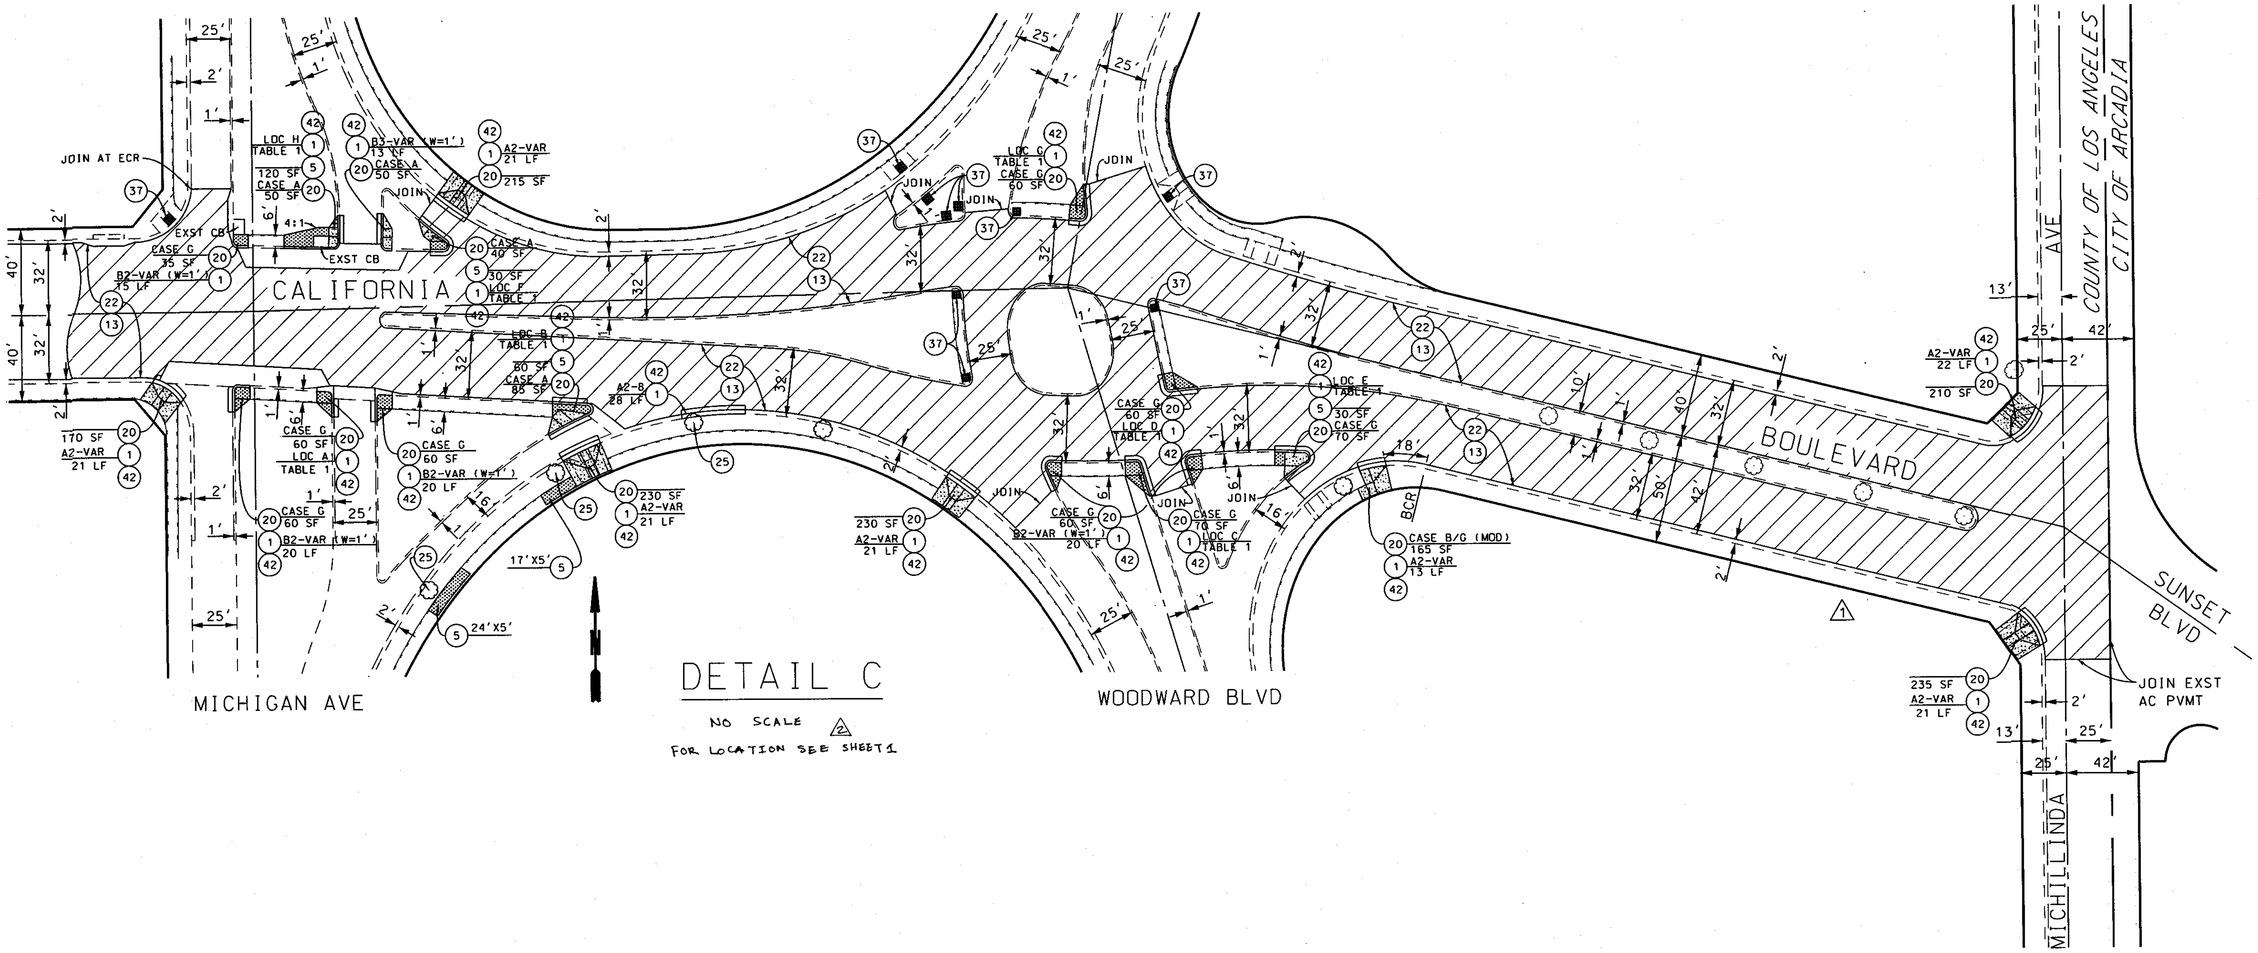

TABLE 1 - CURB AND GUTTER TRANSITIONS				
LOCATION	LENGTH	TRANSITION FROM	TRANSITION TO	CONTRACT BID UNIT
A	20 LF	B2-VAR (W=1')	B3-VAR (W=1')	B2-VAR (W=1')
B	50 LF	B2-VAR (W=1')	B3-VAR (W=1')	B2-VAR (W=1')
C	20 LF	B2-VAR (W=1')	B3-VAR (W=1')	B2-VAR (W=1')
D	20 LF	B2-VAR (W=1')	B3-VAR (W=1')	B2-VAR (W=1')
E	40 LF	B2-VAR (W=1')	B3-VAR (W=1')	B2-VAR (W=1')
F	33 LF	B2-VAR (W=1')	B3-VAR (W=1')	B2-VAR (W=1')
G	20 LF	B2-VAR (W=1')	B3-VAR (W=1')	B2-VAR (W=1')
H	32 LF	B2-VAR (W=1')	B3-VAR (W=1')	B2-VAR (W=1')

CALIFORNIA BOULEVARD		
LOCATION FROM MADRE STREET	(27) NORTH SIDE	(27) SOUTH SIDE
3080' E/O		1
3190' E/O	1	
3310' E/O	1	
3560' E/O	1	
3730' E/O	1	
4010' E/O	1	
ACTUAL LOCATION TO BE VERIFIED BY FIELD ENGINEER		

AS BUILT

DATE	MK	DESCRIPTION
10/23/12	2	AS-BUILT
4/07/11	1	REMOVED PROPOSED LEFT TURN POCKET

REVISIONS

REGISTERED PROFESSIONAL ENGINEER GILBERT TSOI 67747 CIVIL STATE OF CALIFORNIA

PROJECT ENGINEER 1/19/11 DATE

PH079571

COUNTY OF LOS ANGELES DEPARTMENT OF PUBLIC WORKS

CALIFORNIA BOULEVARD, ET AL.

CALIFORNIA BLVD - DETAILS

PROJECT ID NO. RDC0012976

PCA X7500145 | DWG | SHEET 6 OF 13

PLAN RD

DRAFTER J. GARCIA | DESIGNER J. GARCIA | CHECKER G. TSOI | CADD PROJECT FILE NAME RDC0012976-PLAN-RD.DGN | REVIEWED BY

DATE: 04/07/2011 TIME: 1:02:41 PM FILE: C:\MyFiles\Job1\PROJECTS\RDC0012976-CALIFORNIA Blvd Et Al\CAD\WORKING ON CAD\RDC0012976 PLAN RD.dgn