


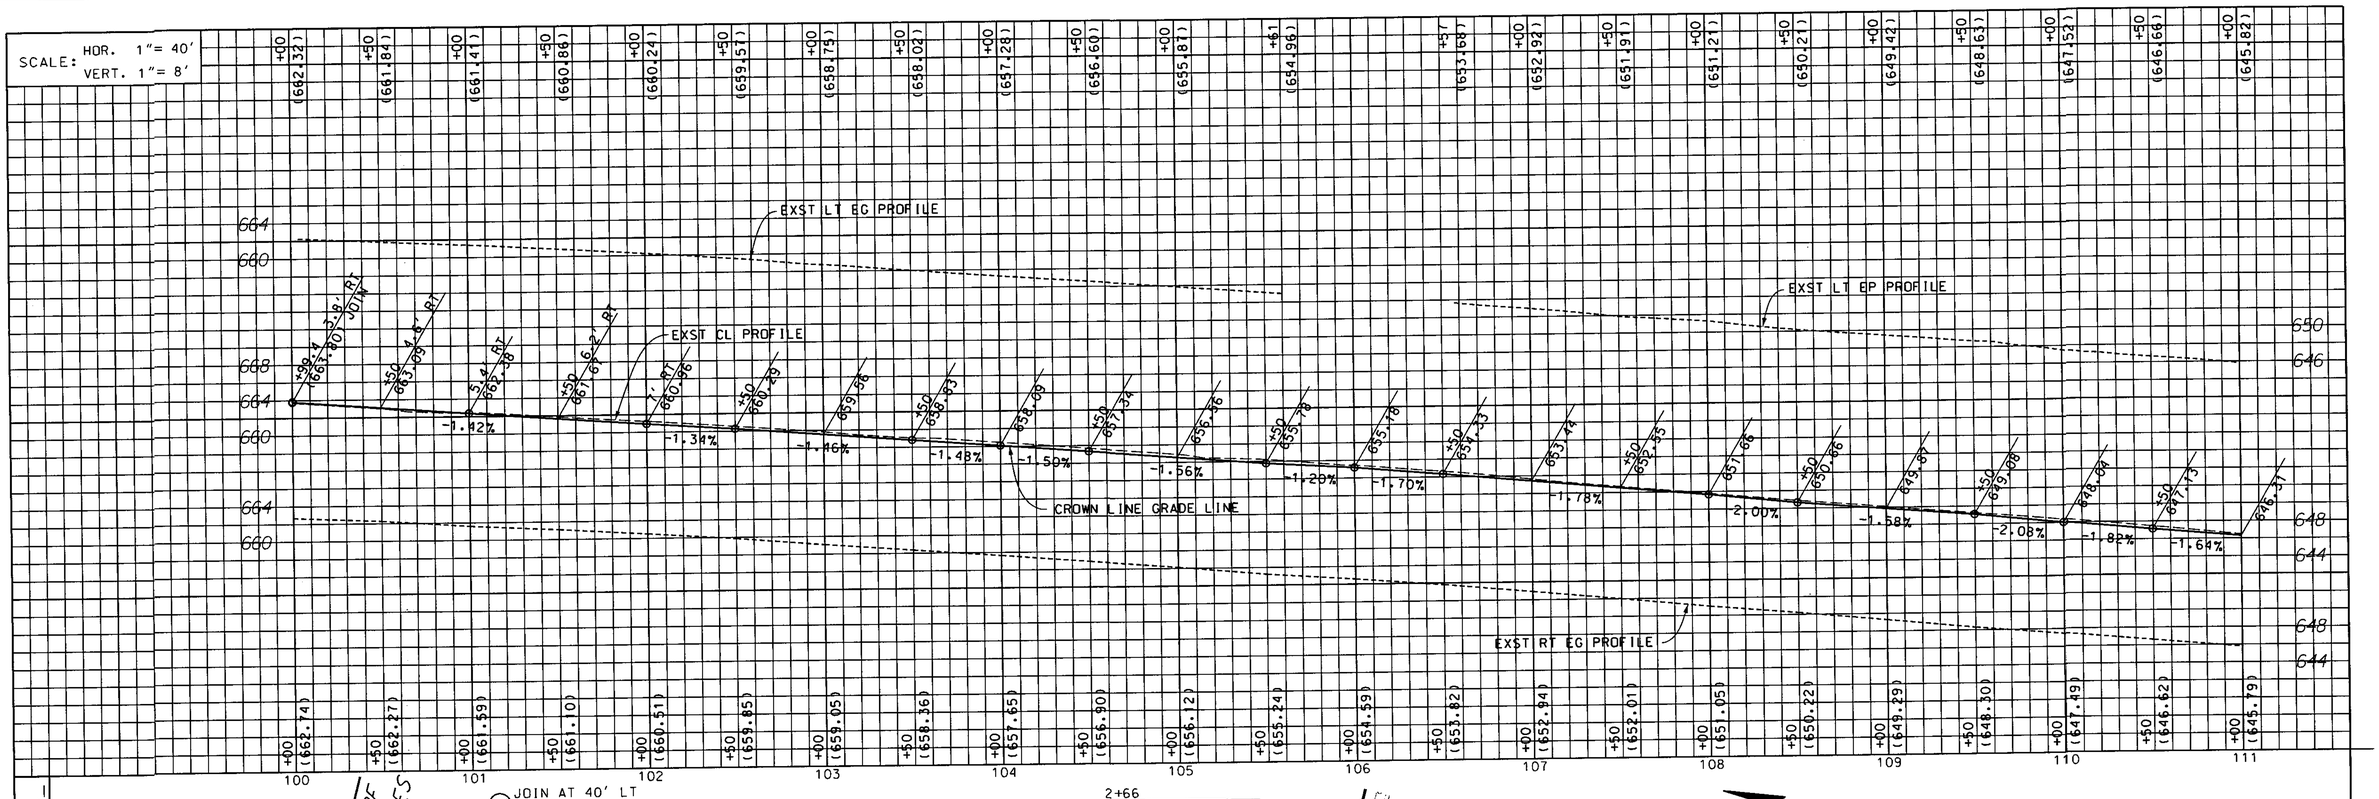


AS BUILT

| DATE | MK | DESCRIPTION |
|---|---|---|
| 8/2/11 | 2 | REVISED CURB RAMP |
| 8/2/11 | 1 | DELETED CMB NOTE |

REVISIONS

REGISTERED PROFESSIONAL ENGINEER GILBERT TSOI 67747 CIVIL STATE OF CALIFORNIA

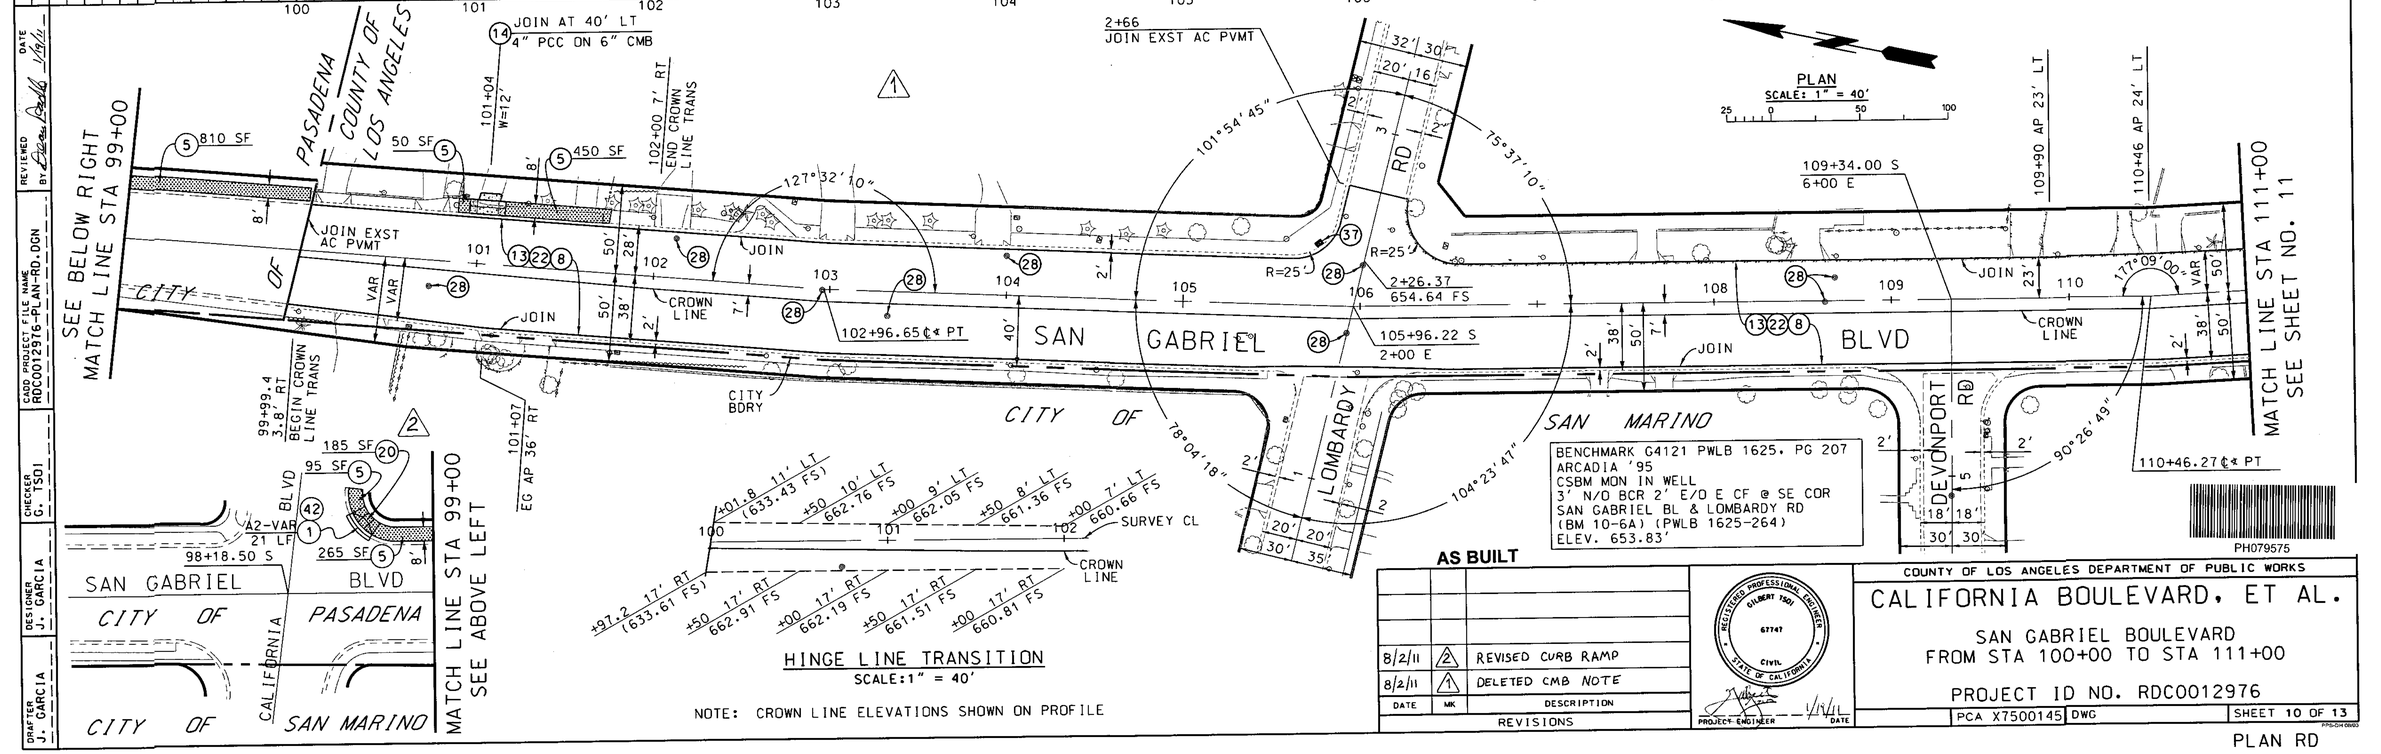PROJECT ENGINEER DATE 1/19/11

COUNTY OF LOS ANGELES DEPARTMENT OF PUBLIC WORKS

# CALIFORNIA BOULEVARD, ET AL.

SAN GABRIEL BOULEVARD
FROM STA 100+00 TO STA 111+00

PROJECT ID NO. RDC0012976

PCA X7500145 | DWG | SHEET 10 OF 13

PLAN RD

DRAFTER J. GARCIA | DESIGNER J. GARCIA | CHECKER G. TSOI | CADD PROJECT FILE NAME RDC0012976-PLAN-RD.DGN | REVIEWED BY | DATE 1/19/11

DATE: 03/16/2011 TIME: 3:28:22 PM FILE: C:\MyFiles\Joel\PROJECTS\RDC0012976-CALIFORNIA Blvd Et Al\CAD\WORKING ON CAD\RDC0012976 PLAN RD.dgn