SCALE: HOR. 1"= 20'
VERT. 1"= 4'

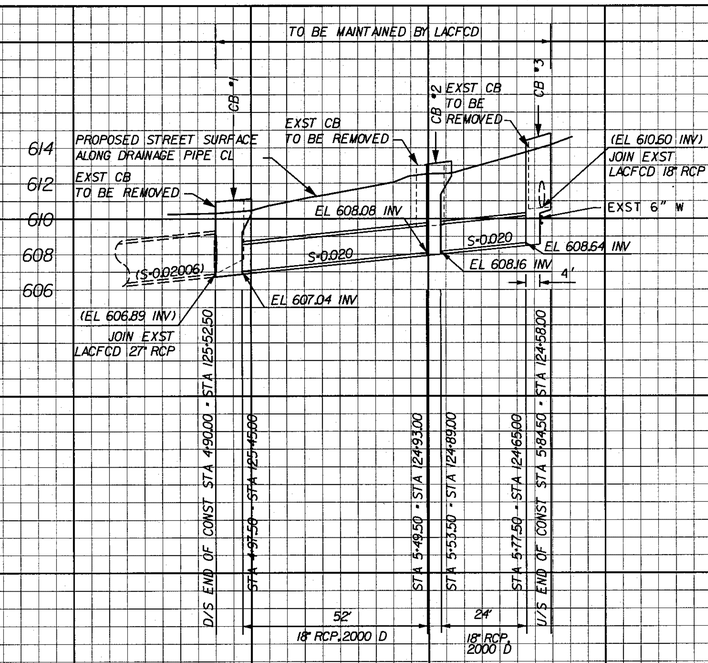

DRAINAGE PIPE PROFILE

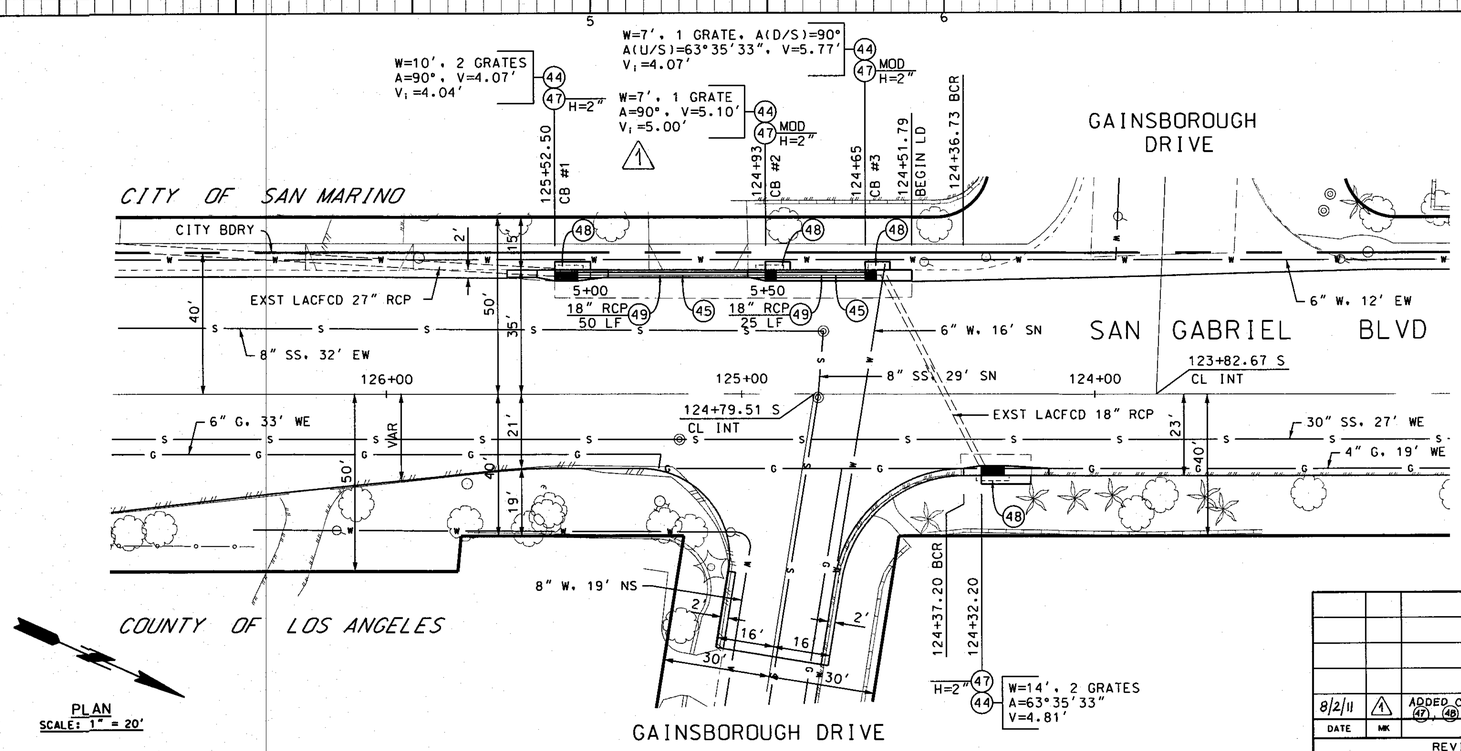

PLAN
SCALE: 1" = 20'

UTILITIES

WATER LINES	SUNYSLOPE WATER COMPANY
	CALIFORNIA AMERICAN WATER COMPANY
GAS LINES	THE GAS COMPANY
SEWER LINES	LACDPW

PH079578

BENCHMARK BM-1
ARCADIA '95
L & T IN W CB SAN GABRIEL BLVD
25 FT S/O SLY DRWY TO CHURCH
625 FT N/O C/L HUNTINGTON DR
PWLB 1526-2067
ELEV. 609.134

AS BUILT

DATE	MK	DESCRIPTION
8/2/11	1	ADDED CONSTRUCTION NOTES 47, 48 & 49

REVISIONS

REGISTERED PROFESSIONAL ENGINEER GILBERT TSOI 67747 CIVIL STATE OF CALIFORNIA

PROJECT ENGINEER — DATE 1/9/11

COUNTY OF LOS ANGELES DEPARTMENT OF PUBLIC WORKS

CALIFORNIA BOULEVARD, ET AL.

DRAINAGE PROFILE

PROJECT ID NO. RDC0012976

PCA X7500145 | DWG | SHEET 13 OF 13

PLAN RD

DRAFTER J. GARCIA | DESIGNER J. GARCIA | CHECKER G. TSOI | CADD PROJECT FILE NAME RDC0012976-PLAN-RD.DGN | REVIEWED BY | DATE 1/9/11

DATE: 02/09/2011 TIME: 4:51:06 PM FILE: C:\MyFiles\Joel\PROJECTS\RDC0012976-CALIFORNIA Blvd E" A1\CAD\WORKING ON CAD\RDC0012976 PLAN RD.dgn