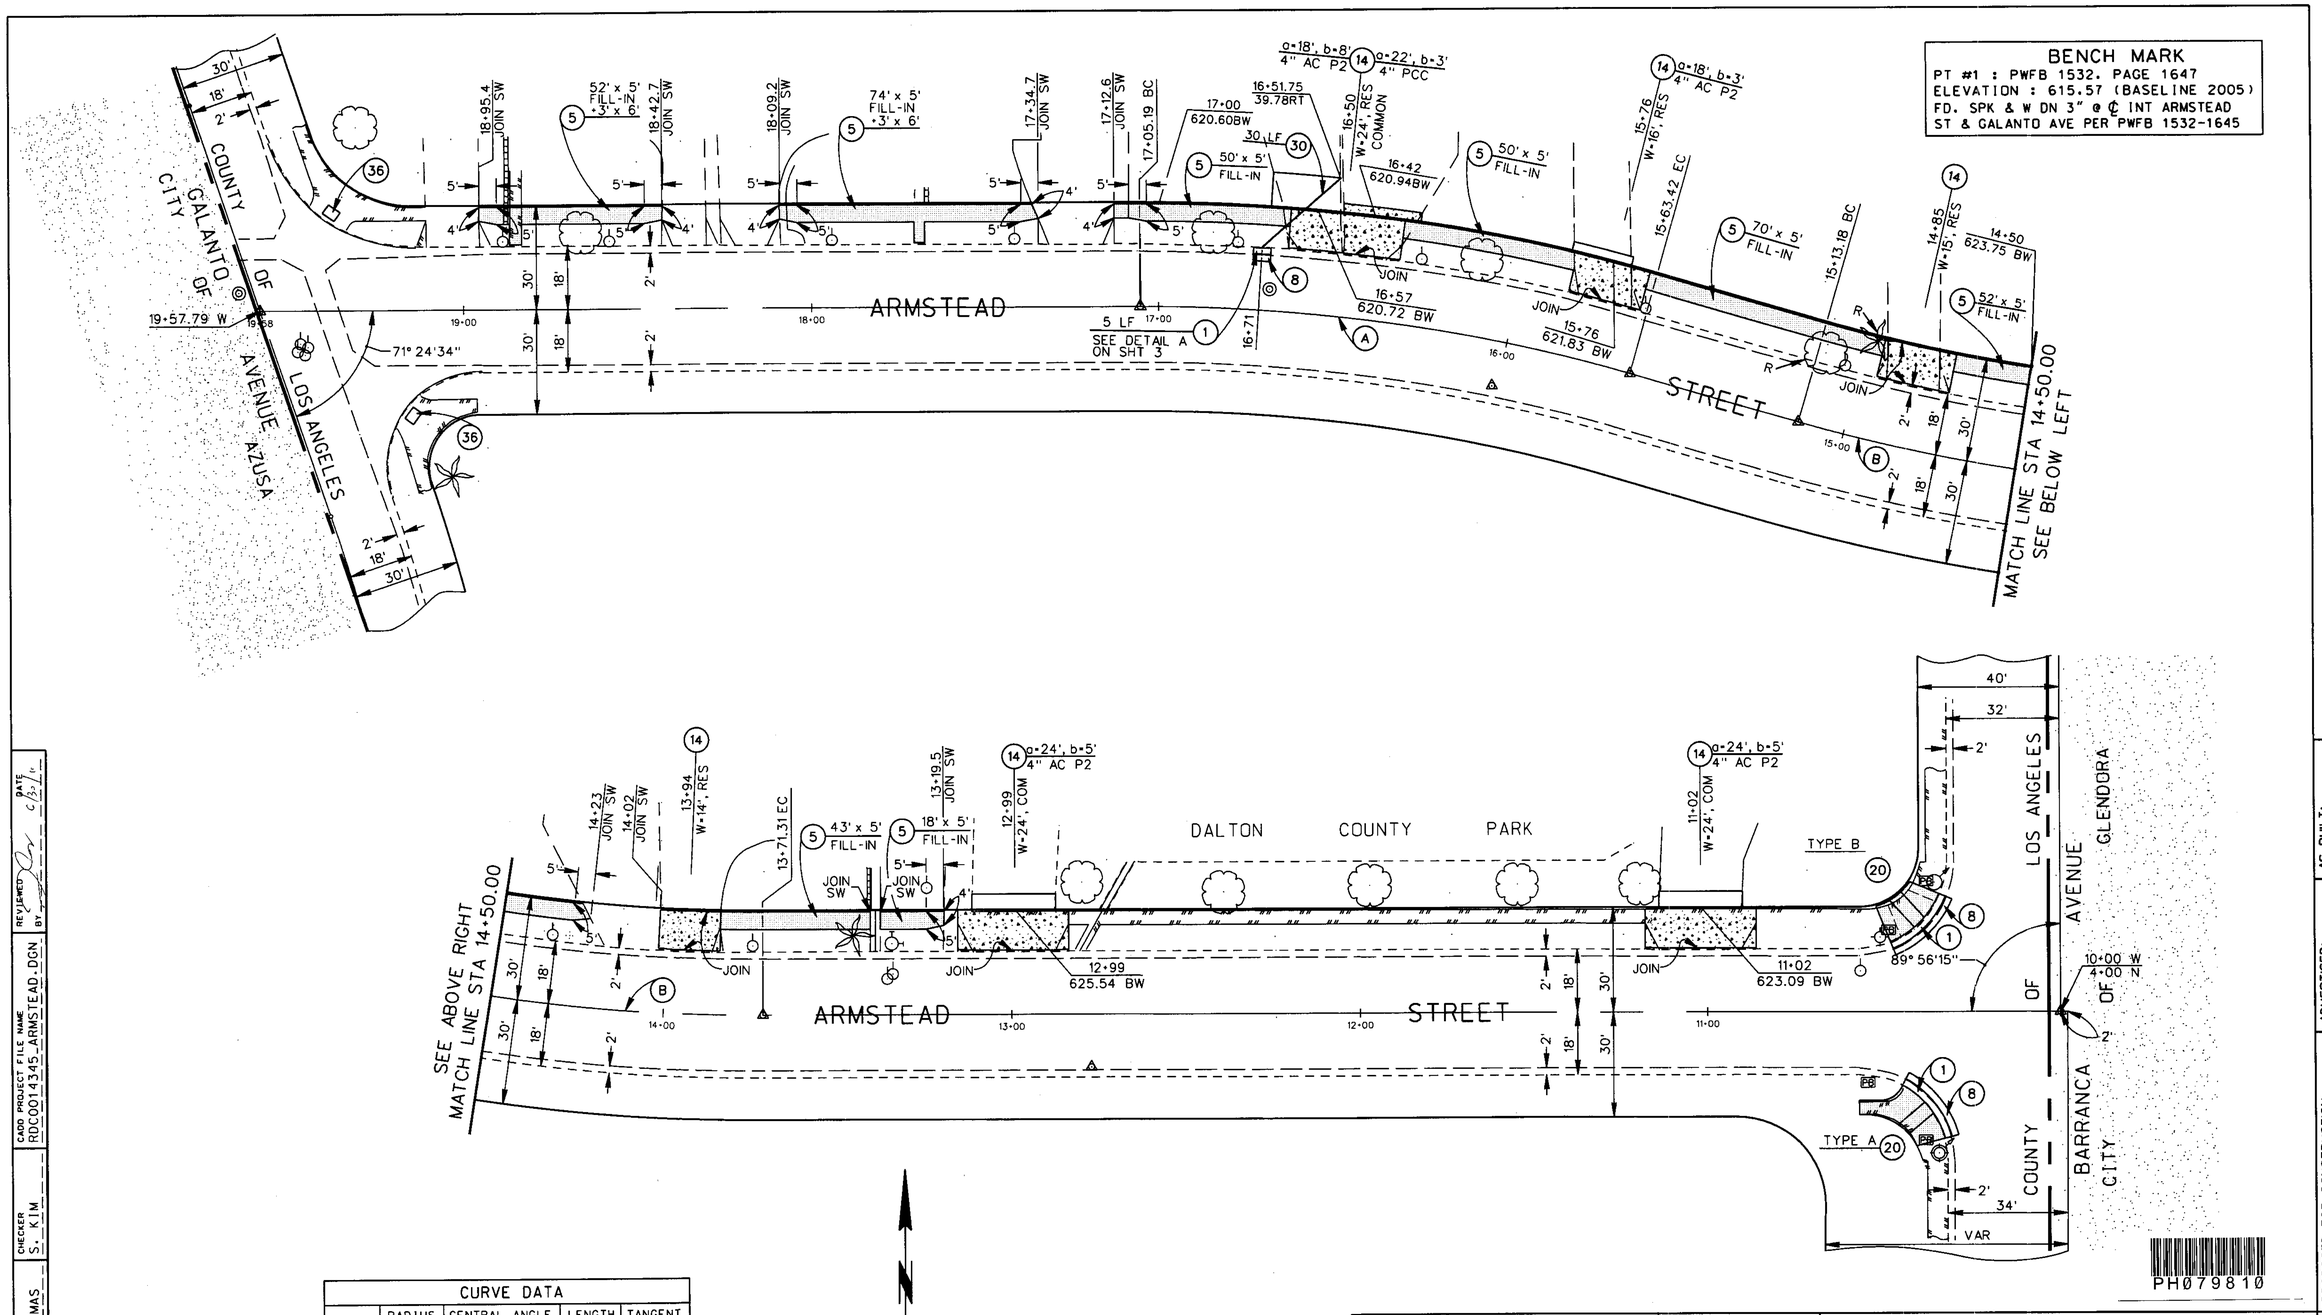

CURVE DATA						
CURVE	RADIUS FT	CENTRAL ANGLE DEG	MIN	SEC	LENGTH FT	TANGENT FT
A	501.17	16	12	25	141.76	71.36
B	503.53	16	08	31	141.86	71.40

PH079810

DATE	MK	DESCRIPTION
REVISIONS		

REGISTERED PROFESSIONAL ENGINEER SUNG H. KIM 46694 CIVIL STATE OF CALIFORNIA

PROJECT ENGINEER 6/30/11 DATE

COUNTY OF LOS ANGELES DEPARTMENT OF PUBLIC WORKS

ARMSTEAD STREET

BARRANCA AVENUE TO GALANTO AVENUE (N/S)

PLAN

PROJECT ID NO. RDC0014347

PCA X2101956 | DWG PH079810 | SHEET 14 OF 14

"AS BUILT DRAWINGS"

DRAFTER A. THOMAS | DESIGNER A. THOMAS | CHECKER S. KIM | CADD PROJECT FILE NAME RDC0014345_ARMSTEAD.DGN | REVIEWED BY | DATE 6/30/11

PROPOSED FOR CONSTRUCTION: DATE | ADVERTISED: DATE | AS BUILT: DATE