COUNTY OF LOS ANGELES
DEPARTMENT OF PUBLIC WORKS

GUNN AVENUE, ET AL.

TOTAL LENGTH 6.50 MILES

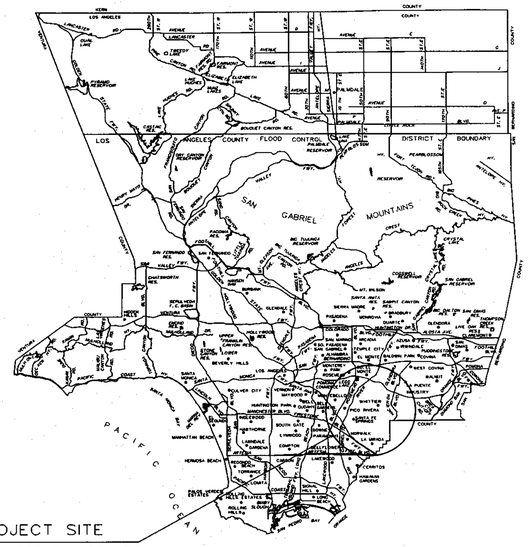

PROJECT SITE

T.G. 707 C4, C5, D4, D5, E3, E4

R.D. 446

LOCATION MAP

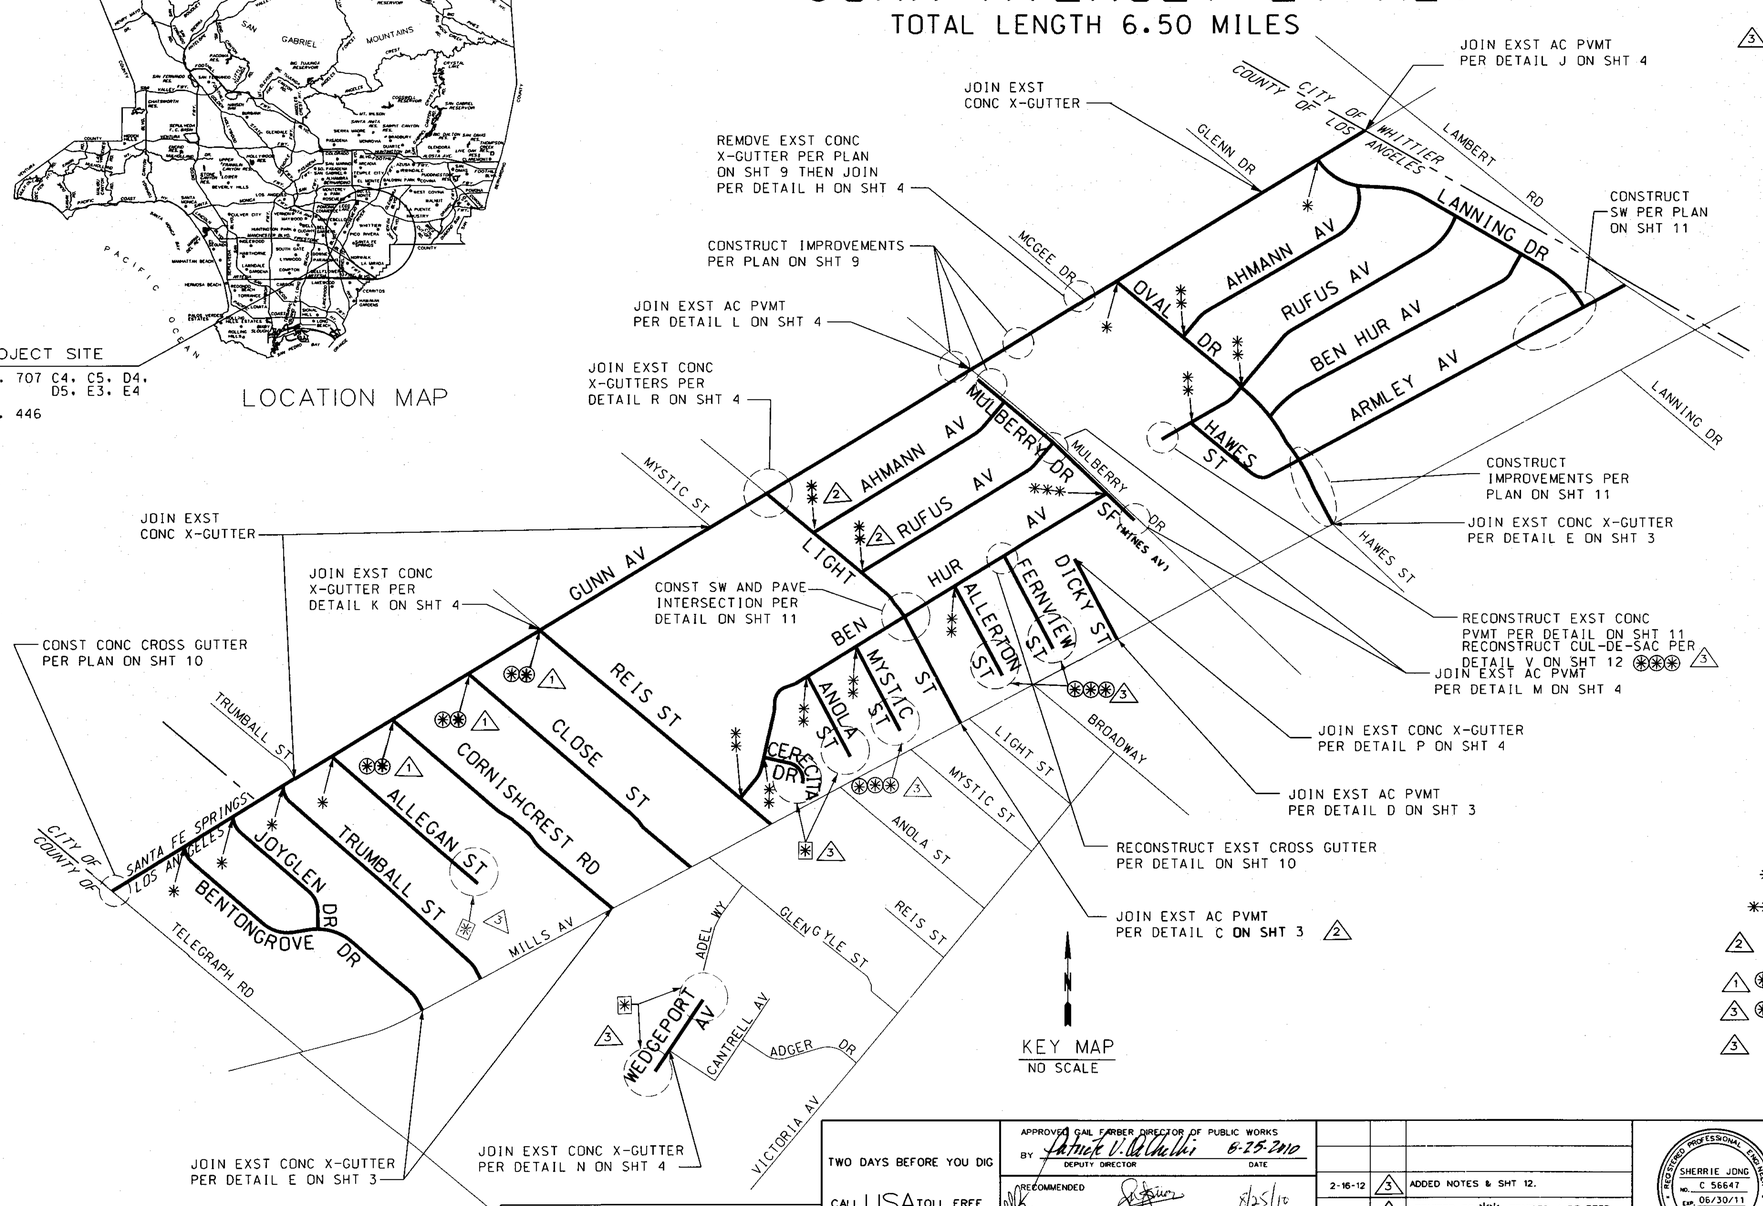

INDEX OF SHEETS

SHEET NO. 1	TITLE SHEET
SHEET NO. 2	CONSTRUCTION NOTES AND REFERENCES
SHEET NO. 3	TYPICAL SECTIONS AND CONSTRUCTION DETAILS
SHEET NO. 4	CONSTRUCTION & DIGOUT DETAILS, AND TABLE
SHEET NO. 5	PARKWAY TABLES
SHEET NO. 6	PAKKWAY DETAIL, SECTION, AND TABLES
SHEET NO. 7	PARKWAY TABLES
SHEET NO. 8	CURB RAMP DETAILS AND TABLES
SHEET NO. 9	IMPROVEMENT DETAILS
SHEET NO. 10	CROSS GUTTER DETAILS
SHEET NO. 11	IMPROVEMENT DETAILS
3 SHEET NO. 12	TYPICAL SECTIONS AND CONSTRUCTION DETAILS
PLAN SP	STRIPING PLANS
PLAN TC	TRAFFIC CONTROL PLAN
PLAN TS	LOOP RESTORATION PLANS

PROJECT LIMITS

AHMANN AV - LIGHT ST TO MULBERRY DR SOUTH FRONTAGE
AHMANN AV - OVAL DR TO LANNING DR
ALLEGAN ST - 870' S/O GUNN AV TO GUNN AV
ALLERTON ST - BEN HUR AV TO 500' S/O BEN HUR AV
ANOLA ST - BEN HUR AV TO 460' S/O BEN HUR AV
ARMLEY AV - HAWES ST TO LAMBERT RD
BEN HUR AV - OVAL RD TO LANNING DR
BEN HUR AV - REIS ST TO MULBERRY DRIVE SOUTH FRONTAGE
BENTONGROVE DR - MILLS AV TO GUNN AV
CERECITA DR - BEN HUR AV TO 280' S/O BEN HUR AV
CLOSE ST - MILLS AV TO GUNN AV
CORNISHCREST RD - GUNN AV TO MILLS AV
DICKY ST - ALLEY S/O BEN HUR AV TO MILLS AV
FERNVIEW ST - BEN HUR AV TO 520' S/O BEN HUR AV
GUNN AV - TELEGRAPH RD TO 280' N/O LANNING DR
HAWES ST - RUFUS AV TO ARMLEY AV
JOYGLEN DR - BENTONGROVE DR TO GUNN AV
LANNING DR - GUNN AV TO ARMLEY AV
LIGHT ST - GUNN AV TO MILLS AV
MULBERRY DR SF - 170' W/O AHMANN AV TO 110' E/O BEN HUR AV
MYSTIC ST - BEN HUR AV TO 480' S/O BEN HUR AV
OVAL DR - MILLS AV TO GUNN AV
REIS ST - MILLS AV TO GUNN AV
RUFUS AV - LIGHT ST TO MULBERRY DR
RUFUS AV - 150' S/O HAWES ST TO LANNING DR
TRUMBALL ST - MILLS AV TO GUNN AV
WEDGEPORT AV - 140' S/O CANTRELL AV TO 330' N/O CANTRELL AV

NOTES:

1. JOIN EXST AC PVMT PER DETAIL C ON SHEET 3 UNLESS NOTED OTHERWISE.
2. PAVE INTERSECTIONS PER DETAIL F ON SHEET 4 UNLESS NOTED OTHERWISE.

* SEE DETAIL A ON SHEET 3.
** SEE DETAIL B ON SHEET 3.
*** SEE DETAIL G ON SHEET 4.
2 ~~** SEE DETAIL S ON SHEET 4.~~
1 ** SEE DETAIL U ON SHEET 3.
3 *** SEE DETAIL V ON SHEET 12.
3 * SEE DETAIL W ON SHEET 12.

PH079876

AS BUILT PLAN B

DRAFTER	DESIGNER	CHECKER	CADD PROJECT FILE NAME
A. TORRES	S. JONG	D. RADLE	RDC0015216-PLAN-RD.DGN

TWO DAYS BEFORE YOU DIG
CALL USA TOLL FREE
1-800-227-2600

APPROVED
BY Thomas P. Lopez — CITY OF SANTA FE SPRINGS — 9-2-10 DATE

APPROVED GAIL FARBER DIRECTOR OF PUBLIC WORKS
BY Patrick V. Alchikh — DEPUTY DIRECTOR — 8-25-2010 DATE

RECOMMENDED
BY — ASSISTANT DEPUTY DIRECTOR — 8/25/10 DATE

SUBMITTED DPW
BY Jashed Sabi — HIGHWAY DESIGN SECTION II — 8/23/10 DATE

DATE	MK	DESCRIPTION
2-16-12	3	ADDED NOTES & SHT 12.
9-27-10	2	REVISED TO **. REVISED / DELETED NOTE
9-21-10	1	REVISED TO *** AND ADDED NOTE

REVISIONS

REGISTERED PROFESSIONAL ENGINEER — SHERRIE JONG — NO. C 56647 — EXP. 06/30/11 — CIVIL — STATE OF CALIFORNIA
PROJECT ENGINEER — 7-21-10 DATE

COUNTY OF LOS ANGELES DEPARTMENT OF PUBLIC WORKS

GUNN AVENUE, ET AL.

TITLE SHEET

PROJECT ID NO. RDC0015497

PREVENTIVE MAINTENANCE PROJECT

3

PCA	DWG	SHEET 1 OF 12

TS-DF 3/99

PLAN RD

DATE: $DATE$ TIME: $TIME$ FILE: $FILE$