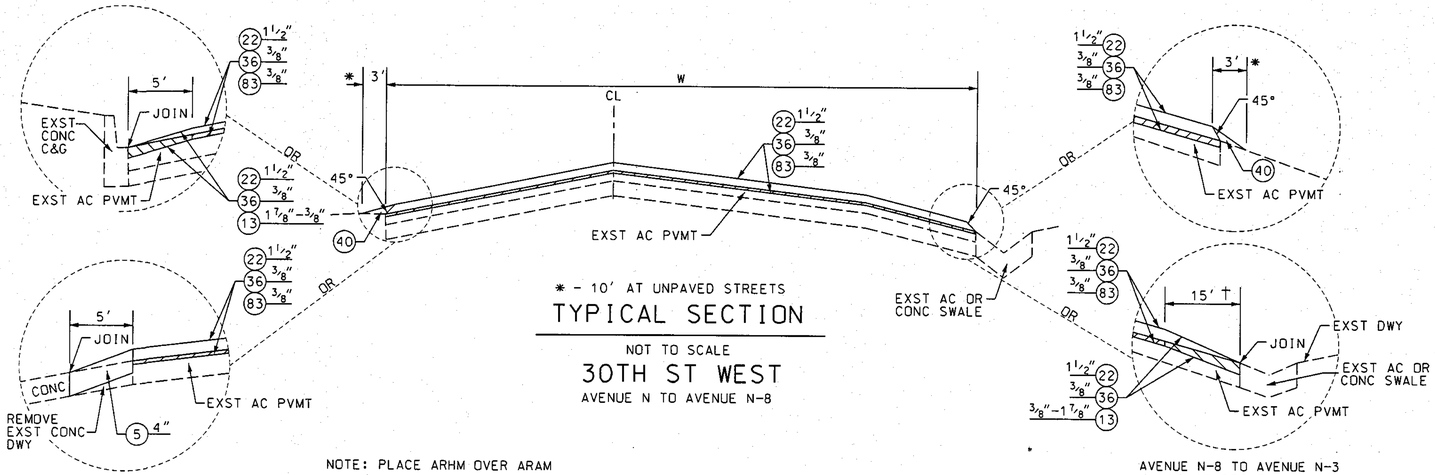

* - 10' AT UNPAVED STREETS

TYPICAL SECTION

NOT TO SCALE

30TH ST WEST

AVENUE N TO AVENUE N-8

NOTE: PLACE ARHM OVER ARAM

AVENUE N-8 TO AVENUE N-3
† 15' AT DRIVEWAYS

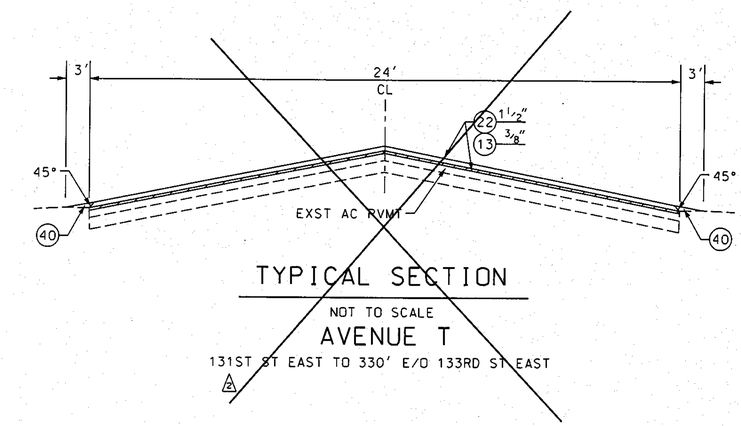

TYPICAL SECTION

NOT TO SCALE

AVENUE T

131ST ST EAST TO 330' E/O 133RD ST EAST

△2

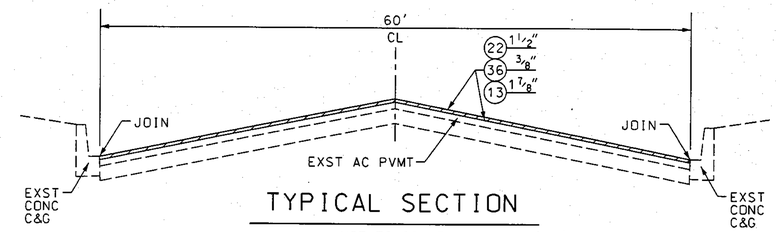

TYPICAL SECTION

NOT TO SCALE

82ND ST EAST

222' N/O PEARBLOSSOM HY TO PEARBLOSSOM HY

NOTE: PLACE ARHM OVER ARAM

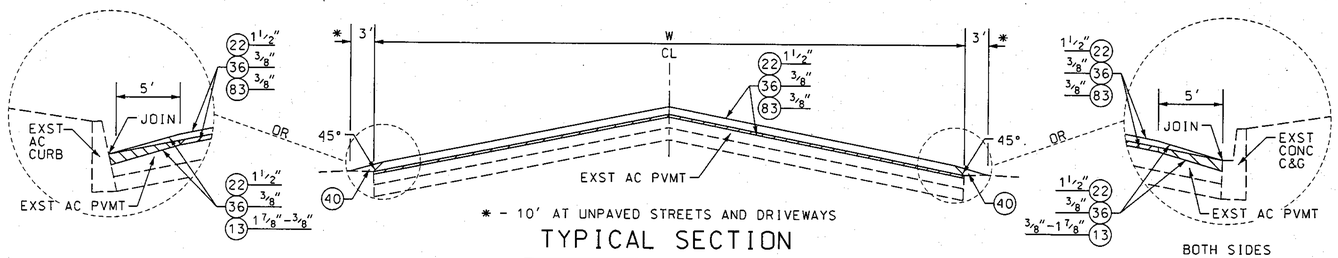

* - 10' AT UNPAVED STREETS AND DRIVEWAYS

TYPICAL SECTION

NOT TO SCALE

AVENUE N

1500' W/O 15TH ST WEST TO BW/A V FY/2050

165TH ST EAST

170'N/O UPRR TO 170' S/O UPRR
1800' N/O PEARBLOSSOM HY TO PEARBLOSSOM HY

AVENUE T

BE/LTL R CK/0212 TO 2000' E/O 80TH ST EAST

NOTE: PLACE ARHM OVER ARAM

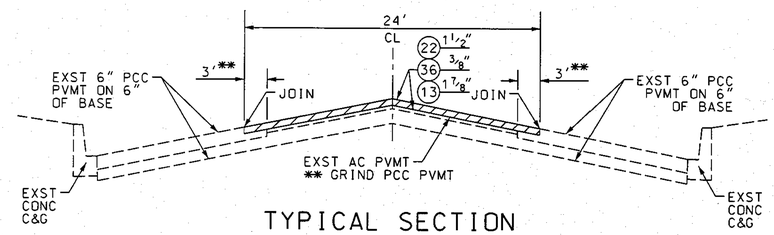

TYPICAL SECTION

NOT TO SCALE

82ND ST EAST

1800' N/O PEARBLOSSOM HY TO 222' N/O PEARBLOSSOM HY

NOTE: PLACE ARHM OVER ARAM

PH080048

DATE	MK	DESCRIPTION
8/11/11	MO	CHANGE (13) TO (83) FOR MICROMILL
8/11/11	MO	CHANGE PROJECT ID NO. FROM RDC0015324 TO RDC0015741
08-11-11	△2	DELETE PER PDD'S REQUEST. SMP UNABLE TO OBTAIN R/W

REVISIONS

REGISTERED PROFESSIONAL ENGINEER — M. ORELLANA — C62045 — EXP. 09-30-11 — CIVIL — STATE OF CALIFORNIA

PROJECT ENGINEER — DATE 8-02-10

COUNTY OF LOS ANGELES DEPARTMENT OF PUBLIC WORKS

AVENUE N, ET AL.- PHASE 2

TYPICAL SECTIONS

PROJECT ID NO. RDC0015741

PCA | DWG PH080048 | SHEET 3 OF 5

PS-DH 08/03

DRAFTER A TORRES | DESIGNER M ORELLANA | CHECKER M ORELLANA | CADD PROJECT FILE NAME RDC0015324-PLAN-RD | REVIEWED BY | DATE

PROPOSED FOR CONSTRUCTION: — DATE — | ADVERTISED: — DATE — | AS BUILT: — DATE —

DATE: $DATE$ TIME: $TIME$ FILE: $FILEL$