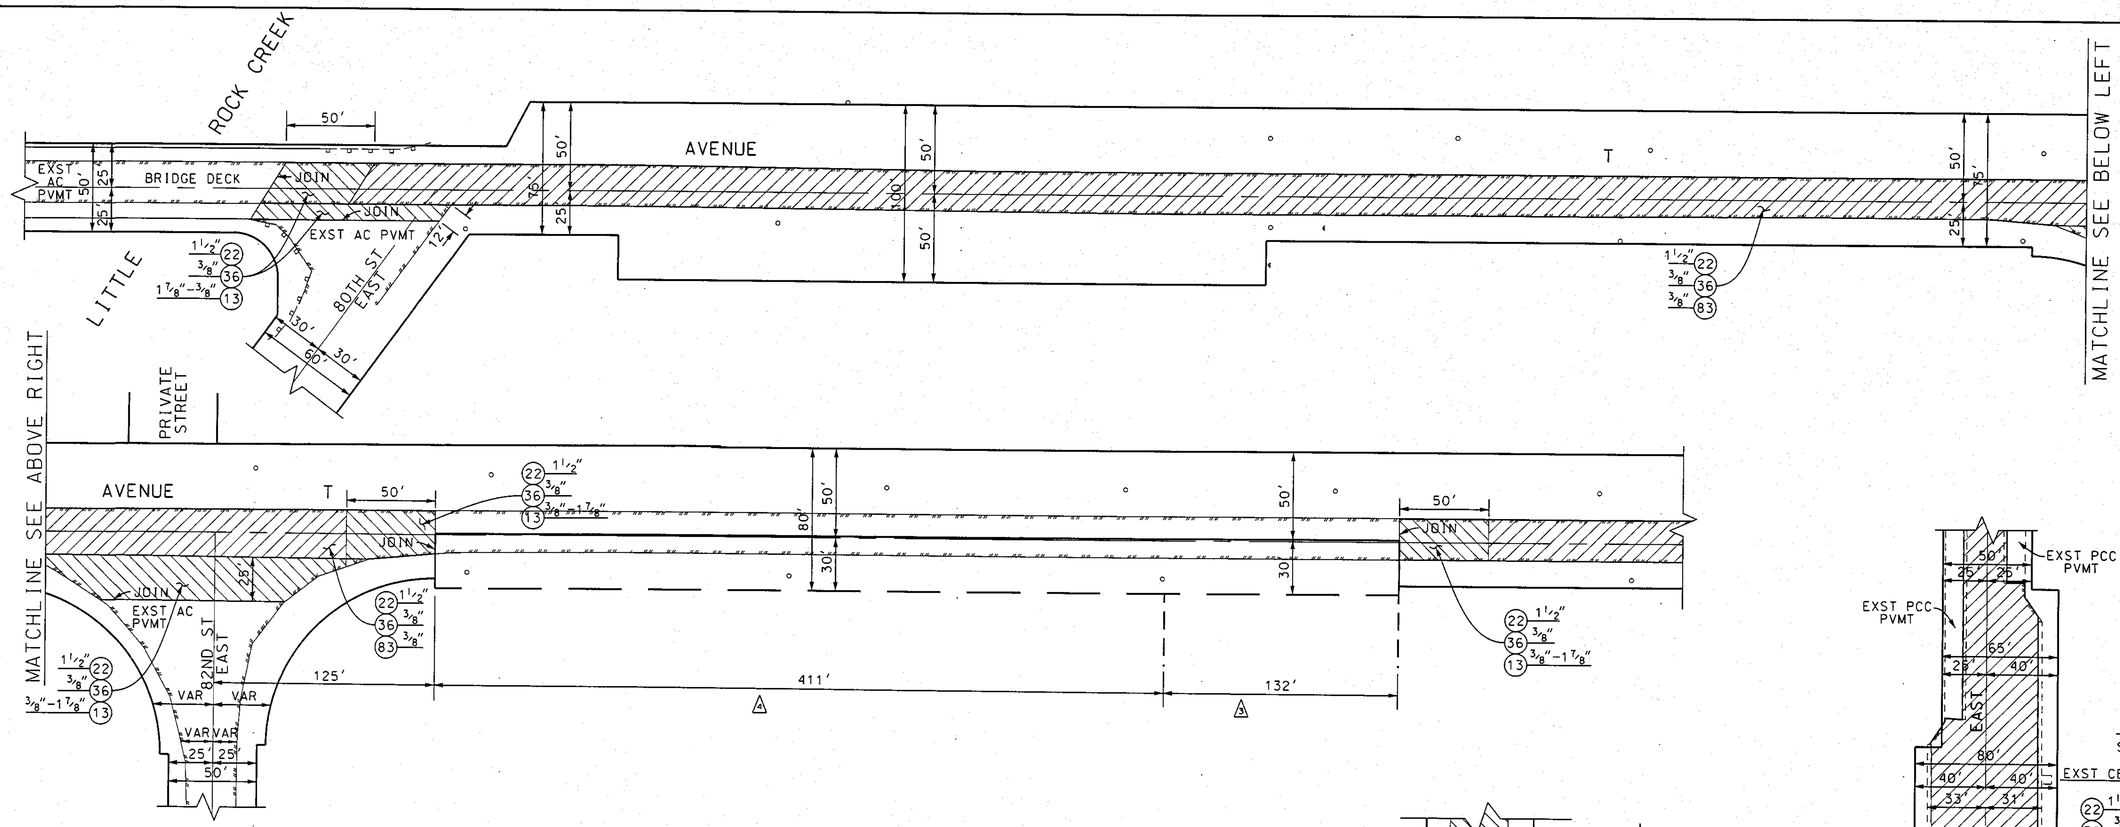

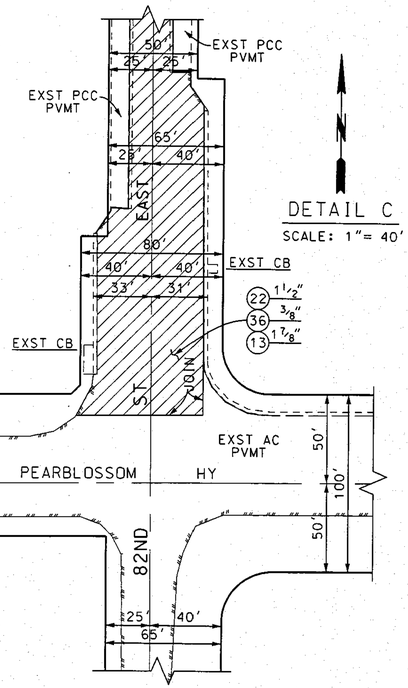

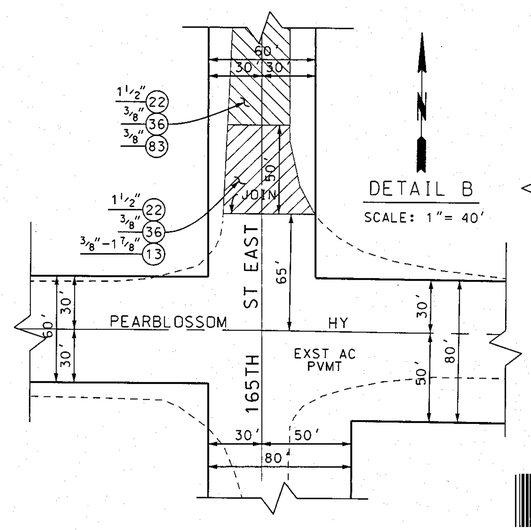

PH080049

PLAN
SCALE: 1" = 40'

TABLE

	STREET NAME	LIMITS	W (FT)	L (FT)	AREA* (SF)	QUANTITIES 5 (83) (SF)	(13) (SF)	(22) (TON)	(36) (SY)
1	30TH STREET WEST	AVENUE N TO 720' S/O AVENUE N	42	720	30.300	30.300	--	285	3.367
2	30TH STREET WEST	720' S/O AVENUE N TO 820' S/O AVENUE N	25	100	2.500	1.600	900	24	278
3	30TH STREET WEST	820' S/O AVENUE N TO 1620' S/O AVENUE N	45	800	36.100	35.200	900	339	4.012
4	30TH STREET WEST	1620' S/O AVENUE N TO AVENUE N-8	70	1020	71.500	68.000	3.500	671	7.945
5	82ND STREET EAST	1800' N/O PEARBLOSSOM HY TO 222' N/O PEARBLOSSOM HY	24	1.578	38.000	--	28.532	356	4.212
6	82ND STREET EAST	222' N/O PEARBLOSSOM HY TO PEARBLOSSOM HY	60	222	13.500	--	13.500	125	1.480
7	165TH STREET EAST	1800' N/O PEARBLOSSOM HY TO 65' N/O PEARBLOSSOM HY	32	1.735	56.000	54.000	2.000	525	6.223
8	165TH STREET EAST	170' N/O UPRR TO 170' S/O UPRR	32	340	11.000	1.000	10.000	104	1.223
9	AVENUE N	1500' W/O 15TH ST WEST TO 254' E/O 15TH ST WEST	27	1.754	48.000	46.650	1.350	450	5.334
10	AVENUE N	254' E/O 15TH ST WEST TO 585' E/O 15TH ST WEST	40	331	13.300	8.000	5.300	125	1.478
11	AVENUE N	585' E/O 15TH ST WEST TO BW/A V FY / 2050	42	319	13.500	7.600	5.900	127	1.500
12	AVENUE T	BE/LTL R CK/0212 TO 780' E/O 82ND ST EAST	25	1.457	3.700	32.000	5.000	469	5.556
~~13~~	~~AVENUE T~~ 5	~~131ST ST EAST TO 330' E/O 133RD ST EAST~~	~~24~~	~~1.650~~	~~39.600~~	~~39.600~~	--	~~372~~	--

* INCLUDES ADDITIONAL AREA FOR INTERSECTIONS, AND PAVED SHOULDERS.

DATE	MK	DESCRIPTION
9/14/11	5	REVISE QUANTITIES TABLE
9/14/11	4	DELETE PER PDD'S REQUEST. SMP UNABLE TO OBTAIN R/W
8/11/11	MO	CHANGE (13) TO (83) FOR MICROMILL
8/11/11	MO	CHANGE PROJECT ID NO. FROM RDC0015324 TO RDC0015741
08-11-11	3	DELETE PER PDD'S REQUEST. SMP UNABLE TO OBTAIN R/W

REVISIONS

REGISTERED PROFESSIONAL ENGINEER — M. ORELLANA — NO. C62045 — EXP. 09-30-11 — CIVIL — STATE OF CALIFORNIA

PROJECT ENGINEER — 9-02-10 DATE

COUNTY OF LOS ANGELES DEPARTMENT OF PUBLIC WORKS

AVENUE N, ET AL.- PHASE 2

DETAILS AND TABLE

PROJECT ID NO. RDC0015741

PCA | DWG PH080049 | SHEET 4 OF 5

DRAFTER A TORRES | DESIGNER M ORELLANA | CHECKER M ORELLANA | CADD PROJECT FILE NAME RDC0015324-PLAN-RD | REVIEWED BY | DATE

PROPOSED FOR CONSTRUCTION: — DATE — | ADVERTISED: — DATE — | AS BUILT: — DATE —

DATE: $DATE$ TIME: $TIME$ FILE: $FILEL$

PS-CH 05/03