COUNTY OF LOS ANGELES
DEPARTMENT OF PUBLIC WORKS

AVENUE N

45TH STREET WEST TO 1800' E/O 30TH STREET WEST

TOTAL LENGTH OF PROJECT = 1.84 MILES

INDEX

SHEET 1	KEY MAP
SHEET 2	NOTES AND REFERENCES
SHEET 3-4	TYPICAL SECTIONS
SHEET 5-8	PLAN VIEW
PLAN SP	SIGNING AND STRIPING PLANS
PLAN TC	TRAFFIC CONTROL PLANS
PLAN TS	LOOP RESTORATION PLANS

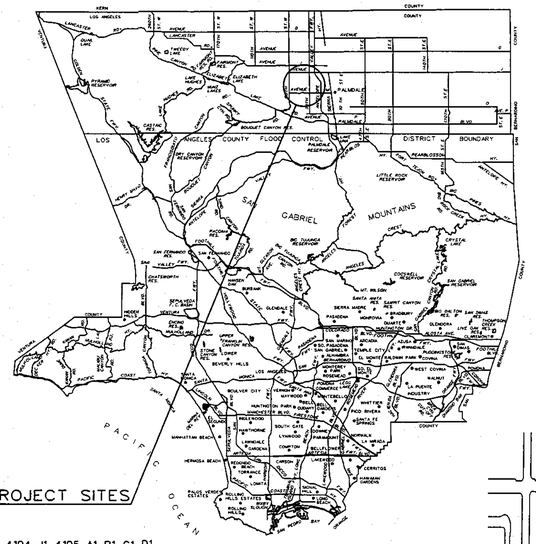

T. G. 4194-J1, 4195-A1, B1, C1, D1
R. D. 557

LOCATION MAP

KEY MAP
NOT TO SCALE

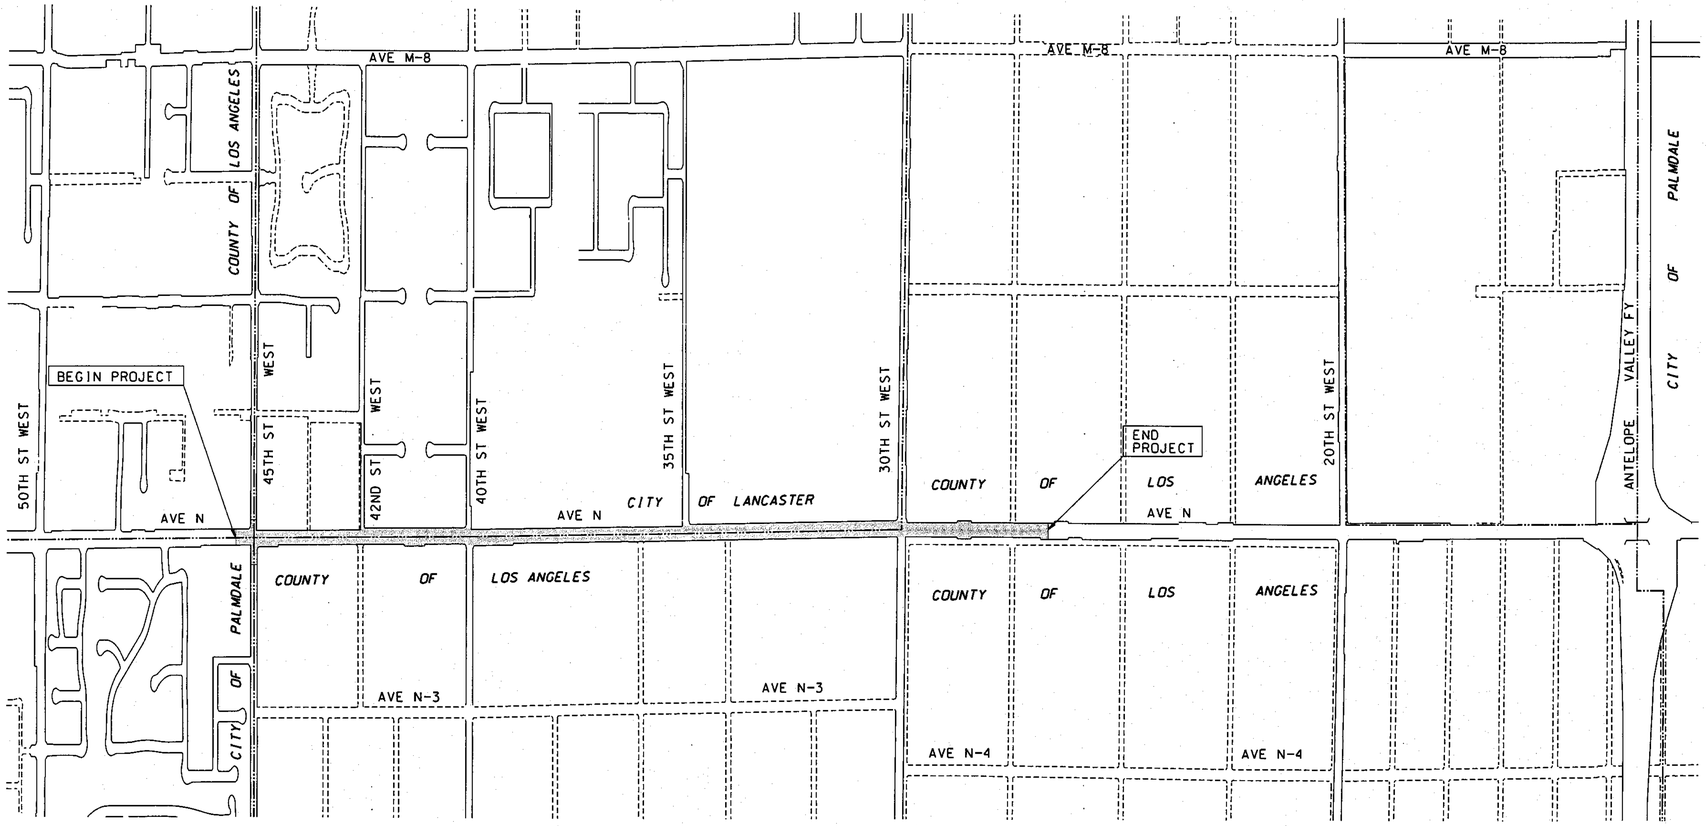

AS BUILT

PLAN B

PROPOSED FOR CONSTRUCTION: ___ DATE ___ ADVERTISED: ___ DATE ___ AS BUILT: ___ DATE ___

DRAFTER	DESIGNER	CHECKER	CADD PROJECT FILE NAME
EM	EM	V. LLANA	RDC0015741.DGN, SHT 1

APPROVED BY CITY OF LANCASTER 8/11/11 DATE

APPROVED BY CITY OF PALMDALE 8/15/11 DATE

TWO DAYS BEFORE YOU DIG
CALL USA TOLL FREE
1-800-227-2600

APPROVED GAIL FARBER DIRECTOR OF PUBLIC WORKS
BY DEPUTY DIRECTOR 8-09-2011 DATE

RECOMMENDED BY ASSISTANT DEPUTY DIRECTOR 8/9/2011 DATE

SUBMITTED BY HIGHWAY SECTION I 8/9/11 DATE

DATE	DESCRIPTION

REVISIONS

REGISTERED PROFESSIONAL ENGINEER VOLTAIRE LLANA No. 63954 CIVIL STATE OF CALIFORNIA

PROJECT ENGINEER 8/9/11 DATE

COUNTY OF LOS ANGELES DEPARTMENT OF PUBLIC WORKS

AVENUE N

TITLE SHEET

PROJECT ID NO. RDC0015741

CAPITAL PREVENTIVE MAINTENANCE PROJECT

PCA X2501847 | DWG PH080051 | SHEET 1 OF 8

PH080051

DATE: $DATE$ TIME: $TIME$ FILE: $FILEL$