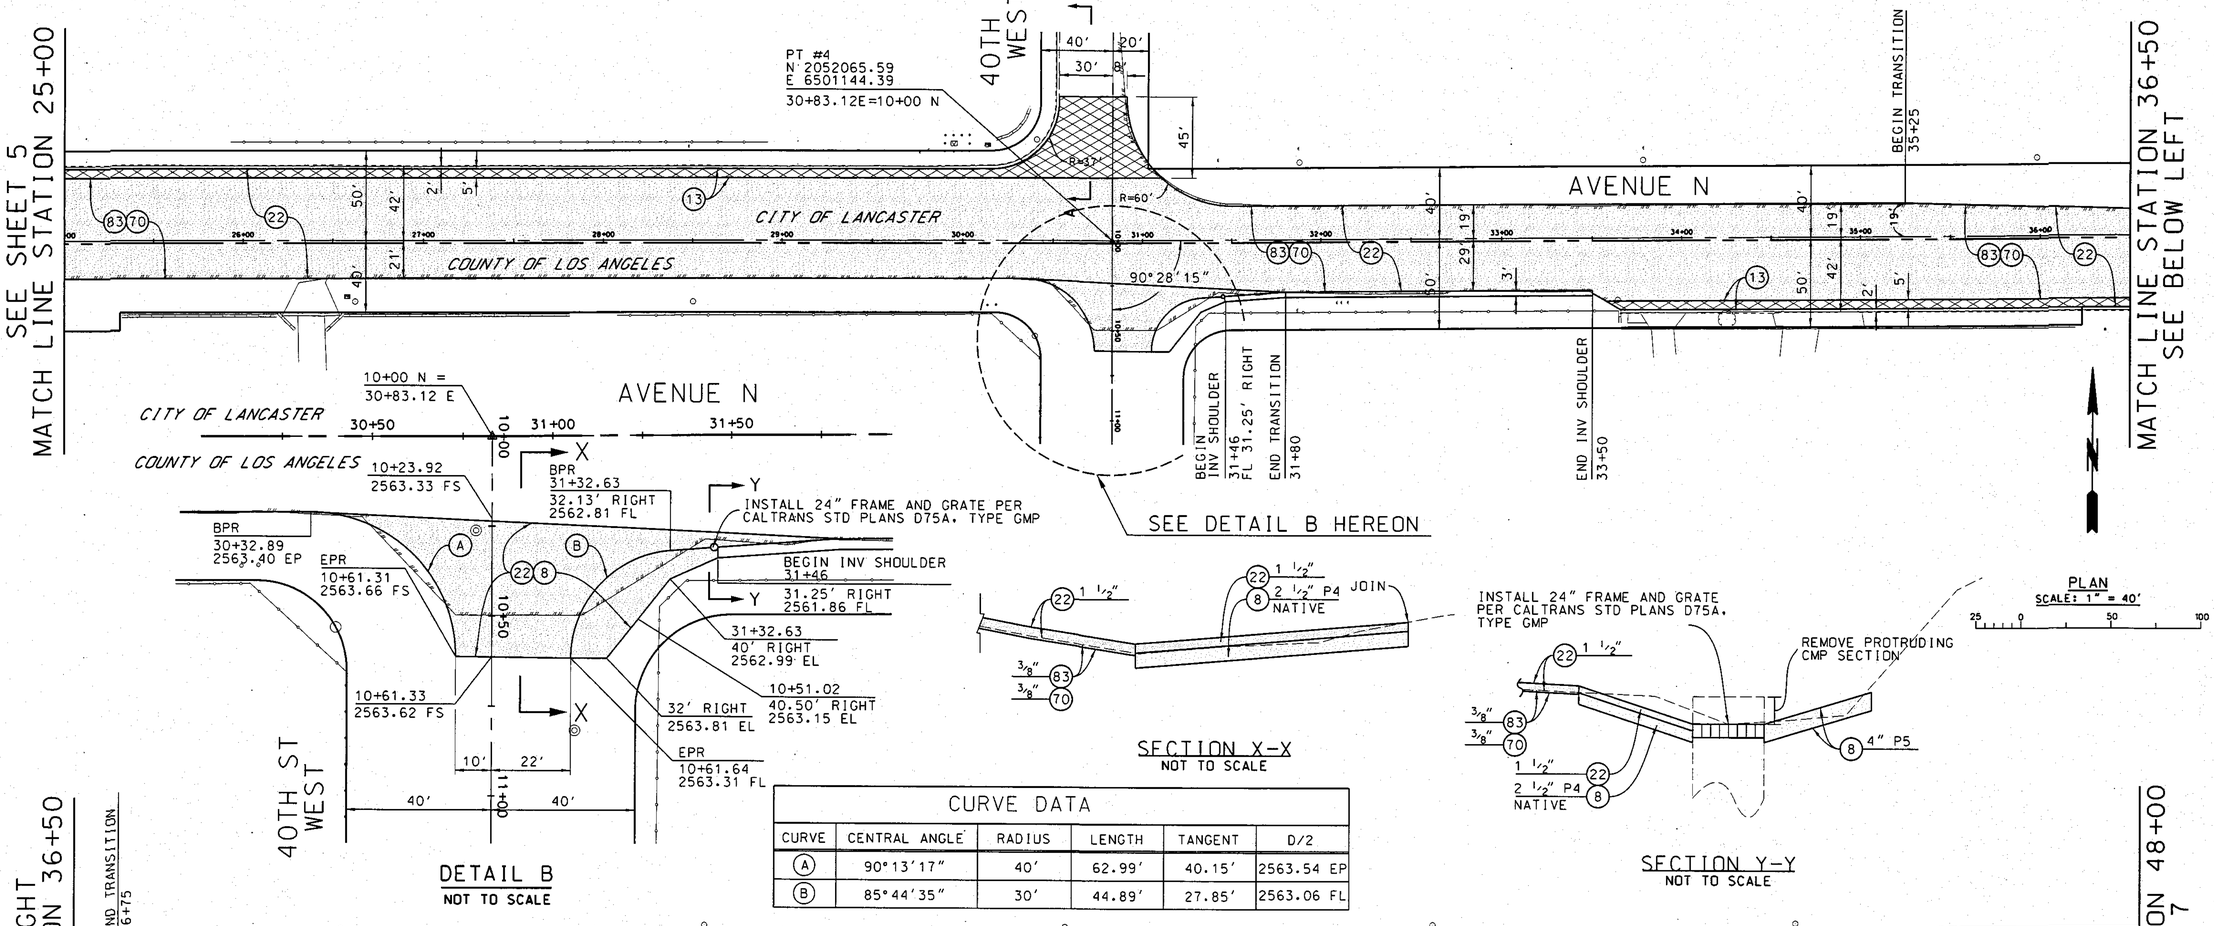

DETAIL B
NOT TO SCALE

SECTION X-X
NOT TO SCALE

SECTION Y-Y
NOT TO SCALE

PLAN
SCALE: 1" = 40'

CURVE DATA					
CURVE	CENTRAL ANGLE	RADIUS	LENGTH	TANGENT	D/2
A	90°13'17"	40'	62.99'	40.15'	2563.54 EP
B	85°44'35"	30'	44.89'	27.85'	2563.06 FL

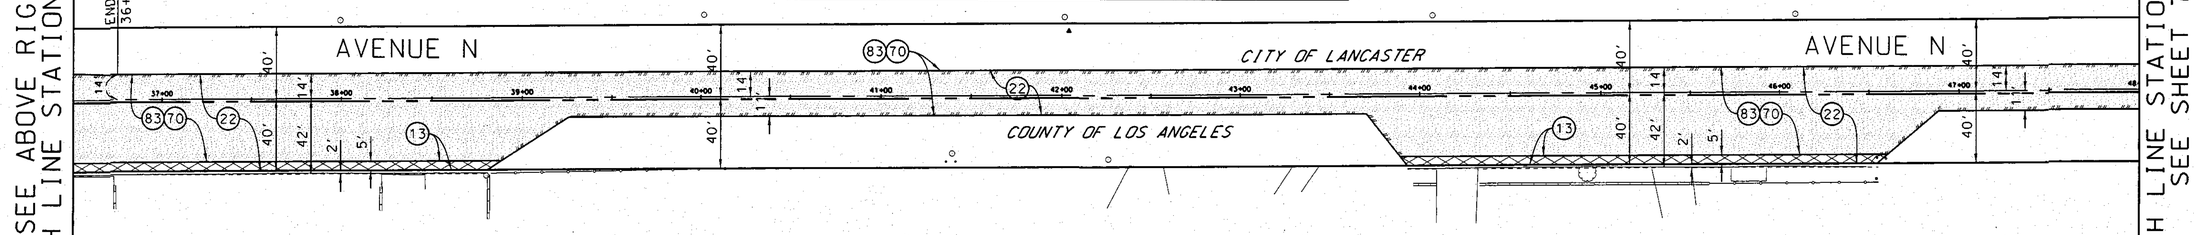

PLAN
SCALE: 1" = 40'

AS BUILT

PH080056

BENCH MARK

PT 4 PALMDALE 1998
EL=2561.70 NAVD 88

Fd CD SURV MON IN WELL
@ ℄ INT AVE N & 40TH ST WEST
DN 24"

DATE	MK	DESCRIPTION

REVISIONS

REGISTERED PROFESSIONAL ENGINEER VOLTAIRE LLANA No. 63954 CIVIL STATE OF CALIFORNIA

PROJECT ENGINEER 8/9/11 DATE

COUNTY OF LOS ANGELES DEPARTMENT OF PUBLIC WORKS

AVENUE N
600' W/O 40TH ST WEST TO
400' W/O 36TH ST WEST
PROJECT ID NO. RDC0015741
T.G. 4195 A1,B1

PCA X2501847 | DWG PH080056 | SHEET 6 OF 8

DRAFTER E. MAGUINO | DESIGNER E. MAGUINO | CHECKER V. LLANA | CADD PROJECT FILE NAME RDC0015741_DGN, SHT 6 | REVIEWED BY | DATE 8/9/11

PROPOSED FOR CONSTRUCTION: DATE | ADVERTISED: DATE | AS BUILT: DATE

DATE: $DATE$ TIME: $TIME$ FILE: $FILEL$