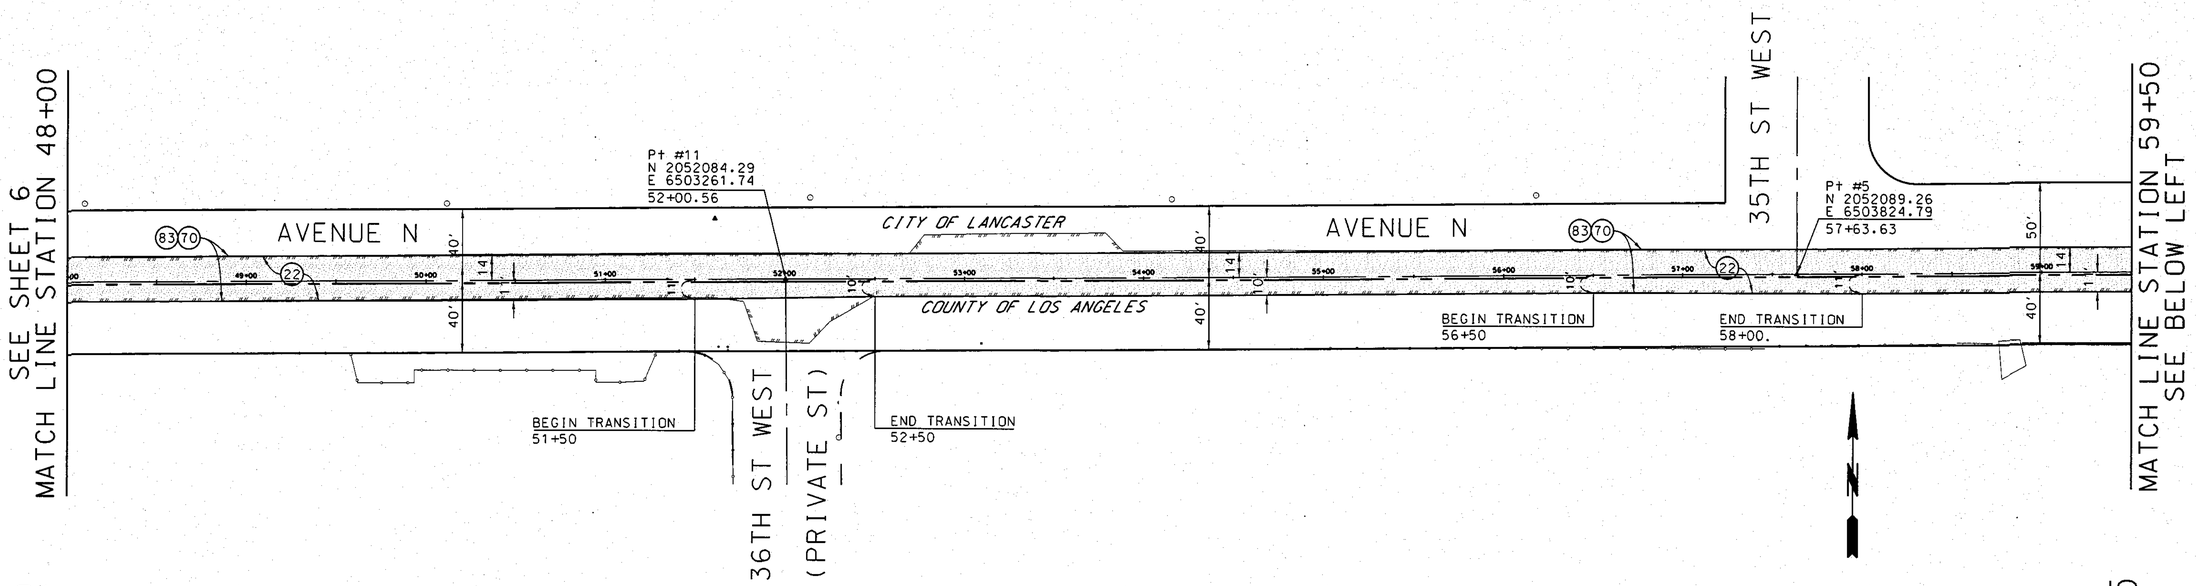

PLAN
SCALE: 1" = 40'

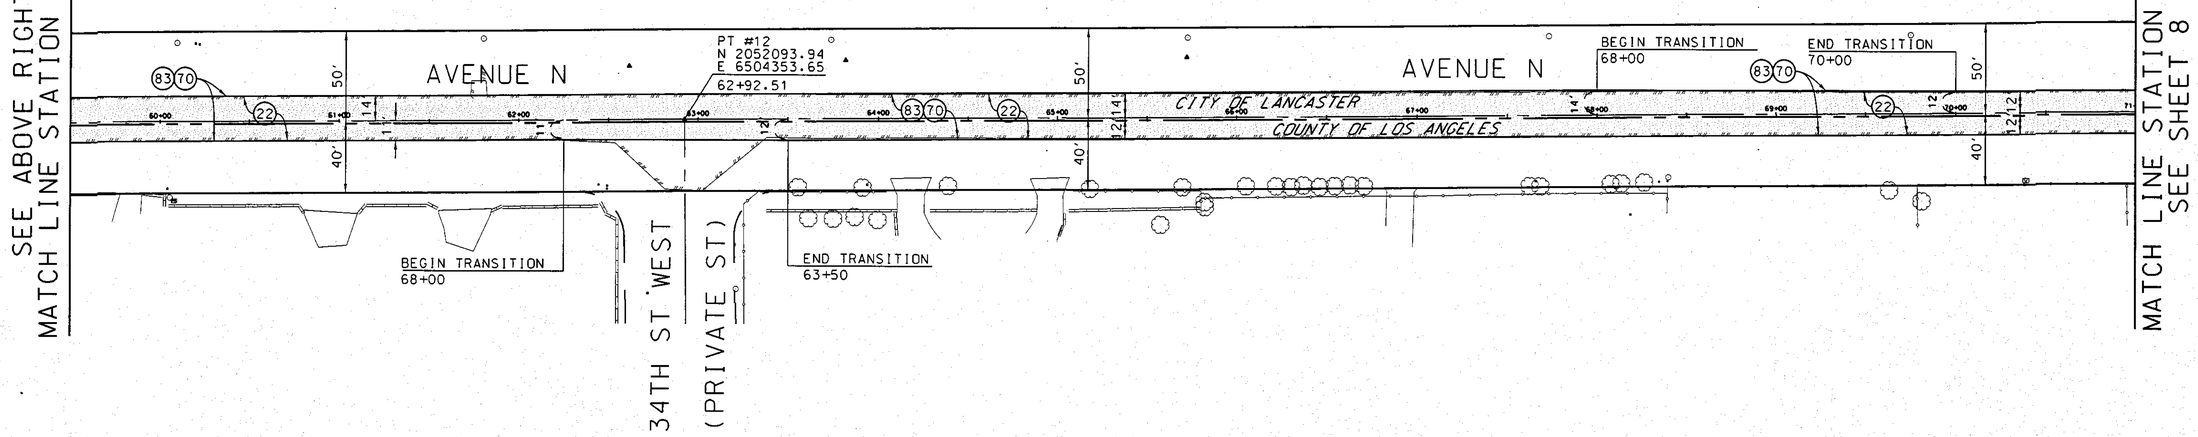

PLAN
SCALE: 1" = 40'

AS BUILT

PH080057

BENCH MARK

PT 5 PALMDALE 1998
EL=2578.46 NAVD 88

Fd CO SURV MON IN WELL
@ ℄ INT AVE N & 35TH ST WEST
DN 24"

DATE	MK	DESCRIPTION

REVISIONS

REGISTERED PROFESSIONAL ENGINEER VOLTAIRE LLANA No. 63954 CIVIL STATE OF CALIFORNIA

PROJECT ENGINEER DATE

COUNTY OF LOS ANGELES DEPARTMENT OF PUBLIC WORKS

AVENUE N
400' W/O 36TH ST WEST TO
800' E/O 34TH ST WEST
PROJECT ID NO. RDC0015741
T.G. 4195 B1

PCA X2501847 | DWG PH080057 | SHEET 7 OF 8

PROPOSED FOR CONSTRUCTION: DATE | ADVERTISED: DATE | AS BUILT: DATE

DRAFTER E. MAGUINO | DESIGNER E. MAGUINO | CHECKER V. LLANA | CADD PROJECT FILE NAME RDC0015741.DGN, SHT 7 | REVIEWED BY | DATE 8/9/11

DATE: $DATE$ TIME: $TIME$ FILE: $FILEL$