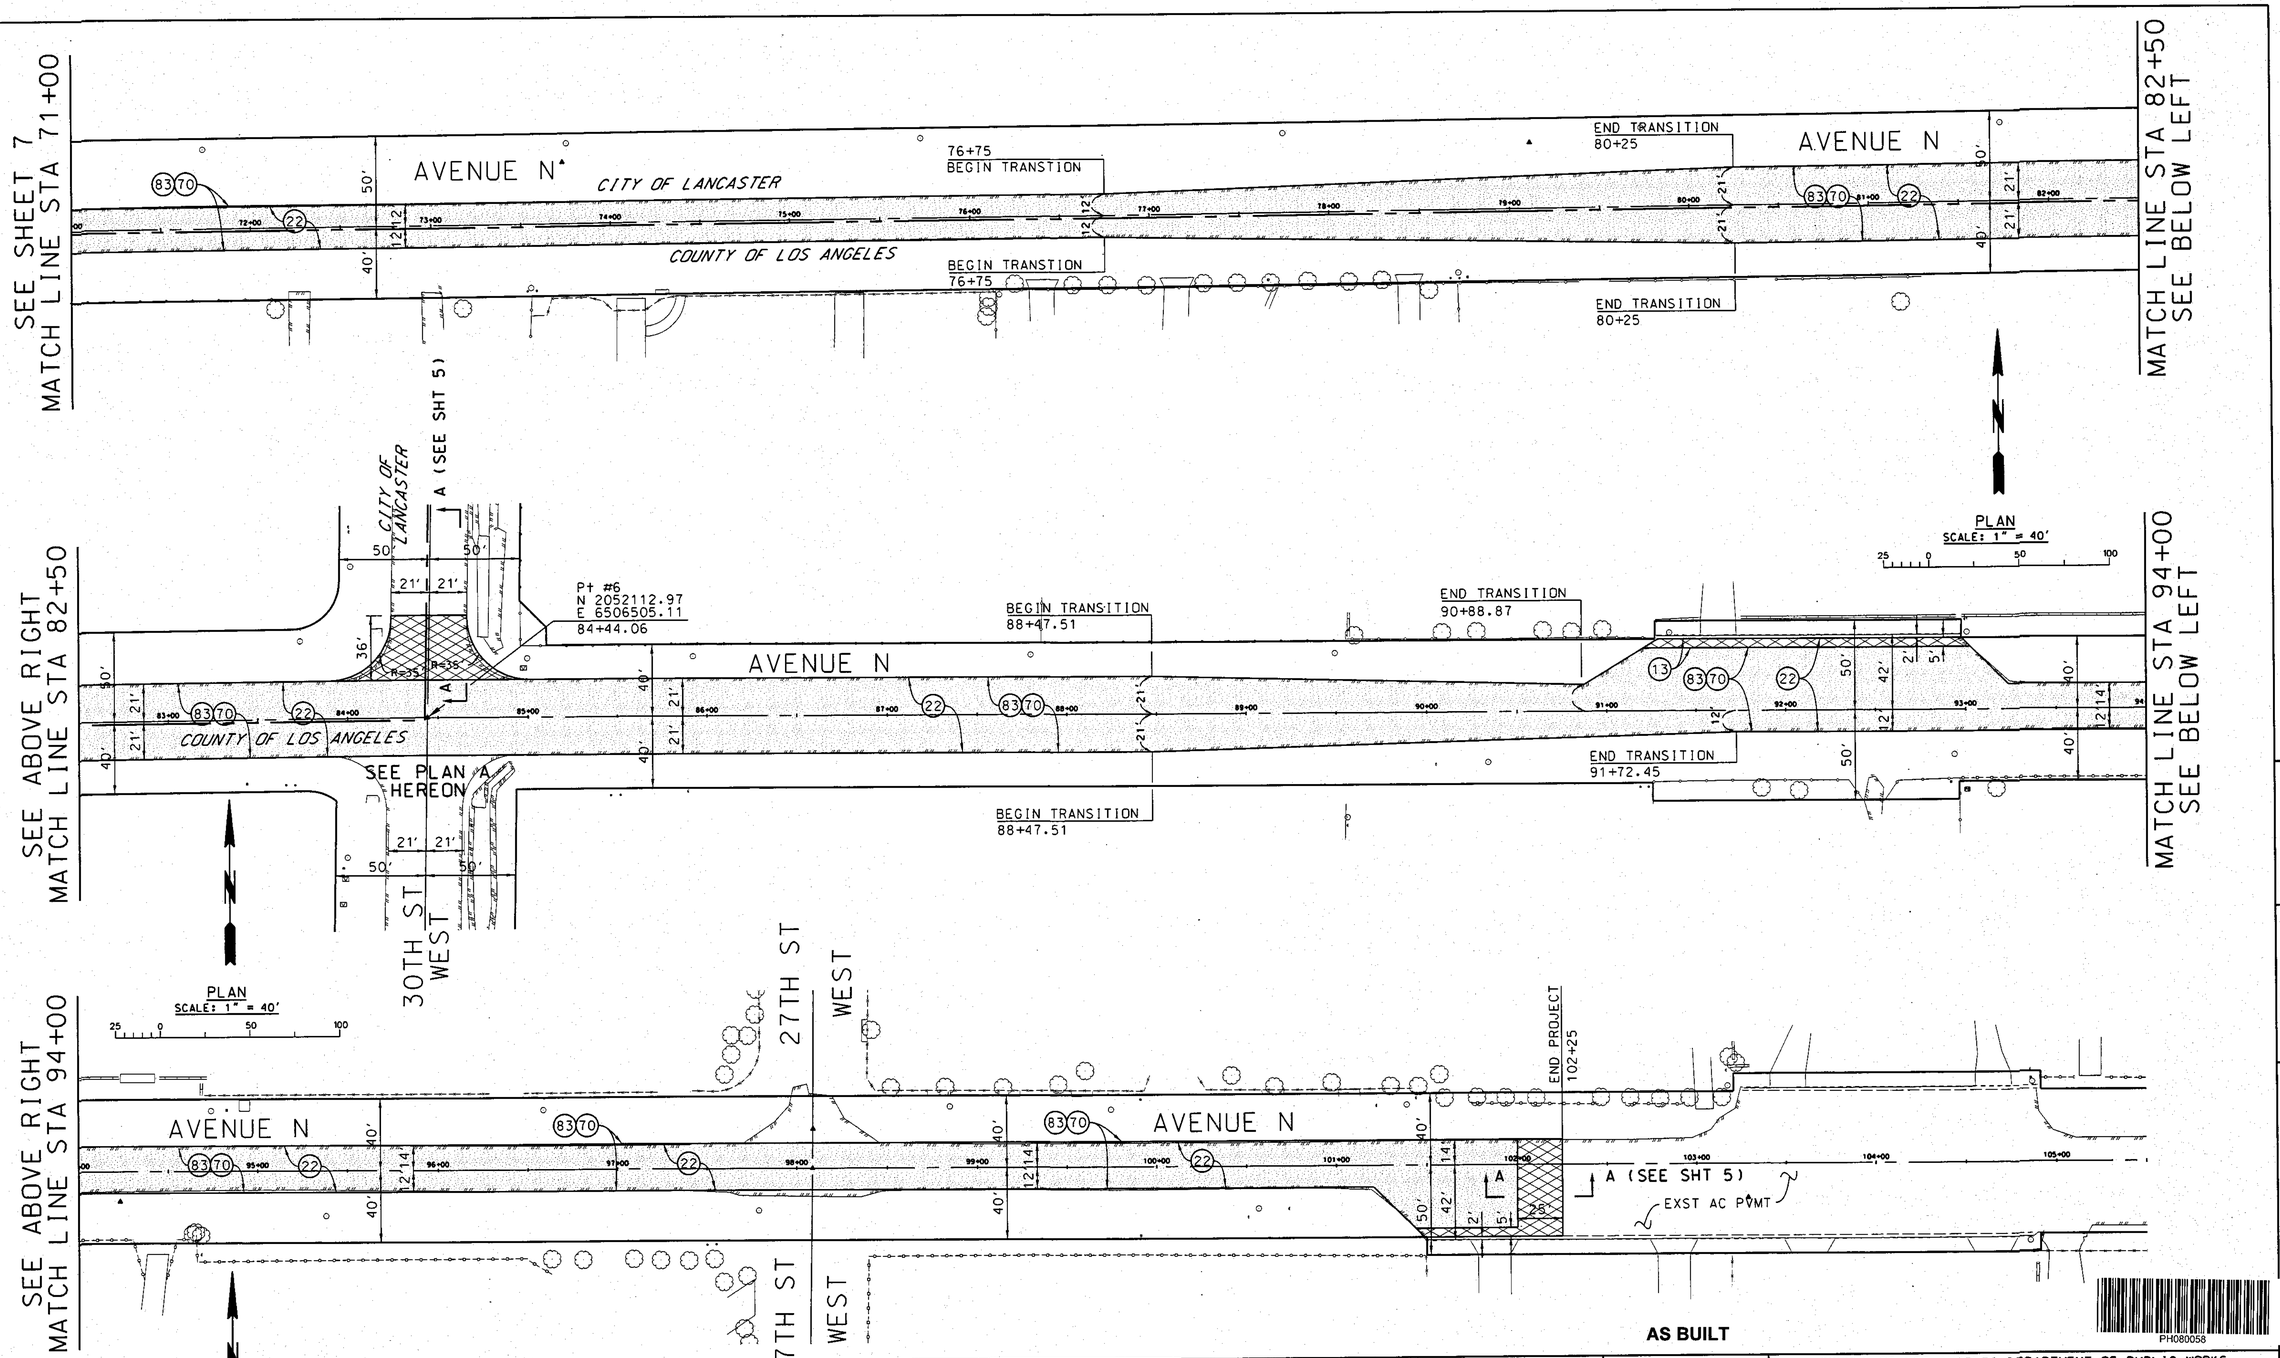

AS BUILT

PH080058

BENCH MARK

PT 6 — PALMDALE 1998
EL=2587.53 — NAVD 88

Fd CO SURV MON IN WELL
@ ℄ INT AVE N & 30TH ST WEST
DN 17"

DATE	MK	DESCRIPTION

REVISIONS

REGISTERED PROFESSIONAL ENGINEER — VICTAIRE LLANA — No. 63954 — CIVIL — STATE OF CALIFORNIA

PROJECT ENGINEER — DATE 8/9/10

COUNTY OF LOS ANGELES DEPARTMENT OF PUBLIC WORKS

AVENUE N

800' E/O 34TH ST WEST TO
1800' E/O 30TH ST WEST
PROJECT ID NO. RDC0015741
T.G. 4195 B1,C1,D1

PCA X2501847 | DWG PH080058 | SHEET 8 OF 8

PROPOSED FOR CONSTRUCTION: — DATE
ADVERTISED: — DATE
AS BUILT: — DATE

DRAFTER E. MAGUINO | DESIGNER E. MAGUINO | CHECKER V. LLANA | CADD PROJECT FILE NAME RDC0015741.DGN, SHT 8 | REVIEWED BY — DATE 8/9/10

DATE: $DATE$ TIME: $TIME$ FILE: $FILEL$