COUNTY OF LOS ANGELES
DEPARTMENT OF PUBLIC WORKS

PATHFINDER ROAD

1300' E/O FULLERTON ROAD TO ALEXDALE LANE

TOTAL LENGTH: 1.77 MILES

INDEX OF SHEETS

SHEET NO. 1	TITLE SHEET
SHEET NO. 2	CONSTRUCTION NOTES AND REFERENCES
SHEET NO. 3	TYPICAL SECTION AND CONSTRUCTION DETAILS
SHEET NO. 4-7	PLAN
PLAN SP	SIGNING AND STRIPING PLANS
PLAN TS	TRAFFIC SIGNAL PLANS

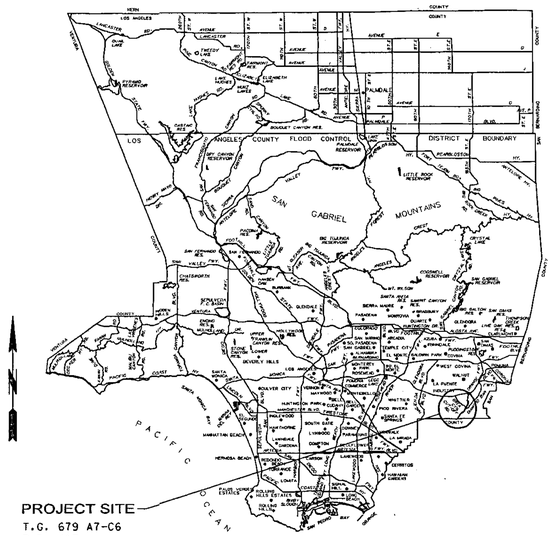

LOCATION MAP
NO SCALE

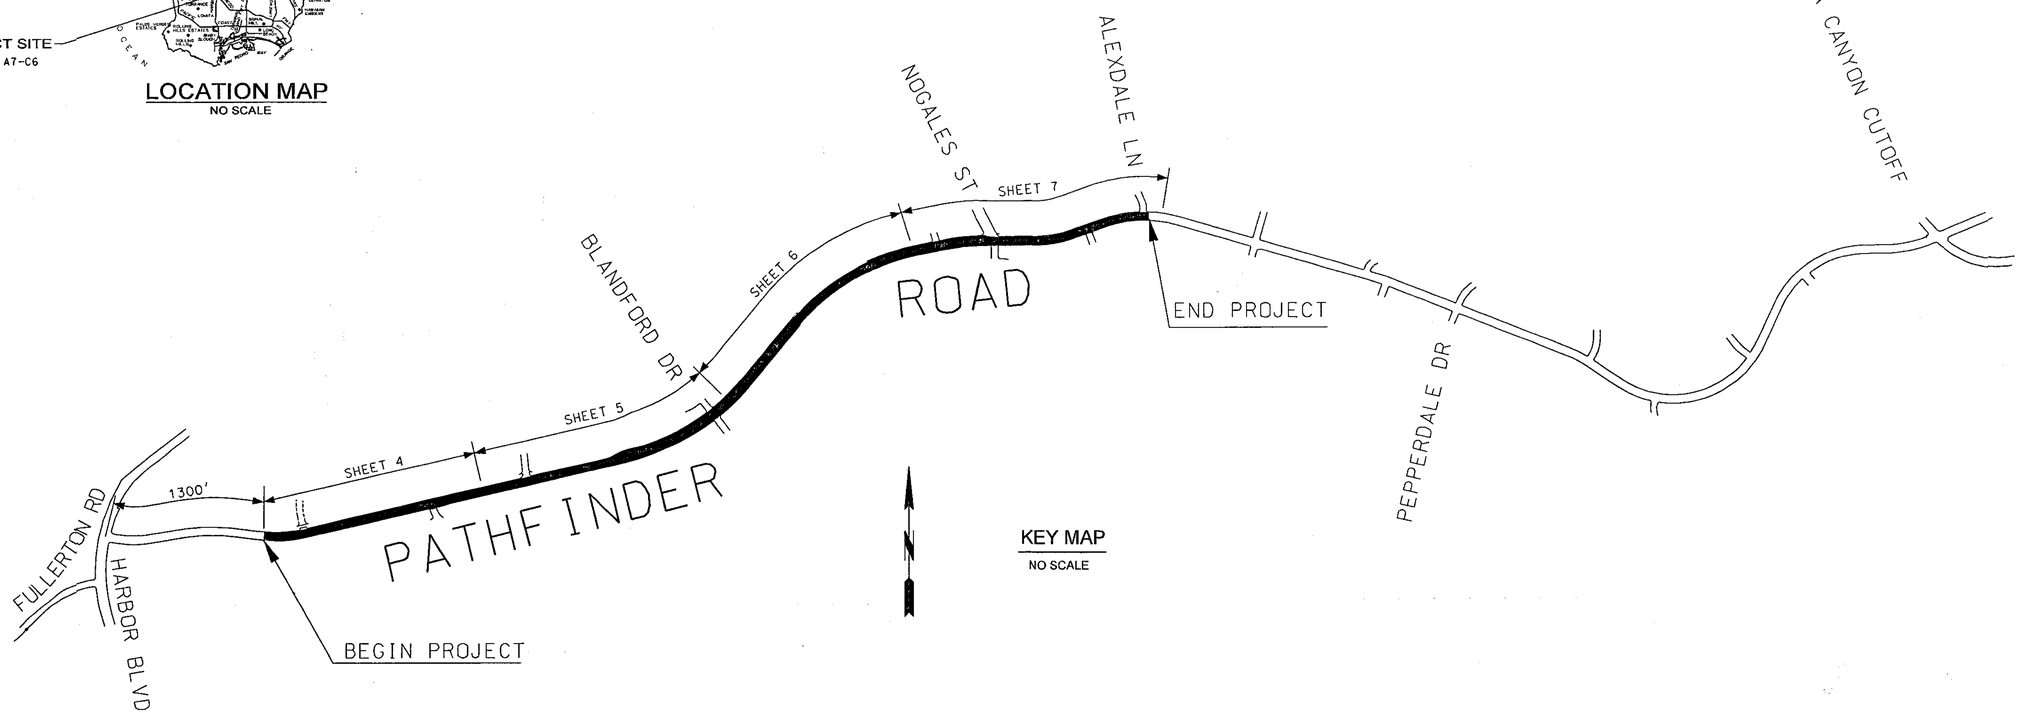

KEY MAP
NO SCALE

AS BUILT

PH081007

TWO DAYS BEFORE YOU DIG	APPROVED GAIL FARBER DIRECTOR OF PUBLIC WORKS BY Patrick J. Ochoa DEPUTY DIRECTOR 1-16-2010 DATE	DATE	MK	DESCRIPTION
CALL USA TOLL FREE	RECOMMENDED BY ASSISTANT DEPUTY DIRECTOR 1/14/10 DATE			
1-800-227-2600	SUBMITTED BY HIGHWAY DESIGN SECTION B 1/12/10 DATE			
		REVISIONS		

REGISTERED PROFESSIONAL ENGINEER SHERRIE JONG NO. C 56647 EXP. 06/30/11 CIVIL STATE OF CALIFORNIA

PROJECT ENGINEER 01-11-10 DATE

COUNTY OF LOS ANGELES DEPARTMENT OF PUBLIC WORKS

PATHFINDER ROAD

TITLE SHEET

PROJECT ID NO. RDC0015342

PREVENTIVE MAINTENANCE PROJECT

BR	JOB	DWG	SHEET 1 OF 7

TS-OF-07/08

PLAN RD

DRAFTER S. JONG | DESIGNER S. JONG | CHECKER D. RADLE | CADD PROJECT FILE NAME RDC0015342-PLAN-RD.DGN

DATE: 10/14/09 TIME: 8:11:16 FILE: 5FILE15