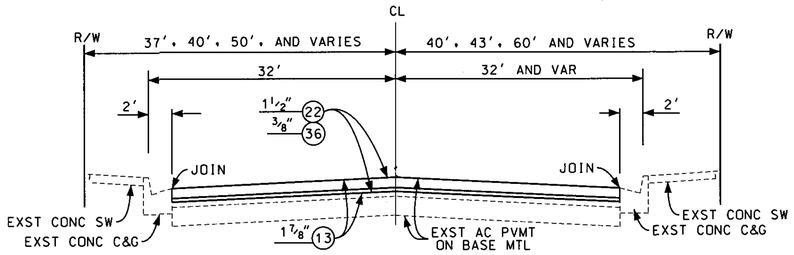

TYPICAL SECTION

NO SCALE

1300' E/O FULLERTON RD TO ALEXDALE LN

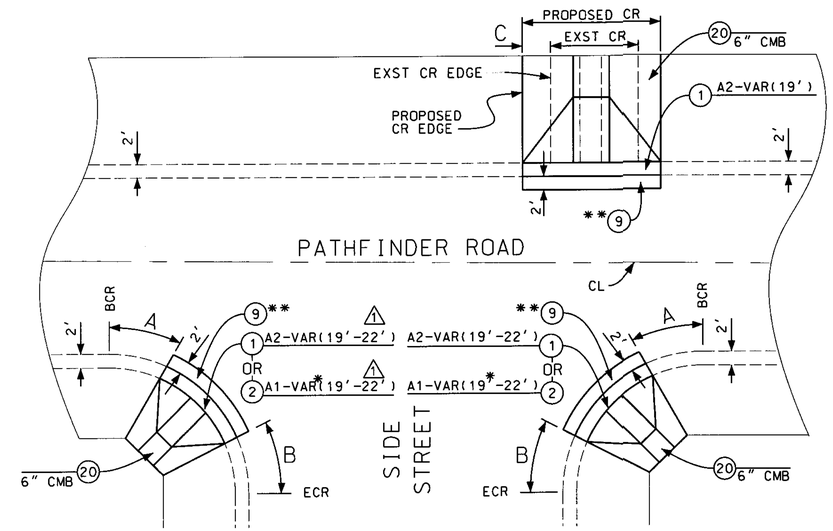

* TRENCH IS NOT REQUIRED IF ADJOINING SURFACE IS CONCRETE
** CONSTRUCT 4" AC(P1) OVER 4" TBS ON 6" CMB

CURB RAMP LOCATION DETAIL

NO SCALE

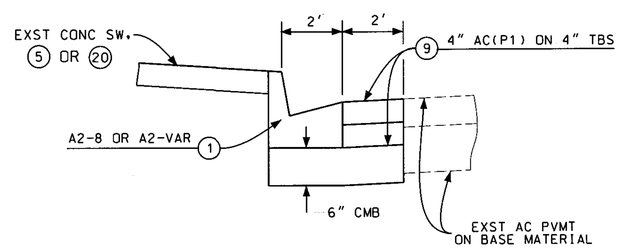

TYPICAL C&G RECONSTRUCTION

NO SCALE

PH081009

AS-BUILT

DATE	MK	DESCRIPTION
2/11/13	1	AS-BUILT (CURB RAMP LENGTH)

REVISIONS

REGISTERED PROFESSIONAL ENGINEER
SHERRIE JONG
NO. C 56647
EXP. 06/30/11
CIVIL
STATE OF CALIFORNIA

PROJECT ENGINEER — DATE 2-11-10

COUNTY OF LOS ANGELES DEPARTMENT OF PUBLIC WORKS

PATHFINDER ROAD

TYPICAL SECTIONS AND DETAILS

PROJECT ID NO. RDC0015342

PCA	DWG	SHEET 3 OF 7

PS-DH 0805

PLAN RD

DRAFTER	DESIGNER	CHECKER	CADD PROJECT FILE NAME	REVIEWED BY	DATE
S. JONG	S. JONG	D. RADLE	RDC0015342-PLAN-RD.DGN		

DATE: $DATE$ TIME: $TIME$ FILE: $FILEL$